

Archived: Friday, June 13, 2025 9:14:50 AM

From: [Medina, Steven](#)

Sent: Friday, June 6, 2025 1:39:05 PM

To: bchen@aqmd.gov ndickel@aqmd.gov [Christina Ojeda](#)

Cc: [Han, Jessie](#) [Haley, William \(Bill\)](#) [Amanda Froman](#) [Steve Cassulo](#) [Nicole Ward](#) [Viswanathan, Srividhya](#) [Jones, Art](#) kate.logan@wasteconnections.com [Mark.Adams](#) [Haley, William \(Bill\)](#)

Subject: Re: Case No. 6177-4 Stipulated Order for Abatement – Well Drilling Update

Importance: Normal

Sensitivity: None

Attachments:

[Outlook-fdqfclry.png](#) [Outlook-r0vhbgs4.png](#) [Outlook-s2q2drr0.png](#) [Outlook-4kwivhay.png](#) [Outlook-mszlrpm.png](#)
[Outlook-snn2unzq.png](#) [Outlook-fioyy3wu.png](#) [Outlook-k2bojgrm.png](#) [Outlook-crz2za3u.png](#) [Outlook-hpwurbl1.png](#)
[Outlook-yf5kn4ns.png](#) [Outlook-ecqir5vy.png](#) [Outlook-y50rjos4.png](#) [Outlook-eee0tdih.png](#) [Outlook-xdhek05a.png](#)
[Outlook-1e4vxasu.png](#) [2025 CCLF GCCS Expan Master Plan_Proposed LFG Extraction Well and Temp Probe Map_2025-06-06.pdf](#)

[EXTERNAL SENDER: Use caution with links/attachments]

All,

In accordance with Condition 15(c) of the Stipulated Order, below is the up-to-date construction summary for the Chiquita Canyon Landfill 2024 GCCS Expansion Master Plan Project.

As of 06/02/2025 to 06/06/2025 - Installation of LFG vertical extraction wells included:

1. CV-2503
2. CV-2507

During 06/02/2025 to 06/06/2025, Chiquita completed the installation of two (2) vertical LFG extraction wells, bringing the total count to two hundred forty-nine (249) vertical LFG extraction wells from December 6th, 2023 (the start date of the GCCS Master Expansion) through today.

During 06/02/2025 to 06/06/2025, Chiquita completed the installation of zero (0) temperature probes, as forecasted in our May 30, 2025, update. The total count of temperature probes installed from February 26th, 2024 (the start date of the temperature probe installations) through today remains thirty-two (32).

The wells and temperature probes scheduled for drilling during the week of 06/09/2025 to 06/13/2025 are as follows (subject to change):

Rig (Continuum): Drilling is currently on hold while the next proposed drilling locations are determined.

Temperature Probe Rig (Cascade): Drilling is currently on hold, as forecasted in our May 30, 2025, update.

STEVEN Ruben Medina, **E.I.T.**


Staff Professional

SCS Engineers

3900 Kilroy Airport Way, Suite 300
Long Beach, CA 90806
858-204-4342 (c)
SMedina@scsengineers.com

Driven by Client Success
www.scsengineers.com



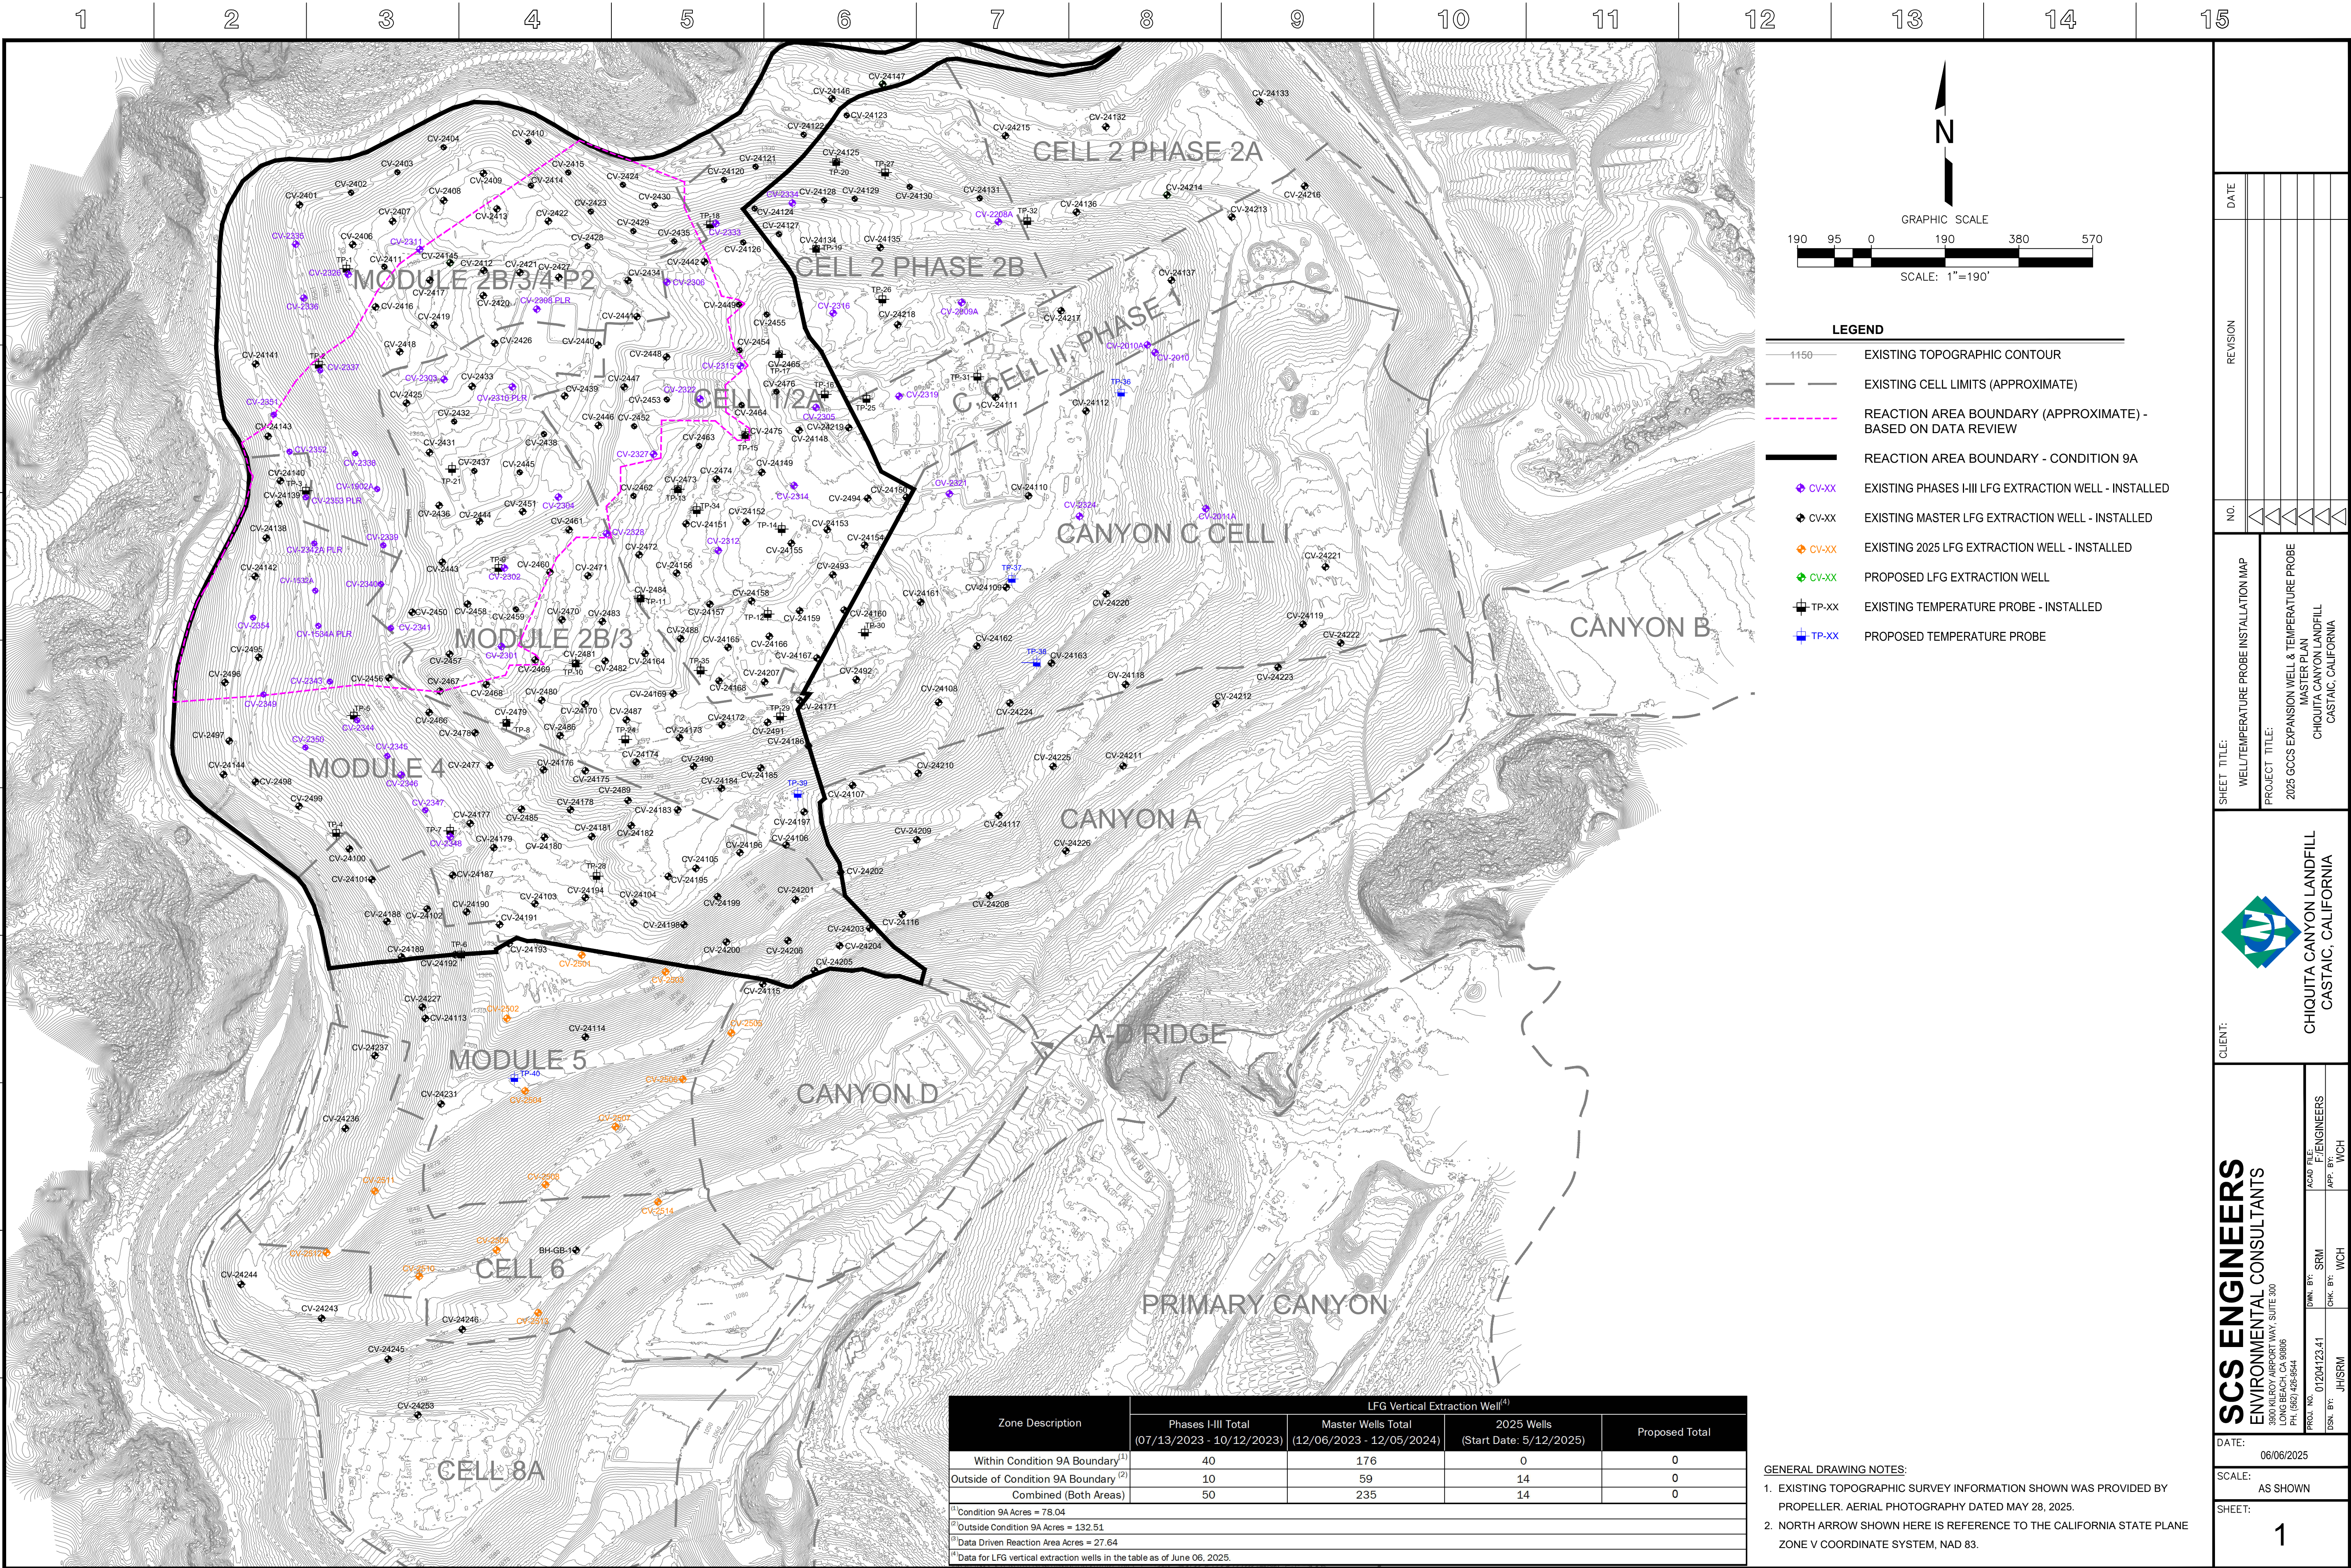

190950190380570

GRAPHIC SCALE

SCALE: 1"=190'

LEGEND

1150

EXISTING TOPOGRAPHIC CONTOUR

EXISTING CELL LIMITS (APPROXIMATE)

REACTION AREA BOUNDARY (APPROXIMATE) - BASED ON DATA REVIEW

REACTION AREA BOUNDARY - CONDITION 9A

CV-XX

EXISTING PHASES I-III LFG EXTRACTION WELL - INSTALLED

CV-XX

EXISTING MASTER LFG EXTRACTION WELL - INSTALLED

CV-XX

EXISTING 2025 LFG EXTRACTION WELL - INSTALLED

CV-XX

PROPOSED LFG EXTRACTION WELL

TP-XX

EXISTING TEMPERATURE PROBE - INSTALLED

TP-XX

PROPOSED TEMPERATURE PROBE

DATE

REVISION

NO.

SHEET TITLE:
WELL/TEMPERATURE PROBE INSTALLATION MAP

PROJECT TITLE:
2025 GCCS EXPANSION WELL & TEMPERATURE PROBE MASTER PLAN
CHIQUITA CANYON LANDFILL
CASTAIC, CALIFORNIA

CLIENT:

SCS ENGINEERS

ENVIRONMENTAL CONSULTANTS

15000 W. ORANGE AVE., SUITE 300
LONG BEACH, CA 90806
PH: (562) 426-9544

ACADE FILE:
F:\ENGINEERS

APP. BY:
WCH

CHK. BY:
WCH

DATE:
06/06/2025

SCALE:
AS SHOWN

SHEET:
1

Z:\Files\Engineers\Waste Connections\Chiquita Canyon LF\2025 Chiquita LF GCCS Design Svcs\05-COA\01-Boring Logs\2025 CCLF GCCS Expan Master Plan_Proposed LFG Extraction Well and Temp Probe Map_2025-06-06.dwg Jun 06, 2025 -- 7:25am By: smedina