

Archived: Monday, June 30, 2025 1:11:35 PM

From: [Medina, Steven](#)

Sent: Friday, June 27, 2025 2:55:33 PM

To: bchen@aqmd.gov ndickel@aqmd.gov [Christina Ojeda](#)

Cc: [Han, Jessie](#) [Haley, William \(Bill\)](#) [Amanda Froman](#) [Steve Cassulo](#) [Nicole Ward](#) [Viswanathan, Srividhya](#) [Jones, Art](#) kate.logan@wasteconnections.com [Mark.Adams](#) [Haley, William \(Bill\)](#)

Subject: Re: Case No. 6177-4 Stipulated Order for Abatement – Well Drilling Update

Importance: Normal

Sensitivity: None

Attachments:

[Outlook-fdqfclry.png](#) [Outlook-r0vhbgs4.png](#) [Outlook-s2q2drr0.png](#) [Outlook-4kwivhay.png](#) [Outlook-msz1rpm.png](#)
[Outlook-snn2unzq.png](#) [Outlook-fioyy3wu.png](#) [Outlook-k2bojgrm.png](#) [Outlook-crz2za3u.png](#) [Outlook-hpwurbl1.png](#)
[Outlook-yf5kn4ns.png](#) [Outlook-ecqir5vy.png](#) [Outlook-y50rjos4.png](#) [Outlook-eee0tdih.png](#) [Outlook-xdhek05a.png](#)
[Outlook-1e4vxasu.png](#) [Outlook-jpjsdf0y.png](#) [Outlook-sqhmxxrf.png](#) [2025 CCLF GCCS Expan Master Plan_Proposed LFG
Extraction Well and Temp Probe Map_2025-06-26.pdf](#)

[EXTERNAL SENDER: Use caution with links/attachments]

All,

In accordance with Condition 15(c) of the Stipulated Order, below is the up-to-date construction summary for the Chiquita Canyon Landfill 2024 GCCS Expansion Master Plan Project.

As of 06/23/2025 to 06/27/2025 - Installation of LFG vertical extraction wells and temperature probes included:

1. TP-36
2. CV-2543
3. CV-2545
4. CV-2553
5. CV-2554

During 06/23/2025 to 06/27/2025, Chiquita completed the installation of four (4) vertical LFG extraction well. The total count of vertical LFG extraction wells installed from December 6, 2023 (the start date of the GCCS Master Expansion) through today is two hundred fifty-four (254).

During 06/23/2025 to 06/27/2025, Chiquita completed the installation of one (1) temperature probe. The total count of temperature probes installed from February 26th, 2024 (the start date of the temperature probe installations) through today is thirty-three (33).

The wells and temperature probes scheduled for drilling during the week of 06/30/2025 to 07/04/2025 are as follows (subject to change):

Rig (Continuum): Due to the need for additional stainless well head parts, along with the upcoming holiday, the drilling crew will be on PTO, and no drilling is scheduled for next week.

Temperature Probe Rig (Cascade): TP-37

STEVEN Ruben Medina, **E.I.T.**

Staff Professional

SCS Engineers

3900 Kilroy Airport Way, Suite 300

Long Beach, CA 90806



858-204-4342 (c)

SMedina@scsengineers.com

Driven by Client Success

www.scsengineers.com

□

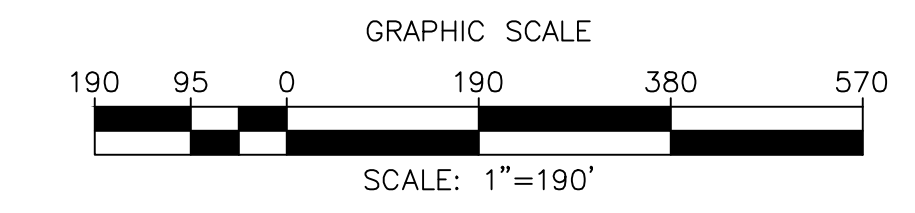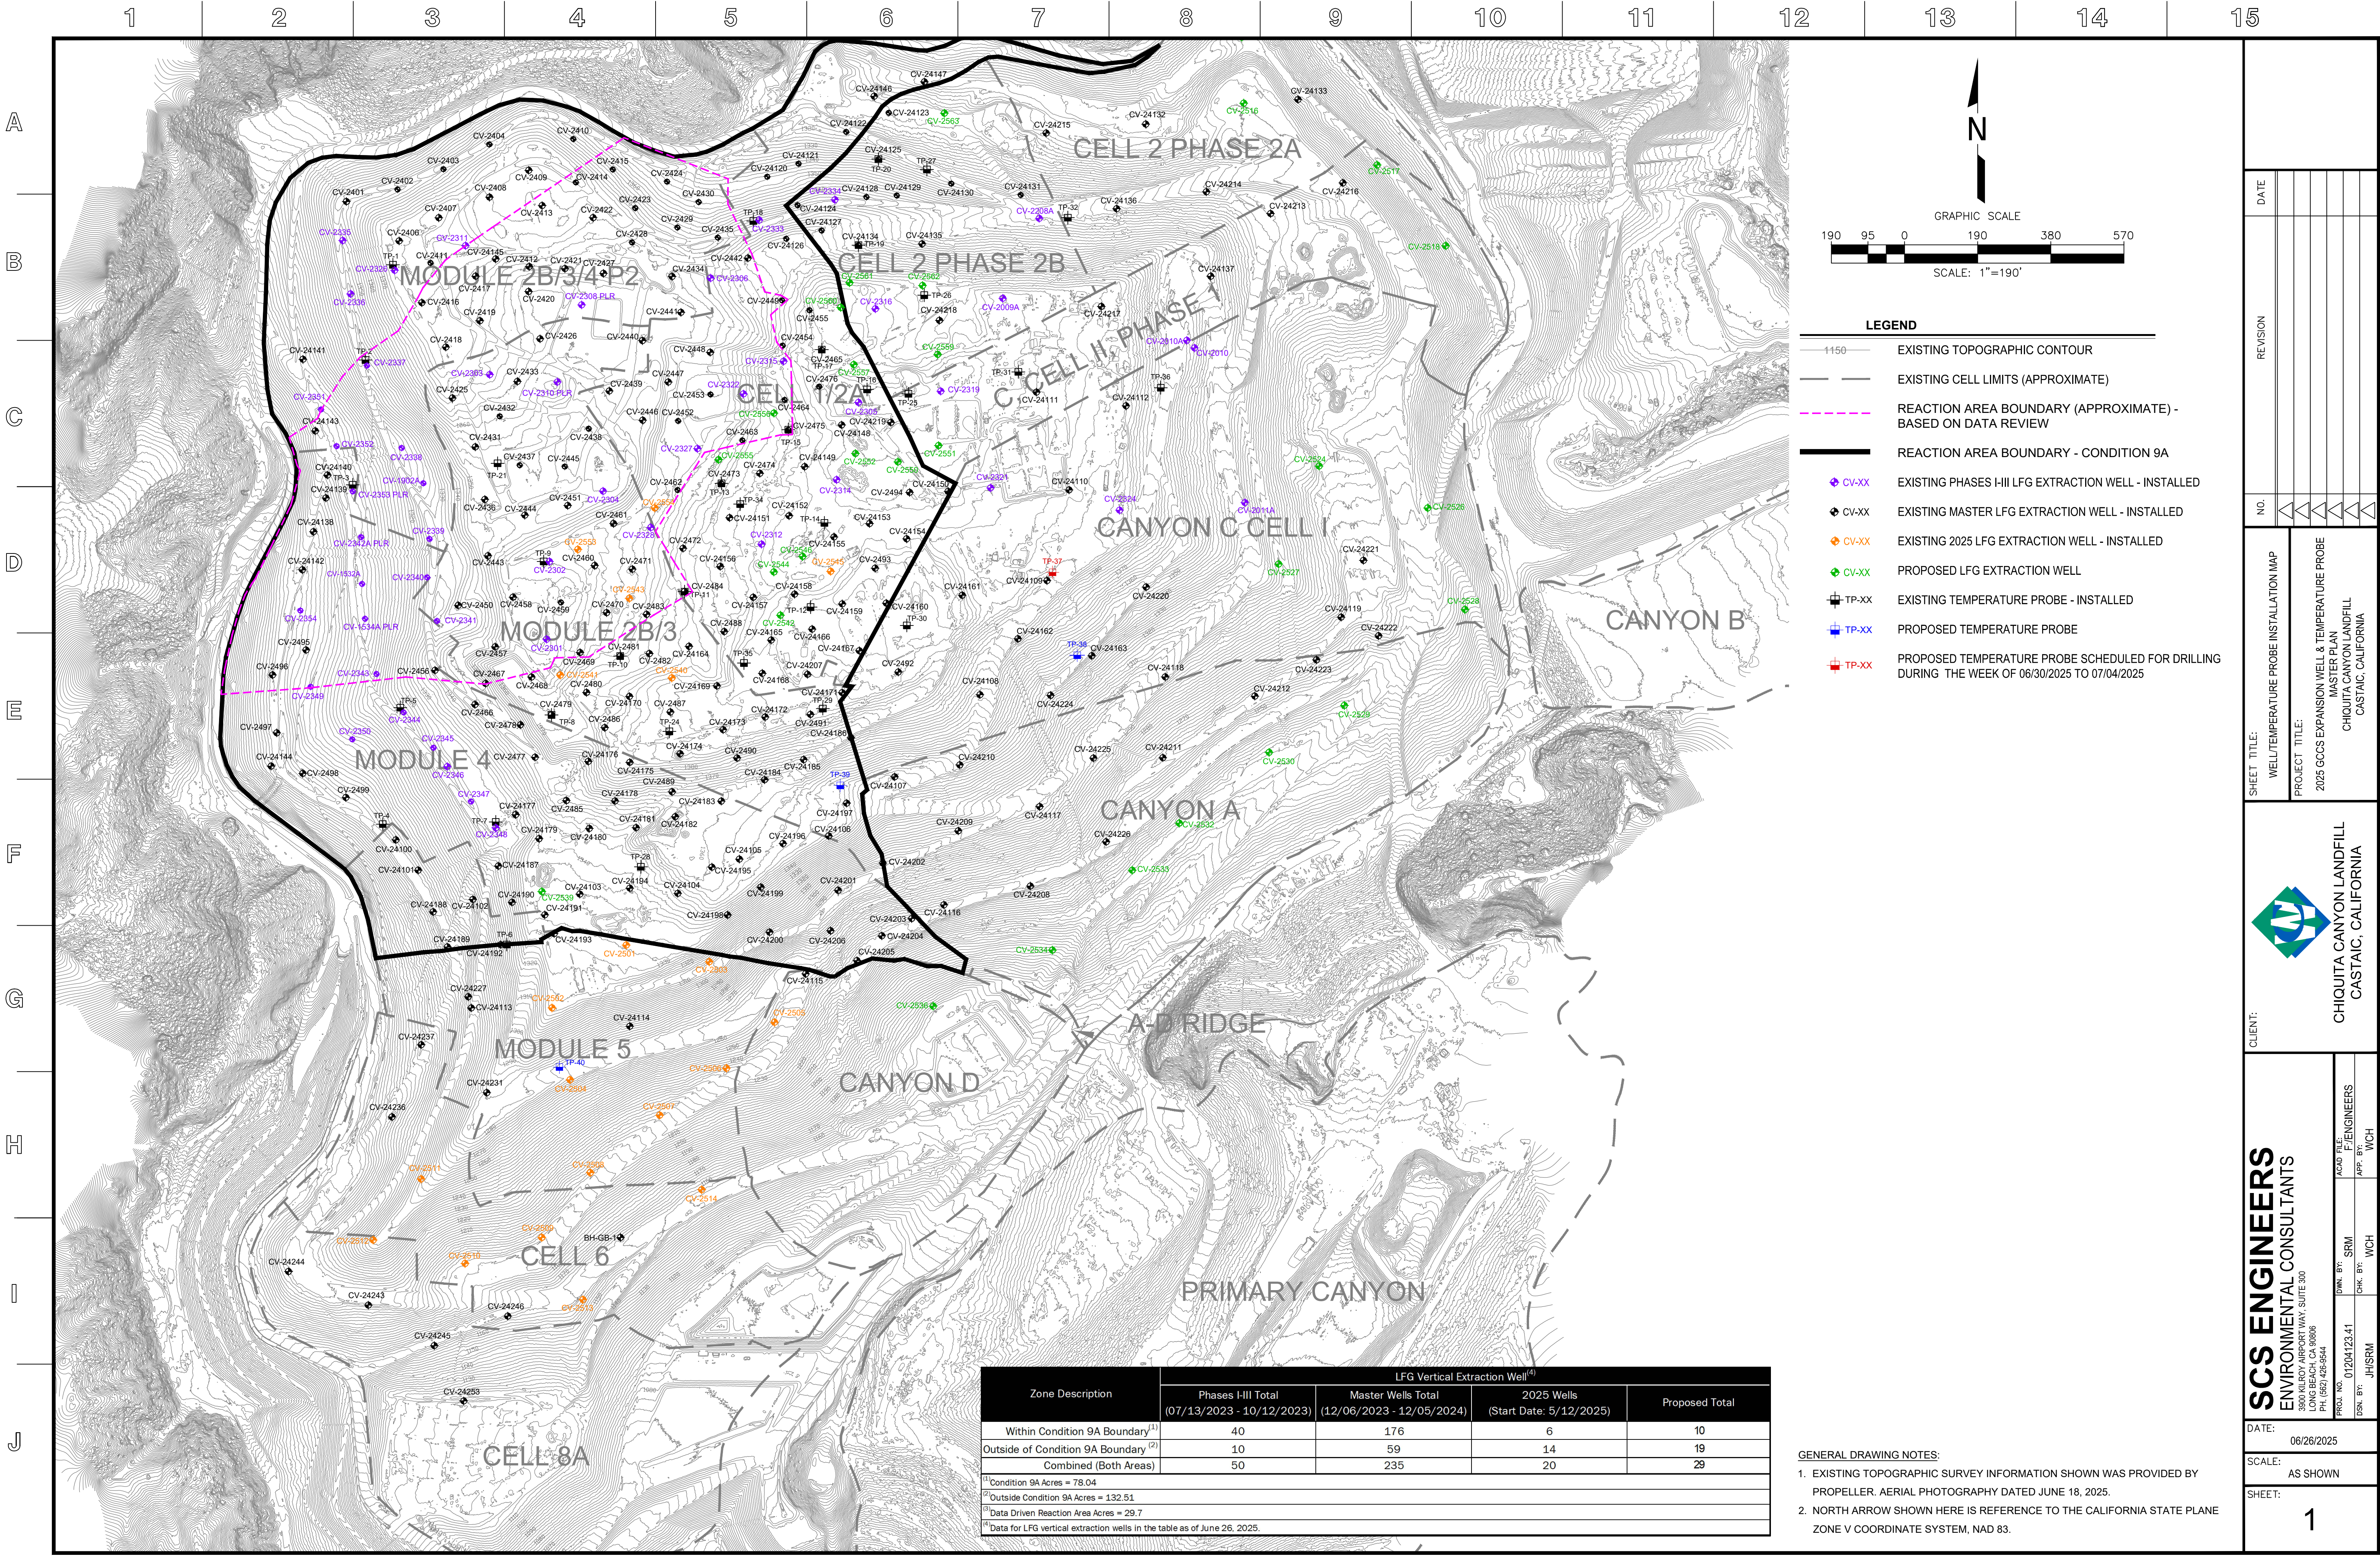

- LEGEND**
- 1150 EXISTING TOPOGRAPHIC CONTOUR
 - EXISTING CELL LIMITS (APPROXIMATE)
 - REACTION AREA BOUNDARY (APPROXIMATE) - BASED ON DATA REVIEW
 - REACTION AREA BOUNDARY - CONDITION 9A
 - CV-XX EXISTING PHASES I-III LFG EXTRACTION WELL - INSTALLED
 - CV-XX EXISTING MASTER LFG EXTRACTION WELL - INSTALLED
 - CV-XX EXISTING 2025 LFG EXTRACTION WELL - INSTALLED
 - CV-XX PROPOSED LFG EXTRACTION WELL
 - TP-XX EXISTING TEMPERATURE PROBE - INSTALLED
 - TP-XX PROPOSED TEMPERATURE PROBE
 - TP-XX PROPOSED TEMPERATURE PROBE SCHEDULED FOR DRILLING DURING THE WEEK OF 06/30/2025 TO 07/04/2025

Zone Description	LFG Vertical Extraction Well ⁽⁴⁾			
	Phases I-III Total (07/13/2023 - 10/12/2023)	Master Wells Total (12/06/2023 - 12/05/2024)	2025 Wells (Start Date: 5/12/2025)	Proposed Total
Within Condition 9A Boundary ⁽¹⁾	40	176	6	10
Outside of Condition 9A Boundary ⁽²⁾	10	59	14	19
Combined (Both Areas)	50	235	20	29

⁽¹⁾ Condition 9A Acres = 78.04
⁽²⁾ Outside Condition 9A Acres = 132.51
⁽³⁾ Data Driven Reaction Area Acres = 29.7
⁽⁴⁾ Data for LFG vertical extraction wells in the table as of June 26, 2025.

GENERAL DRAWING NOTES:

1. EXISTING TOPOGRAPHIC SURVEY INFORMATION SHOWN WAS PROVIDED BY PROPELLER. AERIAL PHOTOGRAPHY DATED JUNE 18, 2025.

2. NORTH ARROW SHOWN HERE IS REFERENCE TO THE CALIFORNIA STATE PLANE ZONE V COORDINATE SYSTEM, NAD 83.

DATE		REVISION		NO.	SHEET TITLE: WELL/TEMPERATURE PROBE INSTALLATION MAP	PROJECT TITLE: 2025 GCCS EXPANSION WELL & TEMPERATURE PROBE MASTER PLAN CHIQUITA CANYON LANDFILL CASTAIC, CALIFORNIA	CLIENT:  CHIQUITA CANYON LANDFILL CASTAIC, CALIFORNIA	SCS ENGINEERS ENVIRONMENTAL CONSULTANTS 1800 N. MICHIGAN AVE., SUITE 300 LONG BEACH, CA 90806 PH: (562) 426-9544 FAX: (562) 426-9544 OWN. BY: SRM CHK. BY: WCH APP. BY: WCH	DATE: 06/26/2025
									SHEET: 1