Archived: Wednesday, July 23, 2025 1:29:52 PM
From: Medina, Steven
Sent: Friday, July 18, 2025 3:54:53 PM
To: bchen@aqmd.gov ndickel@aqmd.gov Christina Ojeda
Cc: Han, Jessie Haley, William (Bill) Amanda Froman Steve Cassulo Nicole Ward Viswanathan, Srividhya Jones, Art Kate Logan Mark.Adams Haley, William (Bill)
Subject: Re: Case No. 6177-4 Stipulated Order for Abatement – Well Drilling Update
Importance: Normal
Sensitivity: None
Attachments:
Outlook-fdqfclry.png; Outlook-r0vhbgs4.png; Outlook-s2q2drr0.png; Outlook-4kwivhay.png; Outlook-msz1rprn.png; Outlook-snn2unzq.png; Outlook-ftoyy3wu.png; Outlook-k2bojgrm.png; Outlook-crz2za3u.png; Outlook-hpwurbl1.png; Outlook-yf5kn4ns.png; Outlook-ecqir5vy.png; Outlook-y50rjos4.png; Outlook-eee0tdih.png; Outlook-xdhek05a.png; Outlook-1e4vxasu.png; Outlook-jpjsdf0y.png; Outlook-sqhmxxrf.png; Outlook-zebtoagg.png; Outlook-fgsnpp2b.png; Outlook-ns3aaxc4.png; 025 CCLF GCCS Expan Master Plan_Proposed LFG Extraction Well and Temp Probe Map.pdf;

[EXTERNAL SENDER: Use caution with links/attachments]

All,

In accordance with Condition 15(c) of the Stipulated Order, below is the up-to-date construction summary for the Chiquita Canyon Landfill 2024 GCCS Expansion Master Plan Project.

As of 07/14/2025 to 07/18/2025 - Installation of LFG vertical extraction wells and temperature probes included:
1.CV-2544
2. CV-2552
3. CV-2556

During 07/14/2025 to 07/18/2025, Chiquita completed the installation of three (3) vertical LFG extraction wells. The total count of vertical LFG extraction wells installed from December 6, 2023 (the start date of the GCCS Master Expansion) through today is two hundred sixty-one (261).

During 07/14/2025 to 07/18/2025, Chiquita completed the installation of zero (0) temperature probes, as forecasted in our July 11, 2025, update. The total count of temperature probes installed from February 26th, 2024 (the start date of the temperature probe installations) through today remains thirty-three (33).

The wells and temperature probes scheduled for drilling during the week of 07/21/2025 to 07/25/2025 are as follows (subject to change):

Rig (Continuum): CV-2524, CV-2526, CV-2528
Temperature Probe Rig (Cascade): As noted in our July 11, 2025 update, drilling activities are currently on hold while Chiquita continues to evaluate the installation of the remaining temperature probes.

Regards,
STEVEN Ruben Medina, **E.I.T.**

Staff Professional
SCS Engineers
3900 Kilroy Airport Way, Suite 300
Long Beach, CA 90806
858-204-4342 (c)
SMedina@scsengineers.com

Driven by Client Success
www.scsengineers.com

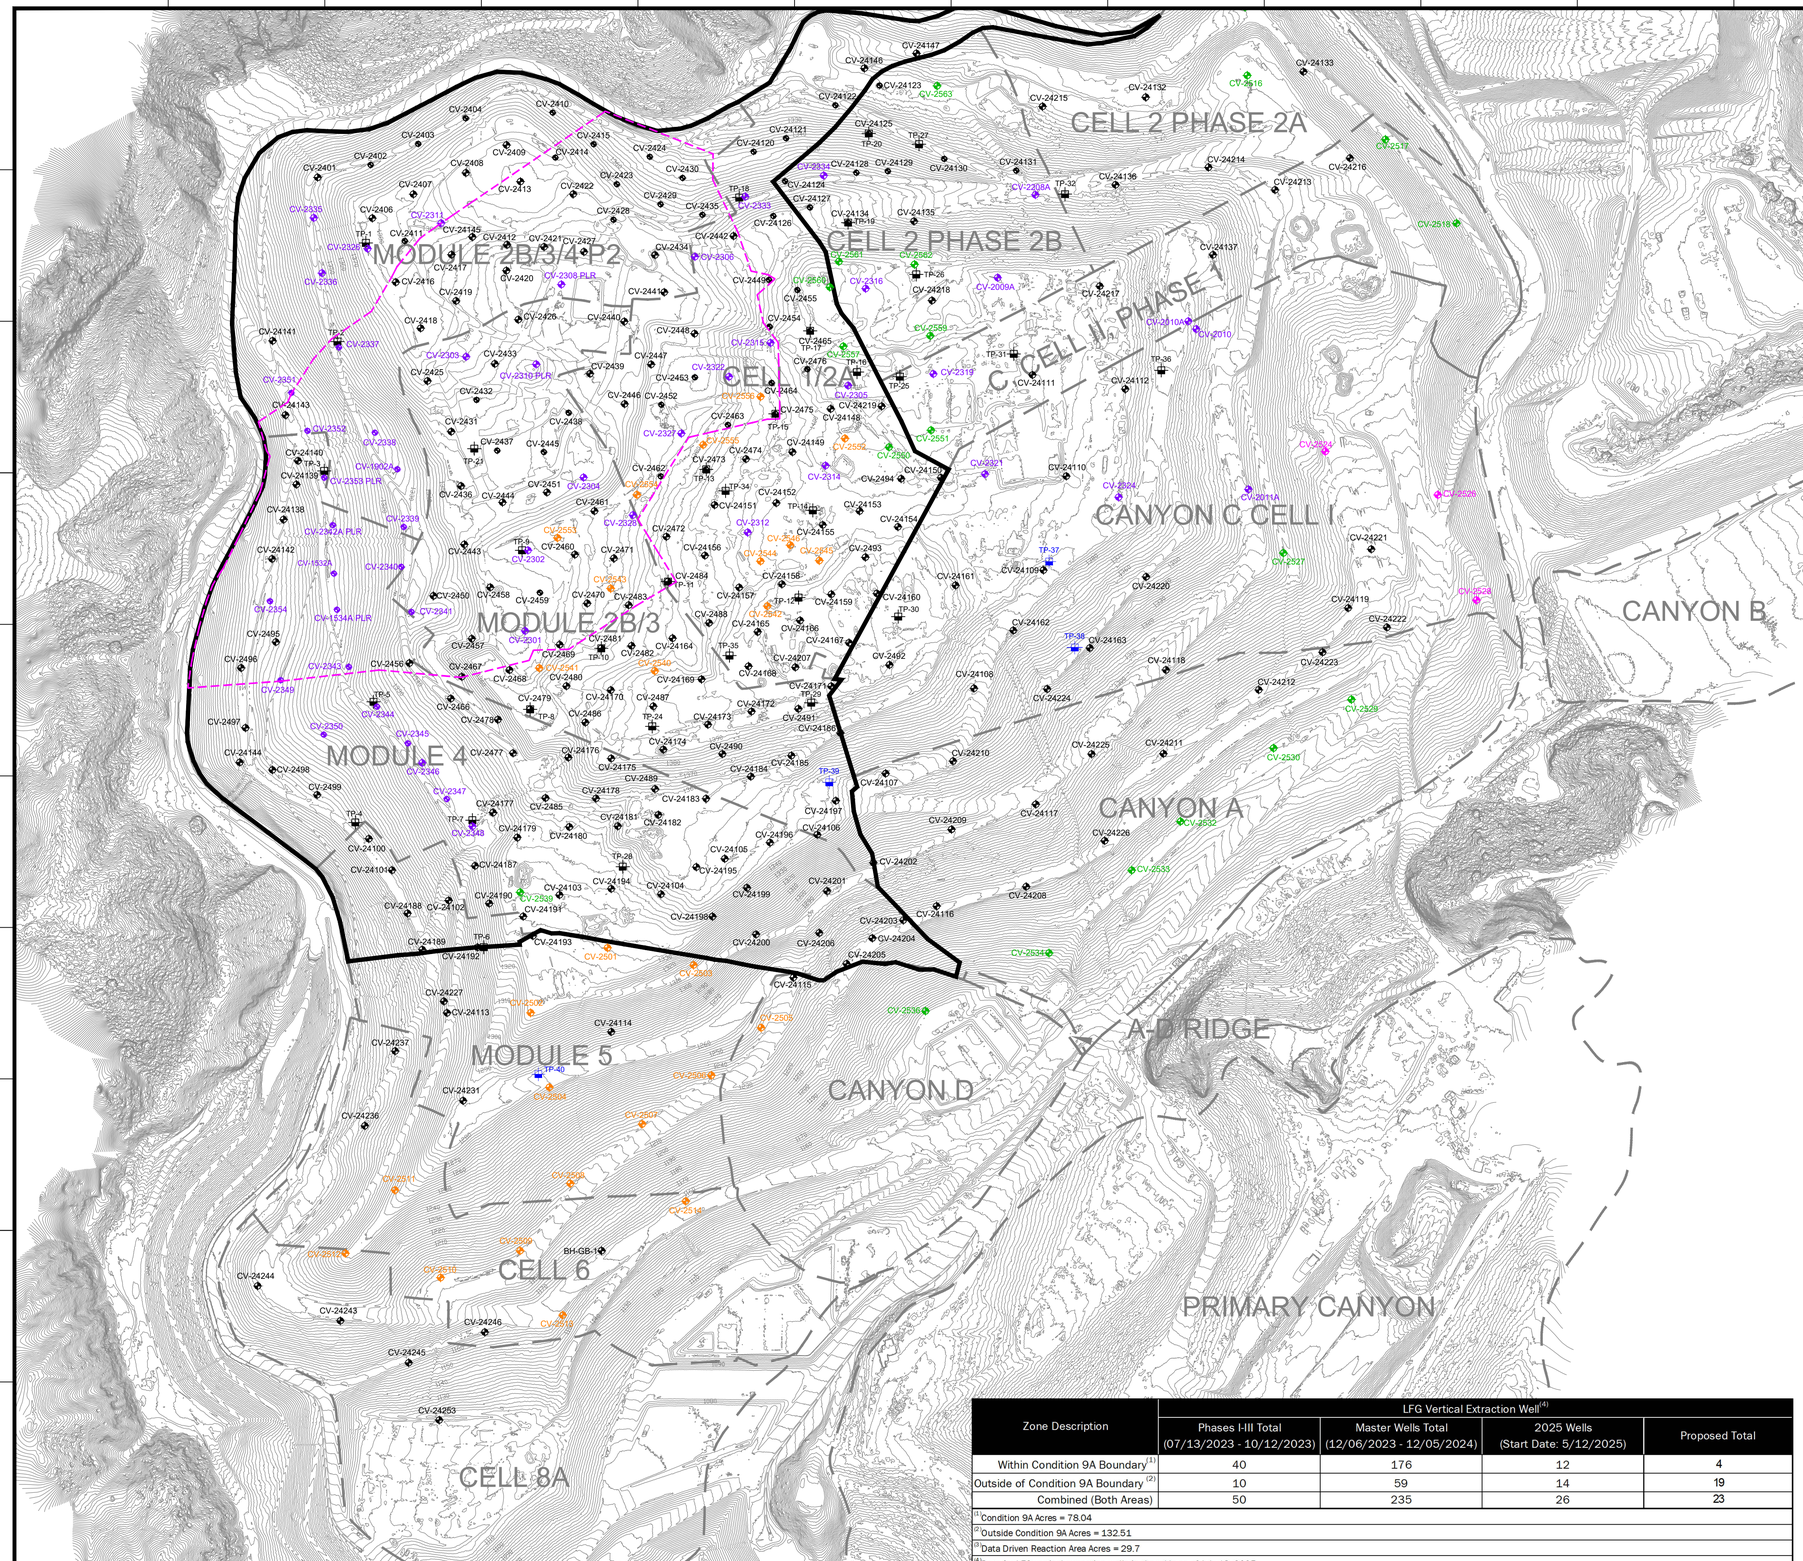

N

GRAPHIC SCALE

190 95 0 190 380 570

SCALE: 1"=190'

LEGEND

- 1150 — EXISTING TOPOGRAPHIC CONTOUR
- EXISTING CELL LIMITS (APPROXIMATE)
- REACTION AREA BOUNDARY (APPROXIMATE) - BASED ON DATA REVIEW
- REACTION AREA BOUNDARY - CONDITION 9A
- CV-XX — EXISTING PHASES I-III LFG EXTRACTION WELL - INSTALLED
- CV-XX — EXISTING MASTER LFG EXTRACTION WELL - INSTALLED
- CV-XX — EXISTING 2025 LFG EXTRACTION WELL - INSTALLED
- CV-XX — PROPOSED LFG EXTRACTION WELL
- CV-XX — PROPOSED LFG EXTRACTION WELL SCHEDULED FOR DRILLING DURING THE WEEK OF 07/21/2025 TO 07/25/2025
- TP-XX — EXISTING TEMPERATURE PROBE - INSTALLED
- TP-XX — PROPOSED TEMPERATURE PROBE

Zone Description	LFG Vertical Extraction Well[4]			
	Phases I-III Total (07/13/2023 - 10/12/2023)	Master Wells Total (12/06/2023 - 12/05/2024)	2025 Wells (Start Date: 5/12/2025)	Proposed Total
Within Condition 9A Boundary[1]	40	176	12	4
Outside of Condition 9A Boundary[2]	10	59	14	19
Combined (Both Areas)	50	235	26	23

[1] Condition 9A Acres = 78.04

[2] Outside Condition 9A Acres = 132.51

[3] Data Driven Reaction Area Acres = 29.7

[4] Data for LFG vertical extraction wells in the table as of July 18, 2025.

GENERAL DRAWING NOTES:

1. EXISTING TOPOGRAPHIC SURVEY INFORMATION SHOWN WAS PROVIDED BY PROPELLER. AERIAL PHOTOGRAPHY DATED JULY 09, 2025.
2. NORTH ARROW SHOWN HERE IS REFERENCE TO THE CALIFORNIA STATE PLANE ZONE V COORDINATE SYSTEM, NAD 83.

NO.	REVISION	DATE

SHEET TITLE: WELL/TEMPERATURE PROBE INSTALLATION MAP

PROJECT TITLE: 2025 GCCS EXPANSION WELL & TEMPERATURE PROBE MASTER PLAN CHIQUITA CANYON LANDFILL CASTAIC, CALIFORNIA

CLIENT: CHIQUITA CANYON LANDFILL CASTAIC, CALIFORNIA

SCS ENGINEERS
ENVIRONMENTAL CONSULTANTS
3900 KILROY AIRPORT WAY, SUITE 300
LONG BEACH, CA 90806
PH. (562) 426-9544

PROJ. NO. 01204123.41 | DWN. BY: SRM | CHK. BY: WCH | ACAD FILE: ENGINEERS | APP. BY: WCH | DSN. BY: JH/SRM

DATE: 07/18/2025

SCALE: AS SHOWN

SHEET: 1

Z:\Files\Engineers\Waste Connections\Chiquita Canyon LF\2025 Chiquita LF GCCS Design Svcs\05-CQA\01-Boring Logs\2025 CCLF GCCS Expan Master Plan_Proposed LFG Extraction Well and Temp Probe Map_2025-07-18.dwg Jul 18, 2025 - 11:44am By: smedina