

Archived: Friday, August 8, 2025 10:45:12 AM

From: [Medina, Steven](#)

Sent: Friday, August 1, 2025 1:45:14 PM

To: bchen@aqmd.gov ndickel@aqmd.gov [Christina Ojeda](#)

Cc: [Han, Jessie](#) [Haley, William \(Bill\)](#) [Amanda Froman](#) [Steve Cassulo](#) [Nicole Ward](#) [Viswanathan, Srividhya](#) [Jones, Art](#) [Kate Logan](#) [Mark.Adams](#) [Haley, William \(Bill\)](#)

Subject: Re: Case No. 6177-4 Stipulated Order for Abatement – Well Drilling Update

Importance: Normal

Sensitivity: None

Attachments:

[Outlook-fdqfclry.png](#) [Outlook-r0vhbgs4.png](#) [Outlook-s2q2drr0.png](#) [Outlook-4kwivhay.png](#) [Outlook-msz1rpn.png](#)
[Outlook-snn2unzq.png](#) [Outlook-fioyy3wu.png](#) [Outlook-k2bojgrm.png](#) [Outlook-crz2za3u.png](#) [Outlook-hpwurbl1.png](#)
[Outlook-yf5kn4ns.png](#) [Outlook-ecqir5vy.png](#) [Outlook-y50rjos4.png](#) [Outlook-eee0tdih.png](#) [Outlook-xdhek05a.png](#)
[Outlook-1e4vxasu.png](#) [Outlook-jpjsdf0y.png](#) [Outlook-sqhmxxrf.png](#) [Outlook-zebtoagg.png](#) [Outlook-fgsnpp2b.png](#)
[Outlook-ns3aaxc4.png](#) [Outlook-we4qbwv0.png](#) [image.png](#) [2025 CCLF GCCS Expan Master Plan_Proposed LFG
Extraction Well and Temp Probe Map_2025-08-01.pdf](#)

[EXTERNAL SENDER: Use caution with links/attachments]

All,

In accordance with Condition 15(c) of the Stipulated Order, below is the up-to-date construction summary for the Chiquita Canyon Landfill 2025 GCCS Expansion Master Plan Project.

As of 07/28/2025 to 08/01/2025 - Installation of LFG vertical extraction wells and temperature probes included:

1. CV-2517
2. CV-2518
3. CV-2526
4. CV-2529
5. CV-2530
6. CV-2532
7. CV-2536

During 07/28/2025 to 08/01/2025, Chiquita completed the installation of seven (7) vertical LFG extraction wells. The total count of vertical LFG extraction wells installed from December 6, 2023 (the start date of the GCCS Master Expansion) through today is two hundred seventy-two (272).

During 07/28/2025 to 08/01/2025, Chiquita completed the installation of zero (0) temperature probes, as forecasted in our July 25, 2025, update. The total count of temperature probes installed from February 26th, 2024 (the start date of the temperature probe installations) through today remains thirty-three (33).

The wells and temperature probes scheduled for drilling during the week of 08/04/2025 to 08/08/2025 are as follows (subject to change):

Rig (Continuum): CV-2522, CV-2523, CV-2525, CV-2528, CV-2531, CV-2533, CV-2534, CV-2538

Temperature Probe Rig (Cascade): As noted in our July 25, 2025 update, drilling activities are currently on hold while

Chiquita continues to evaluate the installation of the remaining temperature probes.

Regards,

STEVEN Ruben Medina, **E.I.T.**

Staff Professional

SCS Engineers

3900 Kilroy Airport Way, Suite 300

Long Beach, CA 90806


858-204-4342 (c)

SMedina@scsengineers.com

Driven by Client Success

www.scsengineers.com

□

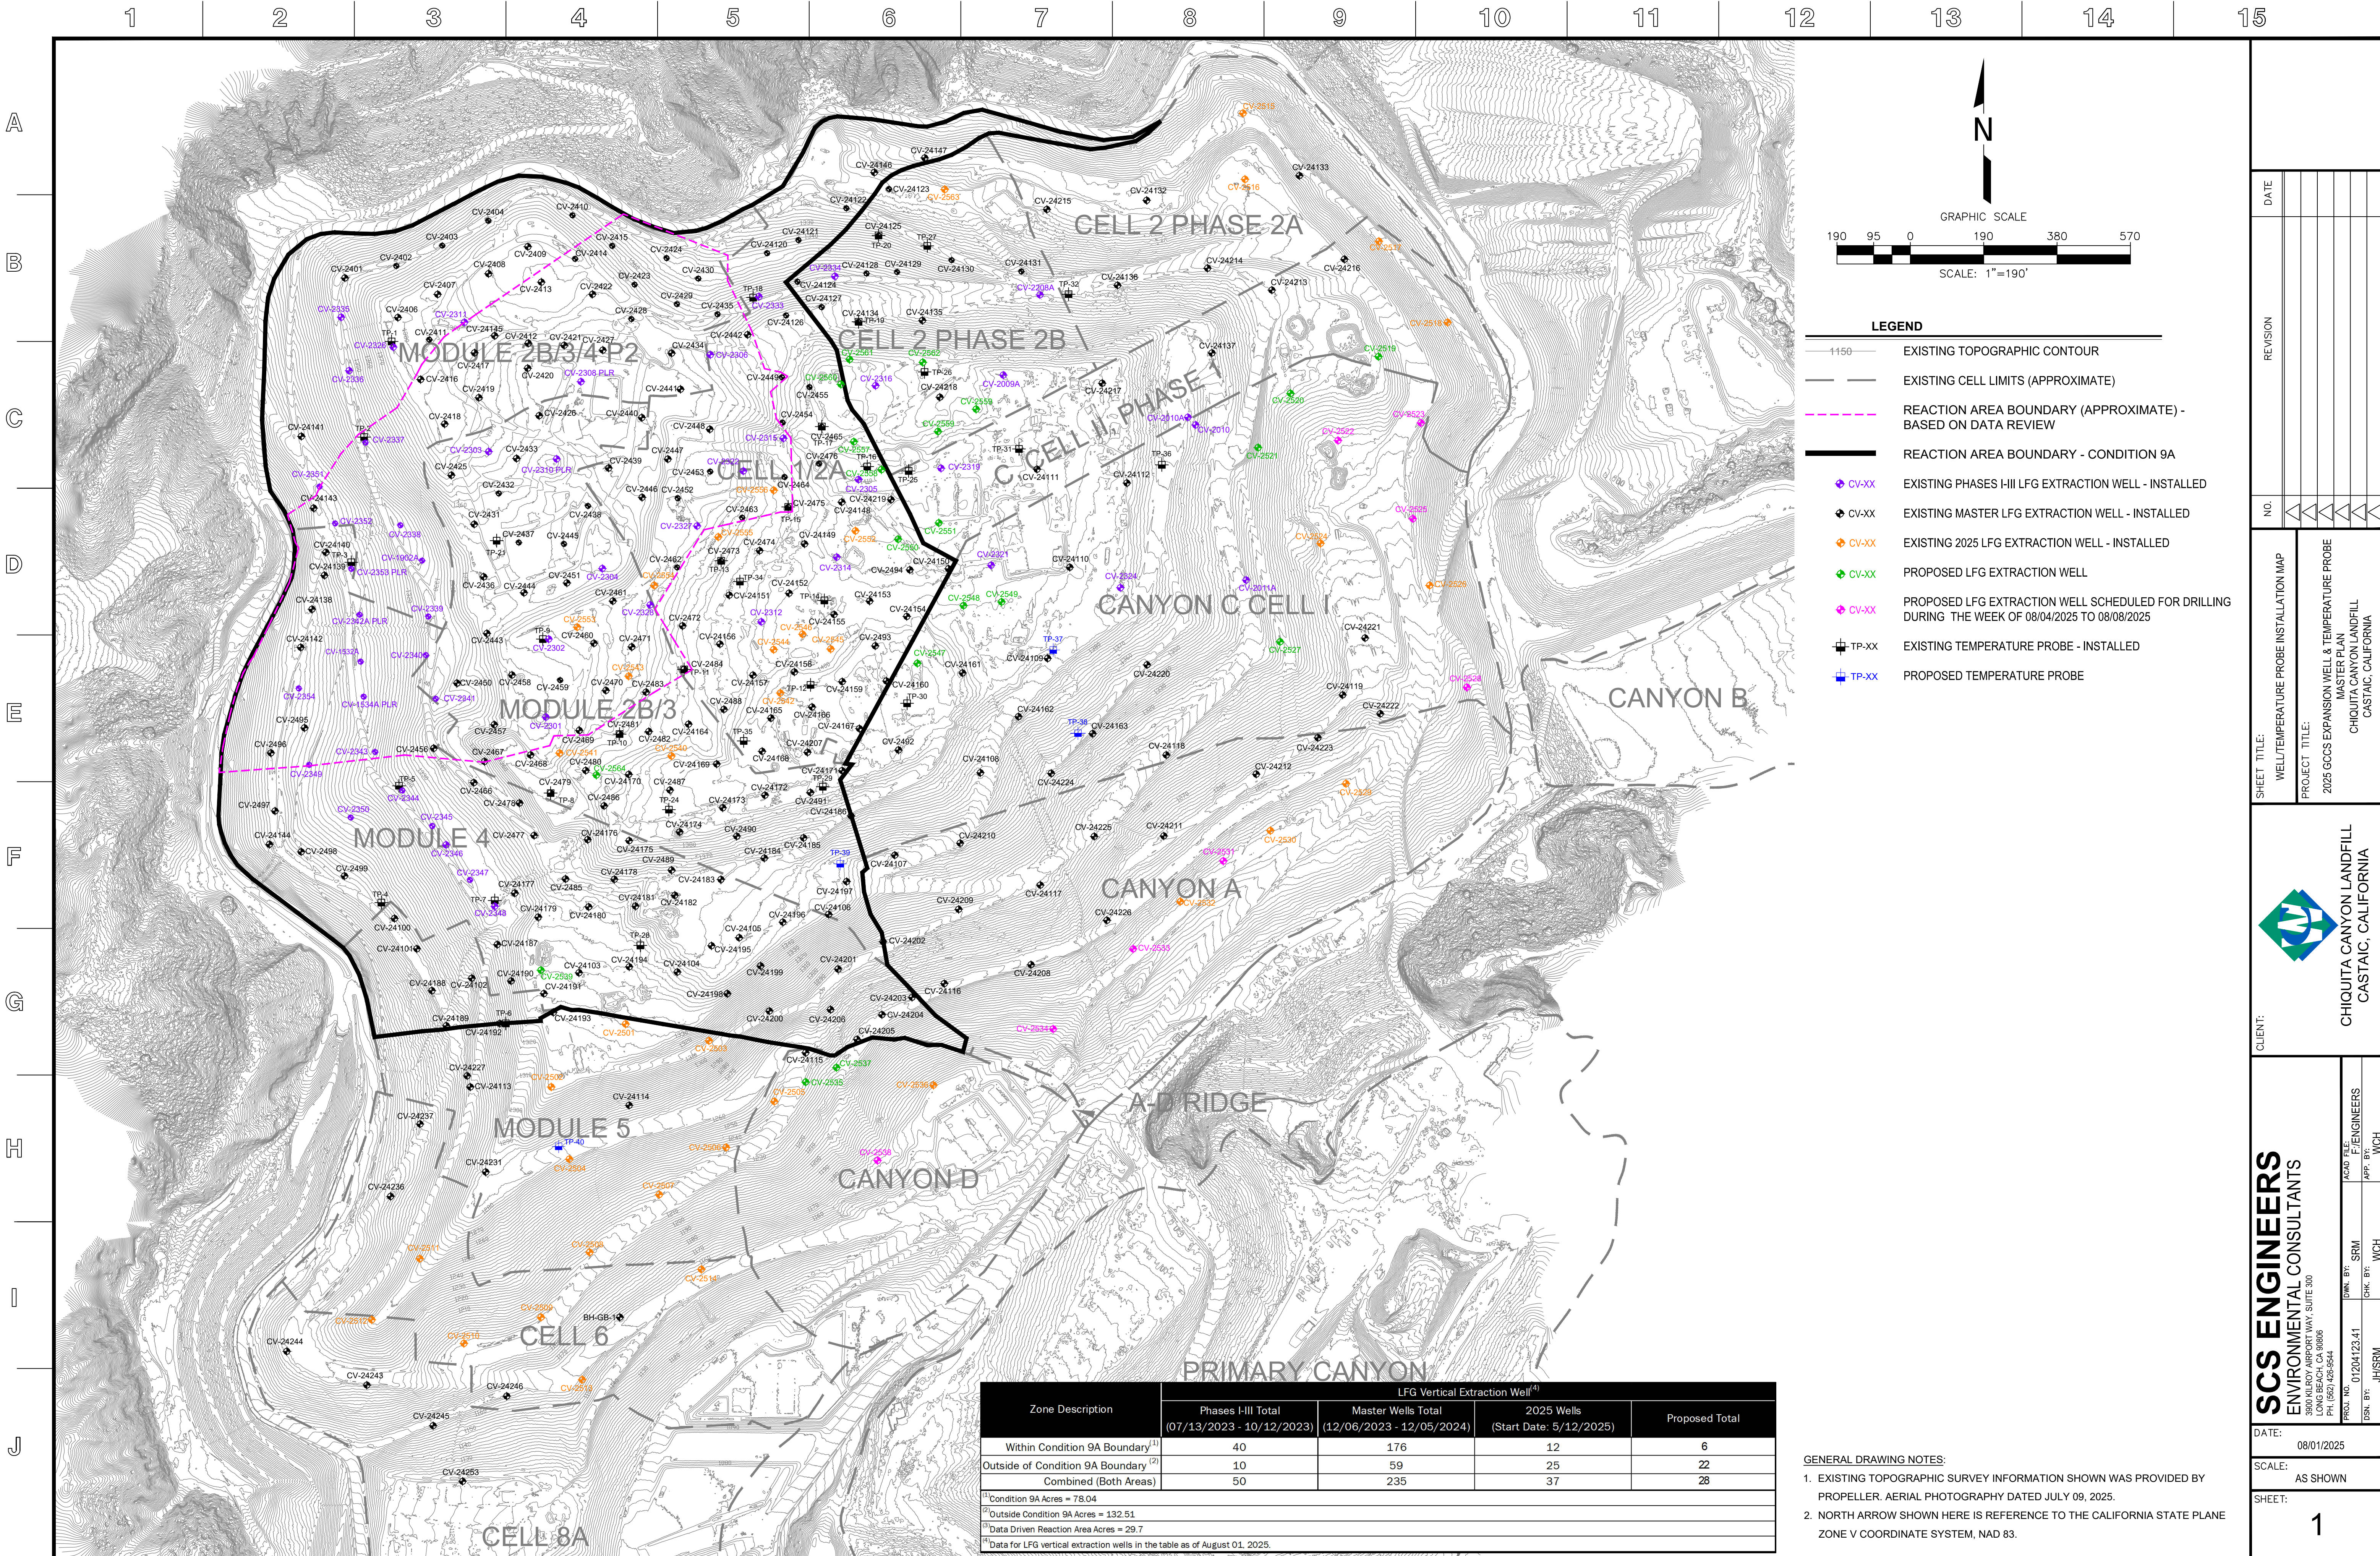

Zone Description	LFG Vertical Extraction Well ⁽⁴⁾			
	Phases I-III Total (07/13/2023 - 10/12/2023)	Master Wells Total (12/06/2023 - 12/05/2024)	2025 Wells (Start Date: 5/12/2025)	Proposed Total
Within Condition 9A Boundary ⁽¹⁾	40	176	12	6
Outside of Condition 9A Boundary ⁽²⁾	10	59	25	22
Combined (Both Areas)	50	235	37	28
⁽¹⁾ Condition 9A Acres = 78.04				
⁽²⁾ Outside Condition 9A Acres = 132.51				
⁽³⁾ Data Driven Reaction Area Acres = 29.7				
⁽⁴⁾ Data for LFG vertical extraction wells in the table as of August 01, 2025.				

DATE

REVISION

NO.

SHEET TITLE:
WELL/TEMPERATURE PROBE INSTALLATION MAP

PROJECT TITLE:
2025 GCCS EXPANSION WELL & TEMPERATURE PROBE
MASTER PLAN
CHICUITA CANYON LANDFILL
CASTAIC, CALIFORNIA

CLIENT:


CHICUITA CANYON LANDFILL
CASTAIC, CALIFORNIA

SCS ENGINEERS
ENVIRONMENTAL CONSULTANTS
1500 E. 15TH AVENUE, SUITE 300
LONG BEACH, CA 90806
PH: (562) 426-9544

PROJ. NO. 01204123.41
DWN. BY: SRM
CHK. BY: WCH

APP. BY: WCH

DATE: 08/01/2025

SCALE: AS SHOWN

SHEET: 1

