

Archived: Thursday, September 18, 2025 9:04:37 AM
From: [Medina, Steven](#)
Sent: Friday, September 12, 2025 11:11:11 AM
To: bchen@aqmd.gov
Cc: [Han, Jessie](#)
Subject: Re: Case No. 6177-4 Stipulated Order for Abatement – Well Drilling Update
Importance: Normal
Sensitivity: None
Attachments: [image.png](#)  [2025 CCLF GCCS Expan Master Plan_Proposed LFG Extraction Well and Temp Probe Map_2025-09-12.pdf](#) 

[EXTERNAL SENDER: Use caution with links/attachments]

All,

In accordance with Condition 15(c) of the Stipulated Order, below is the up-to-date construction summary for the Chiquita Canyon Landfill 2025 GCCS Expansion Master Plan Project.

As of 09/08/2025 to 09/12/2025 - Installation of LFG vertical extraction wells and temperature probes included:

1. CV-2523
2. CV-2528
3. CV-25100S/D
4. CV-25101S/D
5. CV-25102S/D

During 09/08/2025 to 09/12/2025, Chiquita completed the installation of five (5) vertical LFG extraction wells. The total count of vertical LFG extraction wells installed from December 6, 2023 (the start date of the GCCS Master Expansion) through today is two hundred and ninety (290). Please note that CV-2523 was mistakenly included in last week's total. This week's overall total of two hundred and ninety (290) reflects the correction.

During 09/08/2025 to 09/12/2025, Chiquita completed the installation of zero (0) temperature probes. The total count of temperature probes installed from February 26th, 2024 (the start date of the temperature probe installations) through today is thirty-five (35).

The wells and temperature probes scheduled for drilling during the week of 09/15/2025 to 9/19/2025 are as follows (subject to change):

Rig (Continuum): CV-251013S/D, CV-251014S/D, CV-251015S/D, CV-251016S/D, CV-251073S/D
Temperature Probe Rig (Boart Longyear): TP-39

Regards,

STEVEN Ruben Medina, **E.I.T.**
Staff Professional
SCS Engineers

3900 Kilroy Airport Way, Suite 300
Long Beach, CA 90806
858-204-4342 (c)
SMedina@scsengineers.com

Driven by Client Success
www.scsengineers.com




Zone Description	LFG Vertical Extraction Well ⁽⁴⁾			
	Phases I-III Total (07/13/2023 - 10/12/2023)	Master Wells Total (12/06/2023 - 12/05/2024)	2025 Wells (Start Date: 5/12/2025)	Proposed Total
Within Condition 9A Boundary ⁽¹⁾	40	176	19	2
Outside of Condition 9A Boundary ⁽²⁾	10	59	36	12
Combined (Both Areas)	50	235	55	14

⁽¹⁾Condition 9A Acres = 78.04

⁽²⁾Outside Condition 9A Acres = 132.51

⁽³⁾Data Driven Reaction Area Acres = 29.7

⁽⁴⁾Data for LFG vertical extraction wells in the table as of September 12, 2025.

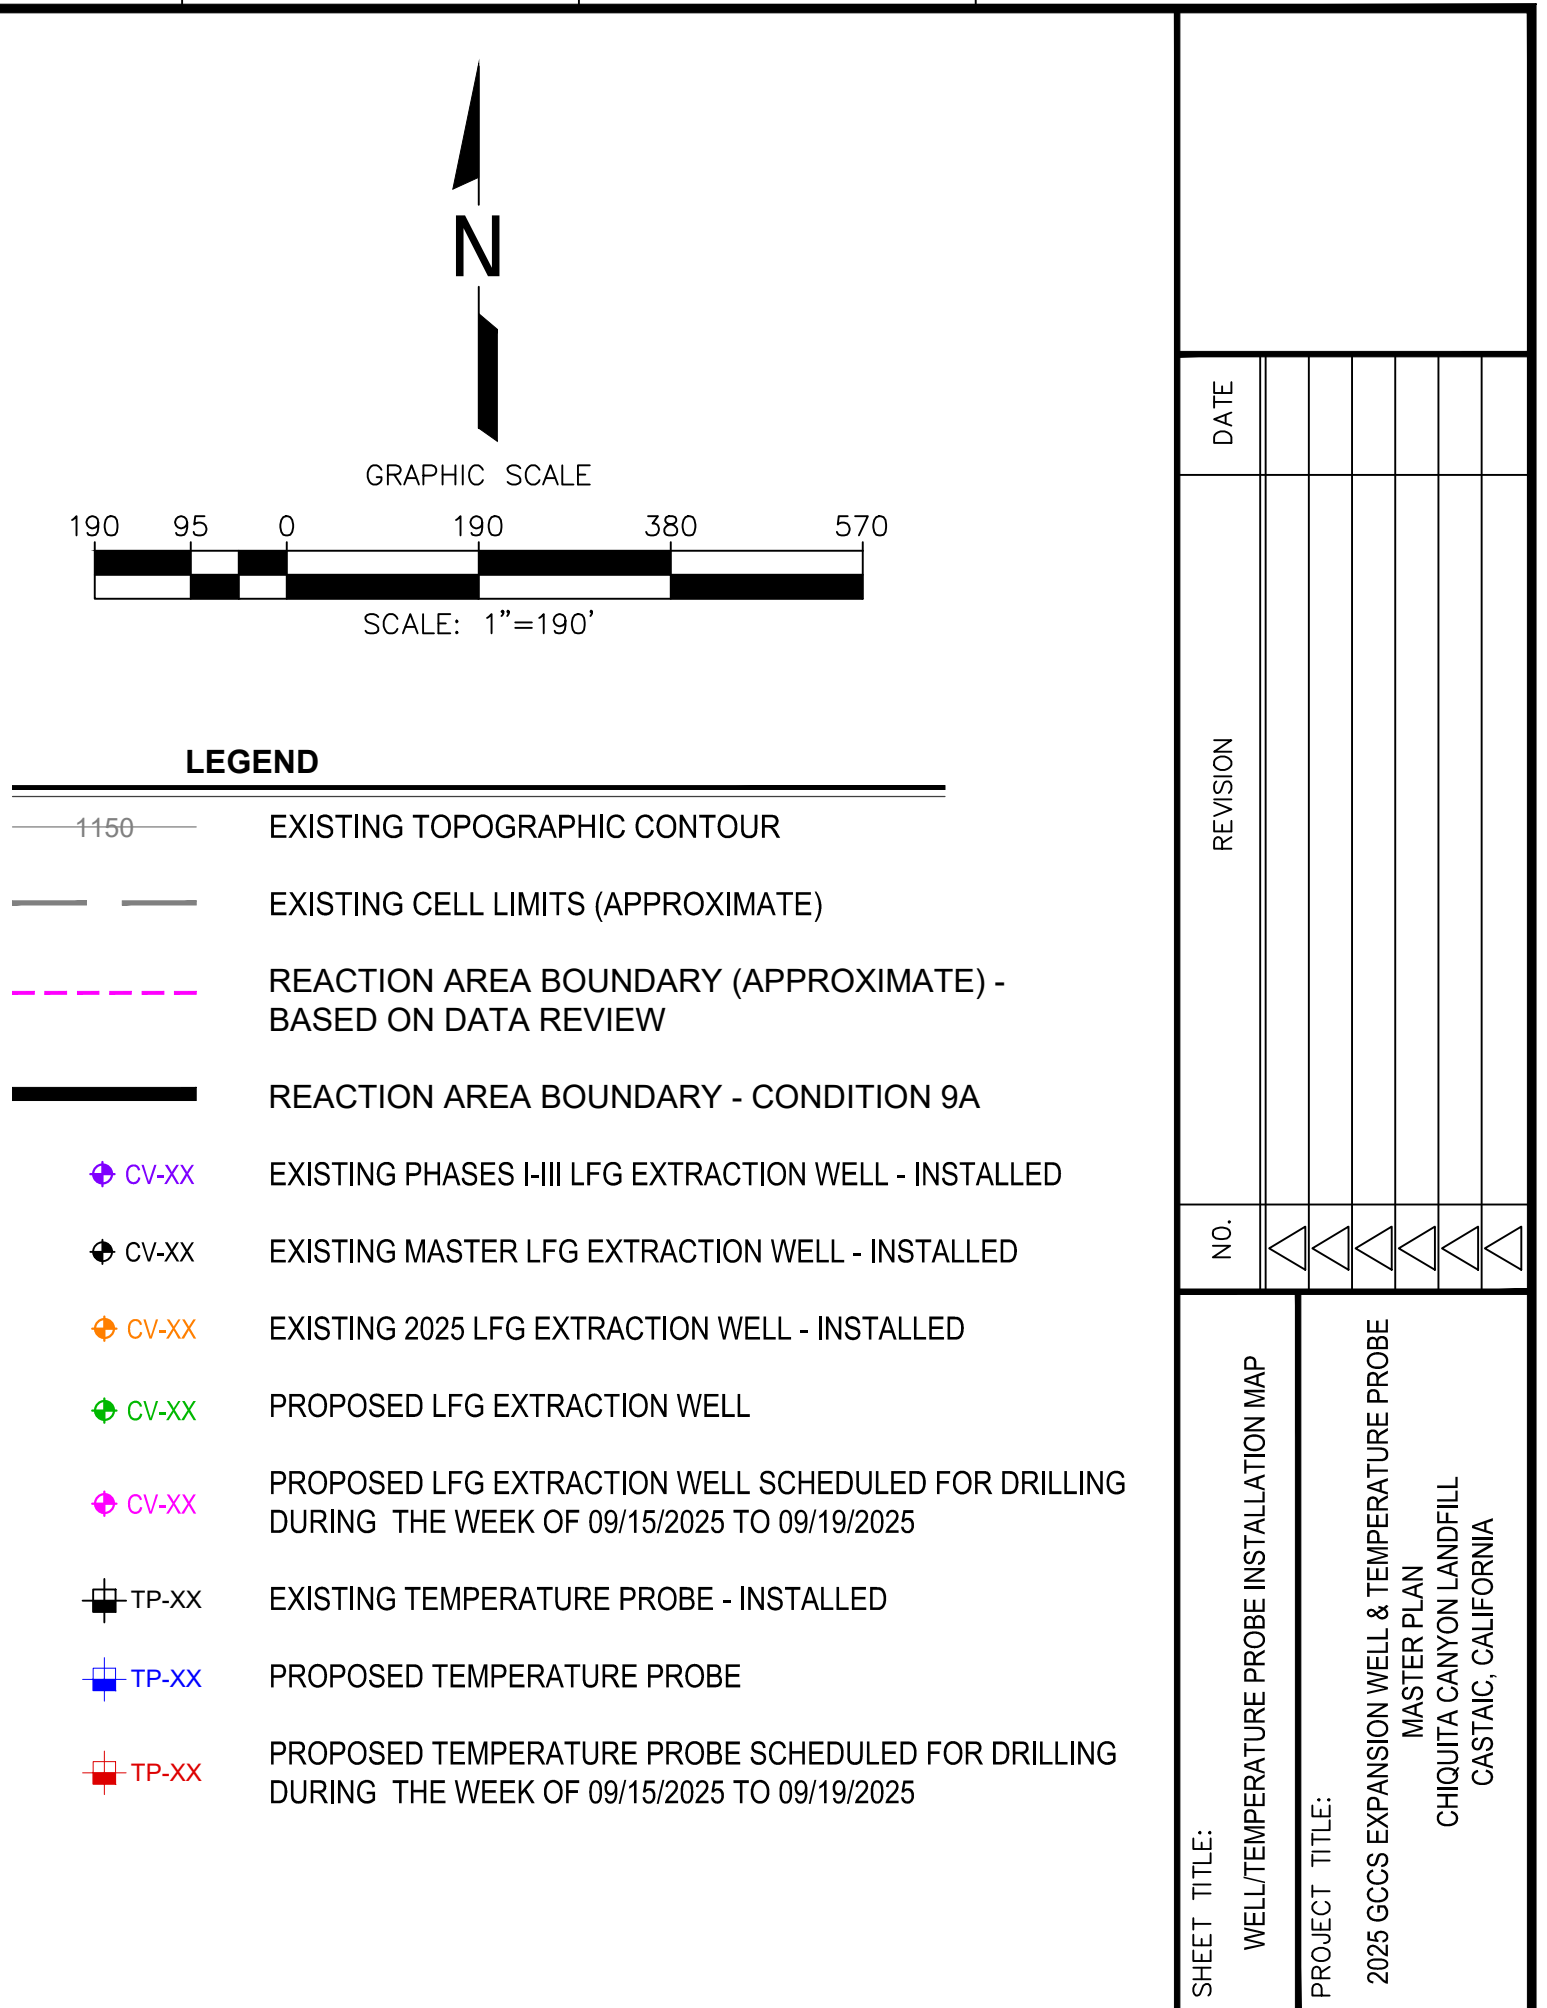

CLIENT:



CHIQUITA CANYON LANDFILL
CASTAIC, CALIFORNIA

SCS ENGINEERS ENVIRONMENTAL CONSULTANTS 3300 KILROY AIRPORT WAY, SUITE 300 LONG BEACH, CA 90806 PH: (562) 428-9544	OWN: BT	SRM	F: ENGINEERS
	CHK: BT	WCH	WCH
	PROJ. NO. 01204123.41		
	DSN. BT: JHSRM		
DATE: 09/12/2025			
SCALE: AS SHOWN			
SHEET: 1			

GENERAL DRAWING NOTES:

1. EXISTING TOPOGRAPHIC SURVEY INFORMATION SHOWN WAS PROVIDED BY PROPELLER. AERIAL PHOTOGRAPHY DATED SEPTEMBER 10, 2025.
2. NORTH ARROW SHOWN HERE IS REFERENCE TO THE CALIFORNIA STATE PLANE ZONE V COORDINATE SYSTEM, NAD 83.