

Archived: Wednesday, October 1, 2025 3:42:30 PM
From: [Kate Logan](#)
Sent: Friday, September 26, 2025 9:27:07 AM
To: KGork@ph.lacounty.gov
Cc: Todd.Thalhamer@Calrecycle.ca.gov
Subject: Chiquita Canyon Landfill – Geosynthetic Cover – Mitigation Measure 4.1
Importance: Normal
Sensitivity: None
Attachments: Figure 1 EVOH Location Through 9.19.2025.pdf, CLF Reaction Area _Reactive Wells_2025-09-19.pdf, 4050 2025-09-05 Milestone 2B Chiquita Canyon LF Isopach_August 2025.pdf

[EXTERNAL SENDER: Use caution with links/attachments]

Below is Chiquita's weekly update on the status of the installation of the EVOH 60-mil geomembrane cover at the Chiquita Canyon Landfill, in accordance with Mitigation Measure 4.1 of the LEA's Compliance Order issued May 1, 2025.


As of September 19, 2025, D&E, on behalf of Chiquita, has installed approximately 429,532 square feet of tan EVOH 60-mil geomembrane cover. No additional coverage was installed during the week of September 15, 2025 due to the inclement weather and wet subgrade conditions, though upon further review and verification, the total square footage of EVOH 60-mil geomembrane cover was increased from the previously reported estimate of approximately 423,857 square feet.


The attached site map shows the approximate extent of the geomembrane cover installed as of Friday, September 19, 2025, as well as the geomembrane coverage described in the draft workplan for extension of the geomembrane cover area dated May 16, 2025, and submitted to the LEA and DTSC. Chiquita is continuing to develop a revised draft workplan to incorporate a phased installation of additional geomembrane cover in response to comments received from the LEA, DTSC, CalRecycle, and the US EPA, for submittal on October 3, 2025. Also attached to this submission are the August 2025 monthly isopach map and a figure identifying wells showing signs of reaction as of September 19, 2025. Due to technical limitations, we are currently unable to create one figure including all of this data.

Thanks,


Kate Logan
Regional Engineer
Chiquita Canyon Landfill
29201 Henry Mayo Dr.
Castaic, CA 91384
(m) (346) 807-5547
Kate.Logan@WasteConnections.com



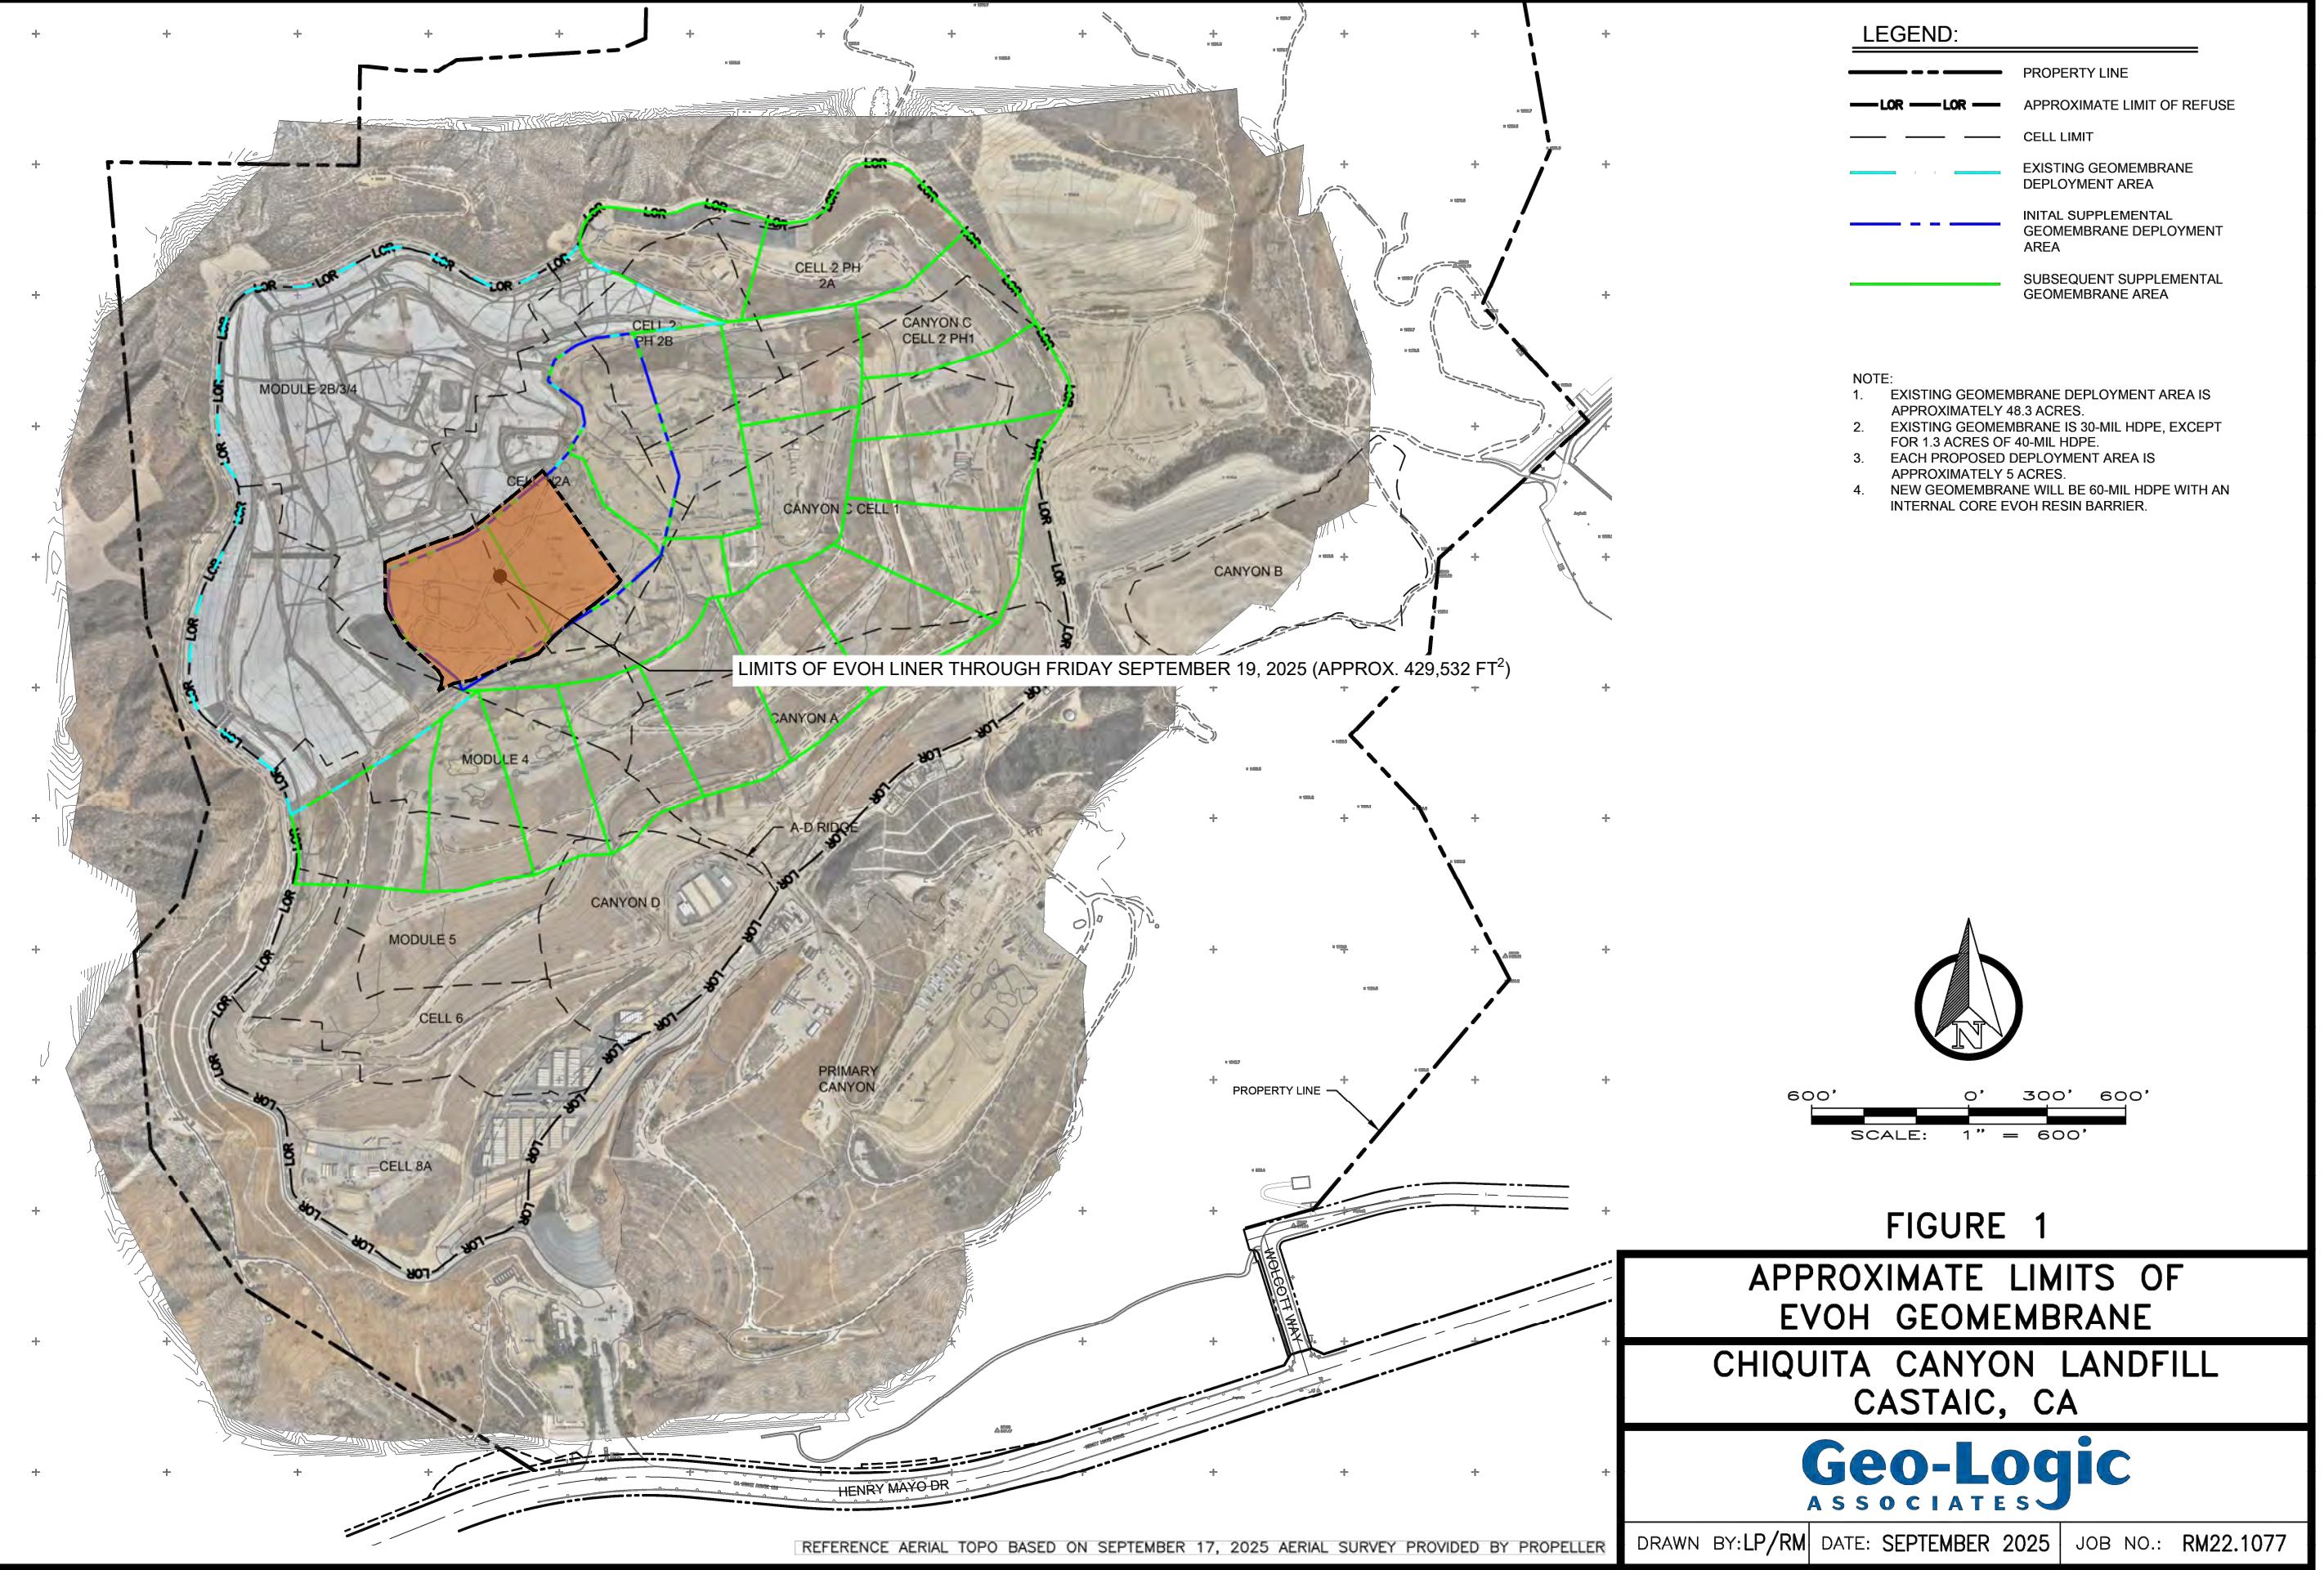

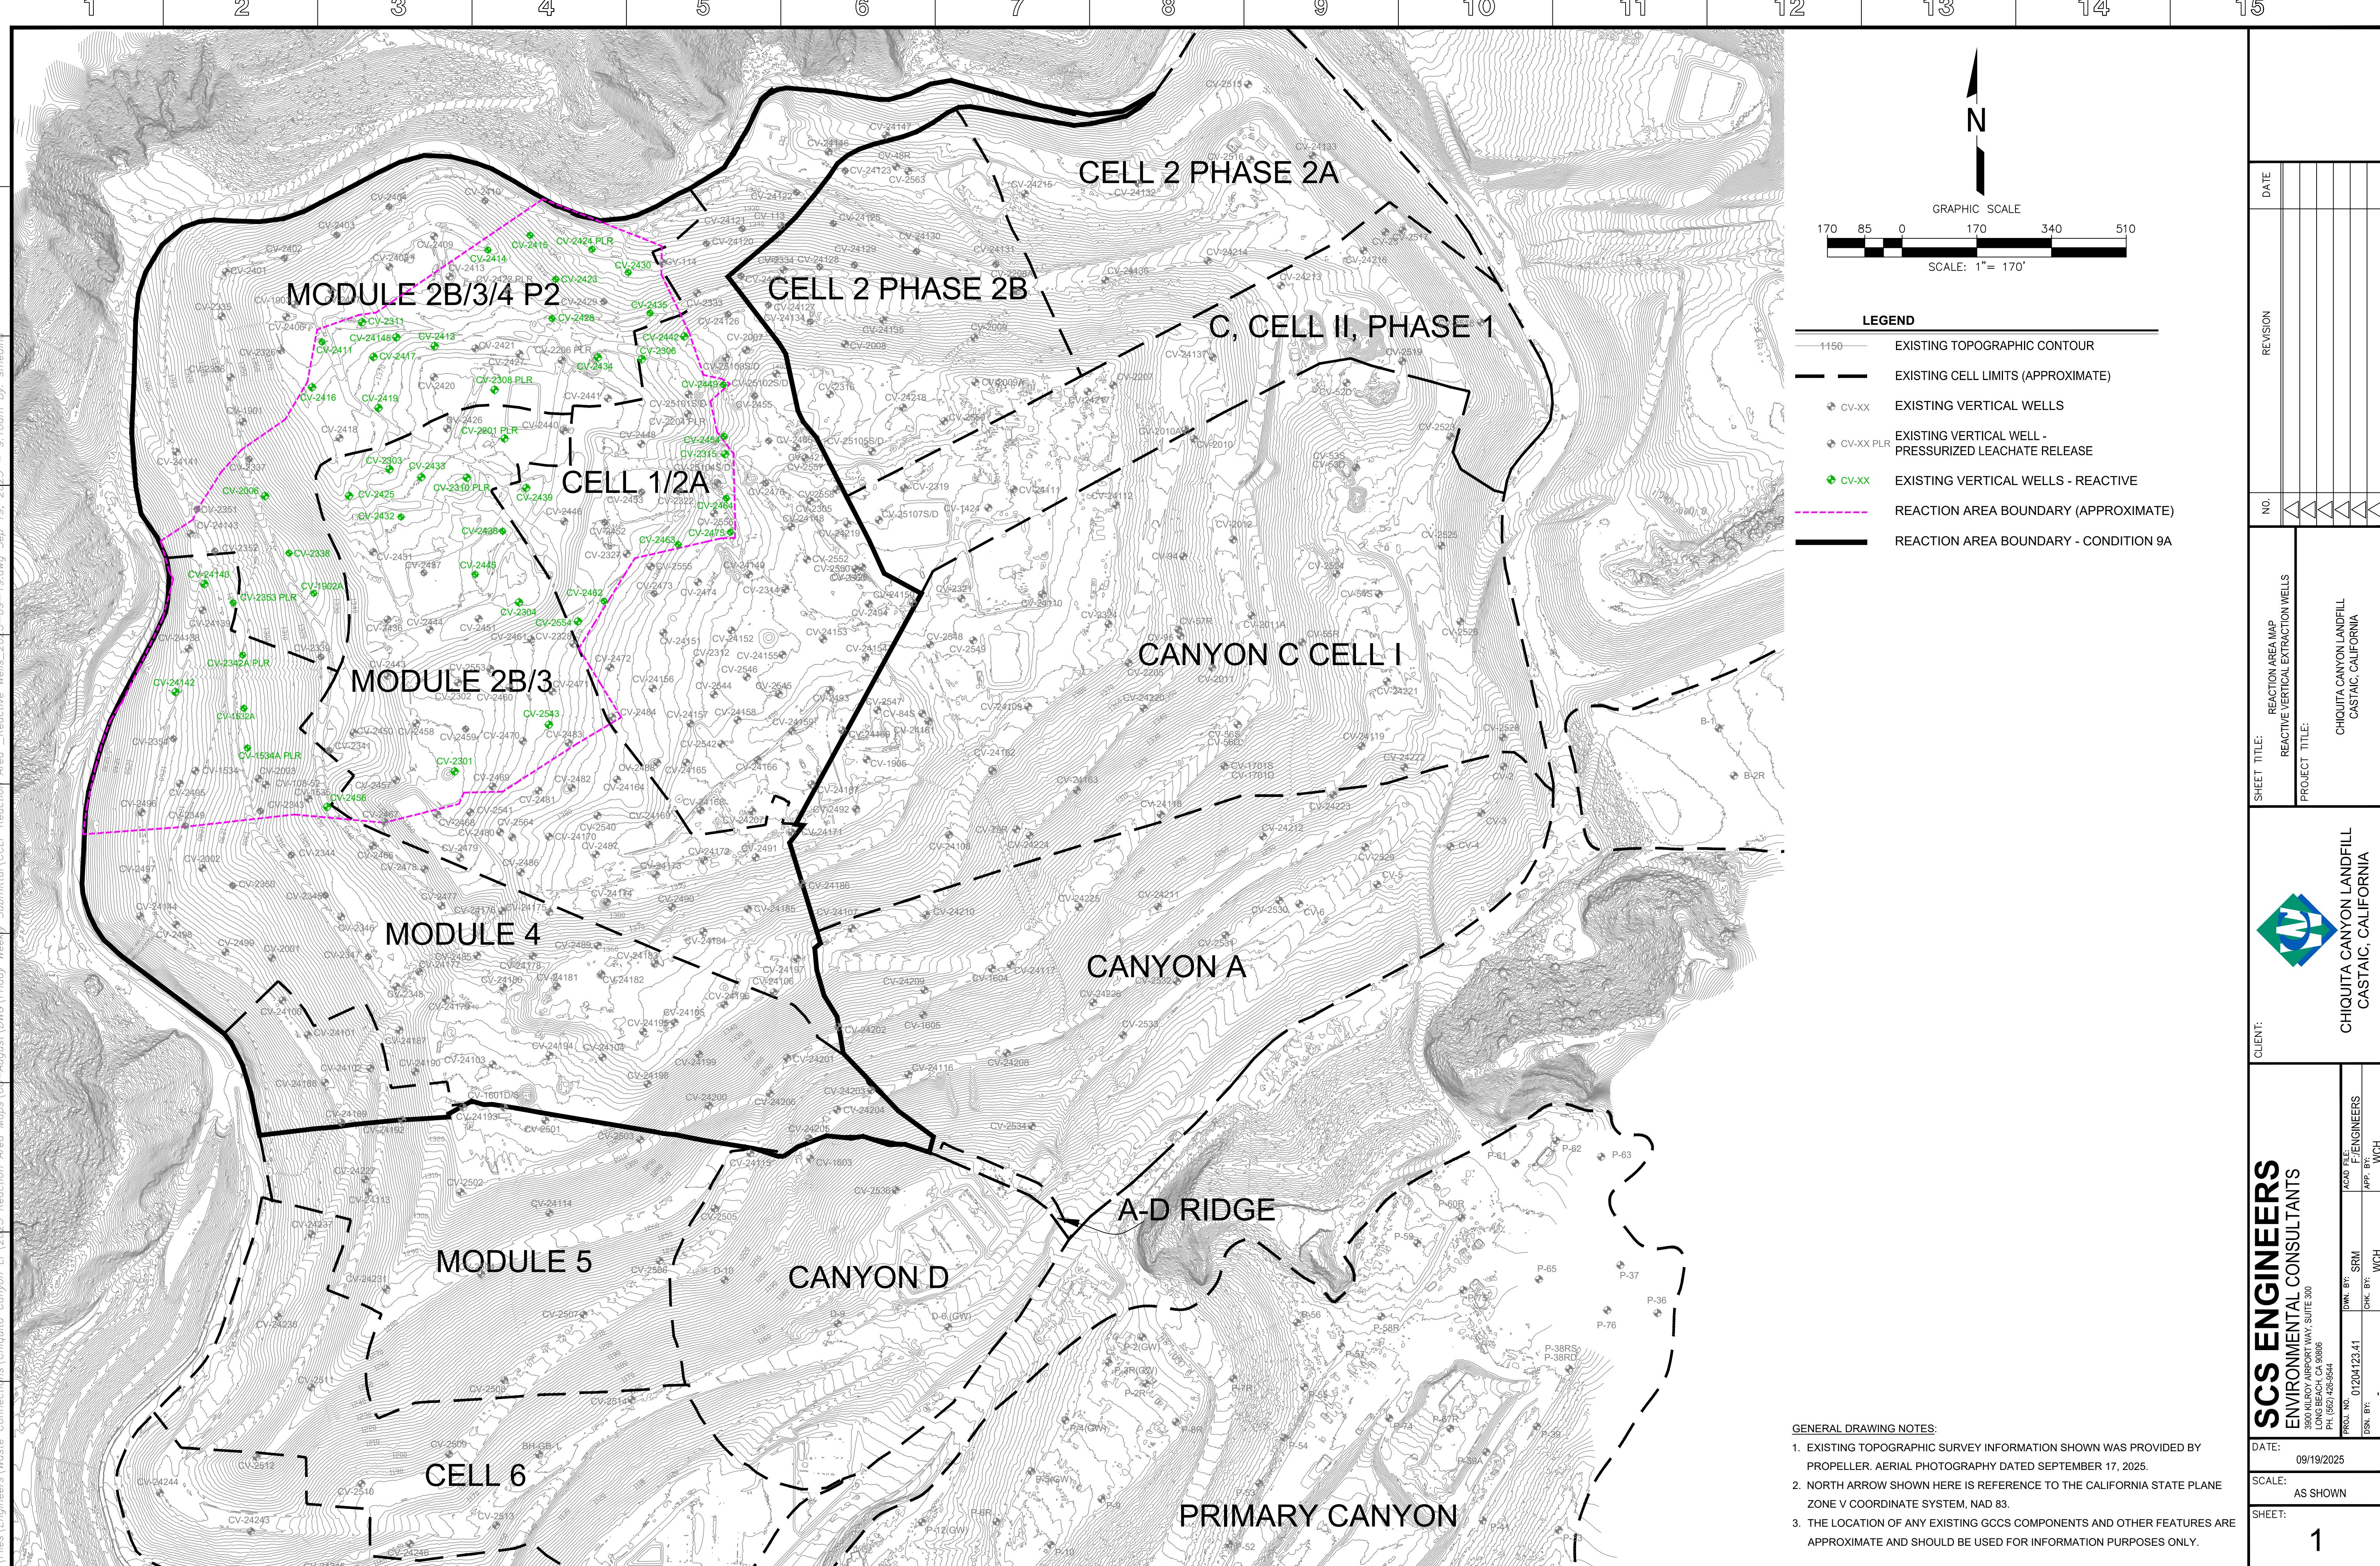

Chiquita Canyon Landfill - Isopach

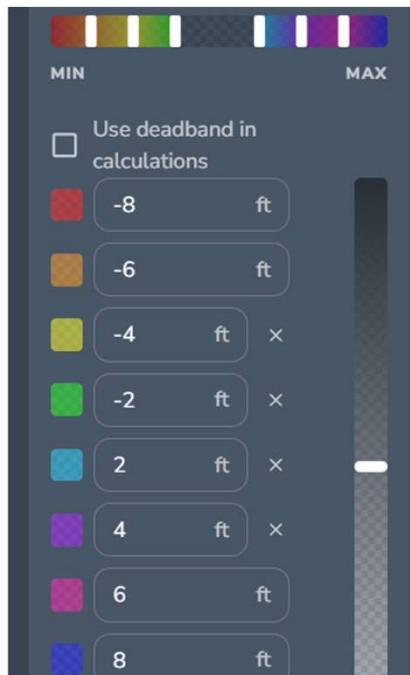

August 27, 2025 Survey Image. July 31, 2025 vs August 27, 2025