


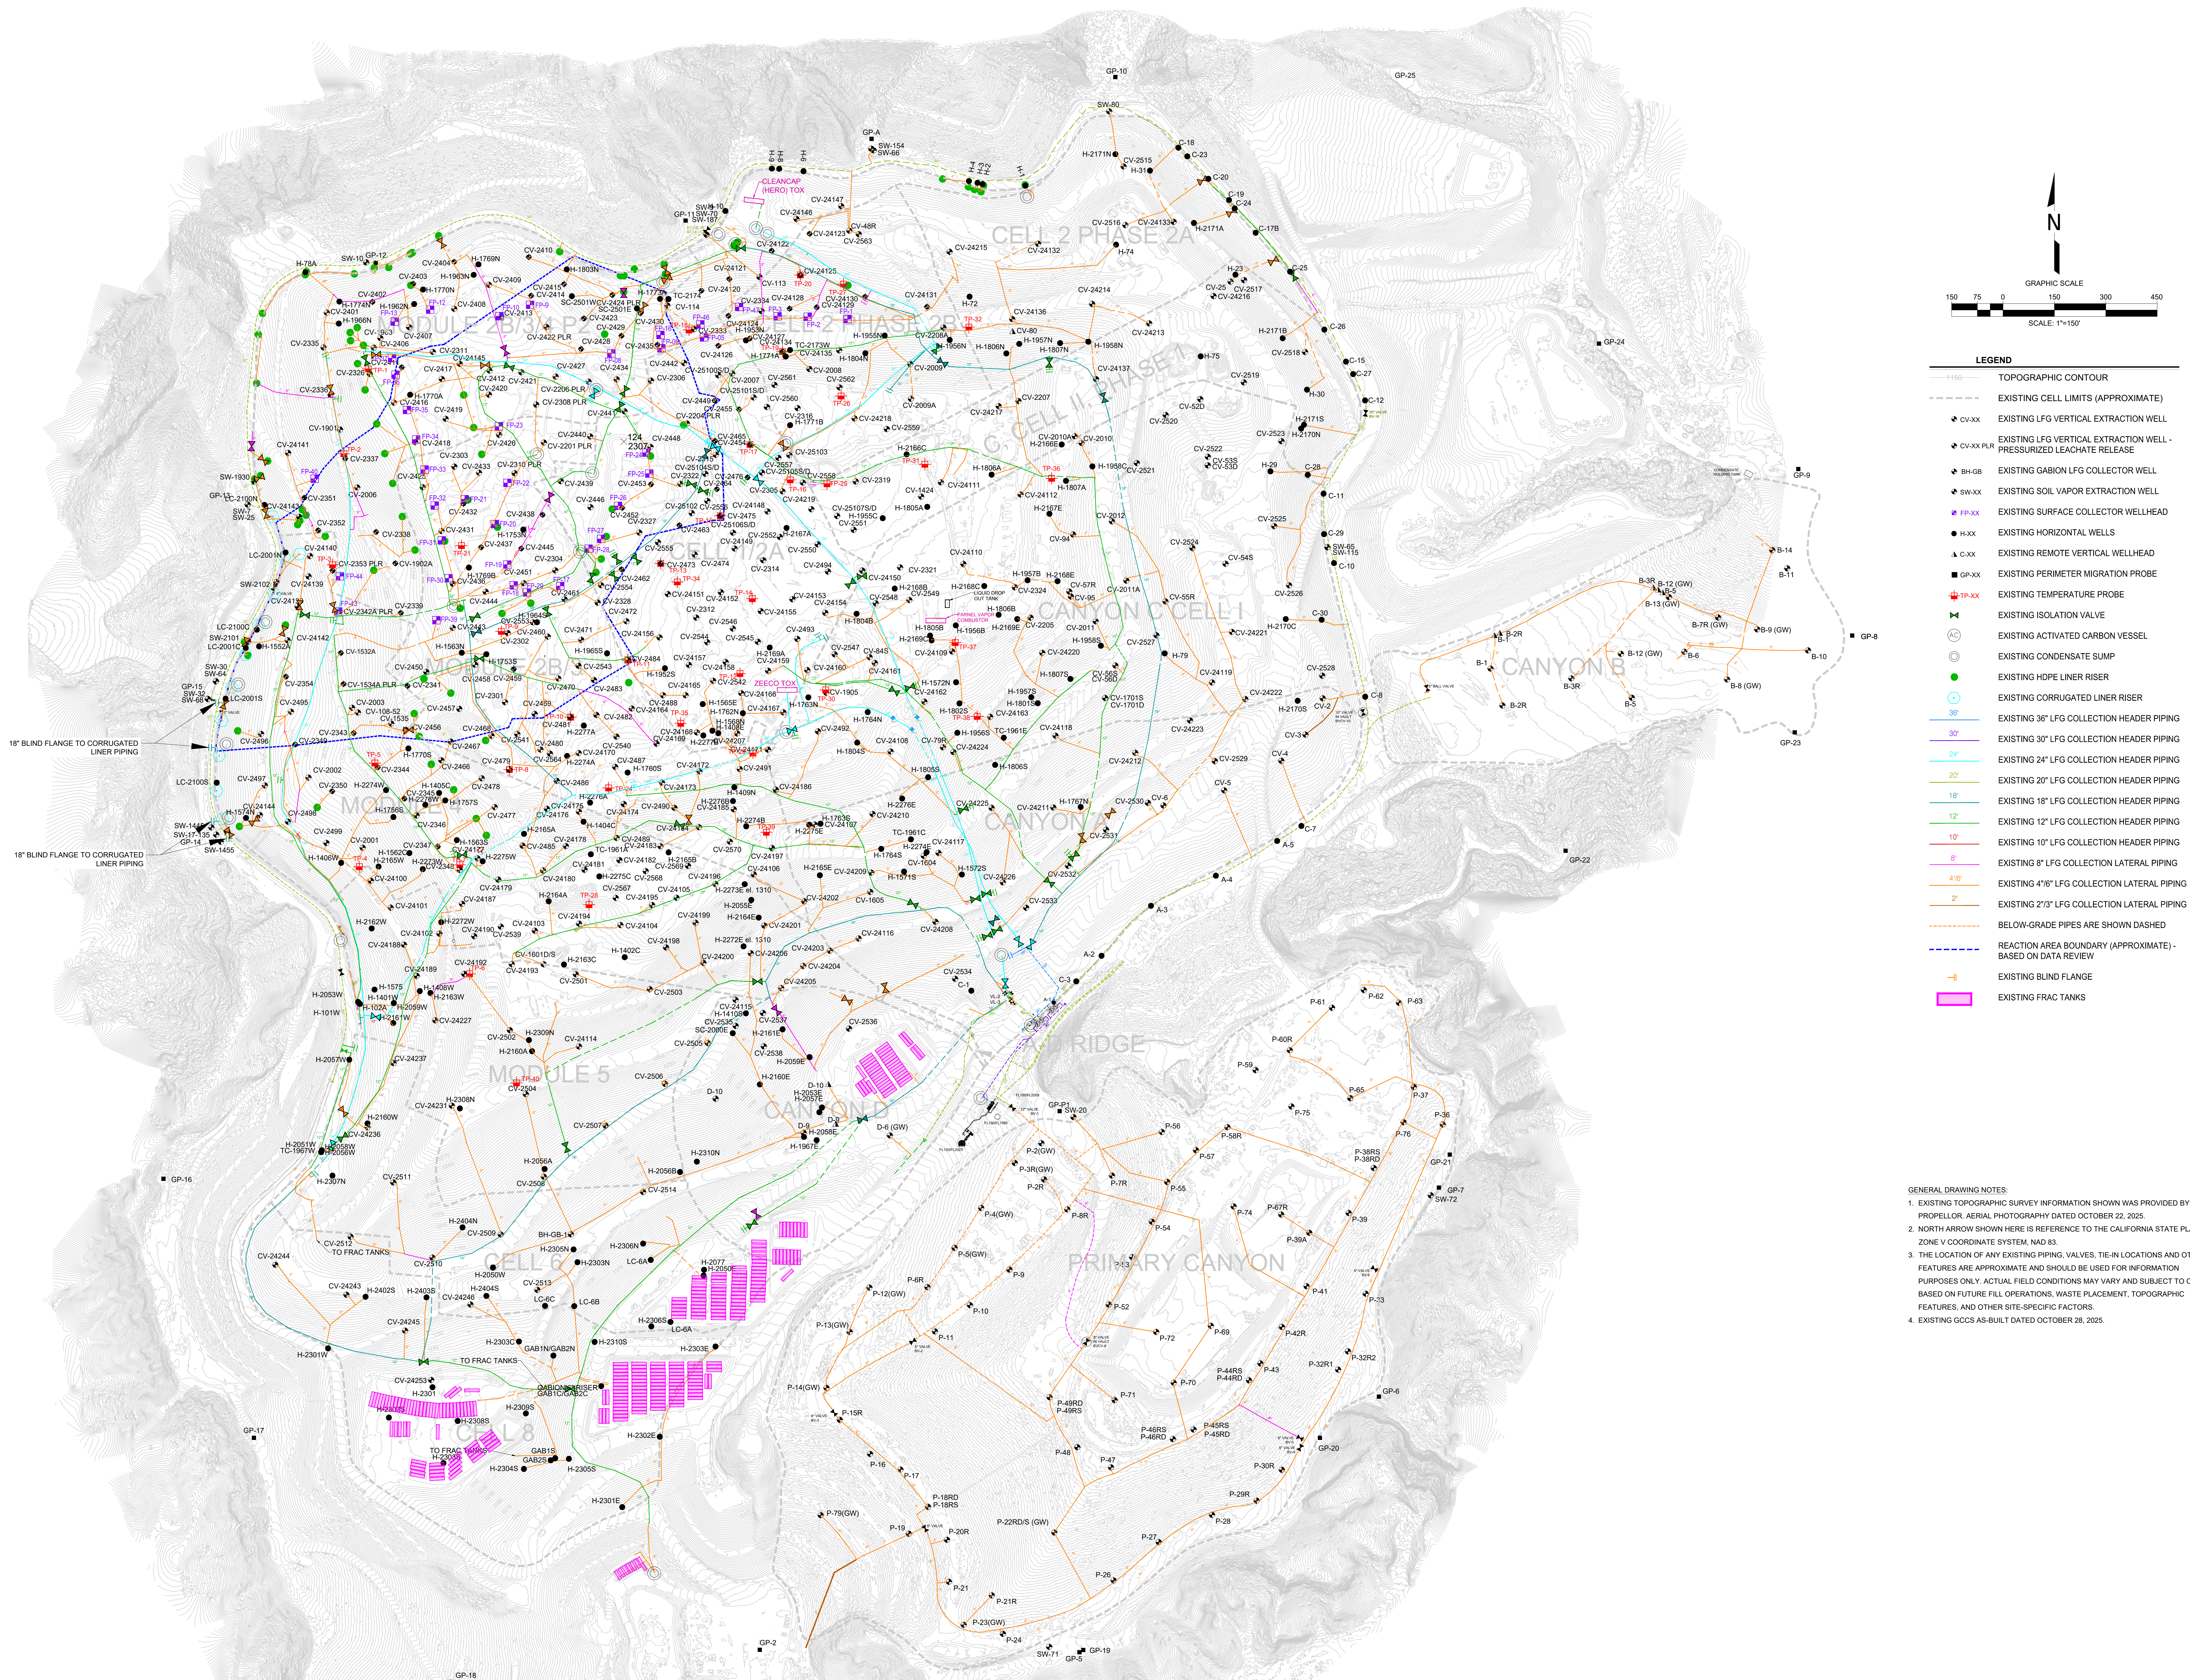

LEGEND