

**Archived:** Thursday, November 6, 2025 12:40:10 PM  
**From:** [Medina, Steven](#)  
**Sent:** Friday, October 31, 2025 12:04:45 PM  
**To:** [bchen@aqmd.gov](mailto:bchen@aqmd.gov)  
**Cc:** [Haley, William \(Bill\)](#)  
**Subject:** Re: Case No. 6177-4 Stipulated Order for Abatement – Well Drilling Update  
**Importance:** Normal  
**Sensitivity:** None  
**Attachments:** Outlook-bjhfulpk.png Outlook-bwiiggbw.png 2025 CCLF GCCS Expan Master Plan\_Proposed LFG Extraction Well and Temp Probe Map\_2025-10-31.pdf

---

[EXTERNAL SENDER: Use caution with links/attachments]

---

All,

In accordance with Condition 15(c) of the Stipulated Order, below is the up-to-date construction summary for the Chiquita Canyon Landfill 2025 GCCS Expansion Master Plan Project.

**As of 10/27/2025 to 10/31/2025 - Installation of LFG vertical extraction wells and temperature probes included:**

1. CV-2565
2. CV-2567
3. TP-22

During 10/27/2025 to 10/31/2025, Chiquita completed the installation of two (2) vertical LFG extraction wells. The total count of vertical LFG extraction wells installed from December 6, 2023 (the start date of the GCCS Master Expansion) through today is three hundred twelve (312).

During 10/27/2025 to 10/31/2025, Chiquita completed the installation of one (1) temperature probe. The total count of temperature probes installed from February 26th, 2024 (the start date of the temperature probe installations) through today is thirty-nine (39).

**The wells and temperature probes scheduled for drilling during the week of 11/03/2025 to 11/07/2025 are as follows (subject to change):**

**Rig (Continuum):** Drilling to resume November 10, 2025, after crew rotation.

**Temperature Probe Rig (Boart Longyear):** Temperature probe (TP) drilling resumed during the week of October 27, 2025. For the week of November 3, 2025, both TP and SVE drilling activities will be on hold while the drilling crew is on rotation. Drilling is scheduled to resume on November 10, 2025

Regards,

**STEVEN** Ruben Medina, **E.I.T.**

Staff Professional



**SCS Engineers**

3900 Kilroy Airport Way, Suite 300  
Long Beach, CA 90806

858-204-4342 (c)  
[SMedina@scsengineers.com](mailto:SMedina@scsengineers.com)

**Driven by Client Success**  
[www.scsengineers.com](http://www.scsengineers.com)



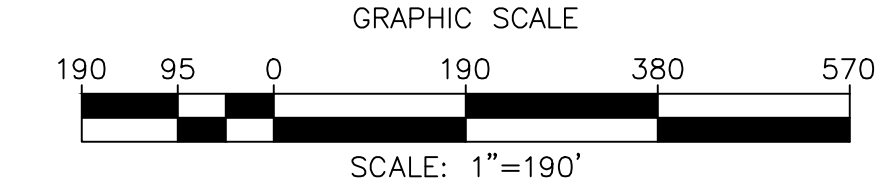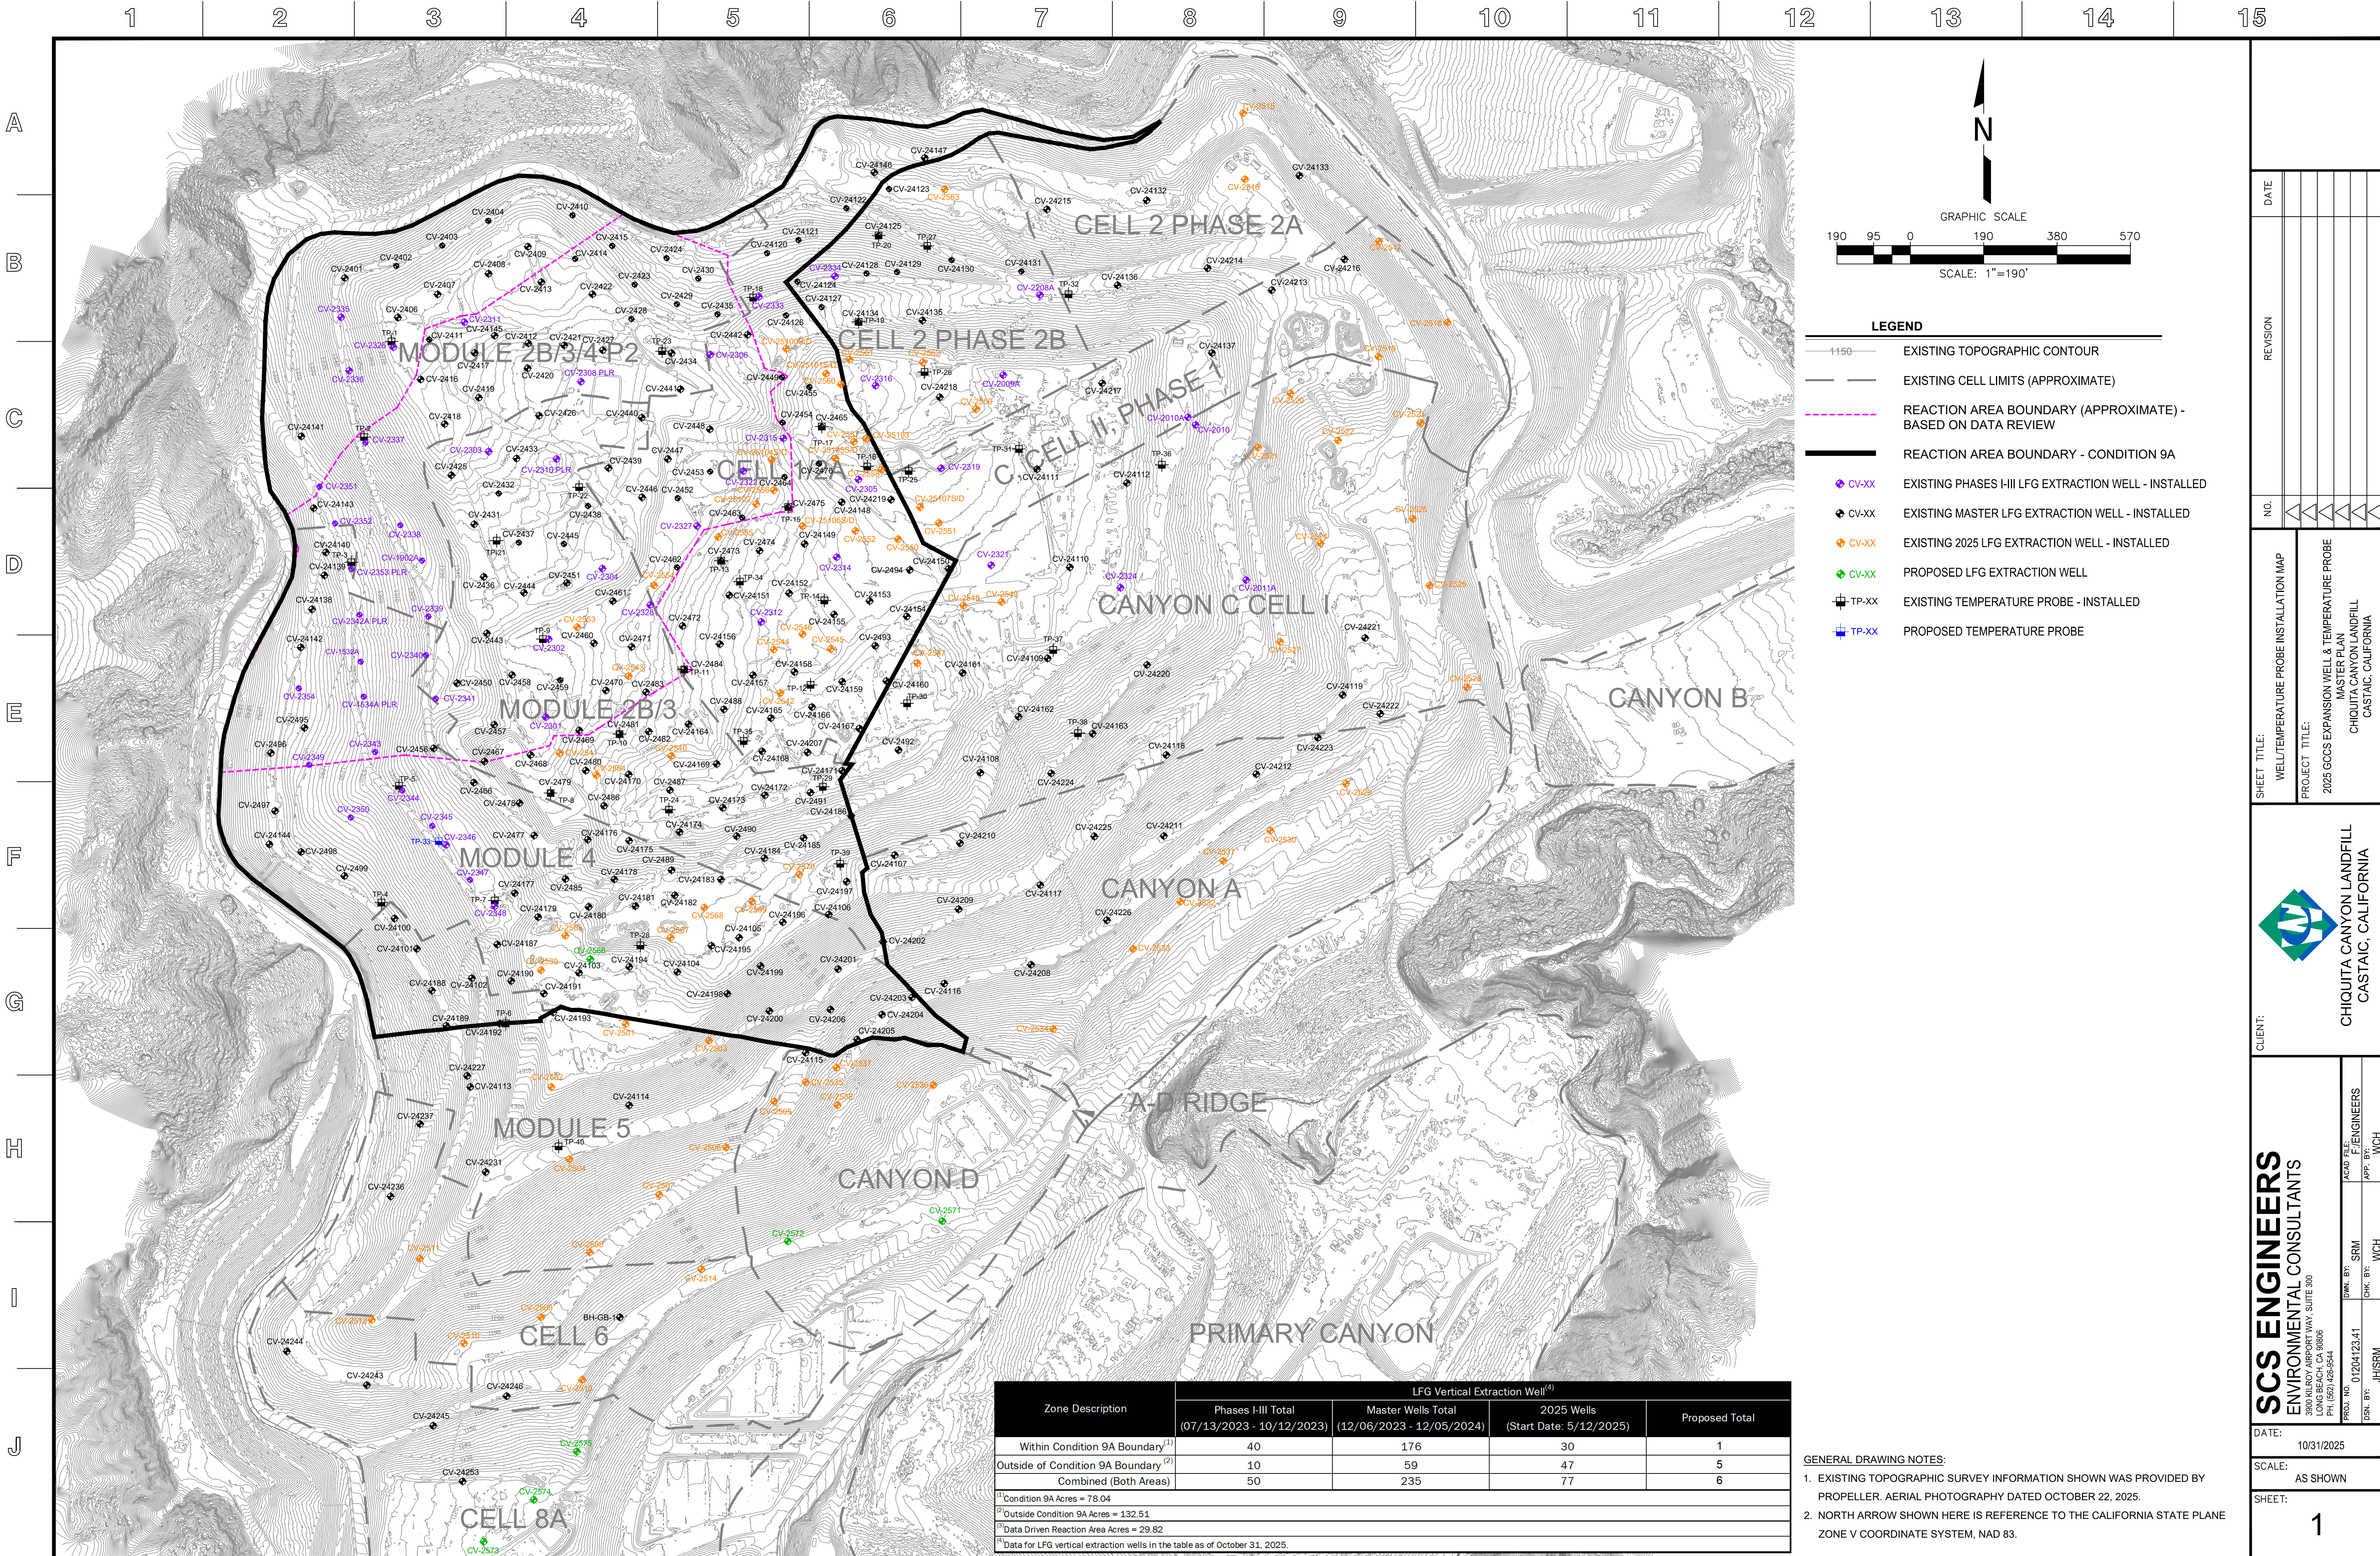

- LEGEND**
- 1150 EXISTING TOPOGRAPHIC CONTOUR
  - EXISTING CELL LIMITS (APPROXIMATE)
  - REACTION AREA BOUNDARY (APPROXIMATE) - BASED ON DATA REVIEW
  - REACTION AREA BOUNDARY - CONDITION 9A
  - EXISTING PHASES I-III LFG EXTRACTION WELL - INSTALLED
  - EXISTING MASTER LFG EXTRACTION WELL - INSTALLED
  - EXISTING 2025 LFG EXTRACTION WELL - INSTALLED
  - PROPOSED LFG EXTRACTION WELL
  - EXISTING TEMPERATURE PROBE - INSTALLED
  - PROPOSED TEMPERATURE PROBE

| Zone Description                                | LFG Vertical Extraction Well <sup>(4)</sup>     |                                                 |                                       |                |
|-------------------------------------------------|-------------------------------------------------|-------------------------------------------------|---------------------------------------|----------------|
|                                                 | Phases I-III Total<br>(07/13/2023 - 10/12/2023) | Master Wells Total<br>(12/06/2023 - 12/05/2024) | 2025 Wells<br>(Start Date: 5/12/2025) | Proposed Total |
| Within Condition 9A Boundary <sup>(1)</sup>     | 40                                              | 176                                             | 30                                    | 1              |
| Outside of Condition 9A Boundary <sup>(2)</sup> | 10                                              | 59                                              | 47                                    | 5              |
| Combined (Both Areas)                           | 50                                              | 235                                             | 77                                    | 6              |

<sup>(1)</sup>Condition 9A Acres = 78.04  
<sup>(2)</sup>Outside Condition 9A Acres = 132.51  
<sup>(3)</sup>Data Driven Reaction Area Acres = 29.82  
<sup>(4)</sup>Data for LFG vertical extraction wells in the table as of October 31, 2025.

**GENERAL DRAWING NOTES:**

- EXISTING TOPOGRAPHIC SURVEY INFORMATION SHOWN WAS PROVIDED BY PROPELLER. AERIAL PHOTOGRAPHY DATED OCTOBER 22, 2025.
- NORTH ARROW SHOWN HERE IS REFERENCE TO THE CALIFORNIA STATE PLANE ZONE V COORDINATE SYSTEM, NAD 83.

DATE

REVISION

NO.

SHEET TITLE:  
WELL/TEMPERATURE PROBE INSTALLATION MAP

PROJECT TITLE:  
2025 GCCS EXPANSION WELL & TEMPERATURE PROBE  
MASTER PLAN  
CHIUQUITA CANYON LANDFILL  
CASTAIC, CALIFORNIA

CLIENT:

SCS ENGINEERS  
ENVIRONMENTAL CONSULTANTS  
15000 WILSON AVENUE, SUITE 300  
LONG BEACH, CA 90806  
PH: (562) 426-9544

DATE:

10/31/2025

SCALE:

AS SHOWN

SHEET:

1

ACAD FILE:  
F:\ENGINEERS

APP. BY:  
WCH

CHK. BY:  
WCH

APP. BY:  
WCH

CHK. BY:  
WCH

C:\Users\5160sr\Desktop\2025 CCLF GCCS Expan Master Plan\_Proposed LFG Extraction Well and Temp Probe Map\_2025-10-31.dwg Oct 31, 2025 - 11:50am By: smedica