

Archived: Thursday, November 13, 2025 1:27:16 PM
From: [Medina, Steven](#)
Sent: Friday, November 7, 2025 10:45:45 AM
To: bchen@aqmd.gov
Cc: [Haley, William \(Bill\)](#)
Subject: Re: Case No. 6177-4 Stipulated Order for Abatement – Well Drilling Update
Importance: Normal
Sensitivity: None
Attachments: Outlook-bjhfulpk.png Outlook-bwiiggbw.png Outlook-fzdw4153.png 2025 CCLF GCCS Expan Master Plan_Proposed LFG Extraction Well and Temp Probe Map_2025-11-07.pdf

[EXTERNAL SENDER: Use caution with links/attachments]

All,

In accordance with Condition 15(c) of the Stipulated Order, below is the up-to-date construction summary for the Chiquita Canyon Landfill 2025 GCCS Expansion Master Plan Project.

During 11/03/2025 to 11/07/2025, Chiquita did not install any new vertical LFG extraction wells due to a drilling crew rotation, as projected in last week's submittal. As a result, the total count of vertical LFG extraction wells installed from December 6, 2023 (the start date of the GCCS Master Expansion) through today is three hundred twelve (312).

During 11/03/2025 to 11/07/2025, Chiquita did not install any new temperature probes due to a drilling crew rotation, as projected in last week's submittal. As a result, the total count of temperature probes installed from February 26th, 2024 (the start date of the temperature probe installations) through today is thirty-nine (39).

The wells and temperature probes scheduled for drilling during the week of 11/10/2025 to 11/14/2025 are as follows (subject to change):

Rig (Continuum): CV-2566, CV-2571, CV-2572, CV-2574, CV-2575

Temperature Probe Rig (Boart Longyear): Drilling of the temperature probes is currently on hold due to ongoing Soil Vapor Extraction (SVE) well drilling, which is scheduled to resume the week of November 10. Drilling of the temperature probes will resume following the completion and installation of the SVE wells.

Regards,

STEVEN Ruben Medina, **E.I.T.**

Staff Professional

SCS Engineers

3900 Kilroy Airport Way, Suite 300

Long Beach, CA 90806


858-204-4342 (c)

SMedina@scsengineers.com

Driven by Client Success

www.scsengineers.com

□

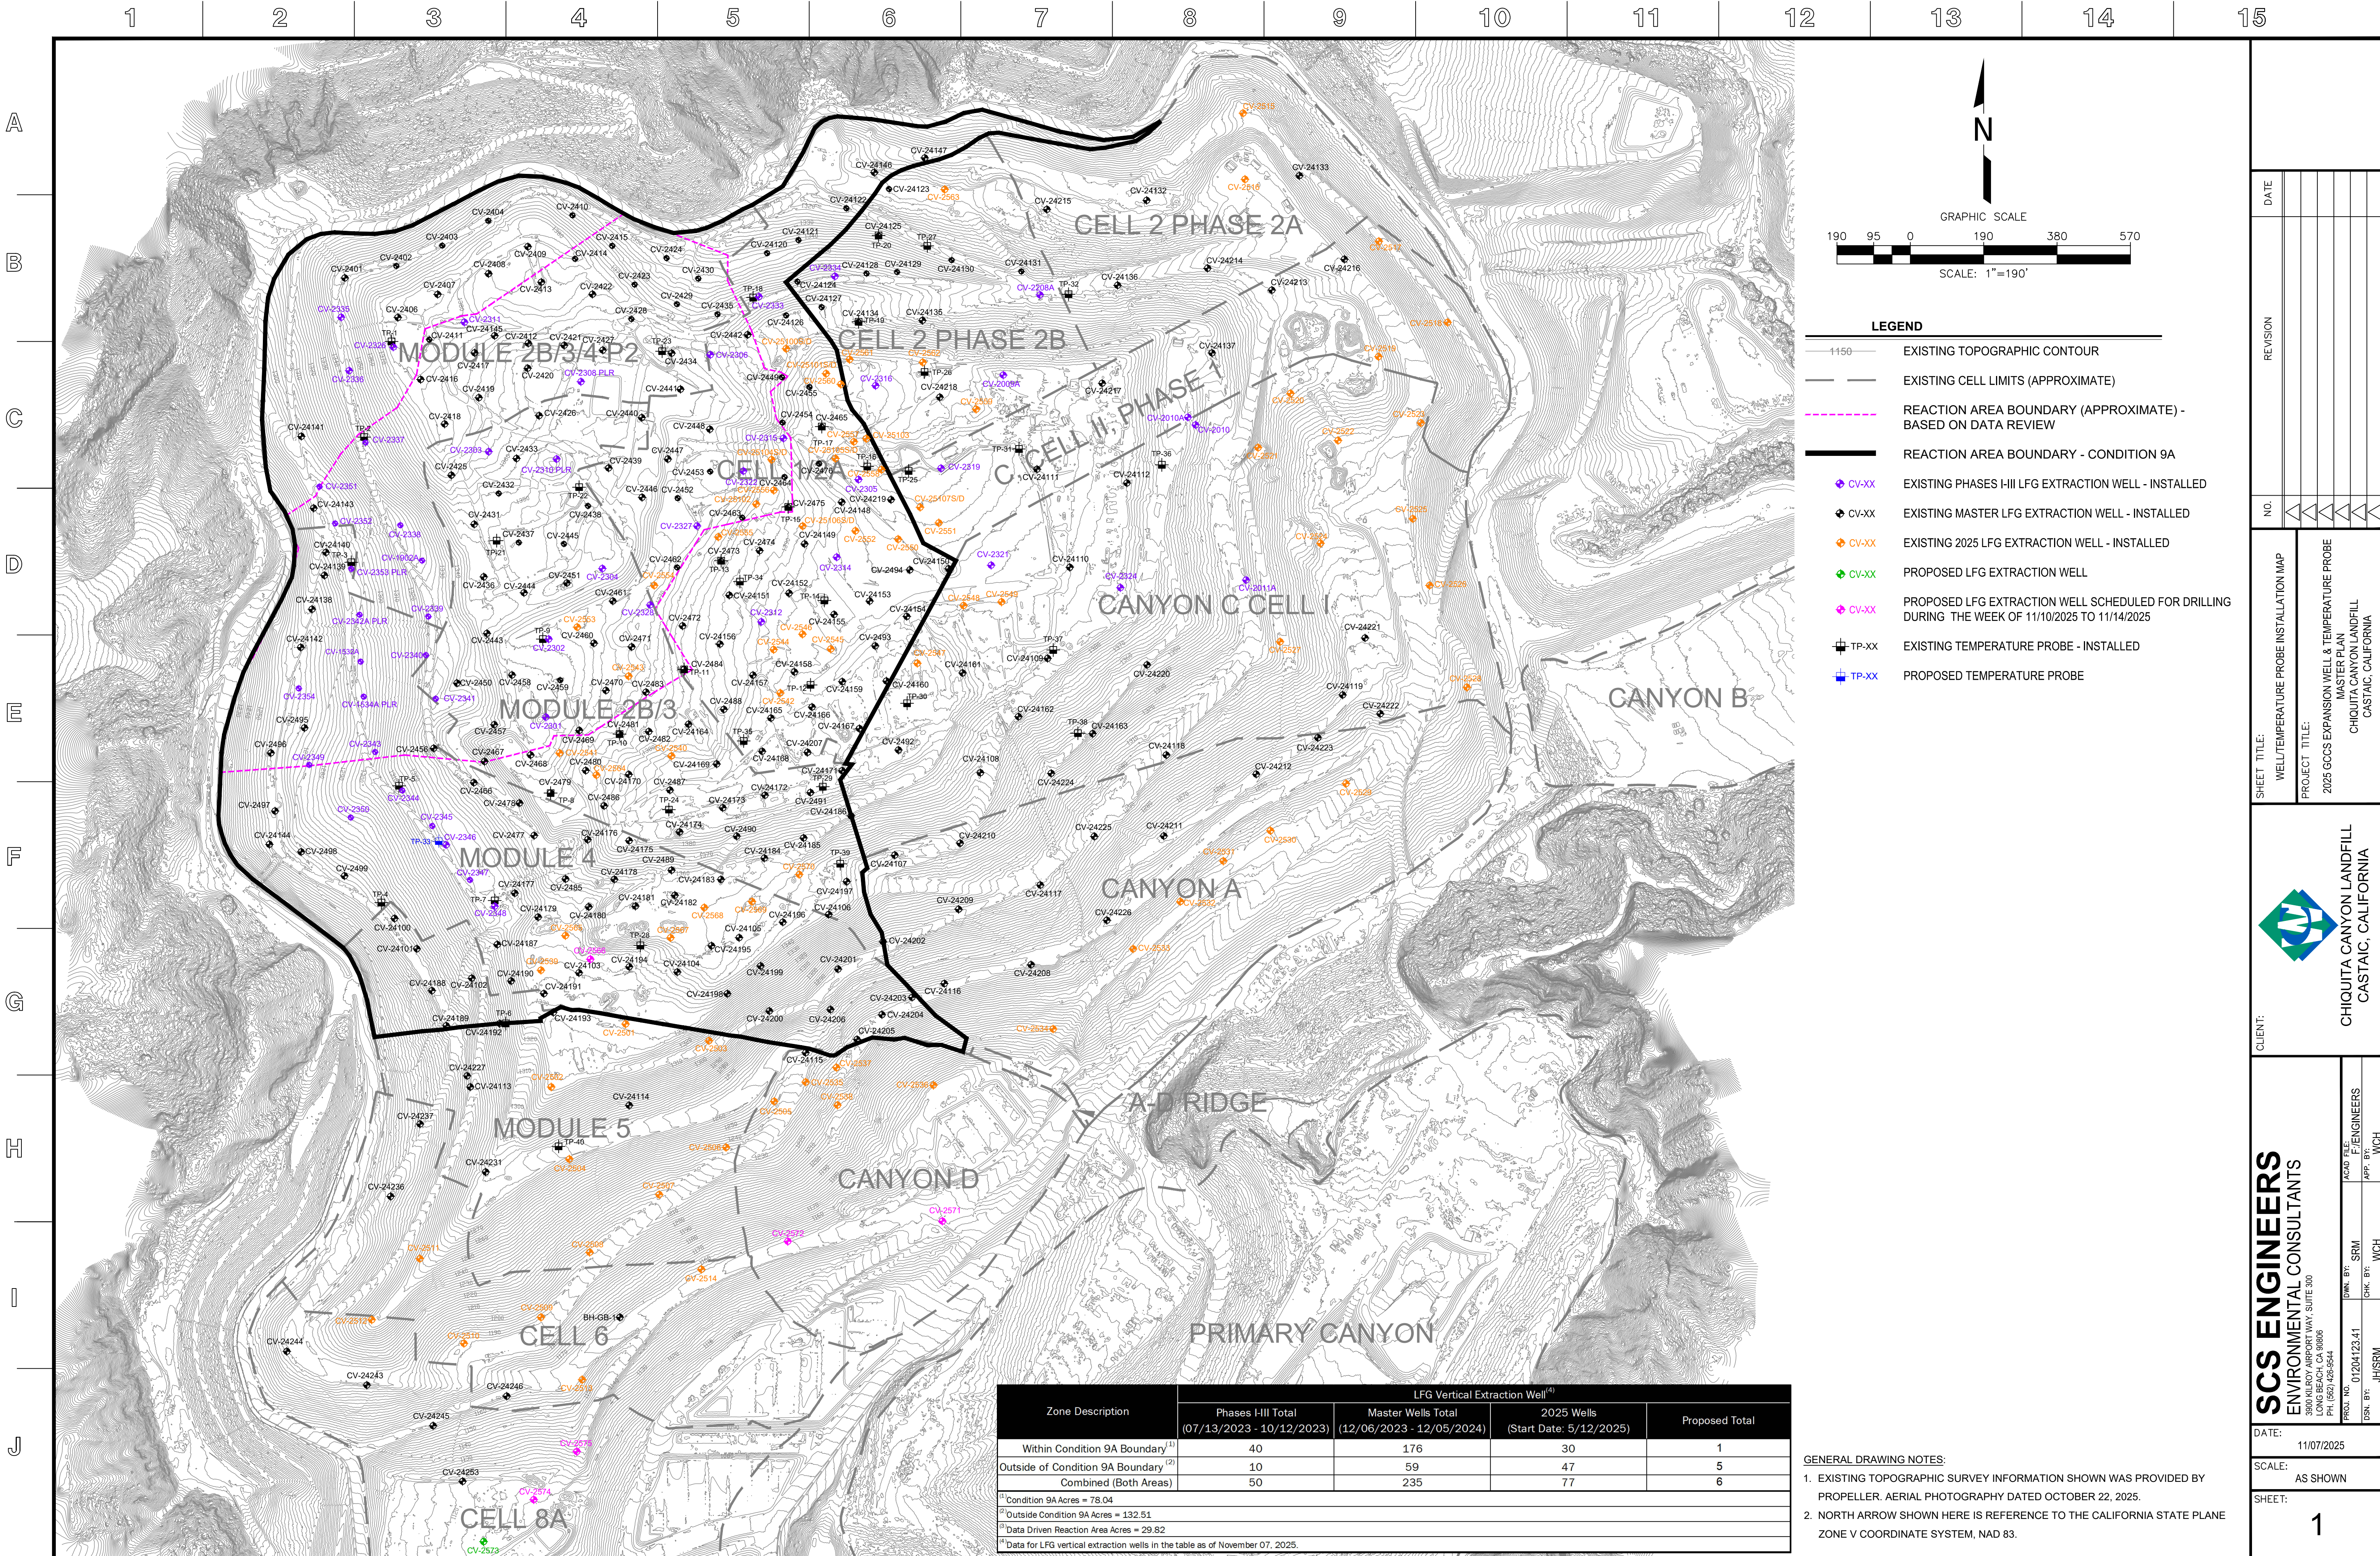

Zone Description	LFG Vertical Extraction Well ⁽¹⁾			
	Phases I-III Total (07/13/2023 - 10/12/2023)	Master Wells Total (12/06/2023 - 12/05/2024)	2025 Wells (Start Date: 5/12/2025)	Proposed Total
Within Condition 9A Boundary ⁽¹⁾	40	176	30	1
Outside of Condition 9A Boundary ⁽²⁾	10	59	47	5
Combined (Both Areas)	50	235	77	6

⁽¹⁾ Condition 9A Acres = 78.04
⁽²⁾ Outside Condition 9A Acres = 132.51
⁽³⁾ Data Driven Reaction Area Acres = 29.82
⁽⁴⁾ Data for LFG vertical extraction wells in the table as of November 07, 2025.

CLIENT:

SCS ENGINEERS
ENVIRONMENTAL CONSULTANTS
LONG BEACH, CA 90806
PH: (562) 426-9544

PROJECT TITLE:
2025 GCCS EXPANSION WELL & TEMPERATURE PROBE
MASTER PLAN
CHICUITA CANYON LANDFILL
CASTAIC, CALIFORNIA

DATE: 11/07/2025

SCALE: AS SHOWN

SHEET: 1