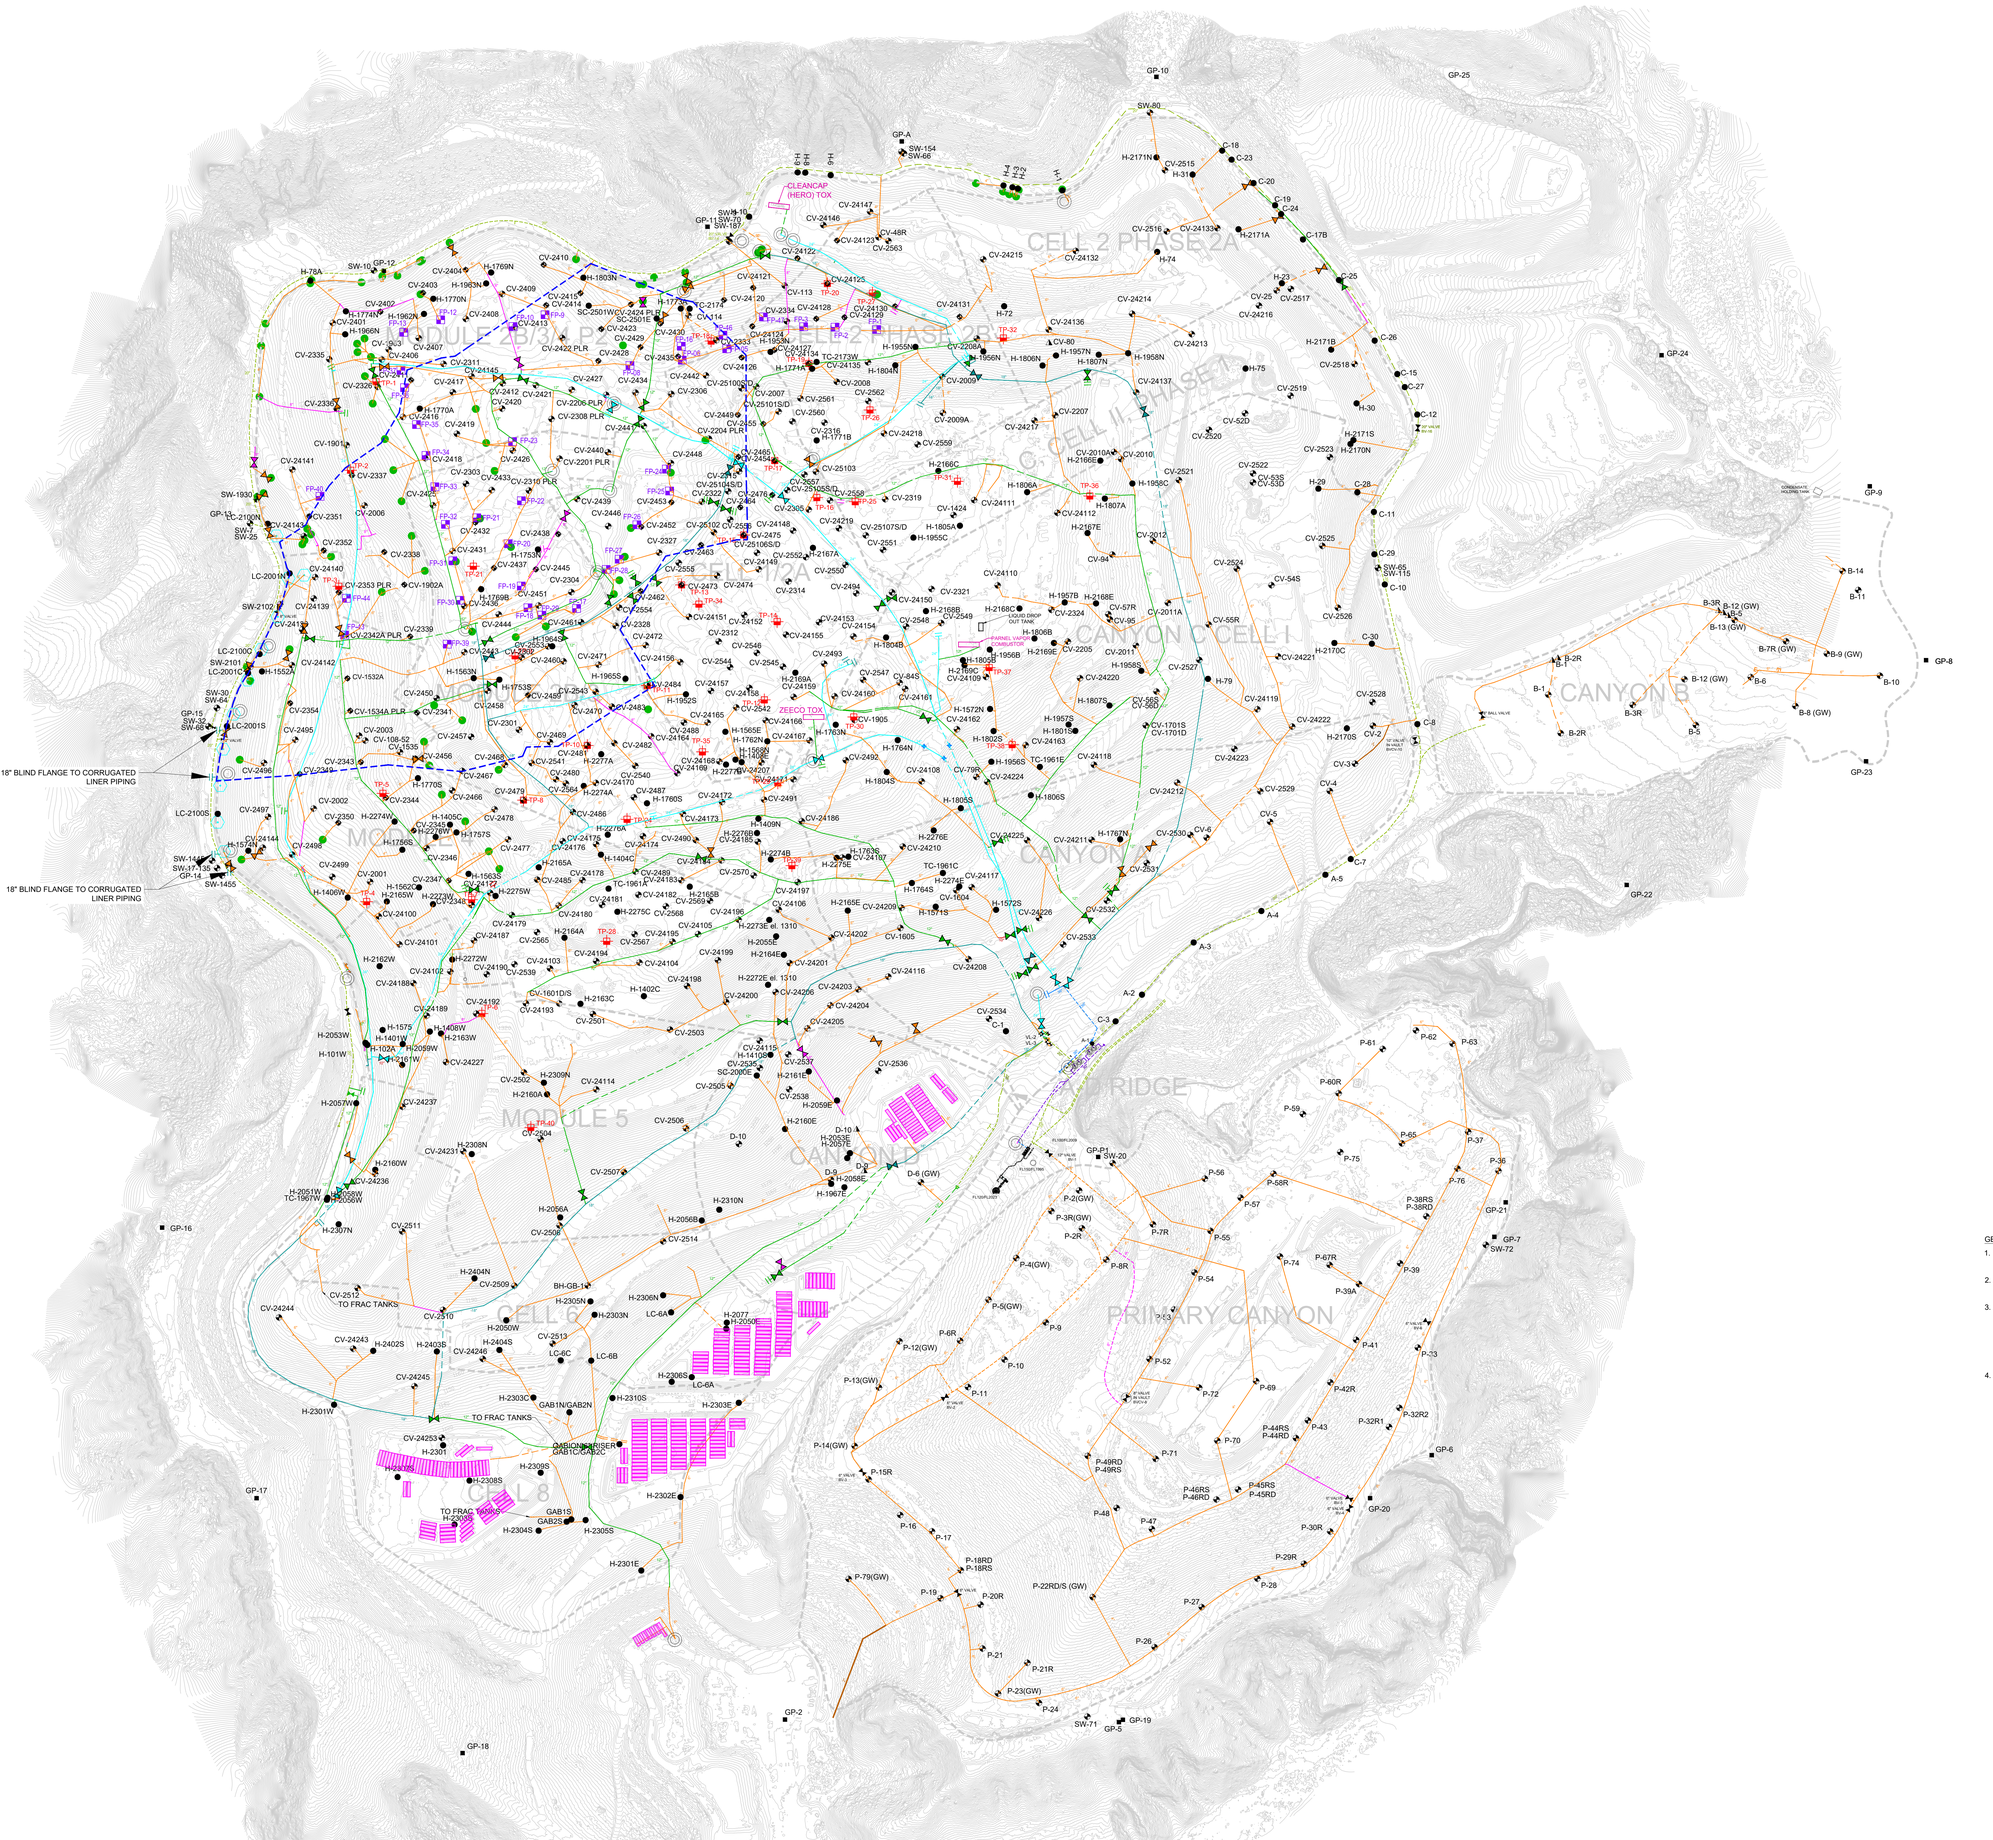

LEGEND

- TOPOGRAPHIC CONTOUR
- EXISTING CELL LIMITS (APPROXIMATE)
- CV-XX — EXISTING LFG VERTICAL EXTRACTION WELL
- CV-XX PLR — EXISTING LFG VERTICAL EXTRACTION WELL - PRESSURIZED LEACHATE RELEASE
- BH-GB — EXISTING GABION LFG COLLECTOR WELL
- SW-XX — EXISTING SOIL VAPOR EXTRACTION WELL
- FP-XX — EXISTING SURFACE COLLECTOR WELLHEAD
- H-XX — EXISTING HORIZONTAL WELLS
- C-XX — EXISTING REMOTE VERTICAL WELLHEAD
- GP-XX — EXISTING TEMPERATURE PROBE
- TP-XX — EXISTING ISOLATION VALVE
- AC — EXISTING ACTIVATED CARBON VESSEL
- EXISTING CONDENSATE SUMP
- EXISTING HDPE LINER RISER
- EXISTING CORRUGATED LINER RISER
- 36' — EXISTING 36" LFG COLLECTION HEADER PIPING
- 30' — EXISTING 30" LFG COLLECTION HEADER PIPING
- 24' — EXISTING 24" LFG COLLECTION HEADER PIPING
- 20' — EXISTING 20" LFG COLLECTION HEADER PIPING
- 18' — EXISTING 18" LFG COLLECTION HEADER PIPING
- 12' — EXISTING 12" LFG COLLECTION HEADER PIPING
- 10' — EXISTING 10" LFG COLLECTION HEADER PIPING
- 8' — EXISTING 8" LFG COLLECTION LATERAL PIPING
- 4'/6' — EXISTING 4"/6" LFG COLLECTION LATERAL PIPING
- 2' — EXISTING 2"/3" LFG COLLECTION LATERAL PIPING
- BELOW-GRADE PIPES ARE SHOWN DASHED
- REACTION AREA BOUNDARY (APPROXIMATE) - BASED ON DATA REVIEW
- EXISTING BLIND FLANGE
- EXISTING FRAC TANKS

GENERAL DRAWING NOTES:

1. EXISTING TOPOGRAPHIC SURVEY INFORMATION SHOWN WAS PROVIDED BY PROPELLOR. AERIAL PHOTOGRAPHY DATED OCTOBER 22, 2025.
2. NORTH ARROW SHOWN HERE IS REFERENCE TO THE CALIFORNIA STATE PLANE ZONE V COORDINATE SYSTEM, NAD 83.
3. THE LOCATION OF ANY EXISTING PIPING, VALVES, TIE-IN LOCATIONS AND OTHER FEATURES ARE APPROXIMATE AND SHOULD BE USED FOR INFORMATION PURPOSES ONLY. ACTUAL FIELD CONDITIONS MAY VARY AND SUBJECT TO CHANGE BASED ON FUTURE FILL OPERATIONS, WASTE PLACEMENT, TOPOGRAPHIC FEATURES, AND OTHER SITE-SPECIFIC FACTORS.
4. EXISTING GCCS AS-BUILT DATED NOVEMBER 04, 2025.

NO.	REVISION	DATE

SHEET TITLE: EXISTING GCCS MAP

PROJECT TITLE: CHIQUITA CANYON LANDFILL CASTAIC, CALIFORNIA

CLIENT: CHIQUITA CANYON LANDFILL CASTAIC, CALIFORNIA

SCS ENGINEERS
ENVIRONMENTAL CONSULTANTS
3900 KILROSS ROAD, SUITE 300
LONG BEACH, CA 90808
PH: (562) 426-9544

PROJ. NO: -	ACAD: N:\CAD\ASBUILT-MASTERS
DSN. BY: JHS/RM	APP. BY: -
DWN. BY: -	CHK. BY: -

DATE: 11/12/2025

SCALE: AS SHOWN

N:\CAD\ASBUILT - MASTERS\CHIQUITA\GCCS\CCL MASTER EXISTING GCCS MAP ONLY_2025-11-12.dwg Nov 12, 2025 - 11:50am By: smedina