

Archived: Wednesday, November 19, 2025 11:55:15 AM
From: [Kate Logan](#)
Sent: Friday, November 14, 2025 7:42:32 AM
To: [Karen Gork](#)
Cc: Todd.Thalhamer@Calrecycle.ca.gov
Subject: Chiquita Canyon Landfill – Geosynthetic Cover – Mitigation Measure 4.1
Importance: Normal
Sensitivity: None
Attachments: [4050 2025-11-07 Milestone 2B Chiquita Canyon LF Isopach_October 2025.pdf](#)  [CLF Reaction Area](#)
[_Reactive Wells_2025-11-07.pdf](#)  [2025-11-07 Figure 1 EVOH Location-Layout1 \(2\).pdf](#) 

[EXTERNAL SENDER: Use caution with links/attachments]

Below is Chiquita's weekly update on the status of the installation of the 60-mil EVOH/HDPE geomembrane cover at the Chiquita Canyon Landfill, in accordance with Mitigation Measure 4.1 of the LEA's Compliance Order issued May 1, 2025.

As of November 7, 2025, D&E, on behalf of Chiquita, had installed approximately 716,077 square feet of tan 60-mil EVOH/HDPE geomembrane cover. Chiquita continues to prioritize, and has almost completed, the installation of access roads on top of the EVOH/HDPE geomembrane cover to ensure continued access to major areas of the landfill. Swift completion of the access road installation will also allow Chiquita to resume operation of the landfill gas extraction wells and dewatering pumps within those areas that had to be temporarily disabled for this project. Additional repairs and detailing were performed on existing panels, including fabricating boots, patching, extrusion welding, and re-seaming, as needed. Chiquita is also preparing the Segment 3 area for EVOH/HDPE geosynthetic cover deployment, including stripping rock off the roads on the existing 30-mil HDPE geosynthetic cover. Chiquita anticipates potential delays in the deployment of the EVOH/HDPE geosynthetic cover as a result of the forecasted rain, which is expected to last through Tuesday, November 18, 2025.

The attached site map shows the approximate extent of geomembrane cover installed as of Friday, November 7, 2025, as well as the geomembrane coverage described in the revised draft workplan for extension of the geomembrane cover area submitted to the LEA, the US EPA, and DTSC on October 3, 2025. Also attached to this submission are the October 2025 monthly isopach map and a figure identifying wells showing signs of reaction as November 7, 2025. Due to technical limitations, we are currently unable to create one figure including all of this data.

Thanks,


Kate Logan
Senior Remediation Project Manager
Chiquita Canyon Landfill
29201 Henry Mayo Dr.
Castaic, CA 91384
(m) (346) 807-5547
Kate.Logan@WasteConnections.com



Chiquita Canyon Landfill - Isopach



October 29, 2025 Survey Image. October 1, 2025 vs October 29, 2025

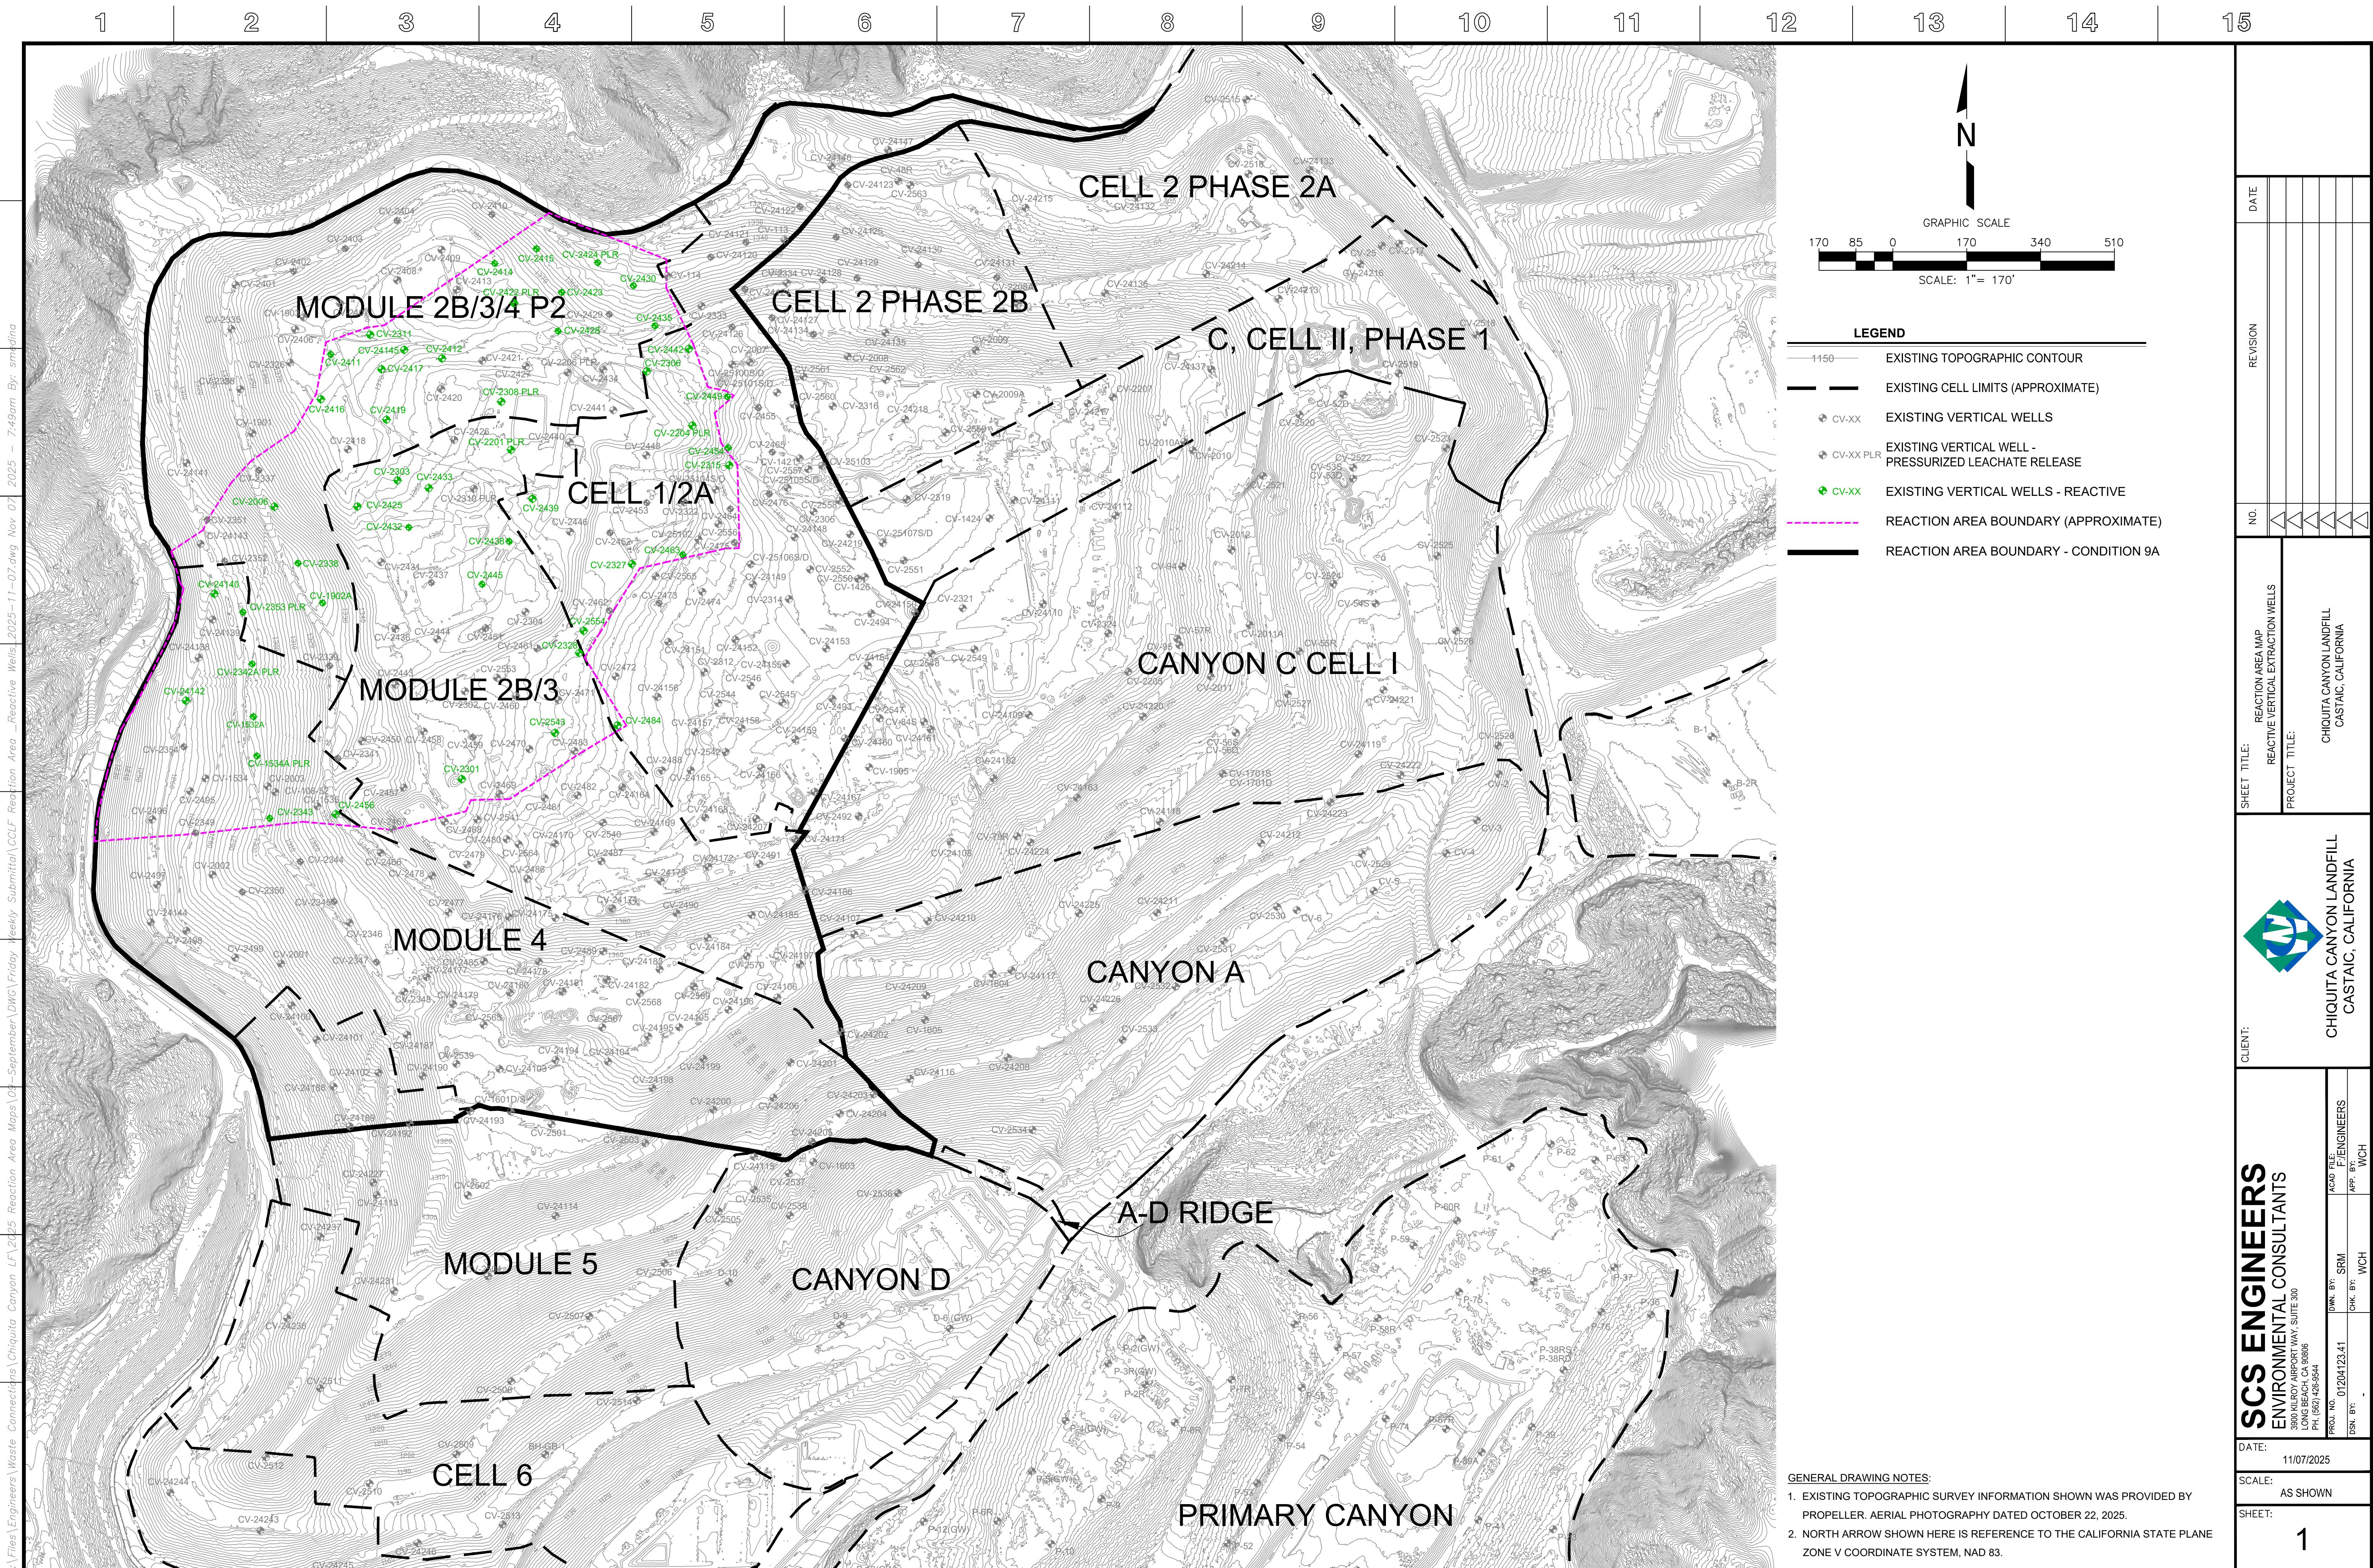

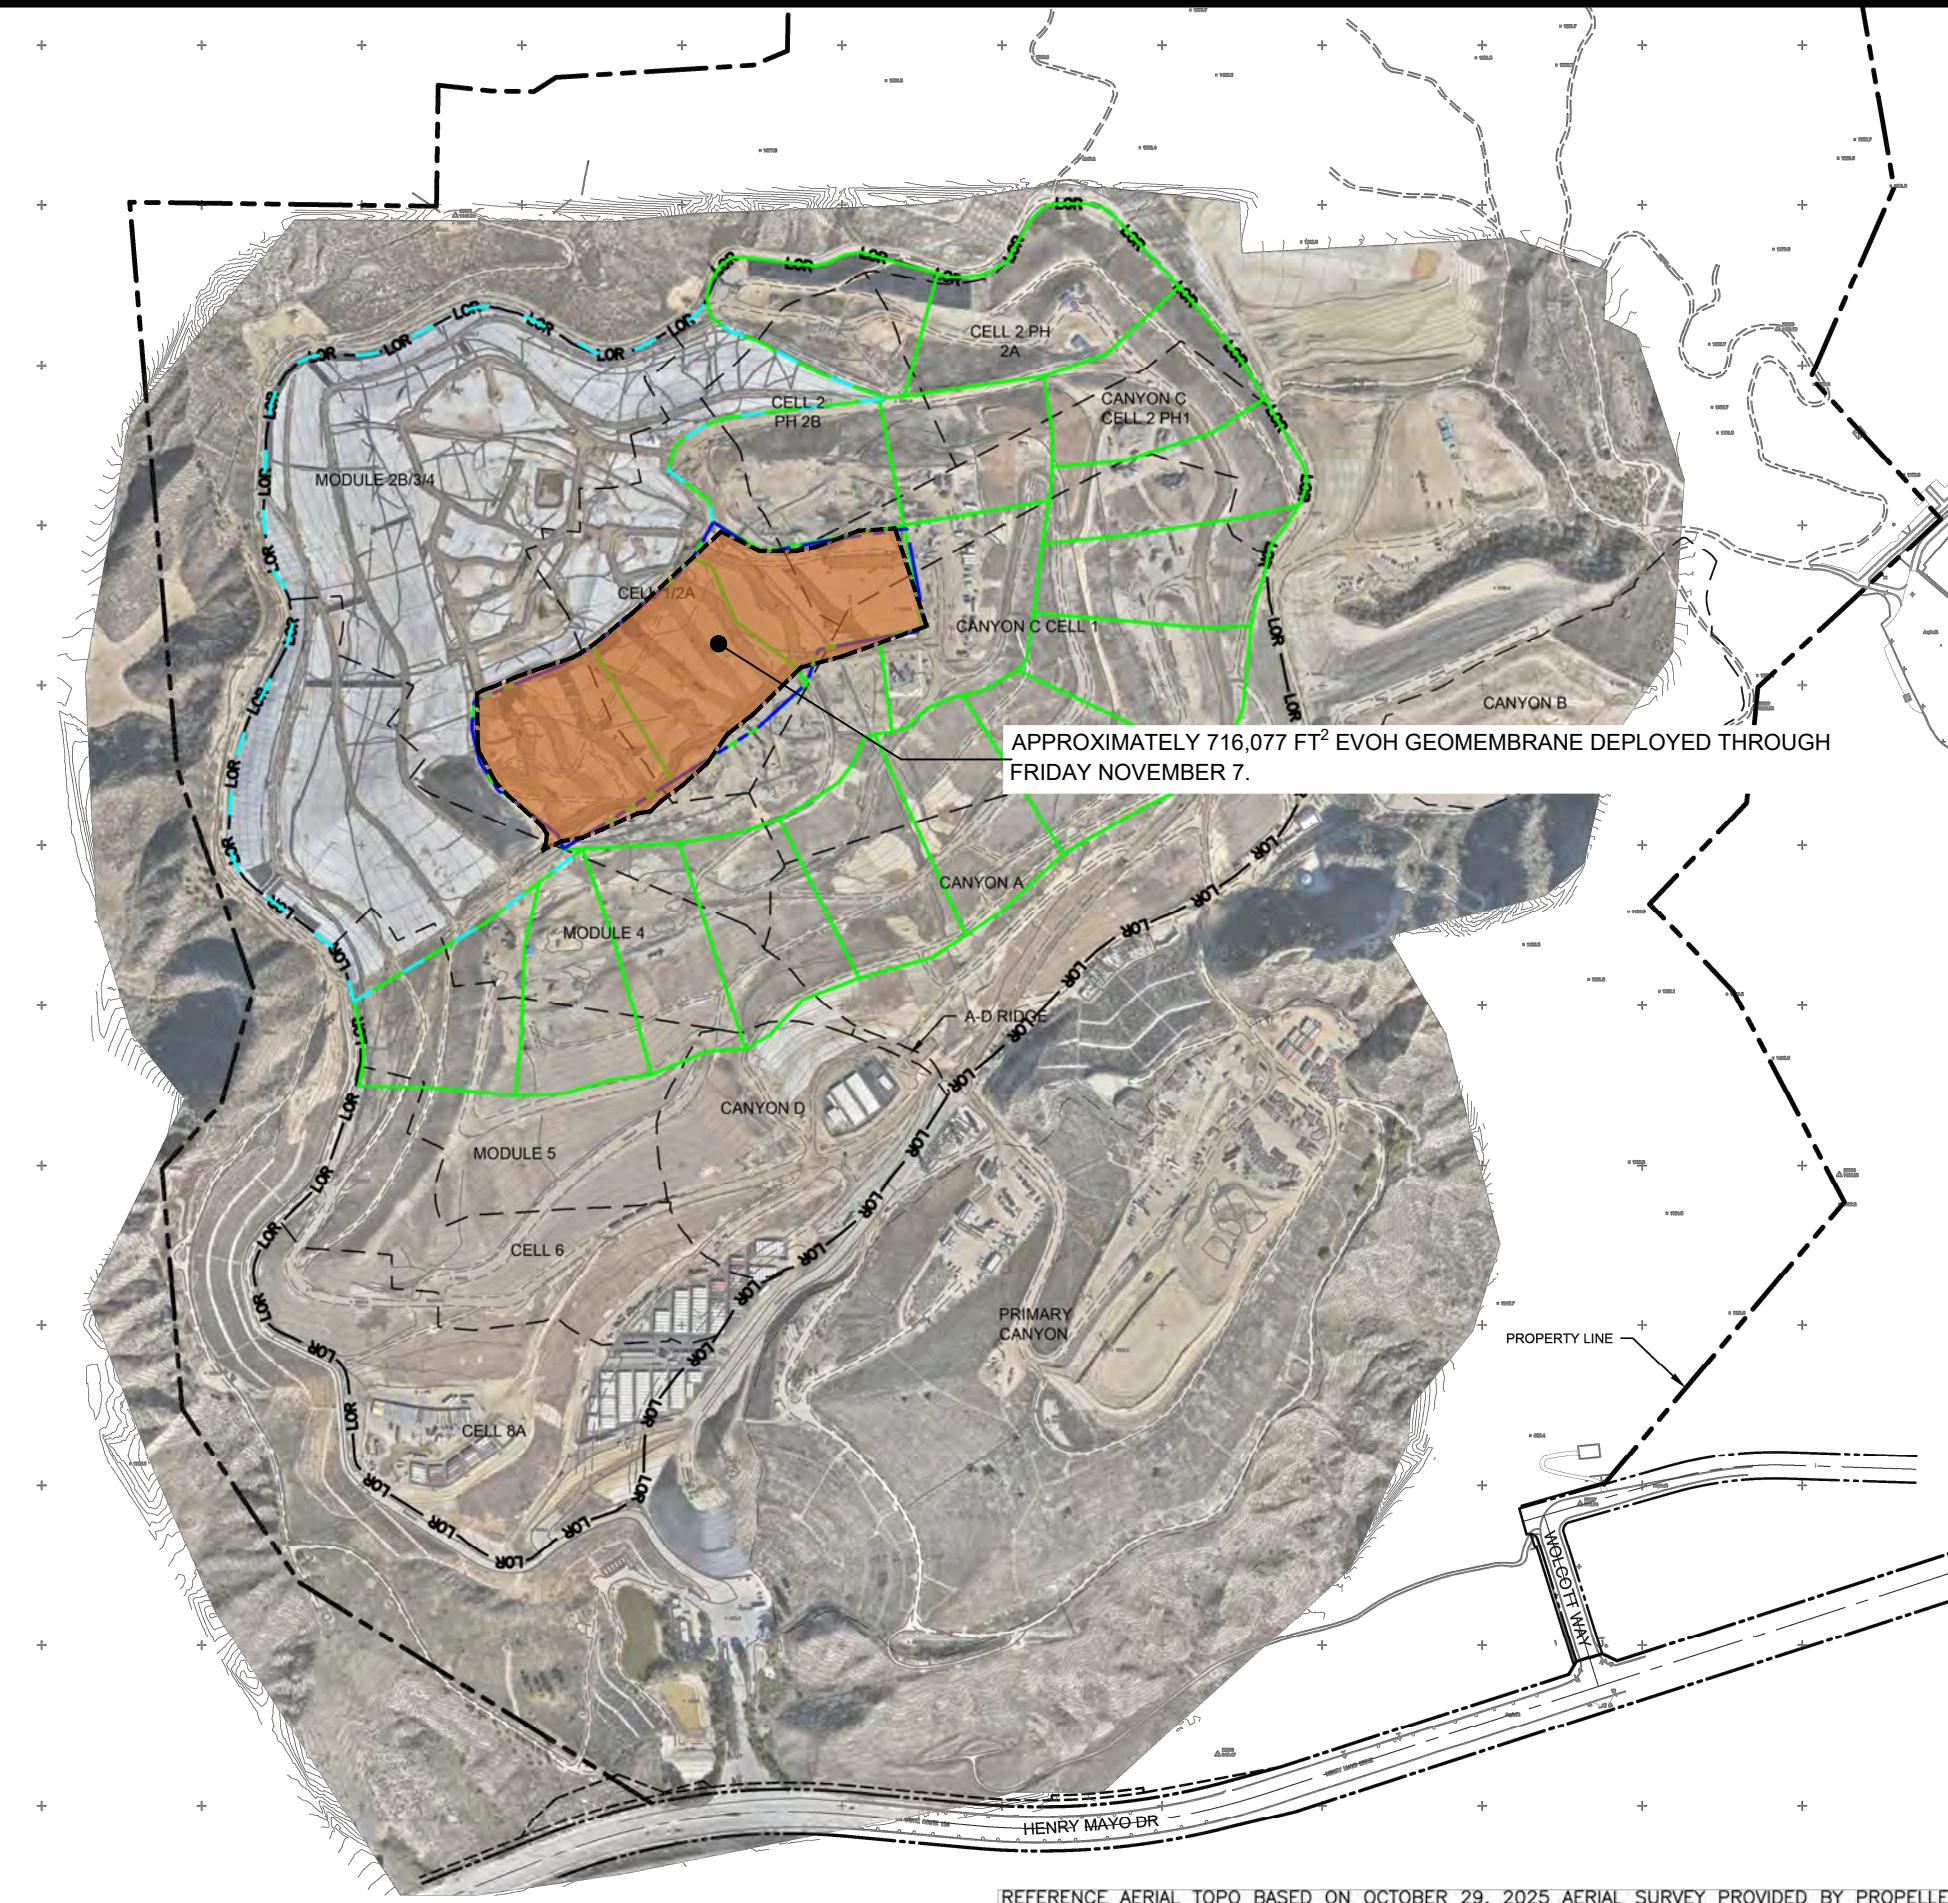


FIGURE 1
APPROXIMATE LIMITS OF
EVOH GEOMEMBRANE
CHIQUITA CANYON LANDFILL
CASTAIC, CA

Geo-Logic
ASSOCIATES