

Archived: Wednesday, November 19, 2025 11:59:43 AM
From: [Medina, Steven](#)
Sent: Friday, November 14, 2025 2:31:37 PM
To: bchen@aqmd.gov
Cc: [Haley, William \(Bill\)](#)
Subject: Re: Case No. 6177-4 Stipulated Order for Abatement – Well Drilling Update
Importance: Normal
Sensitivity: None
Attachments: Outlook-bjhfulpk.png Outlook-bwiiggbw.png Outlook-fzdw4153.png Outlook-lwyudlpw.png 2025 CCLF GCCS Expan Master Plan_Proposed LFG Extraction Well and Temp Probe Map_2025-11-14.pdf

[EXTERNAL SENDER: Use caution with links/attachments]

All,

In accordance with Condition 15(c) of the Stipulated Order, below is the up-to-date construction summary for the Chiquita Canyon Landfill 2025 GCCS Expansion Master Plan Project.

As of 11/10/2025 to 11/14/2025 - Installation of LFG vertical extraction wells included:

1. CV-2566

During 11/10/2025 to 11/14/2025, Chiquita completed the installation of one (1) vertical LFG extraction well. The total count of vertical LFG extraction wells installed from December 6, 2023 (the start date of the GCCS Master Expansion) through today is three hundred thirteen (313).

During 11/10/2025 to 11/14/2025, Chiquita completed the installation of zero (0) temperature probes. The total count of temperature probes installed from February 26th, 2024 (the start date of the temperature probe installations) through today is thirty-nine (39).

The wells and temperature probes scheduled for drilling during the week of 11/17/2025 to 11/21/2025 are as follows (subject to change):

Rig (Continuum): CV-2572; Installation of only one vertical extraction well is projected for next week due to heavy rain affecting site conditions.

Temperature Probe Rig (Boart Longyear): Drilling of the temperature probes is currently on hold due to ongoing Soil Vapor Extraction (SVE) well drilling. Drilling of the temperature probes will resume following the completion and installation of the SVE wells.

Regards,

STEVEN Ruben Medina, **E.I.T.**

Staff Professional

SCS Engineers

3900 Kilroy Airport Way, Suite 300


Long Beach, CA 90806

858-204-4342 (c)

SMedina@scsengineers.com

Driven by Client Success
www.scsengineers.com



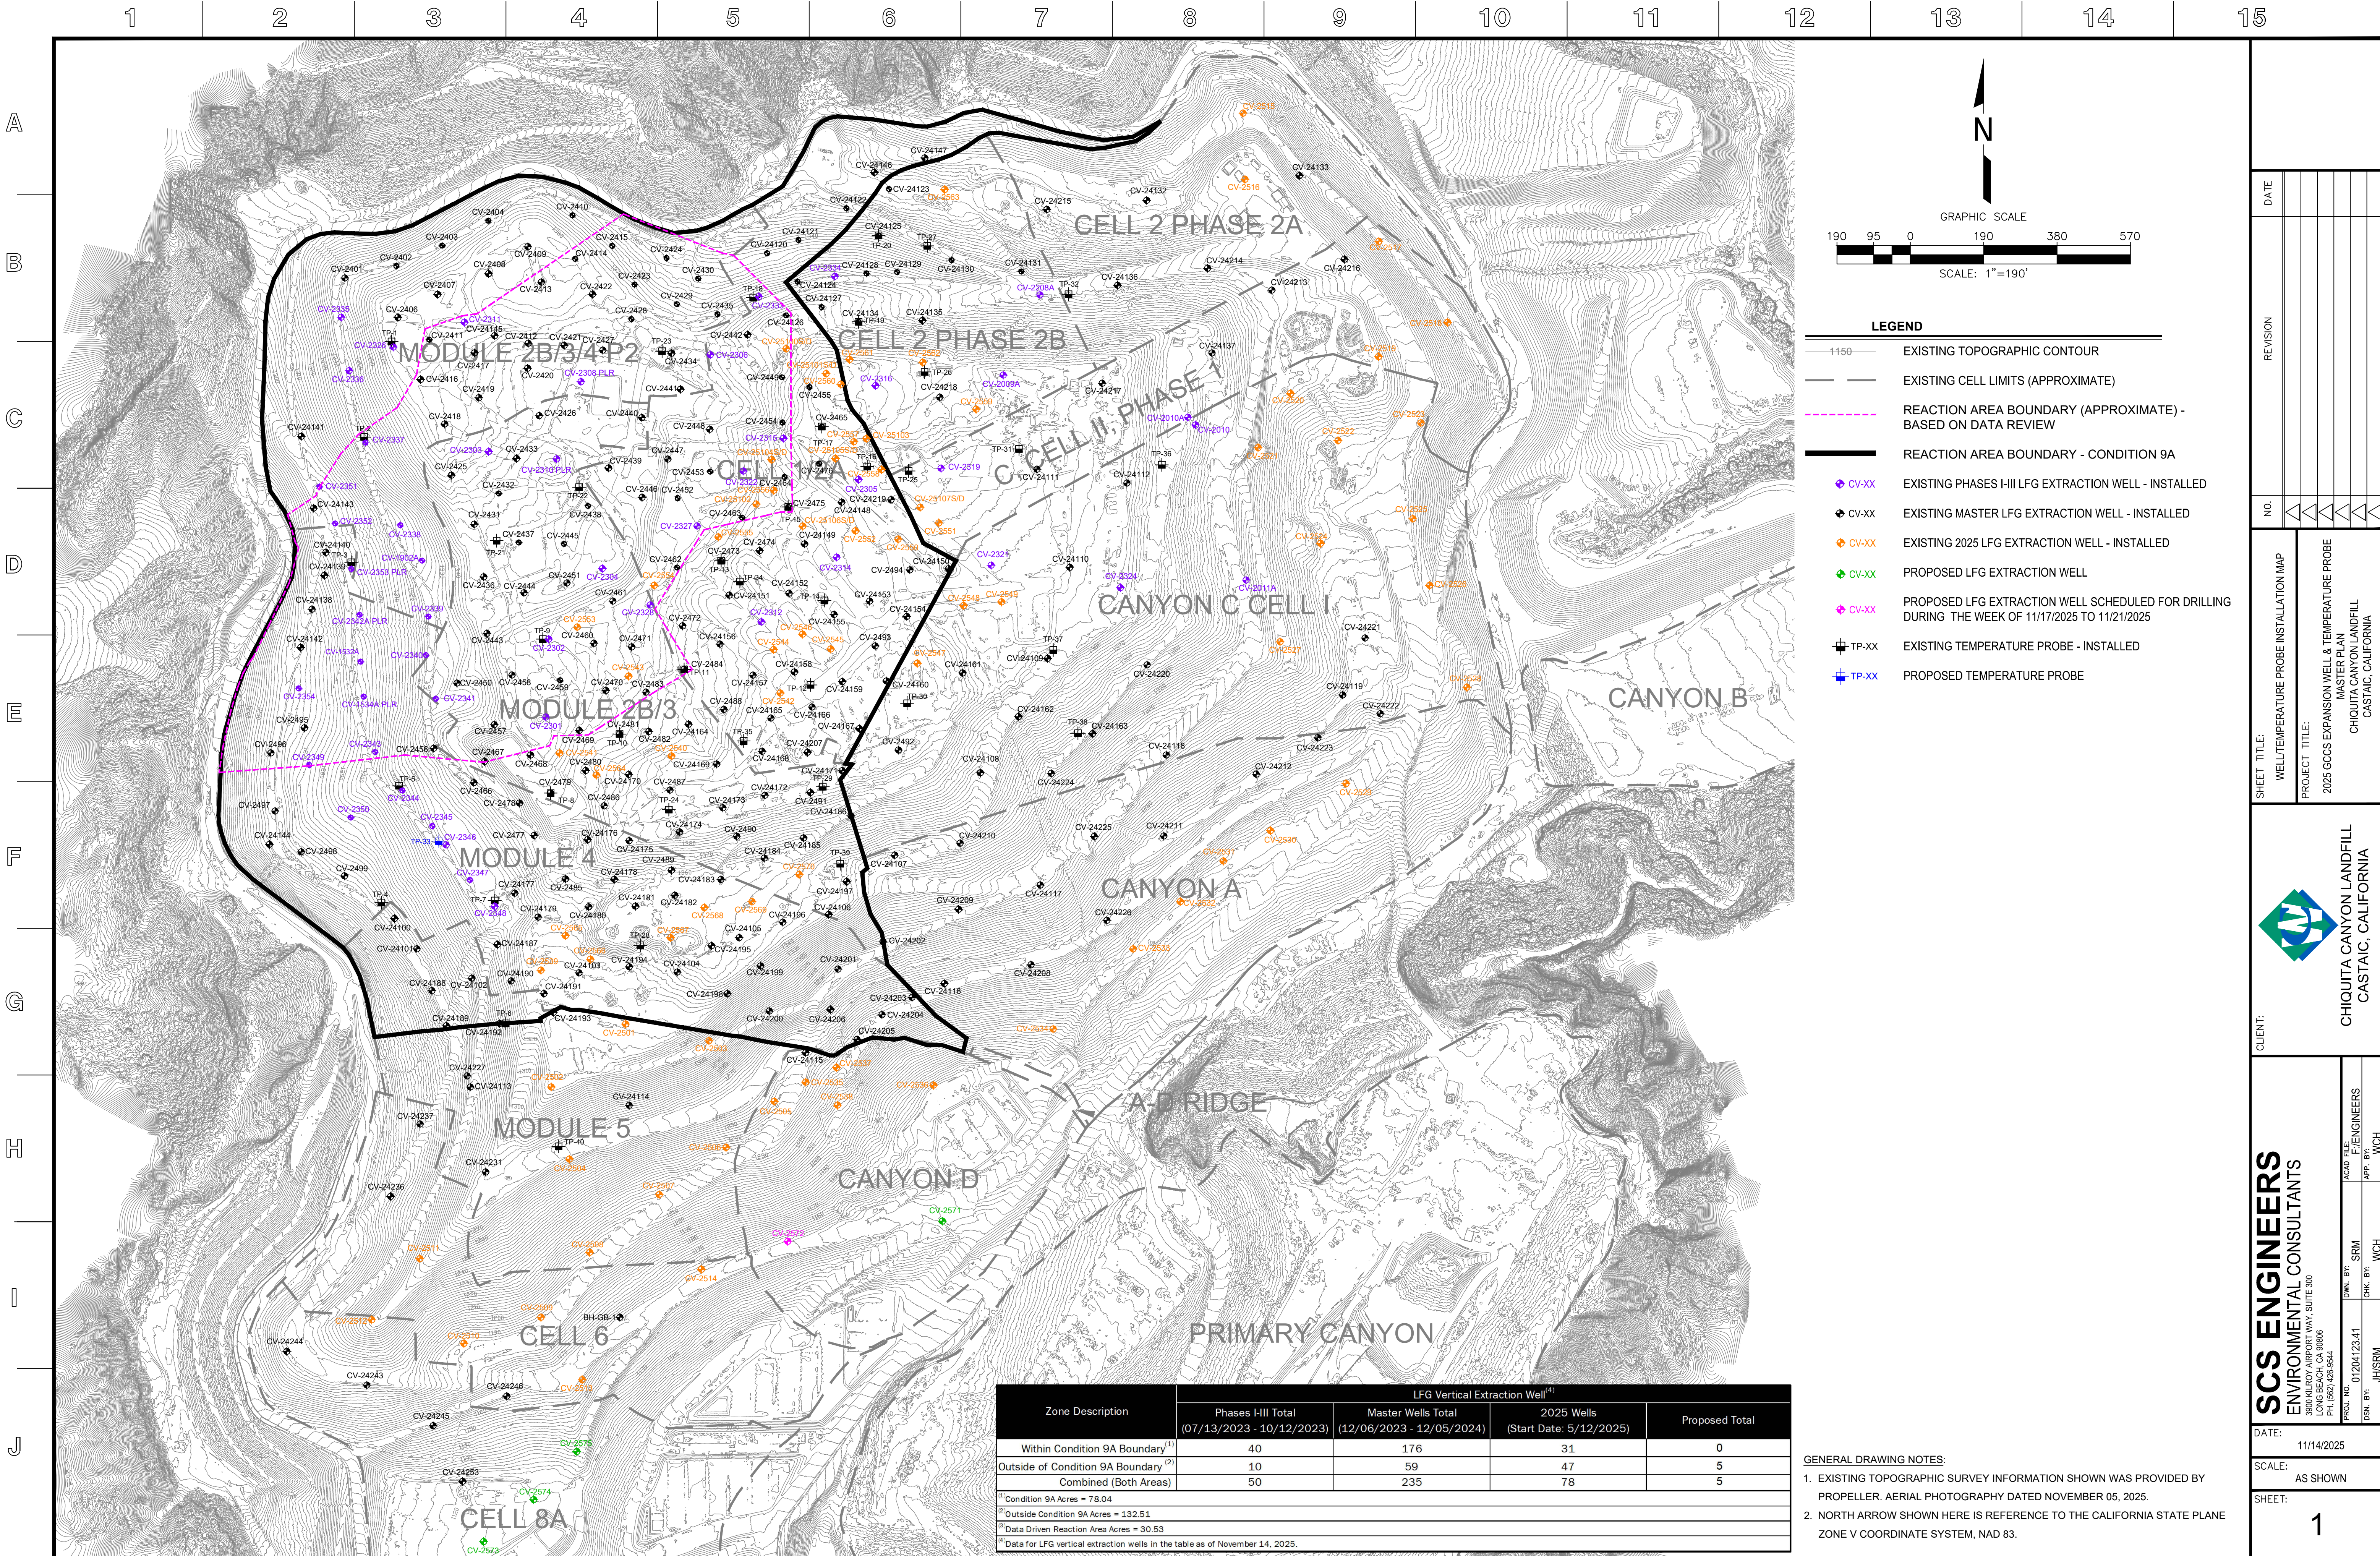

DATE

REVISION

NO.

SHEET TITLE:
WELL/TEMPERATURE PROBE INSTALLATION MAP

PROJECT TITLE:
2025 GCCS EXPANSION WELL & TEMPERATURE PROBE
MASTER PLAN
CHICUITA CANYON LANDFILL
CASTAIC, CALIFORNIA

CLIENT:

SCS ENGINEERS
ENVIRONMENTAL CONSULTANTS
15000 W. ORANGE AVE., SUITE 300
LONG BEACH, CA 90806
PH: (562) 426-9544

DATE:

11/14/2025

SCALE:

AS SHOWN

SHEET:

1

