

Archived: Thursday, November 13, 2025 11:01:13 AM
From: [Kate Logan](#)
Sent: Friday, November 7, 2025 7:33:51 AM
To: [Karen Gork](#)
Cc: Todd.Thalhamer@Calrecycle.ca.gov
Subject: Chiquita Canyon Landfill – Geosynthetic Cover – Mitigation Measure 4.1
Importance: Normal
Sensitivity: None
Attachments: [4050 2025-11-07 Milestone 2B Chiquita Canyon LF Isopach_October 2025.pdf](#) [CLF Reaction Area](#)
[_Reactive Wells_2025-10-31.pdf](#) [2025-10-31 Figure 1 EVOH Location-Layout1 \(2\).pdf](#)

[EXTERNAL SENDER: Use caution with links/attachments]

Below is Chiquita's weekly update on the status of the installation of the 60-mil EVOH/HDPE geomembrane cover at the Chiquita Canyon Landfill, in accordance with Mitigation Measure 4.1 of the LEA's Compliance Order issued May 1, 2025.

As of October 31, 2025, D&E, on behalf of Chiquita, had installed approximately 707,948 square feet of tan 60-mil EVOH/HDPE geomembrane cover. D&E was on rotation the week of October 27, 2025, as requested by D&E, and therefore unable to install additional EVOH/HDPE cover that week. Chiquita continues to prioritize the installation of access roads on top of the EVOH/HDPE geomembrane cover to ensure continued access to major areas of the landfill. Swift completion of the access road installation will also allow Chiquita to resume operation of the landfill gas extraction wells and dewatering pumps within those areas that had to be temporarily disabled for this project. Additional repairs and detailing were performed on existing panels, including fabricating boots, patching, extrusion welding, and re-seaming, as needed.

The attached site map shows the approximate extent of geomembrane cover installed as of Friday, October 31, 2025, as well as the geomembrane coverage described in the revised draft workplan for extension of the geomembrane cover area submitted to the LEA, the US EPA, and DTSC on October 3, 2025. Also attached to this submission are the October 2025 monthly isopach map and a figure identifying wells showing signs of reaction as October 31, 2025. Due to technical limitations, we are currently unable to create one figure including all of this data.


Thanks,
Kate Logan
Senior Remediation Project Manager
Chiquita Canyon Landfill
29201 Henry Mayo Dr.
Castaic, CA 91384
(m) (346) 807-5547
Kate.Logan@WasteConnections.com




Chiquita Canyon Landfill - Isopach



October 29, 2025 Survey Image. October 1, 2025 vs October 29, 2025

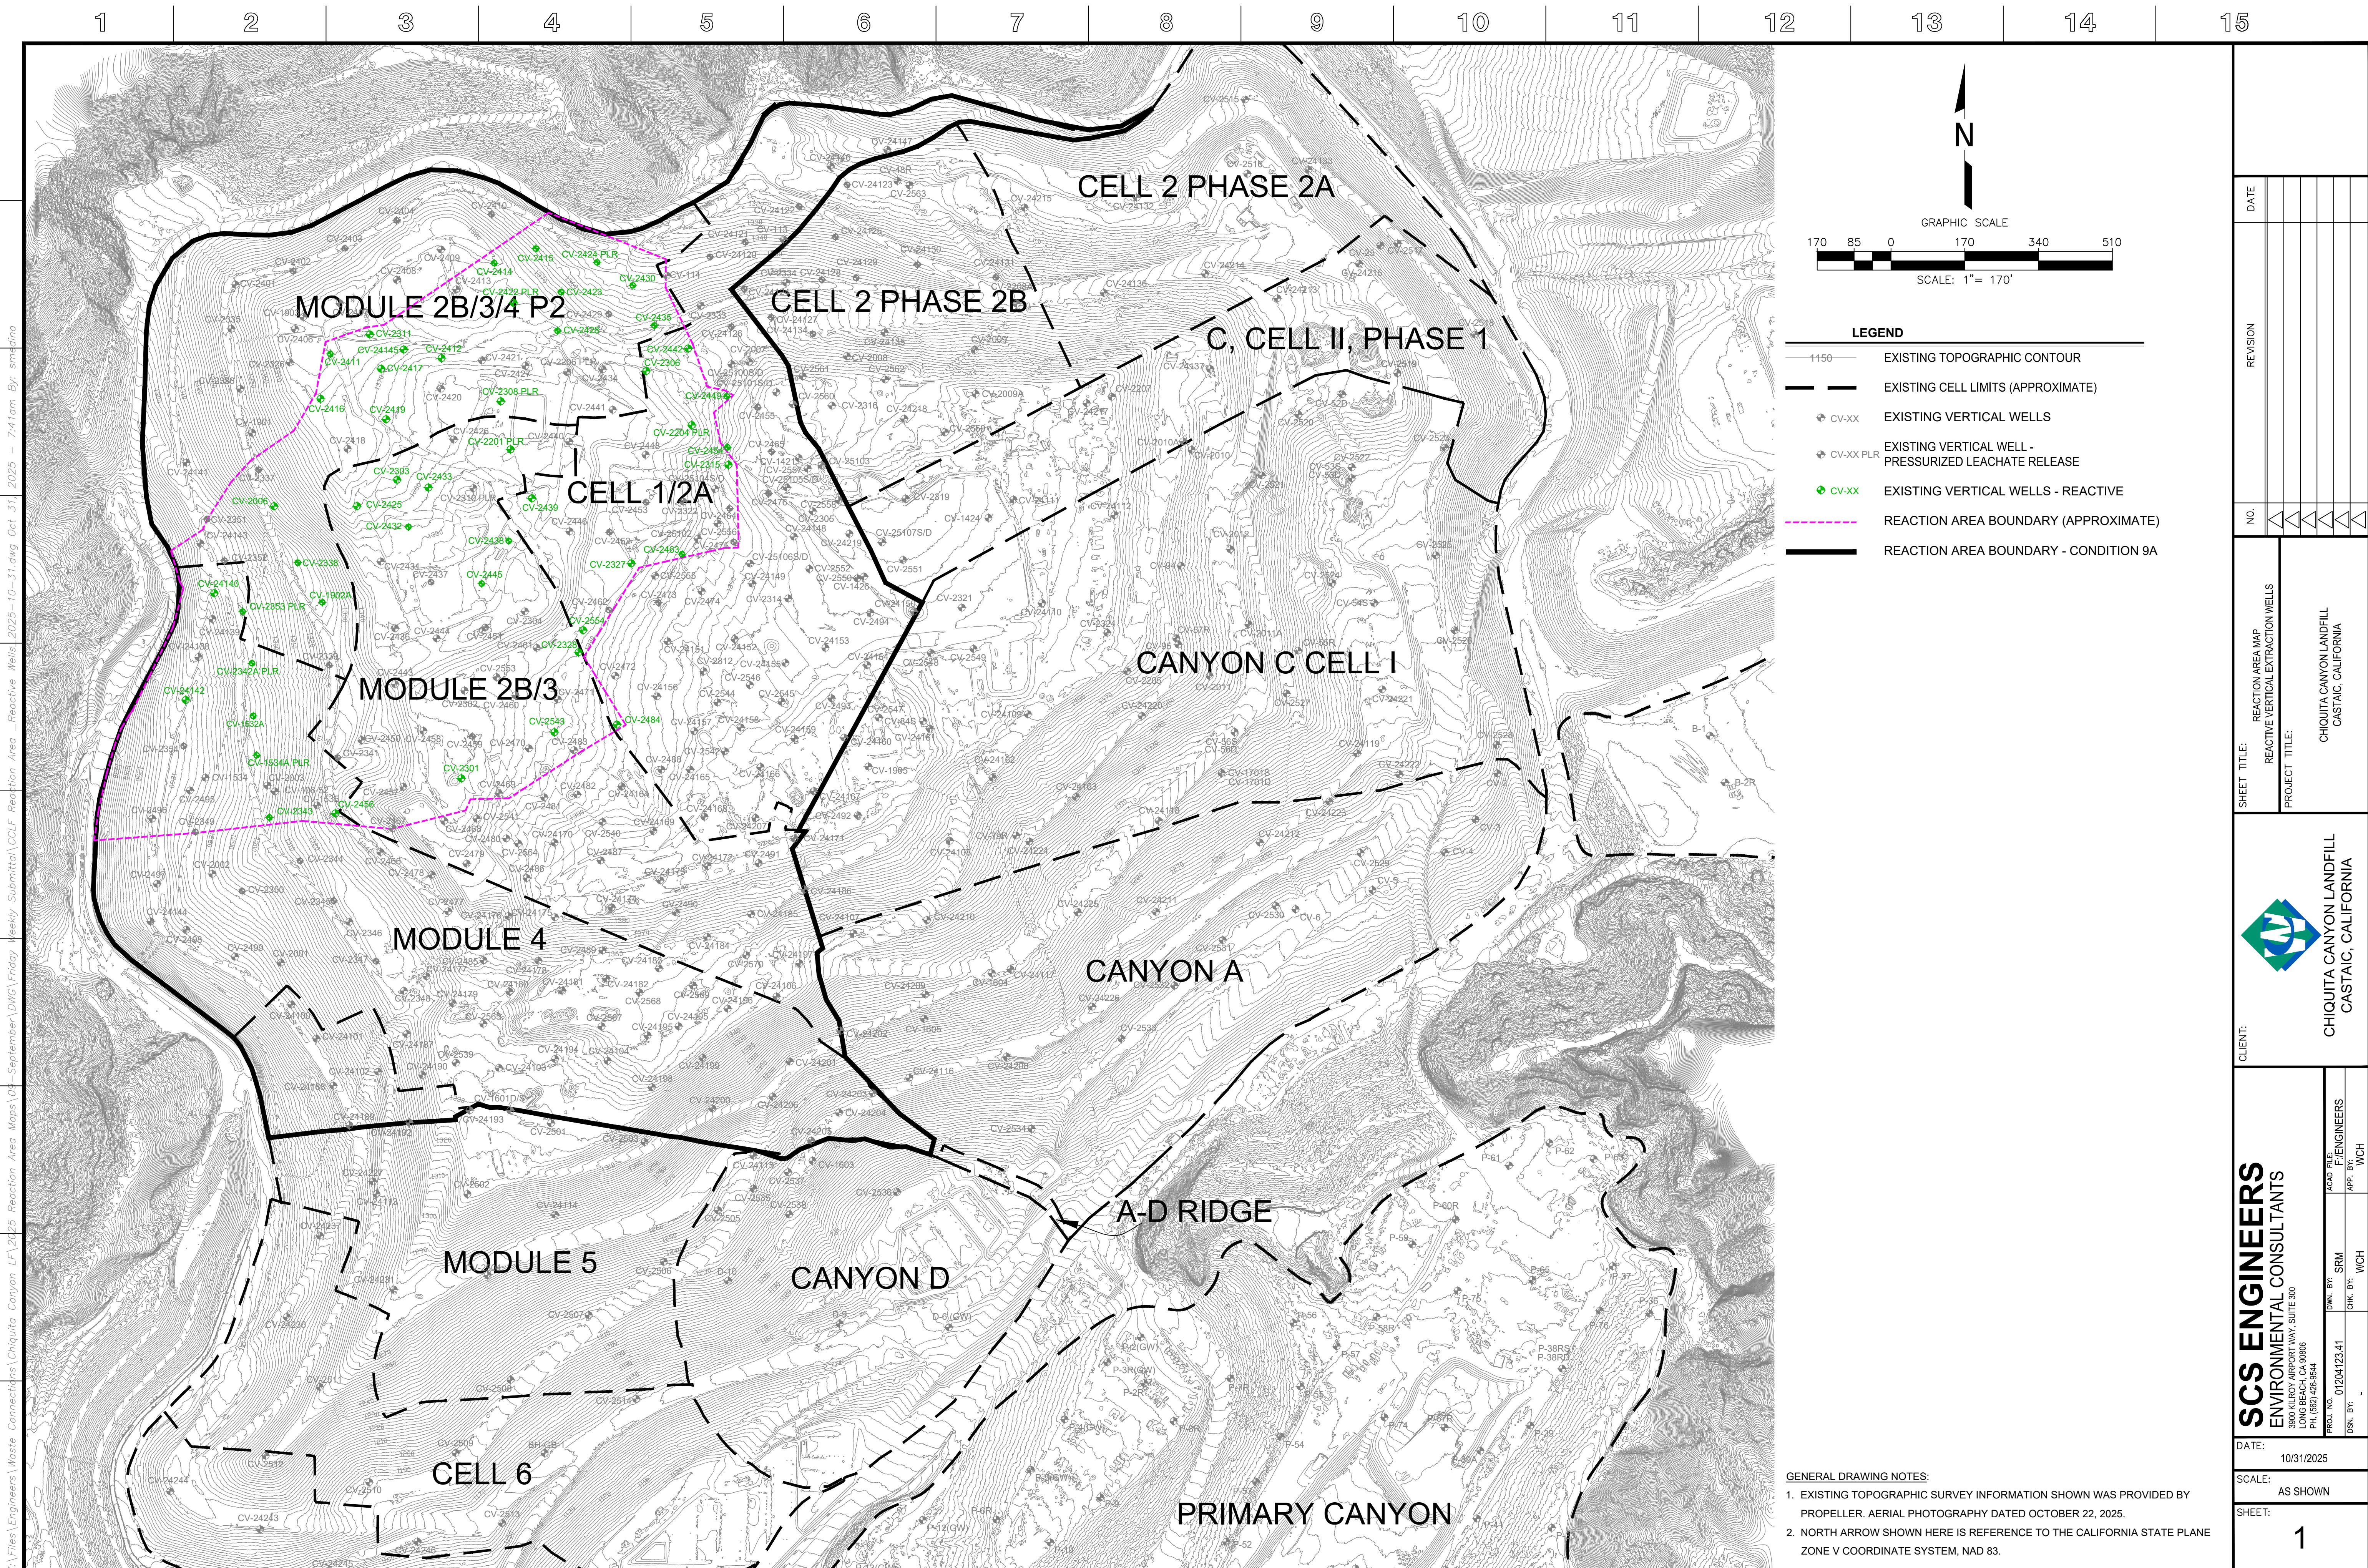

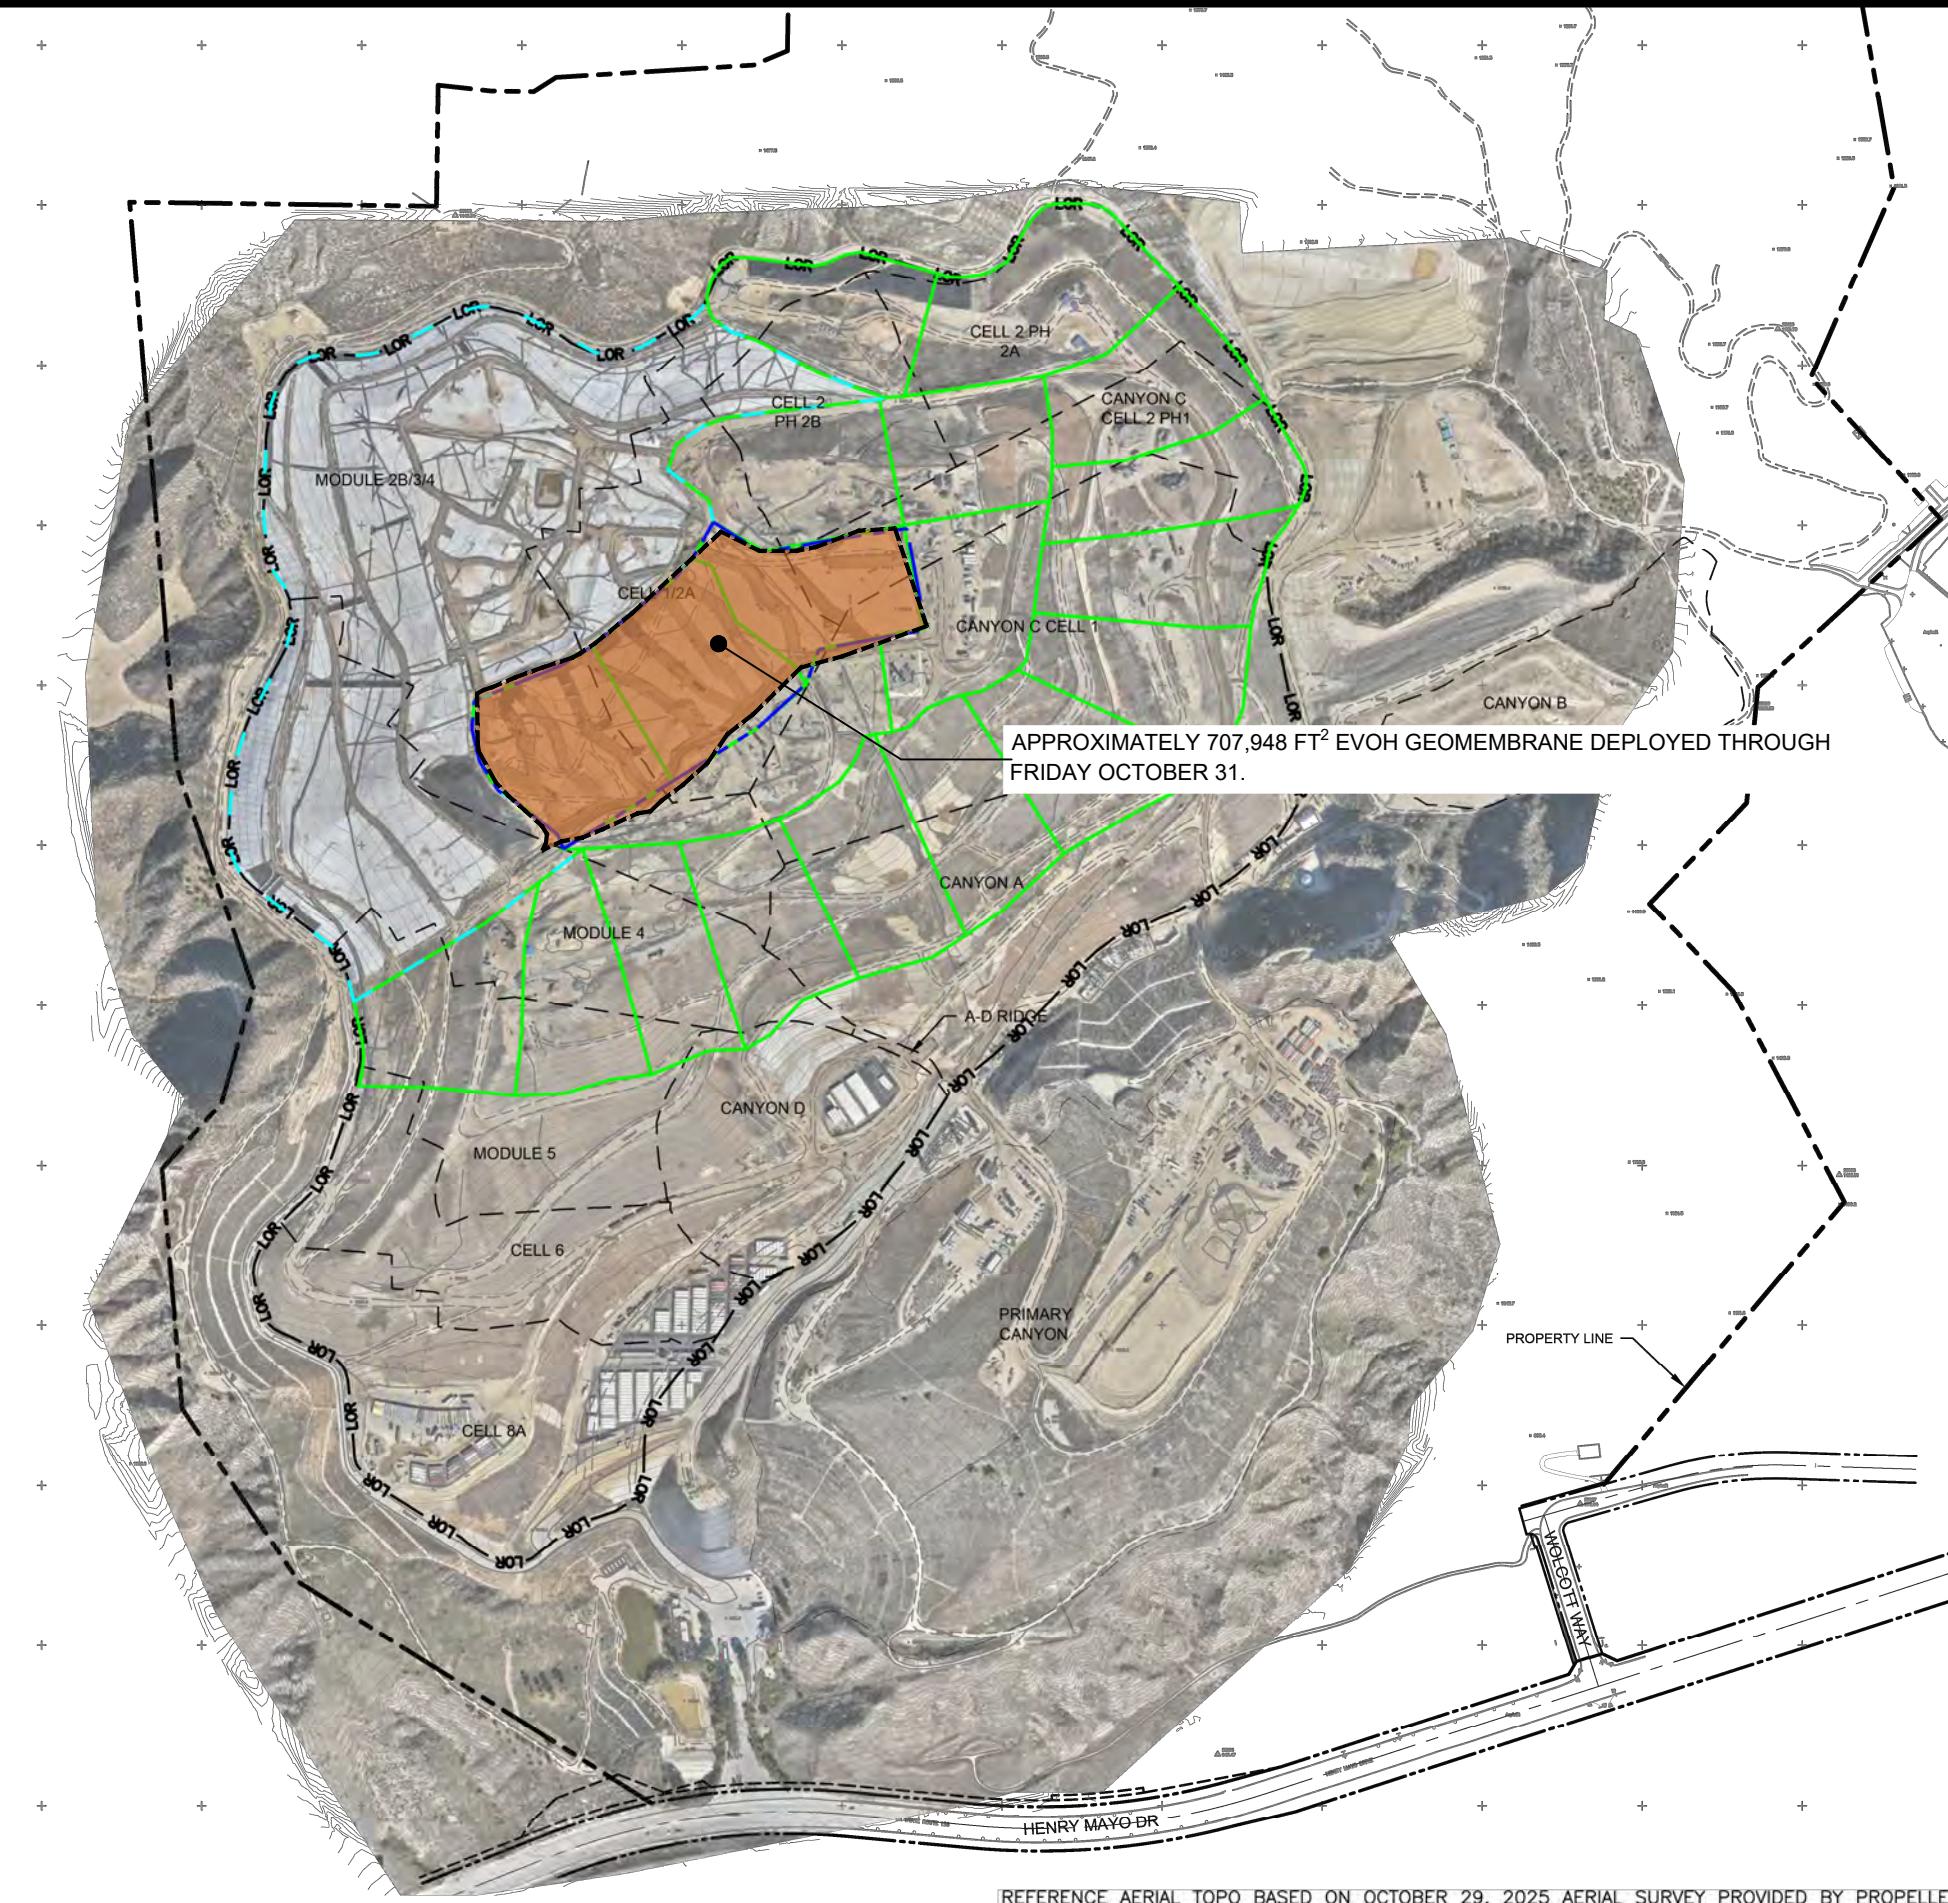

LEGEND:

- PROPERTY LINE
- APPROXIMATE LIMIT OF REFUSE
- CELL LIMIT
- EXISTING GEOMEMBRANE DEPLOYMENT AREA
- INITIAL SUPPLEMENTAL GEOMEMBRANE DEPLOYMENT AREA
- SUBSEQUENT SUPPLEMENTAL GEOMEMBRANE AREA

NOTE:

- EXISTING GEOMEMBRANE DEPLOYMENT AREA IS APPROXIMATELY 48.3 ACRES.
- EXISTING GEOMEMBRANE IS 30-MIL HDPE, EXCEPT FOR 1.3 ACRES OF 40-MIL HDPE.
- EACH PROPOSED DEPLOYMENT AREA IS APPROXIMATELY 5 ACRES.
- NEW GEOMEMBRANE WILL BE 60-MIL HDPE WITH AN INTERNAL CORE EVOH RESIN BARRIER.



600' 0' 300' 600'
SCALE: 1" = 600'

FIGURE 1

**APPROXIMATE LIMITS OF
EVOH GEOMEMBRANE
CHIQUITA CANYON LANDFILL
CASTAIC, CA**

Geo-Logic
ASSOCIATES