

Archived: Tuesday, December 2, 2025 2:52:46 PM
From: [Kate Logan](#)
Sent: Wednesday, November 26, 2025 8:21:09 PM
To: [Karen Gork](#)
Cc: Todd.Thalhamer@Calrecycle.ca.gov
Subject: Chiquita Canyon Landfill – Geosynthetic Cover – Mitigation Measure 4.1
Importance: Normal
Sensitivity: None
Attachments: [CCLF Reaction Area _Reactive Wells_ 2025-11-14.pdf](#) [2025-11-14 Figure 1 EVOH Location-Layout1 \(2\).pdf](#) [050 2025-11-07 Milestone 2B Chiquita Canyon LF Isopach_ October 2025.pdf](#)

[EXTERNAL SENDER: Use caution with links/attachments]

Below is Chiquita's weekly update on the status of the installation of the 60-mil EVOH/HDPE geomembrane cover at the Chiquita Canyon Landfill, in accordance with Mitigation Measure 4.1 of the LEA's Compliance Order issued May 1, 2025. This update is being submitted early due to the Thanksgiving holiday.


As of November 21, 2025, D&E, on behalf of Chiquita, has installed approximately 716,077 square feet of tan 60-mil EVOH/HDPE geomembrane cover. Heavy wet weather conditions during the week of November 17, 2025 prevented further deployment of the EVOH/HDPE geomembrane cover. Chiquita continued to prioritize the installation of access roads on top of the EVOH/HDPE geomembrane cover, however, the substantial rainfall also prevented completion of these roads. Additional repairs and detailing were performed on existing panels, including fabricating boots, patching, extrusion welding, and re-seaming, as needed. Chiquita also continued to prepare the Segment 3 area for EVOH/HDPE geosynthetic cover deployment, including installing additional piping infrastructure. Chiquita anticipates additional delays in the deployment of the EVOH/HDPE geosynthetic cover as a result of the forecasted rain and Thanksgiving holiday.

The attached site map shows the approximate extent of geomembrane cover installed as of Friday, November 21, 2025, as well as the geomembrane coverage described in the revised draft workplan for extension of the geomembrane cover area submitted to the LEA, the US EPA, and DTSC on October 3, 2025. Also attached to this submission are the October 2025 monthly isopach map and a figure identifying wells showing signs of reaction as November 14, 2025. Due to technical limitations, we are currently unable to create one figure including all of this data.

Thanks,


Kate Logan
Senior Remediation Project Manager
Chiquita Canyon Landfill
29201 Henry Mayo Dr.
Castaic, CA 91384
(m) (346) 807-5547
Kate.Logan@WasteConnections.com



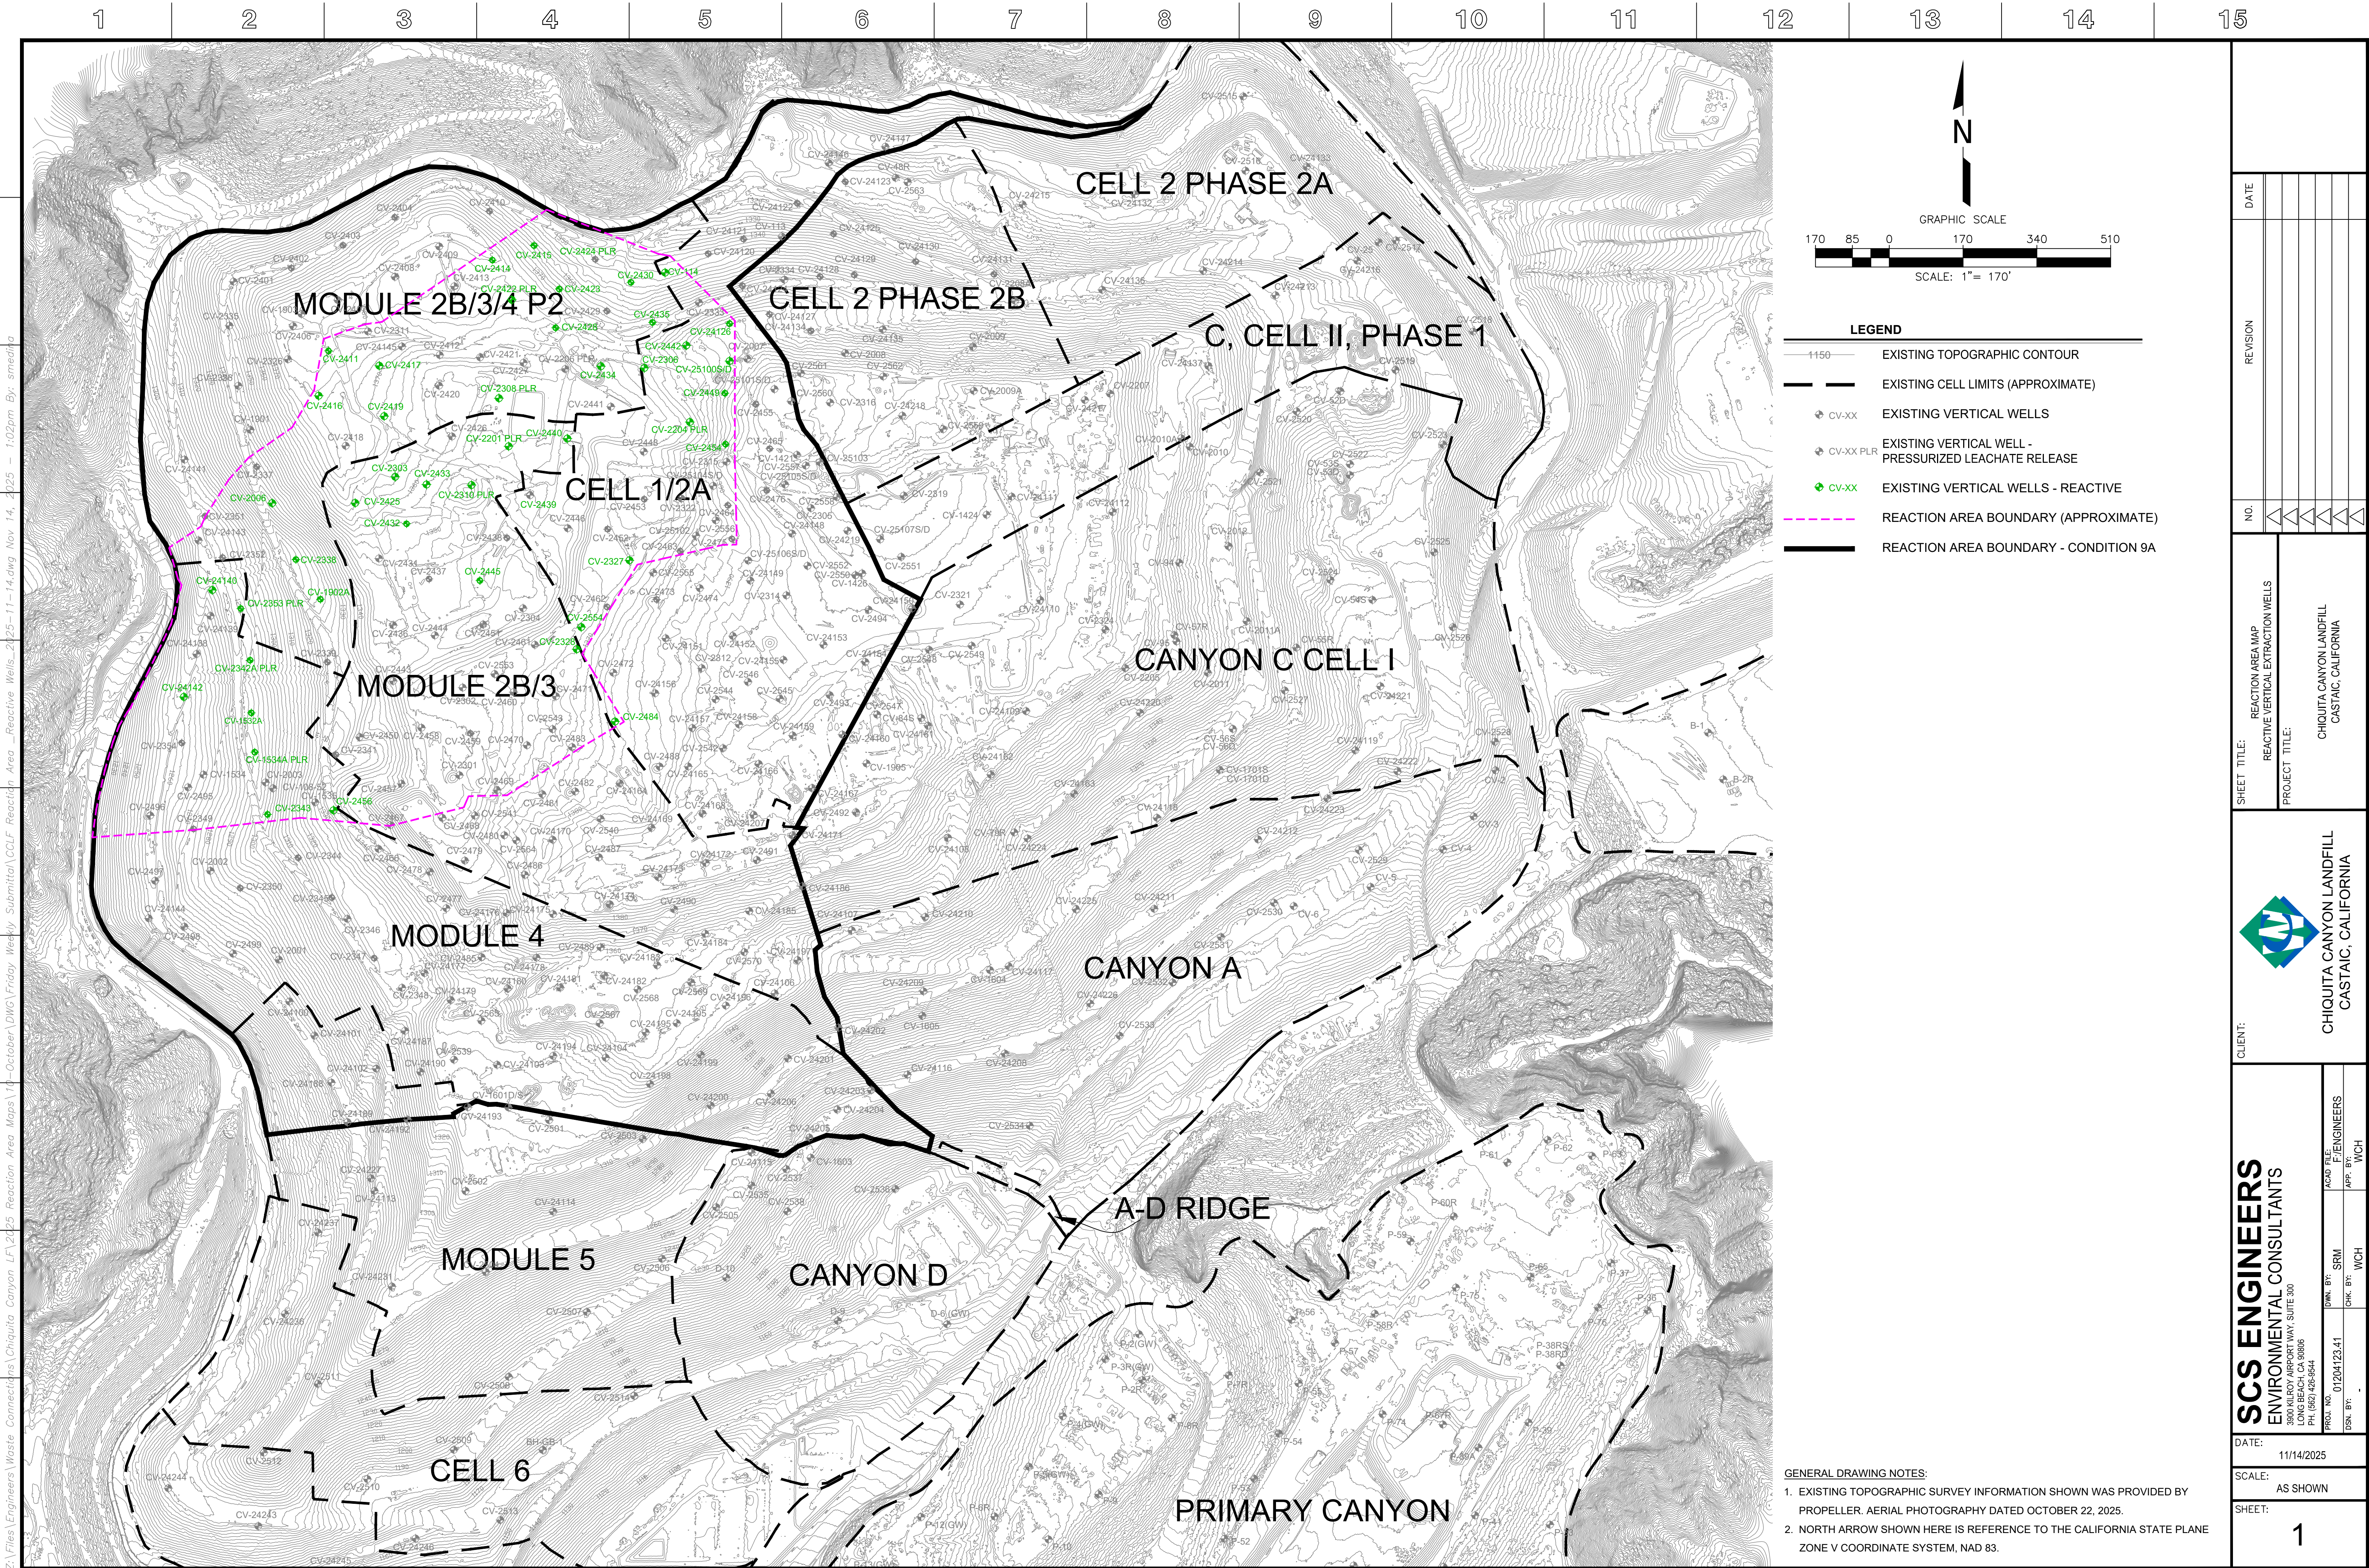


Z:\Files\Engineers\Waste Connections\Chiquita Canyon LF\12425 Reaction Area Maps\11--October\DWG\Friday Weekly Submittal\CCLF Reaction Area_Reactive Wells_2025-11-14.dwg Nov 14, 2025 -- 1:02pm By: smieding

P:\SITES\CHIQUITA CYN LF\MONITORING SUMMARY\FIGURES-WEEKLY\RM22.1077-CCL-EVOH-FIG 1-(2025-11-12).DWG November 13, 2025 - 4:53 PM BY: GLA-USER

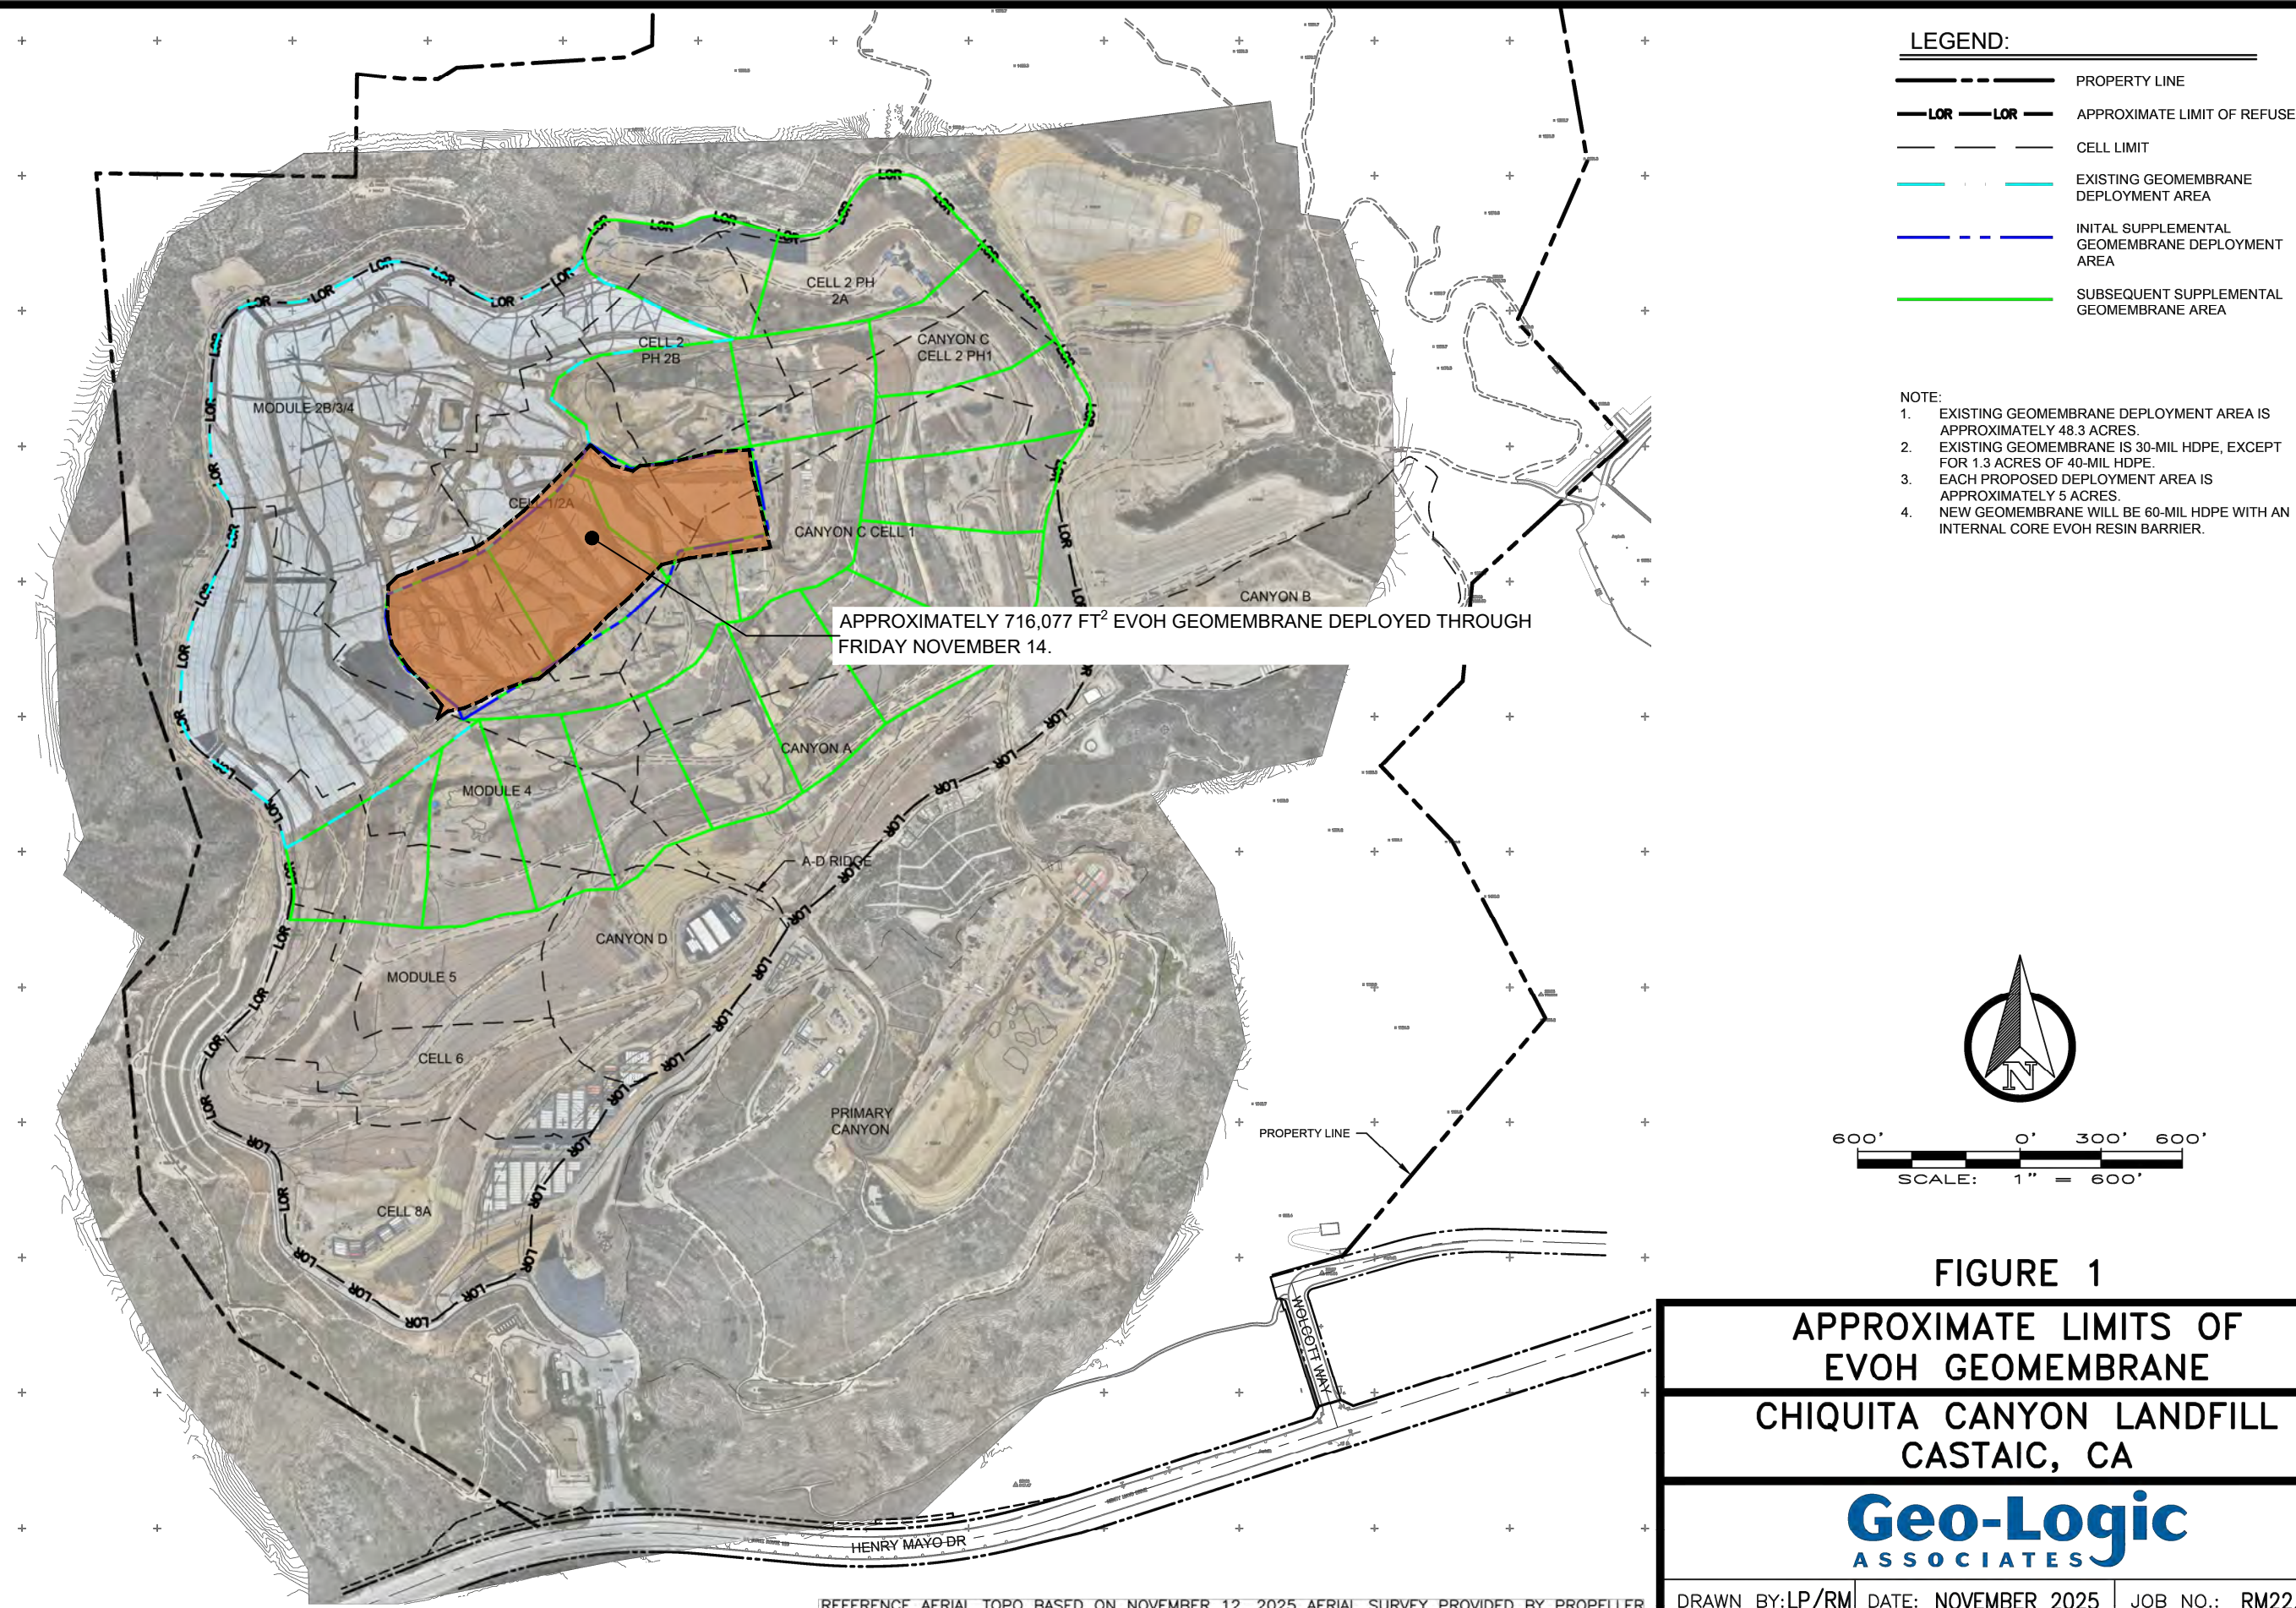

Chiquita Canyon Landfill - Isopach

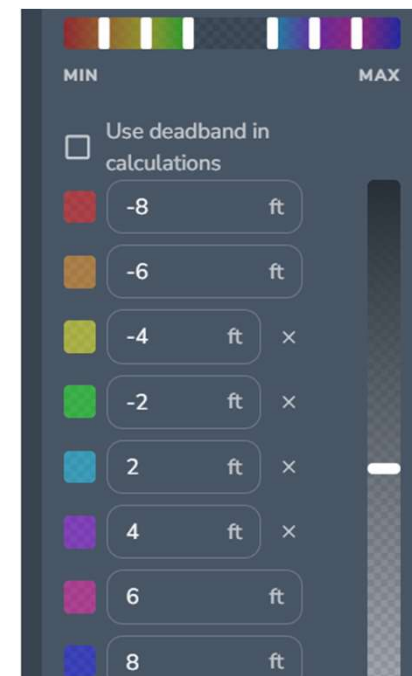

October 29, 2025 Survey Image. October 1, 2025 vs October 29, 2025