

Archived: Tuesday, December 2, 2025 2:38:49 PM
From: [Medina, Steven](#)
Sent: Wednesday, November 26, 2025 1:03:45 PM
To: bchen@aqmd.gov
Cc: [Haley, William \(Bill\)](#)
Subject: Re: Case No. 6177-4 Stipulated Order for Abatement â€œ Well Drilling Update
Importance: Normal
Sensitivity: None
Attachments: [Image.png](#)  [2025 CCLF GCCS Expan Master Plan_Proposed LFG Extraction Well and Temp Probe Map_2025-11-26.pdf](#) 

[EXTERNAL SENDER: Use caution with links/attachments]

All,

In accordance with Condition 15(c) of the Stipulated Order, below is the up-to-date construction summary for the Chiquita Canyon Landfill 2025 GCCS Expansion Master Plan Project.

This summary is being submitted early because no LFG vertical extraction wells or temperature probes will be installed from November 27-28, 2025, due to the Thanksgiving holiday.

During 11/24/2025 to 11/28/2025, Chiquita completed the installation of zero (0) vertical LFG extraction wells. The total count of vertical LFG extraction wells installed from December 6, 2023 (the start date of the GCCS Master Expansion) through today is three hundred fifteen (315).

During 11/24/2025 to 11/28/2025, Chiquita completed the installation of zero (0) temperature probes. The total count of temperature probes installed from February 26th, 2024 (the start date of the temperature probe installations) through today is thirty-nine (39).

The wells and temperature probes scheduled for drilling during the week of 12/01/2025 to 12/05/2025 are as follows (subject to change):

Rig (Continuum): CV-2573, CV-2574, CV-2575

Temperature Probe Rig (Boart Longyear): Drilling of the temperature probes is currently on hold due to ongoing Soil Vapor Extraction (SVE) well drilling. Drilling of the temperature probes will resume following the completion and installation of the SVE wells.

STEVEN Ruben Medina, **E.I.T.**

Staff Professional

SCS Engineers

3900 Kilroy Airport Way, Suite 300

Long Beach, CA 90806


858-204-4342 (c)

SMedina@scsengineers.com

Driven by Client Success

www.scsengineers.com

Image

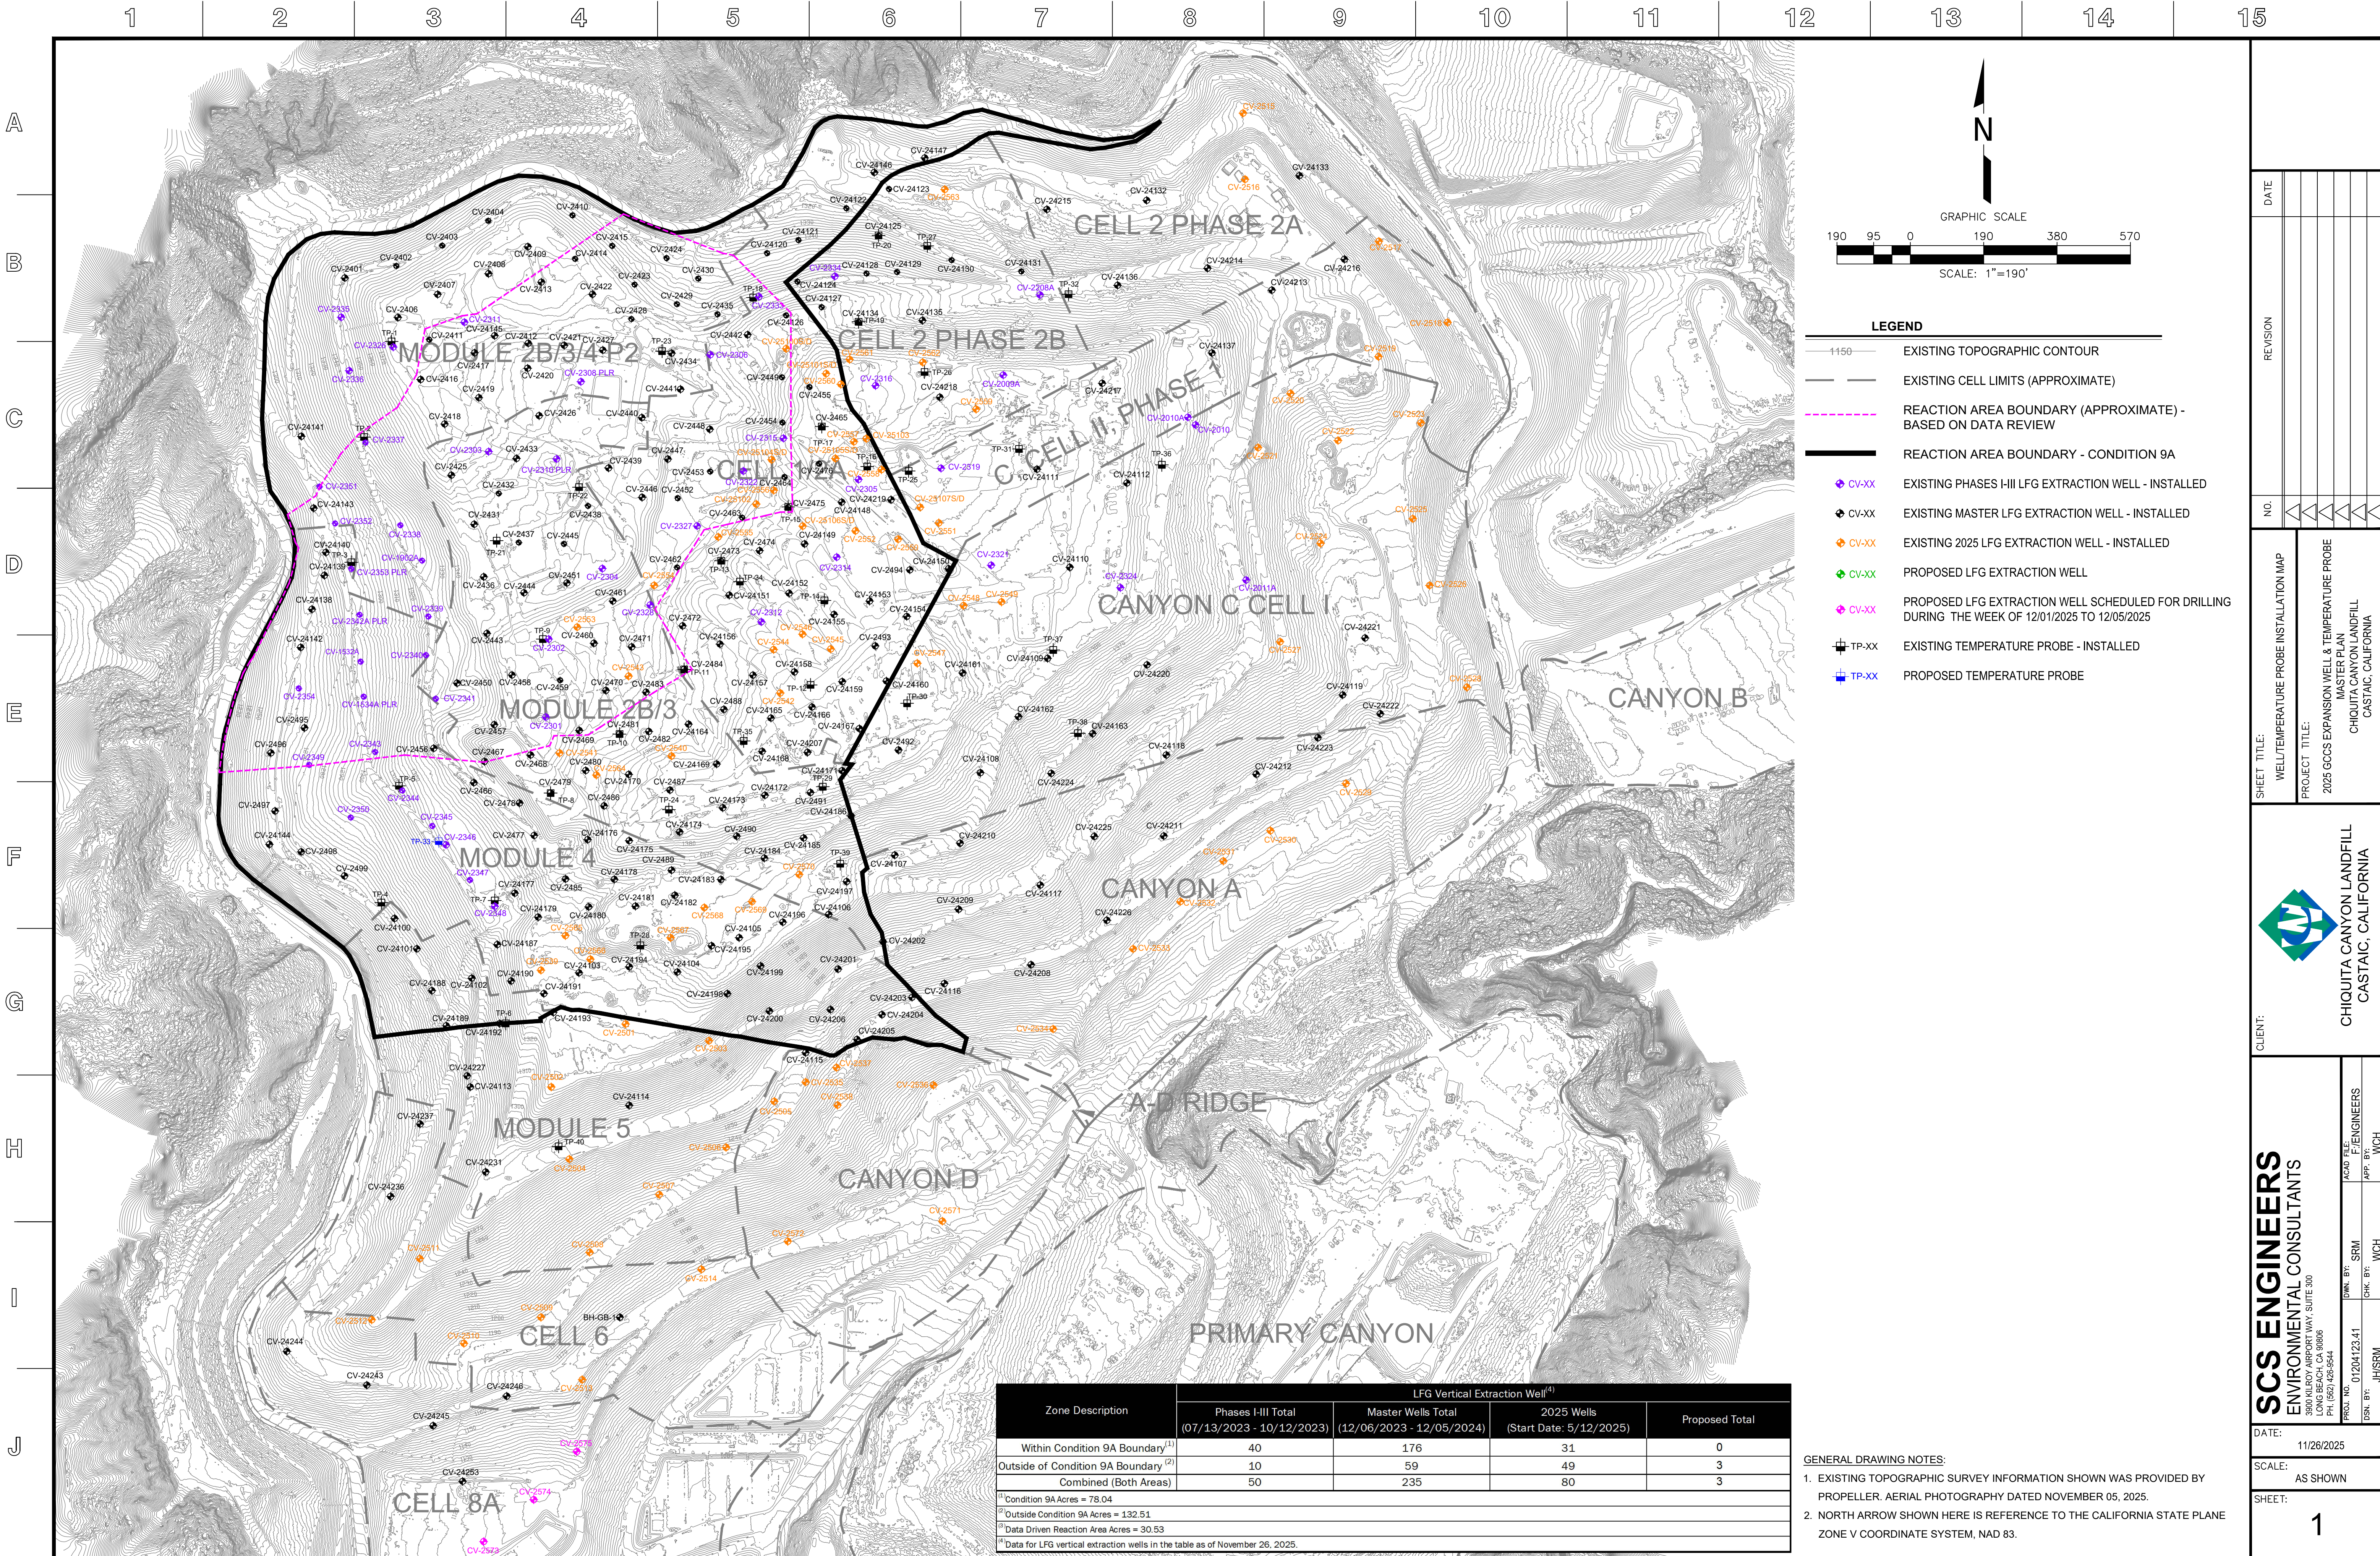

190950190380570

SCALE: 1"=190'

N

LEGEND

1150

EXISTING TOPOGRAPHIC CONTOUR

EXISTING CELL LIMITS (APPROXIMATE)

REACTION AREA BOUNDARY (APPROXIMATE) - BASED ON DATA REVIEW

REACTION AREA BOUNDARY - CONDITION 9A

CV-XX

EXISTING PHASES I-III LFG EXTRACTION WELL - INSTALLED

CV-XX

EXISTING MASTER LFG EXTRACTION WELL - INSTALLED

CV-XX

EXISTING 2025 LFG EXTRACTION WELL - INSTALLED

CV-XX

PROPOSED LFG EXTRACTION WELL

CV-XX

PROPOSED LFG EXTRACTION WELL SCHEDULED FOR DRILLING DURING THE WEEK OF 12/01/2025 TO 12/05/2025

TP-XX

EXISTING TEMPERATURE PROBE - INSTALLED

TP-XX

PROPOSED TEMPERATURE PROBE

NO

DATE

REVISION

SHEET TITLE:
WELL/TEMPERATURE PROBE INSTALLATION MAP

PROJECT TITLE:
2025 GCCS EXPANSION WELL & TEMPERATURE PROBE MASTER PLAN
CHICUITA CANYON LANDFILL
CASTAIC, CALIFORNIA

CLIENT:

SCS ENGINEERS

ENVIRONMENTAL CONSULTANTS

15000 W. ORANGE AVE., SUITE 300
LONG BEACH, CA 90806
PH: (562) 426-9544

DATE:

11/26/2025

SCALE:

AS SHOWN

SHEET:

1

ACAD FILE: F:\ENGINEERS

APP. BY: WCH

CHK. BY: WCH

JH/SRM