

Archived: Tuesday, December 30, 2025 10:34:47 AM
From: [Kate Logan](#)
Sent: Wednesday, December 24, 2025 2:10:26 AM
To: [Karen Gork](#)
Cc: Thalhamer, Todd@CalRecycle
Subject: Chiquita Canyon Landfill – Geosynthetic Cover – Mitigation Measure 4.1
Importance: Normal
Sensitivity: None
Attachments: [2025-12-23 Figure 1 EVOH Location-Layout\(12.19\).pdf](#) [CLF Reaction Area _Reactive Wells_ 2025-12-19.pdf](#) [050 2025-12-05 Milestone 2B Chiquita Canyon LF Isopach _November 2025.pdf](#)

[EXTERNAL SENDER: Use caution with links/attachments]

Below is Chiquita's weekly update on the status of the installation of the 60-mil EVOH/HDPE geomembrane cover at the Chiquita Canyon Landfill, in accordance with Mitigation Measure 4.1 of the LEA's Compliance Order issued May 1, 2025. This update is being submitted early due to the Christmas holiday.

As of December 19, 2025, D&E, on behalf of Chiquita, has installed approximately 781,783 square feet of tan 60-mil EVOH/HDPE geomembrane cover. Additional repairs and detailing were performed on existing panels, including fabricating boots, patching, extrusion welding, and re-seaming, as needed.

The attached site map shows the approximate extent of geomembrane cover installed as of Friday, December 19, 2025, as well as the geomembrane coverage described in the revised draft workplan for extension of the geomembrane cover area submitted to the LEA, the US EPA, and DTSC on October 3, 2025. Also attached to this submission are the November 2025 monthly isopach map and a figure identifying wells showing signs of reaction as of December 19, 2025. Due to technical limitations, we are currently unable to create one figure including all of this data.


Additionally, during the week of December 15, 2025, Chiquita continued preparing an area known as "the bowl" for EVOH/HDPE geomembrane cover deployment. Currently, the "bowl" is covered with 30-mil HDPE geomembrane cover. Once the preparation work has been completed, Chiquita will replace portions of the existing 30-mil HDPE geomembrane cover with 60-mil EVOH/HDPE geomembrane cover. As part of the preparation work, as of December 12, 2025, Chiquita has placed a total of approximately 12,973 cubic yards of soil in grids 178, 184, and 185, which is also shown in the attached map. The depth of soil varies, but ranges between 0.5 feet and 4 feet. Chiquita is replacing the existing 30-mil HDPE geomembrane cover in these areas to address the discoloration of geomembrane cover in this area.


Thanks,

Kate Logan
Senior Remediation Project Manager
Chiquita Canyon Landfill
29201 Henry Mayo Dr.
Castaic, CA 91384
(m) (346) 807-5547
Kate.Logan@WasteConnections.com





P:\SITES\CHIQUITA CYN LF\MONITORING SUMMARY\FIGURES-WEEKLY\RM22.1077-CCL-EVOH-FIG 1-(2025-12-17).DWG December 18, 2025 - 3:31 PM BY: GLA-USER

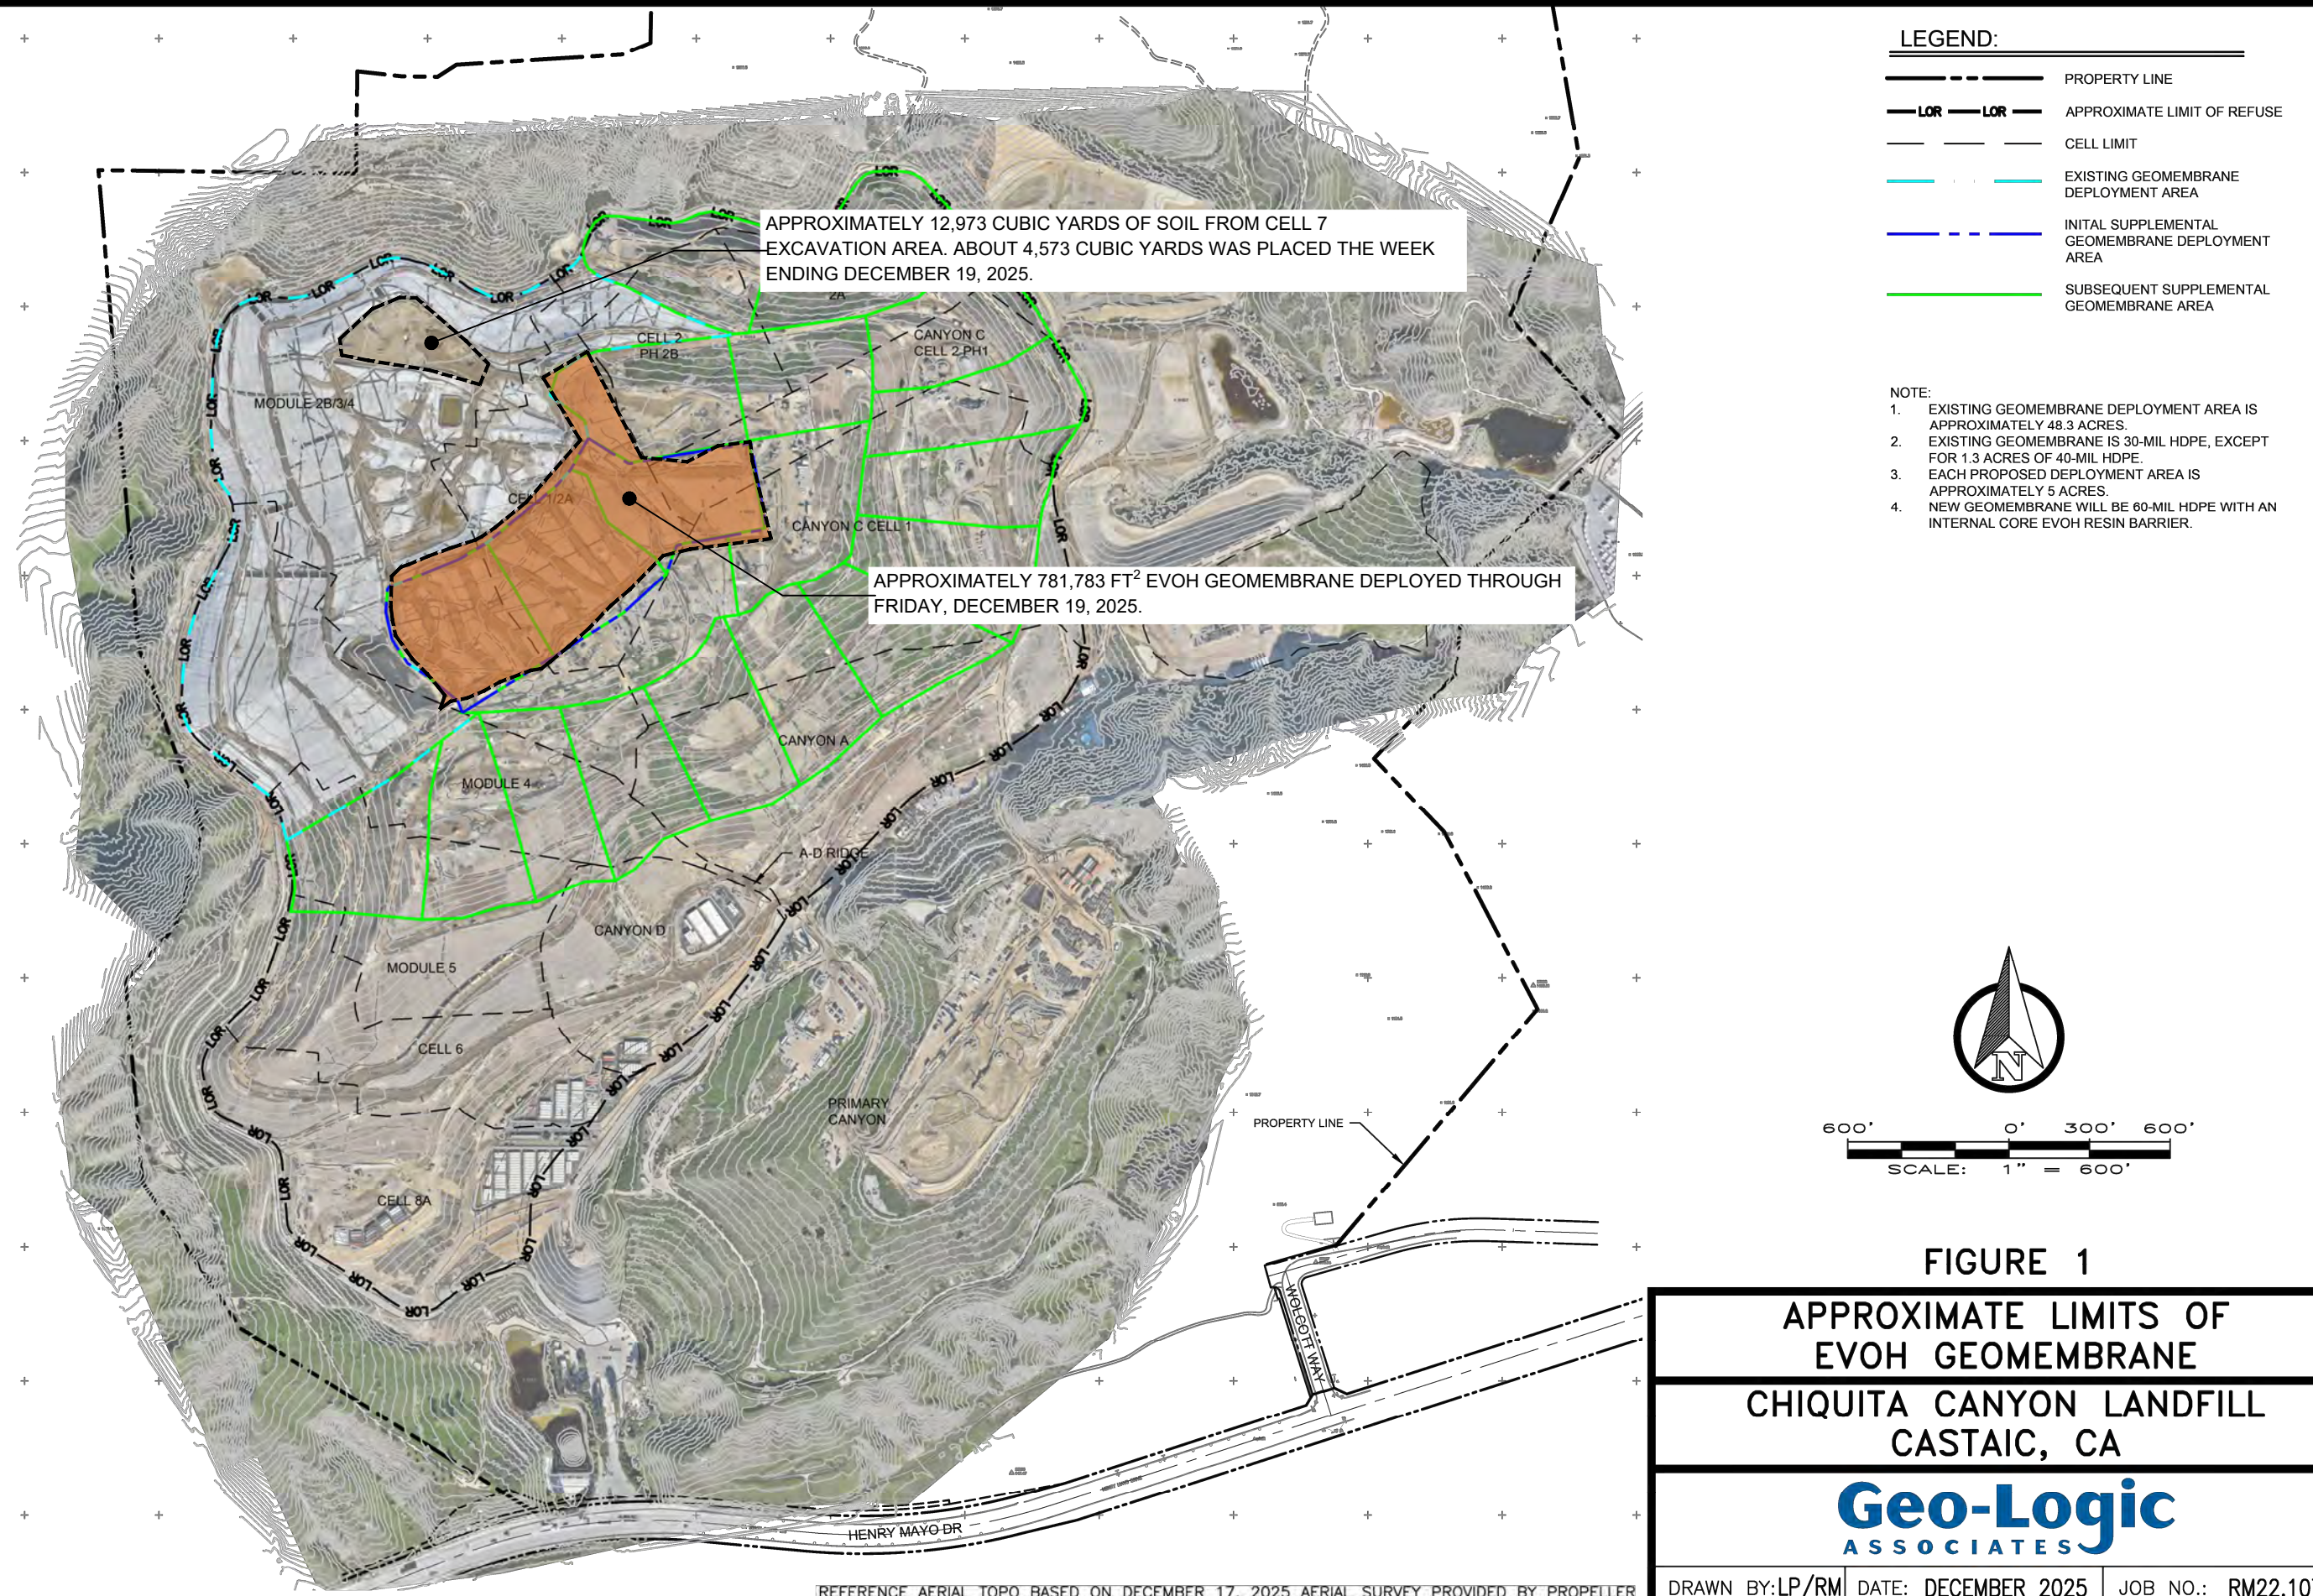

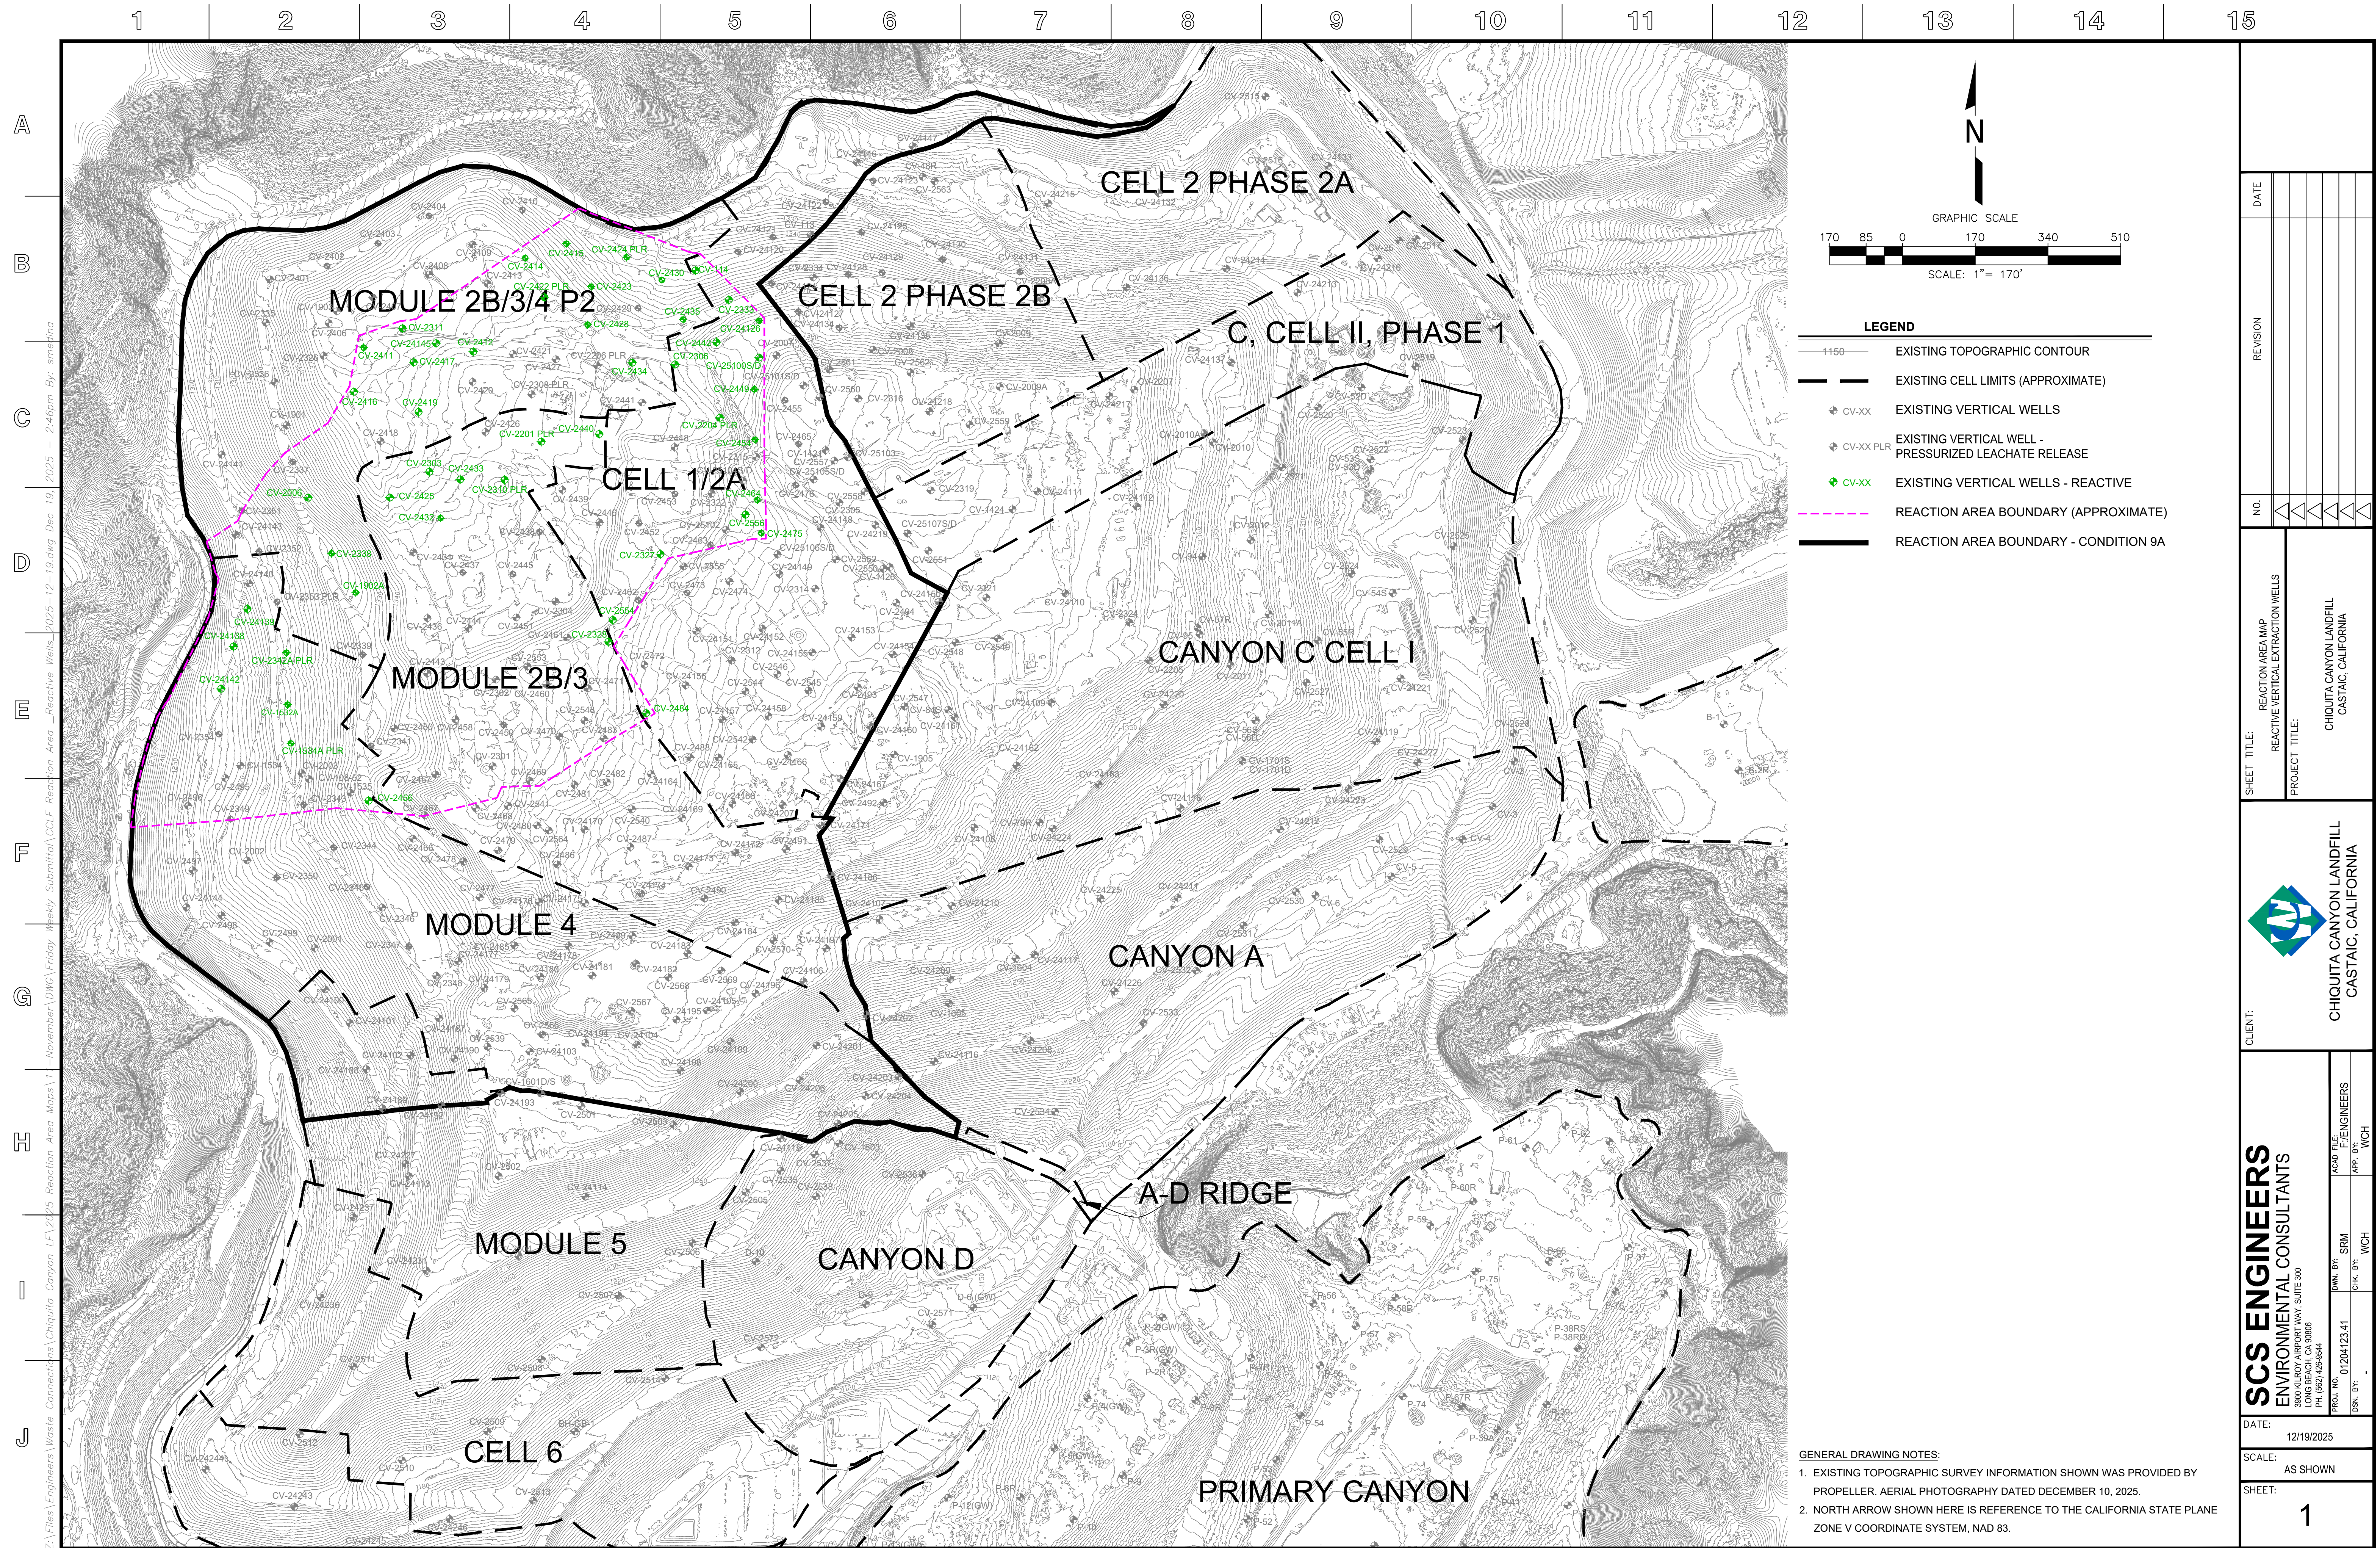

Chiquita Canyon Landfill - Isopach

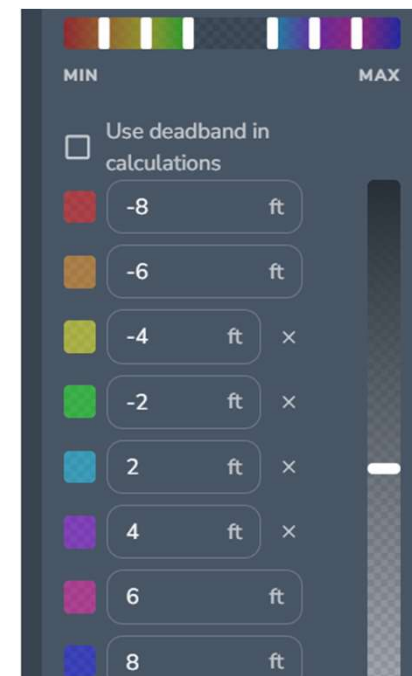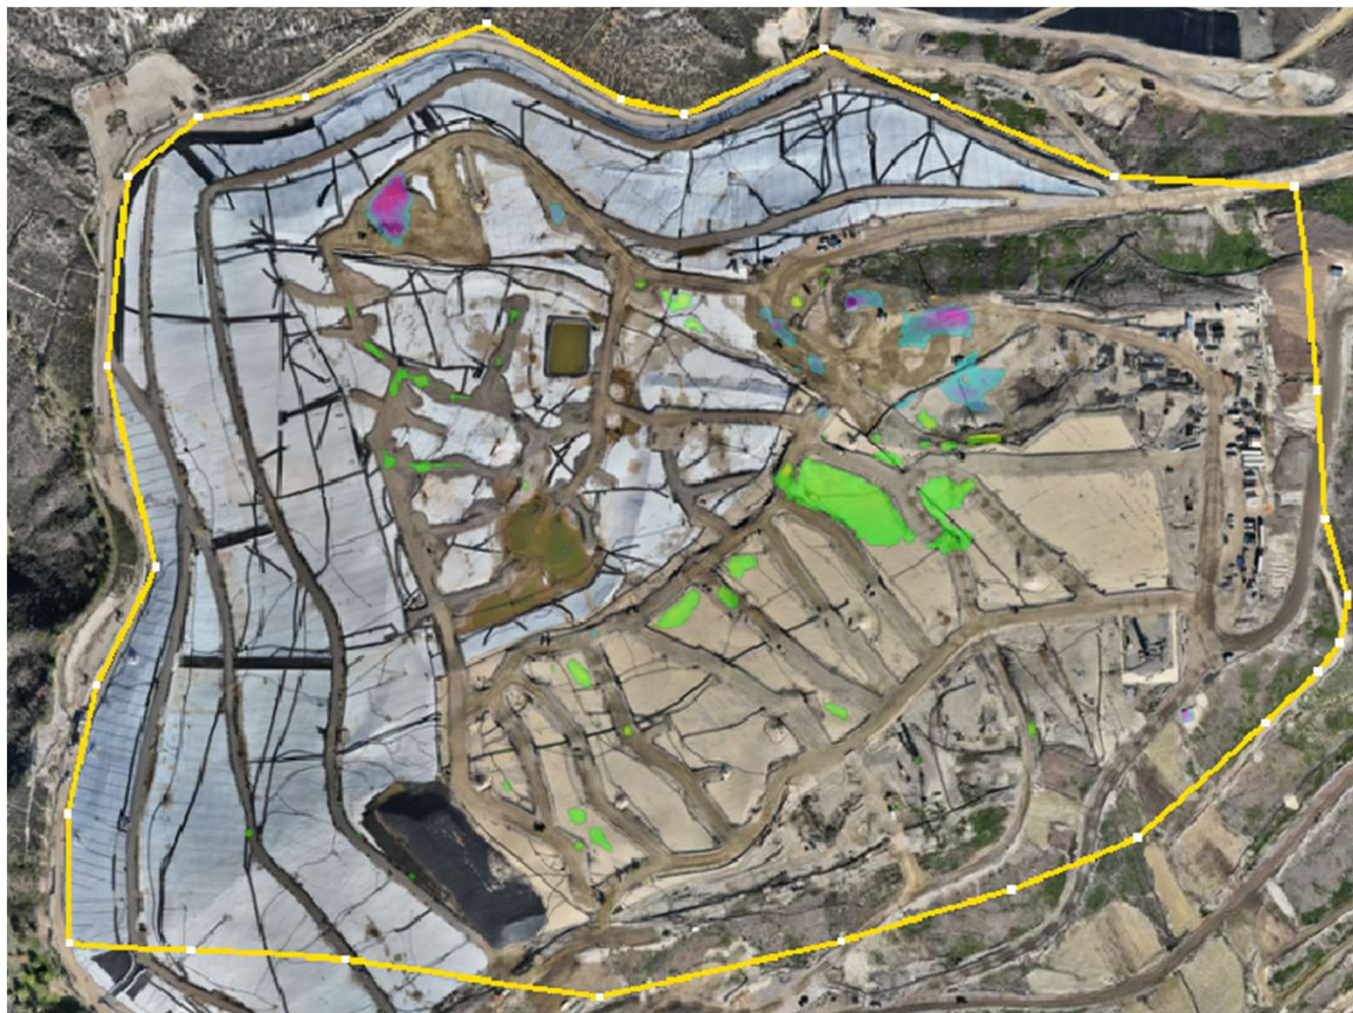

December 3, 2025 Survey Image. October 29, 2025 vs. December 3, 2025