

Archived: Wednesday, December 17, 2025 4:10:09 PM
From: [Kate Logan](#)
Sent: Friday, December 12, 2025 2:19:57 PM
To: [Karen Gork](#)
Cc: Thalhamer, Todd@CalRecycle
Subject: Chiquita Canyon Landfill – Geosynthetic Cover – Mitigation Measure 4.1
Importance: Normal
Sensitivity: None
Attachments: [CCLF Reaction Area _Reactive Wells_ 2025-12-05.pdf](#)  [050 2025-12-05 Milestone 2B Chiquita Canyon LF Isopach _November 2025.pdf](#)  [2025-11-14 Figure 1 EVOH Location-Layout1 \(2\).pdf](#) 

[EXTERNAL SENDER: Use caution with links/attachments]

Below is Chiquita's weekly update on the status of the installation of the 60-mil EVOH/HDPE geomembrane cover at the Chiquita Canyon Landfill, in accordance with Mitigation Measure 4.1 of the LEA's Compliance Order issued May 1, 2025.

As of December 5, 2025, D&E, on behalf of Chiquita, has installed approximately 716,077 square feet of tan 60-mil EVOH/HDPE geomembrane cover. Continued wet weather conditions during the week of December 1, 2025 prevented further deployment of the EVOH/HDPE geomembrane cover. Notwithstanding, Chiquita completed the preparation of Segment 3 for EVOH/HDPE geomembrane cover deployment. Additional repairs and detailing were performed on existing panels, including fabricating boots, patching, extrusion welding, and re-seaming, as needed. D&E resumed deployment of the EVOH/HDPE geomembrane cover on December 8, 2025 and anticipates that it will complete the installation of EVOH/HDPE geomembrane cover in Segment 3 by December 12, 2025.

Additionally, during the week of December 1, 2025, Chiquita began preparing an area in grid 184 known as "the bowl" for EVOH/HDPE geomembrane cover deployment. Currently, the "bowl" is covered with 30-mil HDPE geomembrane cover. Once the preparation work has been completed, Chiquita will replace portions of the 30-mil HDPE cover with 60-mil EVOH/HDPE geomembrane cover.

The attached site map shows the approximate extent of geomembrane cover installed as of Friday, December 5, 2025, as well as the geomembrane coverage described in the revised draft workplan for extension of the geomembrane cover area submitted to the LEA, the US EPA, and DTSC on October 3, 2025. Also attached to this submission are the November 2025 monthly isopach map and a figure identifying wells showing signs of reaction as December 5, 2025. Due to technical limitations, we are currently unable to create one figure including all of this data.


Chiquita is evaluating the LEA's December 10, 2025 email requesting identification of repair areas on the map and additional details related to the repair work. Chiquita will provide further updates in next week's submittal.

Thanks,



Kate Logan
Senior Remediation Project Manager
Chiquita Canyon Landfill
29201 Henry Mayo Dr.
Castaic, CA 91384
(m) (346) 807-5547
Kate.Logan@WasteConnections.com



WASTE CONNECTIONS
Connect with the Future

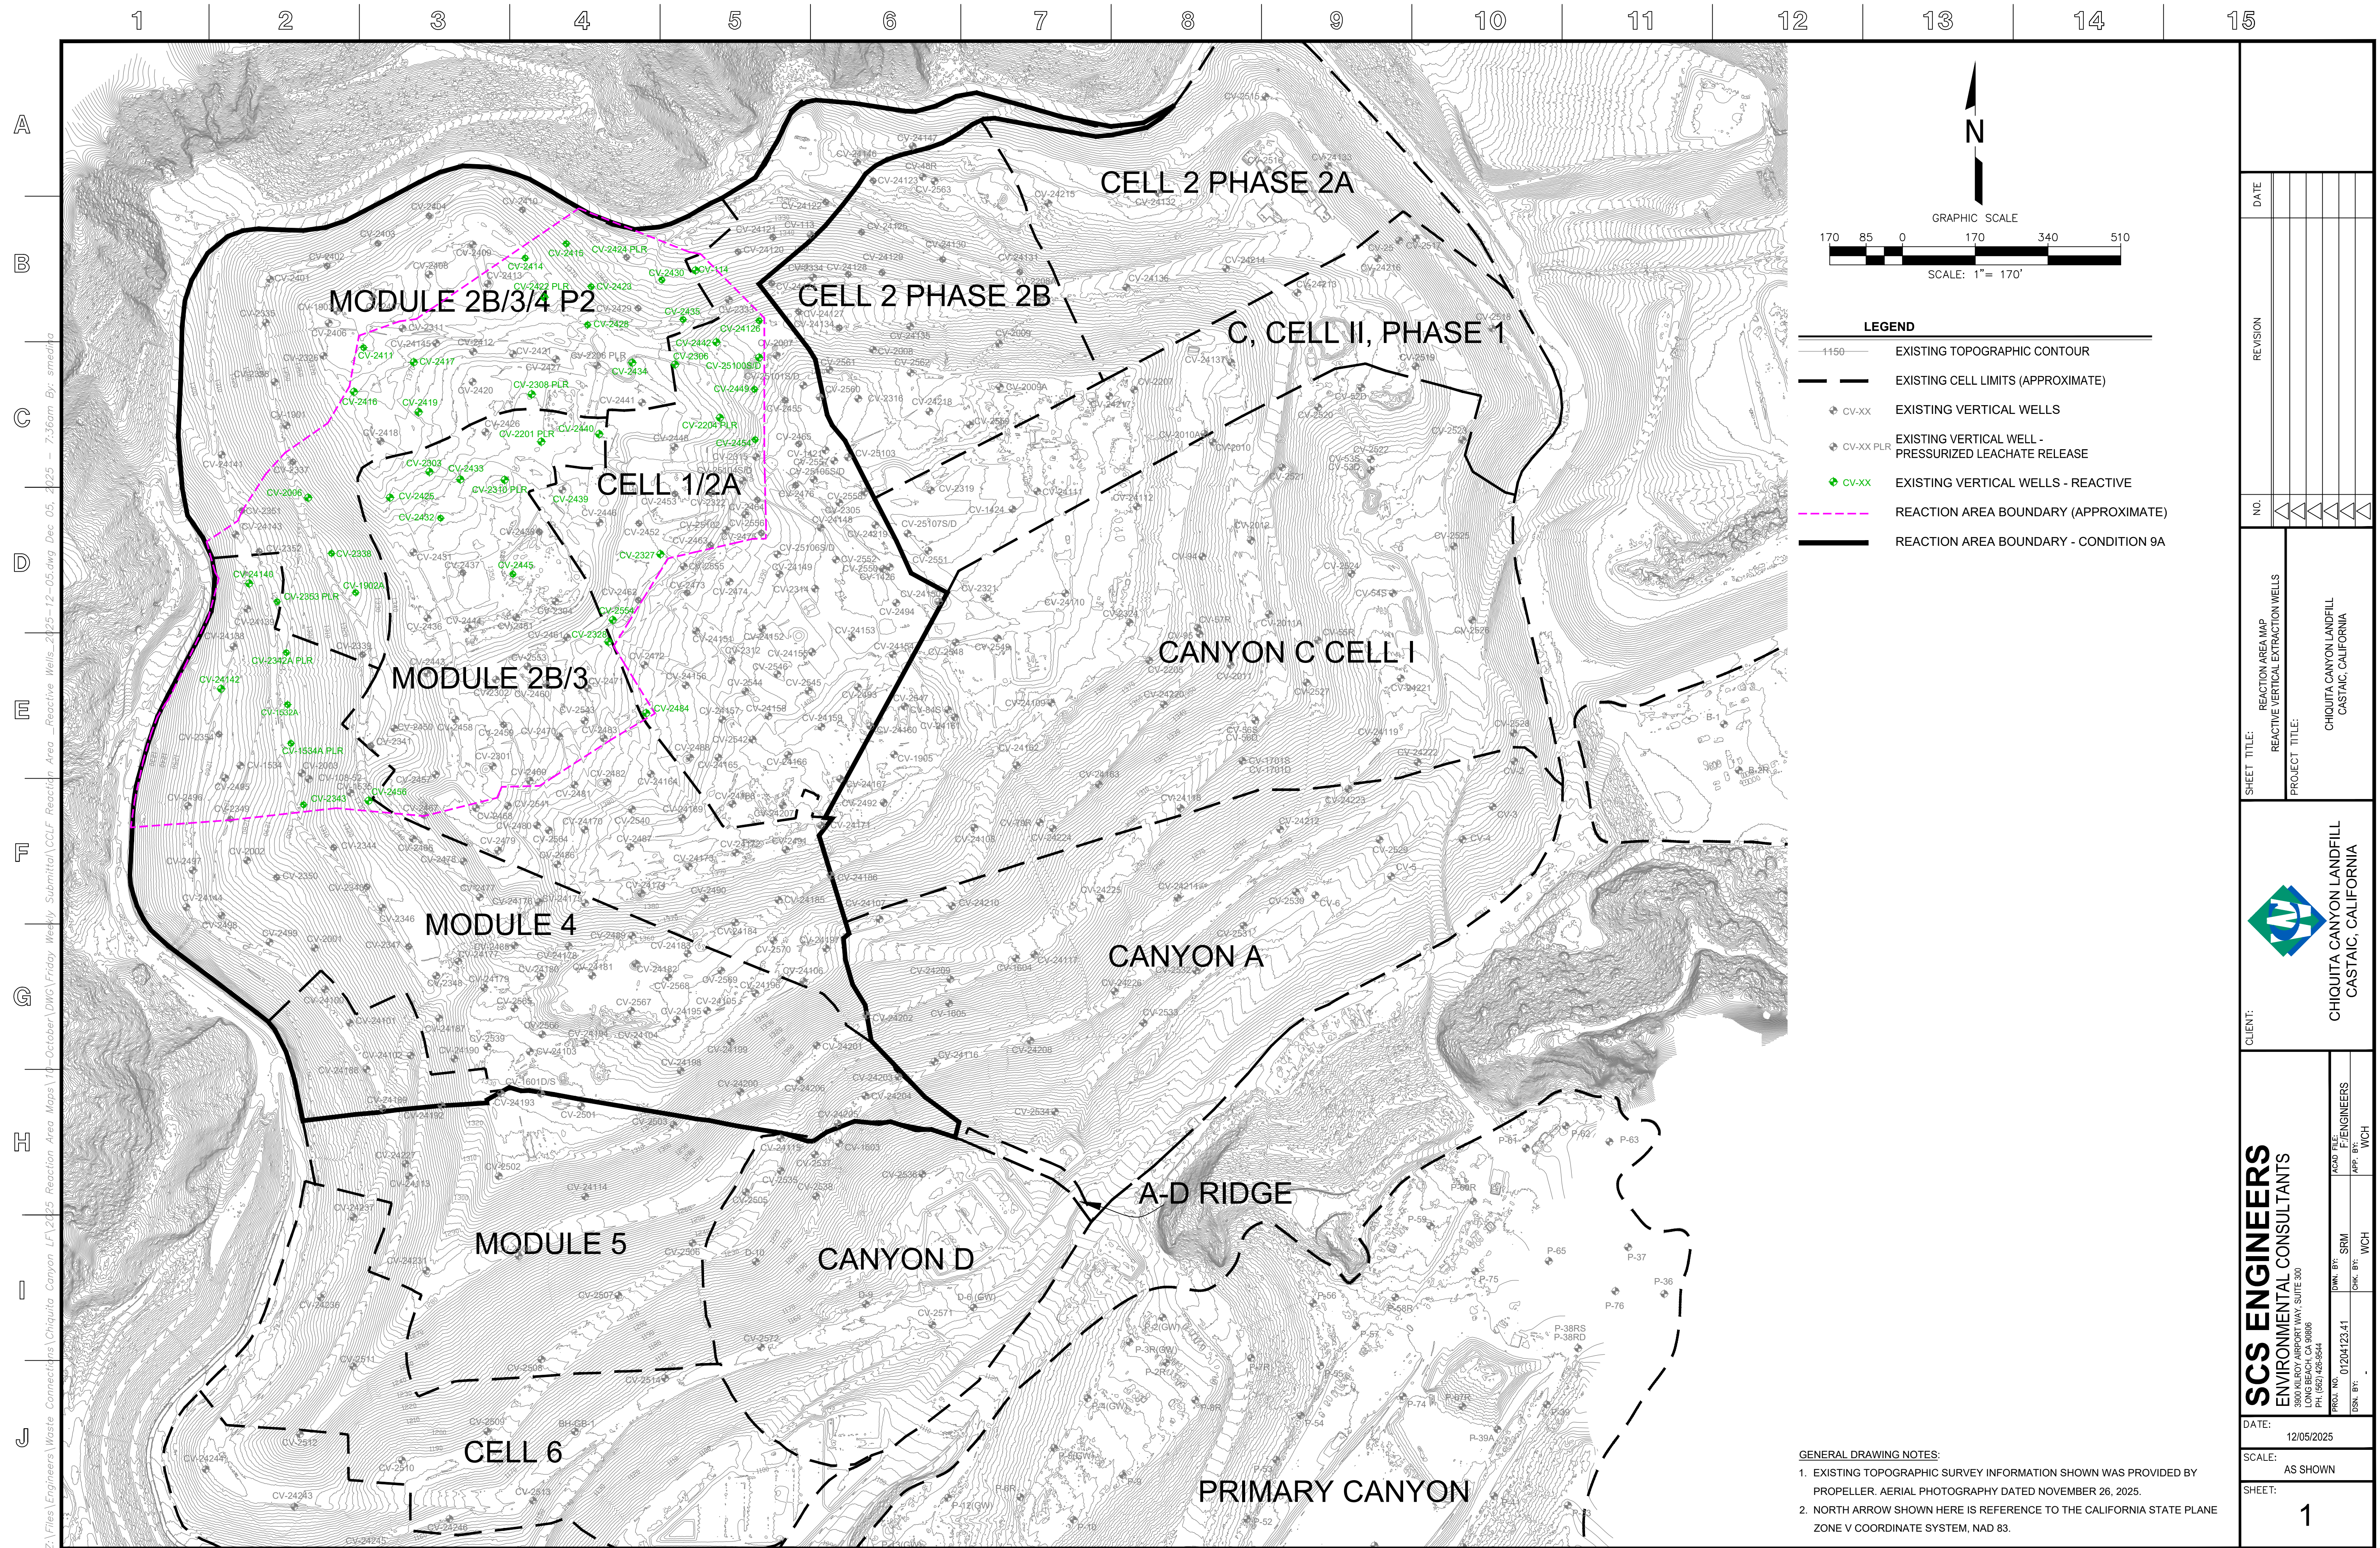

Chiquita Canyon Landfill - Isopach

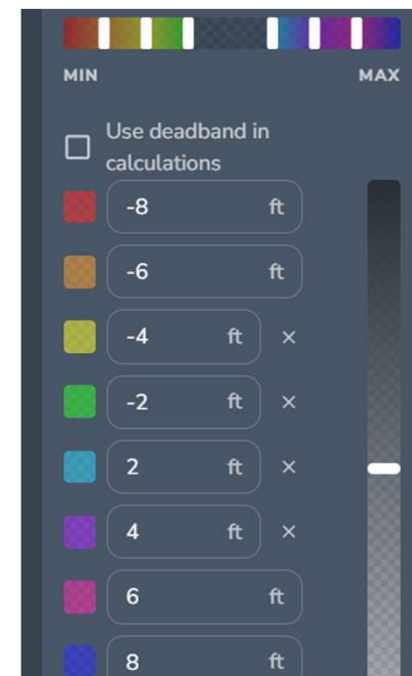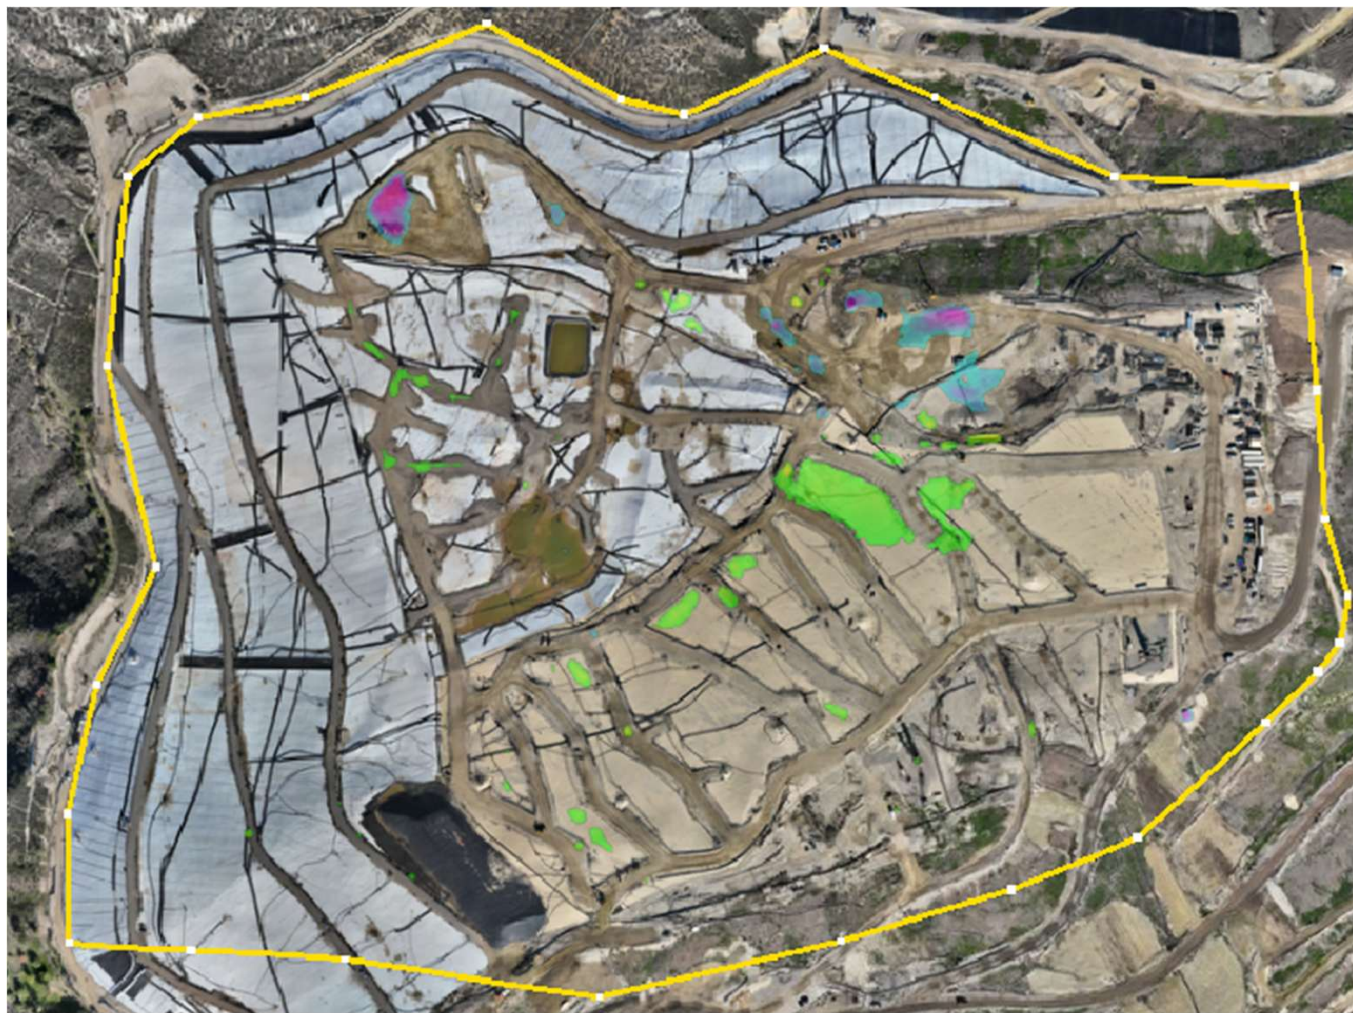

December 3, 2025 Survey Image. October 29, 2025 vs. December 3, 2025

P:\SITES\CHIQUITA CYN LF\MONITORING SUMMARY\FIGURES-WEEKLY\RM22.1077-CCL-EVOH-FIG 1-(2025-11-12).DWG November 13, 2025 - 4:53 PM BY: GLA-USER

