

**Archivado:** Viernes 7 de febrero de 2025 10:12:55 AM

**De:** [Medina, Steven](#)

**Enviado:** Viernes 31 de enero de 2025 3:57:00 PM

**Para:** [bchen@aqmd.gov](mailto:bchen@aqmd.gov) [ndickel@aqmd.gov](mailto:ndickel@aqmd.gov) [Christina Ojeda](#)

**Cc:** [Steve Cassulo](#) [Haley, William \(Bill\)](#) [Amanda Froman](#) [Michael Hearn](#) [Nicole Ward](#)

[Christopher.Fear@WasteConnections.com](mailto:Christopher.Fear@WasteConnections.com) [Viswanathan, Srividhya](#) [Kelly Kincella](#)

**Asunto:** Ref.: Orden de Depuración Estipulada del Caso No. 6177-4 - Actualización sobre la Instalación y Operación Semanal de las Bombas

**Importancia:** Normal

**Sensibilidad:** Ninguna

**Adjunto:**

[Outlook-xwp1d4td.png](#); [Outlook-yz2xcsz0.png](#); [Outlook-g14t4pxu.png](#); [Outlook-3ydyax1.png](#); [Outlook-mycbcg15.png](#); [Outlook-exf4xxwn.png](#); [Outlook-yr13ifv2.png](#); [Outlook-c5rfdzfd.png](#); [Outlook-gr5jgpbp.png](#); [Outlook-11mwtb3v.png](#); [Outlook-ldvrz44r.png](#); [Outlook-o3bo5xwt.png](#); [Outlook-51hs21sv.png](#); [Outlook-tmjzjcyo.png](#); [Outlook-kp0lkfru.png](#); [Outlook-gz1r33r2.png](#); [Outlook-3bh1jlnb.png](#); [Outlook-32pq43f1.png](#); [Outlook-hxrpamhf.png](#); [Outlook-x1gwo1o3.png](#); [Outlook-j4ttolvm.png](#); [Outlook-5xoyuaze.png](#); [Outlook-racdaw0g.png](#); 2025 CCLF Existing De-Watering Well with Pump Map\_2025-01-31.pdf;

---

[REMITENTE EXTERNO: Tenga precaución con los enlaces/adjuntos]

Todos,

Según la Condición 65 de la Orden Estipulada Modificada, a continuación se encuentra el resumen de la instalación y operación de las bombas de desagüe para el Vertedero de Chiquita Canyon.

Durante el período que transcurrió desde el 24/01/2025 hasta el 30/01/2025, Chiquita completó la instalación y comenzó a operar durante el día dos (2) bombas en pozos verticales de extracción de LFG dando un total de ciento veintiocho (128) bombas operado en pozos verticales de extracción de LFG. Por favor, consulte el mapa actualizado adjunto de los pozos de LFG con bombas operando.

Durante el período que va del 31/01/2025 hasta el 06/02/ 2025, dada la cantidad de bombas de desagüe instaladas hasta la fecha y el mantenimiento asociado a esas bombas, Chiquita tiene planeado instalar y comenzar a operar otras tres (3) bombas en pozos verticales de extracción de LFG en ubicaciones a lo largo de la pendiente norte y sur de la zona reactiva. Las ubicaciones de las instalaciones de las bombas para la semana que viene están sujetas a cambios debido a las condiciones climáticas y/o de seguridad.

Atentamente,

**STEVEN** Rubén Medina, **E.I.T.**

Profesional Asociado

**SCS Engineers**

3900 Kilroy Airport Way, Suite 100

Long Beach, CA 90806


858-204-4342 (c)

[5160srm@scsengineers.com](mailto:5160srm@scsengineers.com)

**Dirigidos por el Éxito de los Clientes**

[www.scsengineers.com](http://www.scsengineers.com)

---

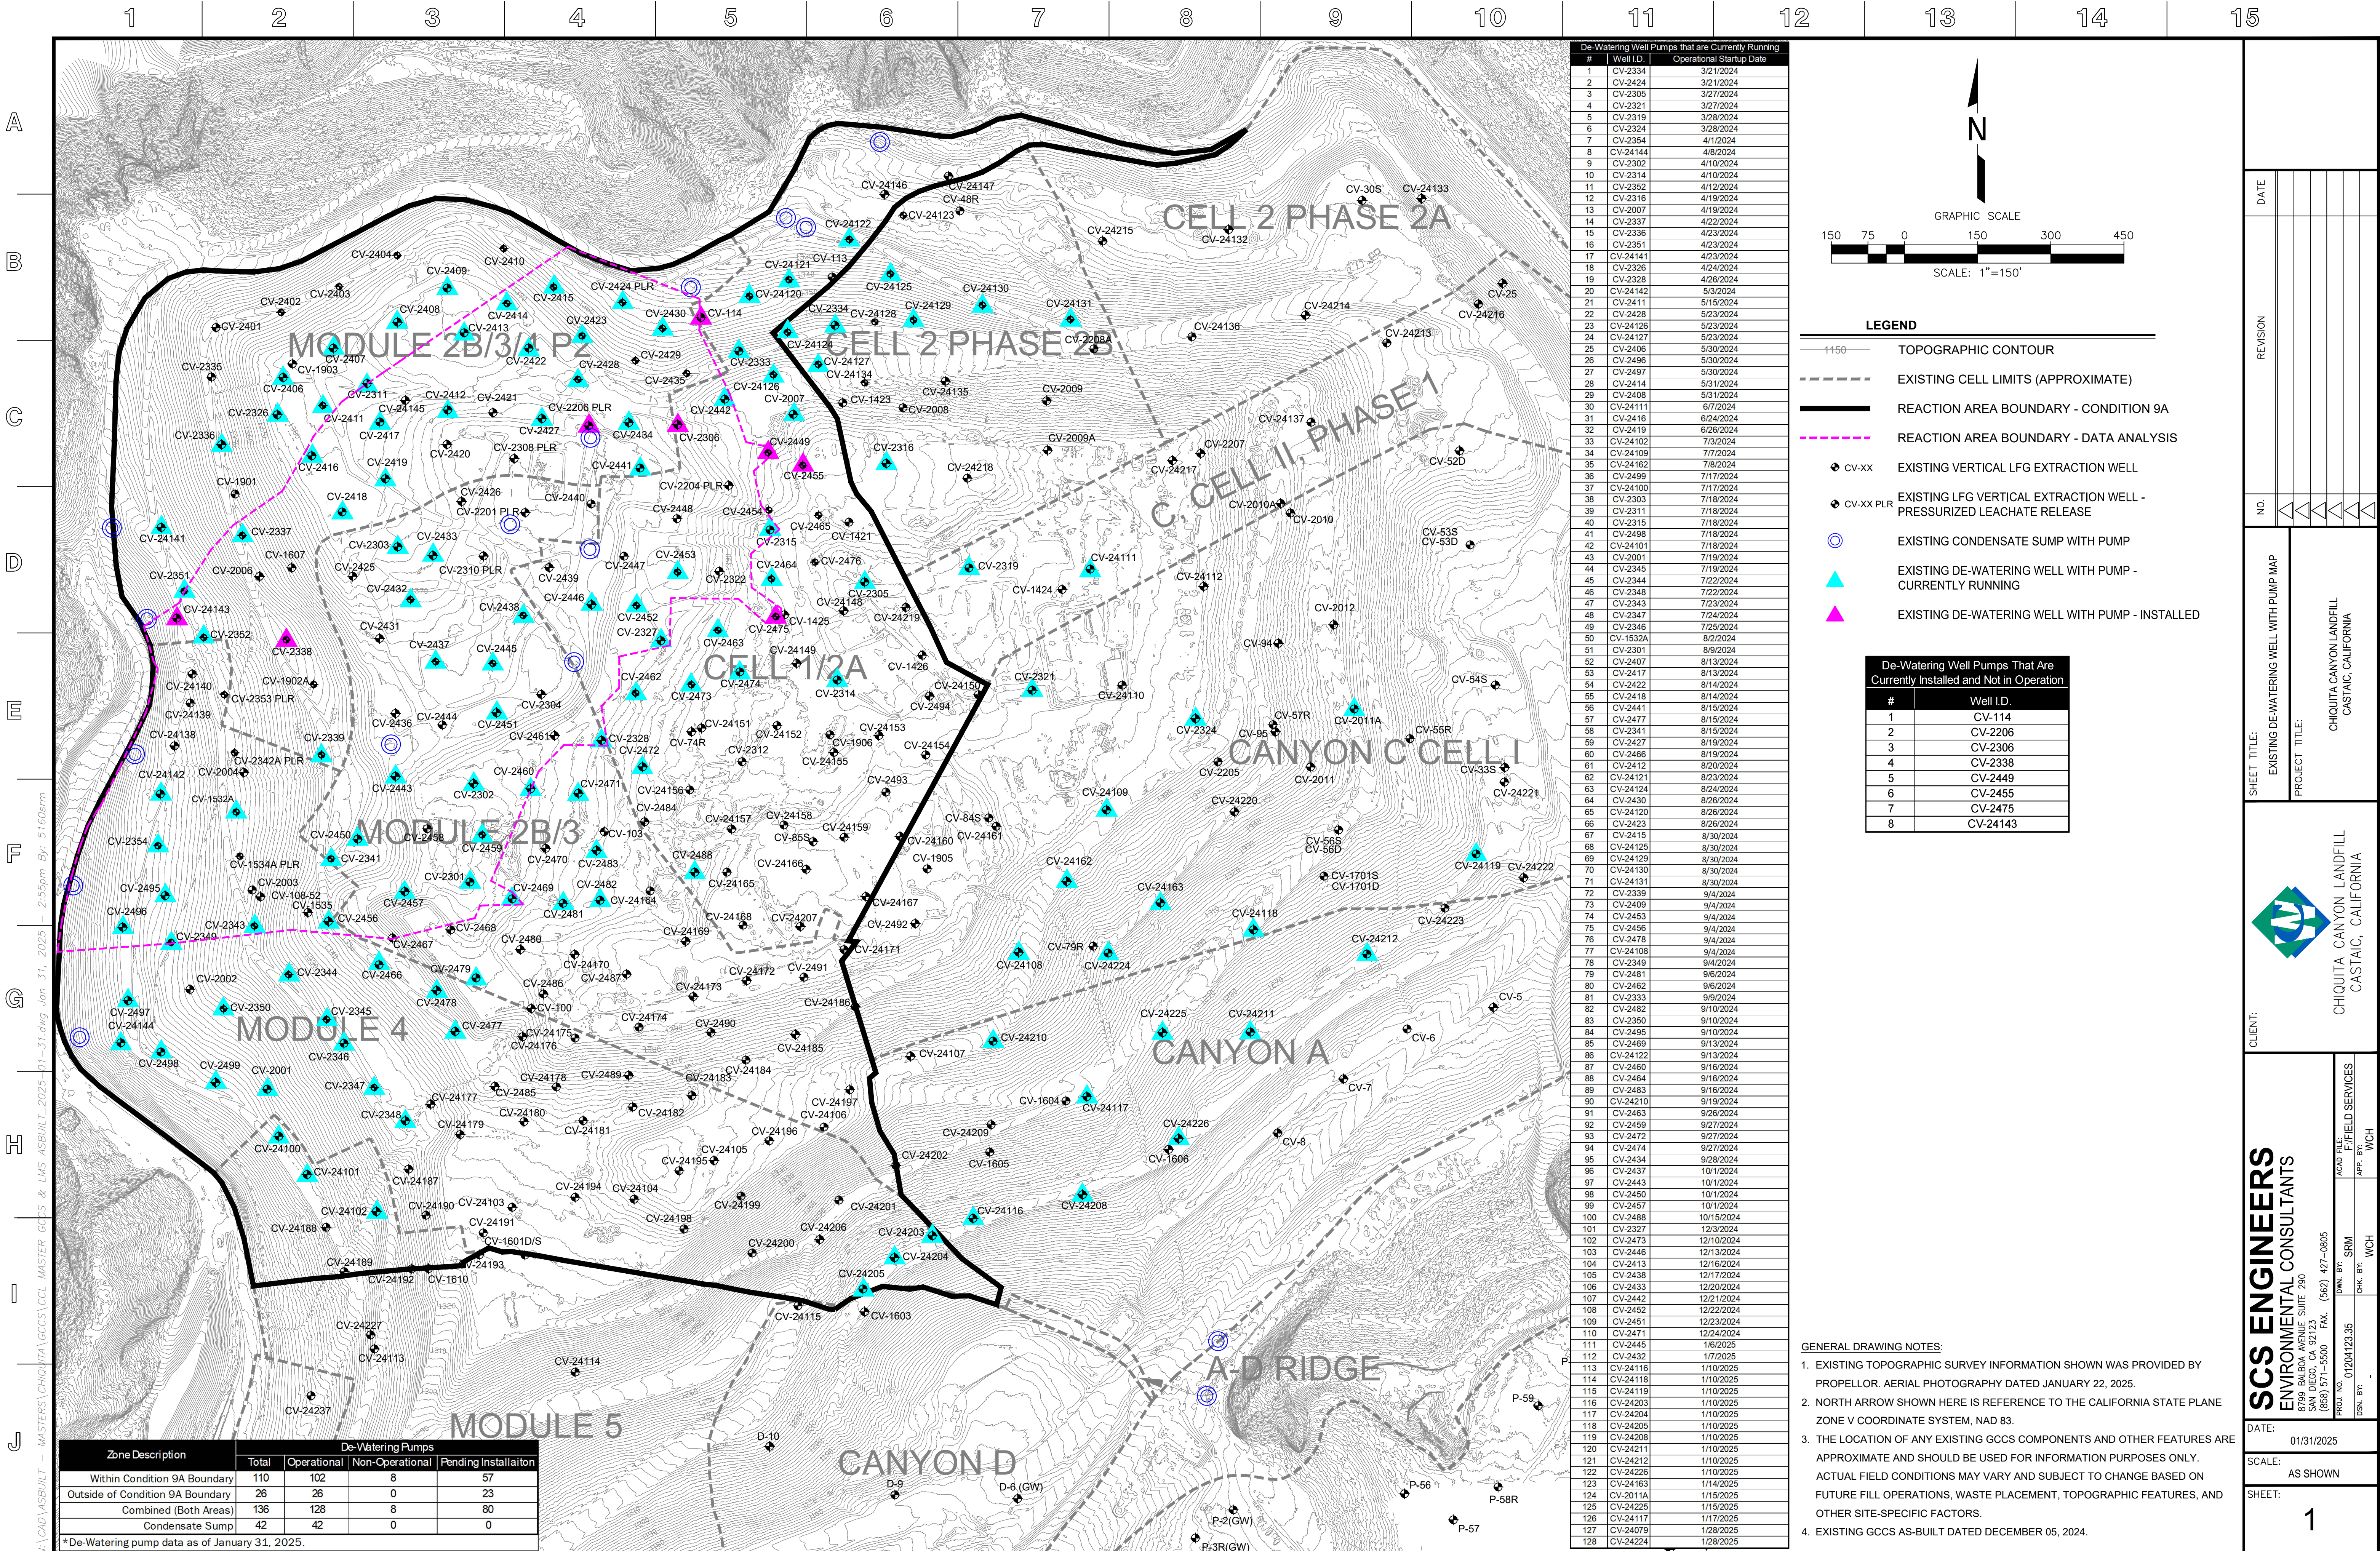

| De-Watering Well Pumps that are Currently Running |           |                          |
|---------------------------------------------------|-----------|--------------------------|
| #                                                 | Well I.D. | Operational Startup Date |
| 1                                                 | CV-2334   | 3/21/2024                |
| 2                                                 | CV-2424   | 3/21/2024                |
| 3                                                 | CV-2305   | 3/27/2024                |
| 4                                                 | CV-2321   | 3/27/2024                |
| 5                                                 | CV-2319   | 3/28/2024                |
| 6                                                 | CV-2324   | 3/28/2024                |
| 7                                                 | CV-2354   | 4/1/2024                 |
| 8                                                 | CV-24144  | 4/8/2024                 |
| 9                                                 | CV-2302   | 4/10/2024                |
| 10                                                | CV-2314   | 4/10/2024                |
| 11                                                | CV-2352   | 4/12/2024                |
| 12                                                | CV-2316   | 4/19/2024                |
| 13                                                | CV-2007   | 4/19/2024                |
| 14                                                | CV-2337   | 4/22/2024                |
| 15                                                | CV-2336   | 4/23/2024                |
| 16                                                | CV-2351   | 4/23/2024                |
| 17                                                | CV-24141  | 4/23/2024                |
| 18                                                | CV-2326   | 4/24/2024                |
| 19                                                | CV-2328   | 4/26/2024                |
| 20                                                | CV-24142  | 5/3/2024                 |
| 21                                                | CV-2411   | 5/15/2024                |
| 22                                                | CV-2428   | 5/23/2024                |
| 23                                                | CV-24126  | 5/23/2024                |
| 24                                                | CV-24127  | 5/23/2024                |
| 25                                                | CV-2406   | 5/30/2024                |
| 26                                                | CV-2496   | 5/30/2024                |
| 27                                                | CV-2497   | 5/30/2024                |
| 28                                                | CV-2414   | 5/31/2024                |
| 29                                                | CV-2408   | 5/31/2024                |
| 30                                                | CV-24111  | 6/7/2024                 |
| 31                                                | CV-2416   | 6/24/2024                |
| 32                                                | CV-2419   | 6/26/2024                |
| 33                                                | CV-24102  | 7/3/2024                 |
| 34                                                | CV-24109  | 7/7/2024                 |
| 35                                                | CV-24162  | 7/8/2024                 |
| 36                                                | CV-2499   | 7/17/2024                |
| 37                                                | CV-24100  | 7/17/2024                |
| 38                                                | CV-2303   | 7/18/2024                |
| 39                                                | CV-2311   | 7/18/2024                |
| 40                                                | CV-2315   | 7/18/2024                |
| 41                                                | CV-2498   | 7/18/2024                |
| 42                                                | CV-24101  | 7/18/2024                |
| 43                                                | CV-2001   | 7/19/2024                |
| 44                                                | CV-2345   | 7/19/2024                |
| 45                                                | CV-2344   | 7/22/2024                |
| 46                                                | CV-2348   | 7/22/2024                |
| 47                                                | CV-2343   | 7/23/2024                |
| 48                                                | CV-2347   | 7/24/2024                |
| 49                                                | CV-2346   | 7/25/2024                |
| 50                                                | CV-1532A  | 8/2/2024                 |
| 51                                                | CV-2301   | 8/9/2024                 |
| 52                                                | CV-2407   | 8/13/2024                |
| 53                                                | CV-2417   | 8/13/2024                |
| 54                                                | CV-2422   | 8/14/2024                |
| 55                                                | CV-2418   | 8/14/2024                |
| 56                                                | CV-2441   | 8/15/2024                |
| 57                                                | CV-2477   | 8/15/2024                |
| 58                                                | CV-2341   | 8/15/2024                |
| 59                                                | CV-2427   | 8/19/2024                |
| 60                                                | CV-2466   | 8/19/2024                |
| 61                                                | CV-2412   | 8/20/2024                |
| 62                                                | CV-24121  | 8/23/2024                |
| 63                                                | CV-24124  | 8/24/2024                |
| 64                                                | CV-2430   | 8/26/2024                |
| 65                                                | CV-24120  | 8/26/2024                |
| 66                                                | CV-2423   | 8/26/2024                |
| 67                                                | CV-2415   | 8/30/2024                |
| 68                                                | CV-24125  | 8/30/2024                |
| 69                                                | CV-24129  | 8/30/2024                |
| 70                                                | CV-24130  | 8/30/2024                |
| 71                                                | CV-24131  | 8/30/2024                |
| 72                                                | CV-2339   | 9/4/2024                 |
| 73                                                | CV-2409   | 9/4/2024                 |
| 74                                                | CV-2453   | 9/4/2024                 |
| 75                                                | CV-2456   | 9/4/2024                 |
| 76                                                | CV-2478   | 9/4/2024                 |
| 77                                                | CV-24108  | 9/4/2024                 |
| 78                                                | CV-2349   | 9/4/2024                 |
| 79                                                | CV-2481   | 9/6/2024                 |
| 80                                                | CV-2462   | 9/6/2024                 |
| 81                                                | CV-2333   | 9/9/2024                 |
| 82                                                | CV-2482   | 9/10/2024                |
| 83                                                | CV-2350   | 9/10/2024                |
| 84                                                | CV-2495   | 9/10/2024                |
| 85                                                | CV-2469   | 9/13/2024                |
| 86                                                | CV-24122  | 9/13/2024                |
| 87                                                | CV-2460   | 9/16/2024                |
| 88                                                | CV-2464   | 9/16/2024                |
| 89                                                | CV-2483   | 9/16/2024                |
| 90                                                | CV-24210  | 9/19/2024                |
| 91                                                | CV-2463   | 9/26/2024                |
| 92                                                | CV-2459   | 9/27/2024                |
| 93                                                | CV-2472   | 9/27/2024                |
| 94                                                | CV-2474   | 9/27/2024                |
| 95                                                | CV-2434   | 9/28/2024                |
| 96                                                | CV-2437   | 10/1/2024                |
| 97                                                | CV-2443   | 10/1/2024                |
| 98                                                | CV-2450   | 10/1/2024                |
| 99                                                | CV-2457   | 10/1/2024                |
| 100                                               | CV-2488   | 10/15/2024               |
| 101                                               | CV-2327   | 12/3/2024                |
| 102                                               | CV-2473   | 12/10/2024               |
| 103                                               | CV-2446   | 12/13/2024               |
| 104                                               | CV-2413   | 12/16/2024               |
| 105                                               | CV-2438   | 12/17/2024               |
| 106                                               | CV-2433   | 12/20/2024               |
| 107                                               | CV-2442   | 12/21/2024               |
| 108                                               | CV-2452   | 12/22/2024               |
| 109                                               | CV-2451   | 12/23/2024               |
| 110                                               | CV-2471   | 12/24/2024               |
| 111                                               | CV-2445   | 1/6/2025                 |
| 112                                               | CV-2432   | 1/7/2025                 |
| 113                                               | CV-24116  | 1/10/2025                |
| 114                                               | CV-24118  | 1/10/2025                |
| 115                                               | CV-24119  | 1/10/2025                |
| 116                                               | CV-24203  | 1/10/2025                |
| 117                                               | CV-24204  | 1/10/2025                |
| 118                                               | CV-24205  | 1/10/2025                |
| 119                                               | CV-24208  | 1/10/2025                |
| 120                                               | CV-24211  | 1/10/2025                |
| 121                                               | CV-24212  | 1/10/2025                |
| 122                                               | CV-24226  | 1/10/2025                |
| 123                                               | CV-24163  | 1/14/2025                |
| 124                                               | CV-2011A  | 1/15/2025                |
| 125                                               | CV-24225  | 1/15/2025                |
| 126                                               | CV-24117  | 1/17/2025                |
| 127                                               | CV-24079  | 1/28/2025                |
| 128                                               | CV-24224  | 1/28/2025                |

**LEGEND**

1150 TOPOGRAPHIC CONTOUR

--- EXISTING CELL LIMITS (APPROXIMATE)

--- REACTION AREA BOUNDARY - CONDITION 9A

--- REACTION AREA BOUNDARY - DATA ANALYSIS

CV-XX EXISTING VERTICAL LFG EXTRACTION WELL

CV-XX PLR EXISTING LFG VERTICAL EXTRACTION WELL - PRESSURIZED LEACHATE RELEASE

EXISTING CONDENSATE SUMP WITH PUMP

EXISTING DE-WATERING WELL WITH PUMP - CURRENTLY RUNNING

EXISTING DE-WATERING WELL WITH PUMP - INSTALLED

| De-Watering Well Pumps That Are Currently Installed and Not in Operation |           |
|--------------------------------------------------------------------------|-----------|
| #                                                                        | Well I.D. |
| 1                                                                        | CV-114    |
| 2                                                                        | CV-2206   |
| 3                                                                        | CV-2306   |
| 4                                                                        | CV-2338   |
| 5                                                                        | CV-2449   |
| 6                                                                        | CV-2455   |
| 7                                                                        | CV-2475   |
| 8                                                                        | CV-24143  |

- GENERAL DRAWING NOTES:
- EXISTING TOPOGRAPHIC SURVEY INFORMATION SHOWN WAS PROVIDED BY PROPELLOR. AERIAL PHOTOGRAPHY DATED JANUARY 22, 2025.
  - NORTH ARROW SHOWN HERE IS REFERRED TO THE CALIFORNIA STATE PLANE ZONE V COORDINATE SYSTEM, NAD 83.
  - THE LOCATION OF ANY EXISTING GCCS COMPONENTS AND OTHER FEATURES ARE APPROXIMATE AND SHOULD BE USED FOR INFORMATION PURPOSES ONLY. ACTUAL FIELD CONDITIONS MAY VARY AND SUBJECT TO CHANGE BASED ON FUTURE FILL OPERATIONS, WASTE PLACEMENT, TOPOGRAPHIC FEATURES, AND OTHER SITE-SPECIFIC FACTORS.
  - EXISTING GCCS AS-BUILT DATED DECEMBER 05, 2024.

| Zone Description                 | De-Watering Pumps |             |                 |                      |
|----------------------------------|-------------------|-------------|-----------------|----------------------|
|                                  | Total             | Operational | Non-Operational | Pending Installation |
| Within Condition 9A Boundary     | 110               | 102         | 8               | 57                   |
| Outside of Condition 9A Boundary | 26                | 26          | 0               | 23                   |
| Combined (Both Areas)            | 136               | 128         | 8               | 80                   |
| Condensate Sump                  | 42                | 42          | 0               | 0                    |

\*De-Watering pump data as of January 31, 2025.

DATE

REVISION

NO

SHEET TITLE:  
EXISTING DE-WATERING WELL WITH PUMP MAP

PROJECT TITLE:  
CHICUITA CANYON LANDFILL  
CASTAIC, CALIFORNIA

CLIENT:  
SCS ENGINEERS  
ENVIRONMENTAL CONSULTANTS  
PROJ. NO. 01204123.35  
DRAWN BY: SRM  
CHECKED BY: WCH

DATE: 01/31/2025  
SCALE: AS SHOWN  
SHEET: 1