

Archivado: Viernes 14 de marzo de 2025 10:45:15 AM

De: [Jones, Art](#)

Enviado: Miércoles 12 de marzo de 2025 2:11:28 PM

Para: [Baitong Chen](#) [Kim, James Kim](#), [Jenny](#)

Cc: [Steve Cassulo](#) [Fong, Cornelius Sullivan](#), [Pat Stephens](#), [Gabrielle Viswanathan](#), [Srividhya Han](#), [Jessie Kelly Kincella](#) [Nathaniel Dickel](#) [Nicole Ward](#) [Mike Calleja](#) [Dylan Smith](#) [Amanda Froman](#) [Haley, William \(Bill\)](#) [Kate Logan](#) [Ambriz, Antonio Johnson](#), [Cage](#)

Asunto: Ref.: Solicitud de Información Adicional para ANs 647475, 647476 y 647477, Código de Centro 119319

Importancia: Normal

Sensibilidad: Ninguna

Adjunto:

[CCL MASTER EXISTING GCCS MAP ONLY_2025-03-05.pdf](#);

[REMITENTE EXTERNO: Tenga precaución con los enlaces/adjuntos]

Buenas tardes Chris

Aquí tenemos el conforme a obra actual. No hay cambios importantes, por lo tanto, el mapa 3-5 es el más actualizado

Atentamente,


Art

Arthur E Jones Jr
Gerente de la Región Sudoeste del Desierto/Vicepresidente de
SCS Engineers
Field Services Group
6 Sunset Way Suite 101
Henderson, NV 89014
Teléfono de la Oficina 209-702-6228
Móvil 209-345-2062

Email: ajones@scsengineers.com
Sitio web: www.scsengineers.com
Dirigidos por el Éxito de los Clientes



Este e-mail puede contener información confidencial y está previsto para uso del destinatario y/o sus representantes previstos únicamente. Si no es el destinatario previsto, por favor, no transmita, copie, divulgue, guarde ni utilice esta comunicación de ninguna manera. Si recibió este mensaje por error, por favor, informe al remitente inmediatamente y elimine este mensaje de forma permanente de su computadora. SCS Engineers no asume ninguna responsabilidad por el contenido de este e-mail no por las consecuencias de ninguna acción tomada en base a la información proporcionada.
– SCS Engineers

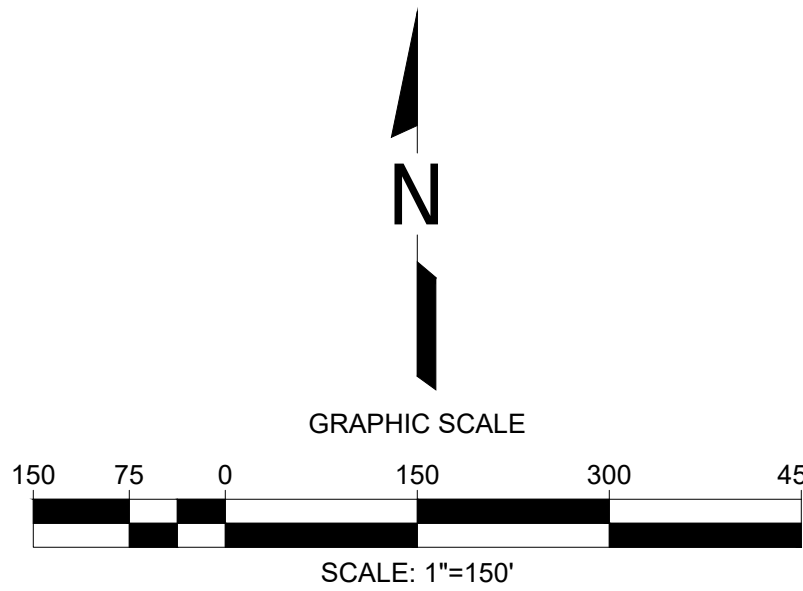

TOPOGRAPHIC CONTOUR	
	EXISTING CELL LIMITS (APPROXIMATE)
	EXISTING LFG VERTICAL EXTRACTION WELL
	EXISTING LFG VERTICAL EXTRACTION WELL - PRESSURIZED LEACHATE RELEASE
	EXISTING GABION LFG COLLECTOR WELL
	EXISTING SOIL VAPOR EXTRACTION WELL
	EXISTING LFG VERTICAL EXTRACTION WELL BELOW-GRADE
	EXISTING SURFACE COLLECTOR WELLHEAD
	EXISTING HORIZONTAL WELLS
	EXISTING REMOTE VERTICAL WELLHEAD
	EXISTING PERIMETER MIGRATION PROBE
	EXISTING TEMPERATURE PROBE
	EXISTING ISOLATION VALVE
	EXISTING ACTIVATED CARBON VESSEL
	EXISTING CONDENSATE SUMP
	EXISTING 36" LFG COLLECTION HEADER PIPING
	EXISTING 30" LFG COLLECTION HEADER PIPING
	EXISTING 24" LFG COLLECTION HEADER PIPING
	EXISTING 20" LFG COLLECTION HEADER PIPING
	EXISTING 18" LFG COLLECTION HEADER PIPING
	EXISTING 12" LFG COLLECTION HEADER PIPING
	EXISTING 10" LFG COLLECTION HEADER PIPING
	EXISTING 8" LFG COLLECTION LATERAL PIPING
	EXISTING 4/6" LFG COLLECTION LATERAL PIPING
	EXISTING 2/3" LFG COLLECTION LATERAL PIPING
	BELOW-GRADE PIPES ARE SHOWN DASHED
	REACTION AREA BOUNDARY (APPROXIMATE) - BASED ON DATA REVIEW
	EXISTING CAP

- SCS ENGINEERS**
ENVIRONMENTAL CONSULTANTS
1000 KILBY AVENUE, SUITE 100