

Archivado: Viernes 21 de marzo de 2025 8:53:36 AM

De: [Medina, Steven](#)

Enviado: Viernes 14 de marzo de 2025 1:20:18 PM

Para: bchen@aqmd.gov ndickel@aqmd.gov [Christina Ojeda](#)

Cc: [Han, Jessie](#) [Steve Cassulo](#) [Haley, William \(Bill\)](#) [Amanda Froman](#) [Michael Hearn](#) [Nicole Ward](#) Christopher.Fear@WasteConnections.com [Viswanathan, Srividhya](#) [Kelly Kincella](#) [Kate Logan](#)

Asunto: Ref.: Orden de Depuración Estipulada del Caso No. 6177-4 - Actualización sobre la Instalación y Operación Semanal de las Bombas

Importancia: Normal

Sensibilidad: Ninguna

Adjunto:

[Outlook-cmqkcb5k.png](#); [Outlook-o0ybx5fq.png](#); [Outlook-jtlptmqi.png](#); [Outlook-jtawij2i.png](#); [2025 CCLF Existing De-Watering Well with Pump Map_2025-03-14.pdf](#);

[REMITENTE EXTERNO: Tenga precaución con los enlaces/adjuntos]

Hola a todos,

Según la Condición 65 de la Orden Estipulada Modificada, a continuación se encuentra el resumen de la instalación y operación de las bombas de desagüe para el Vertedero de Chiquita Canyon.

Durante período que corrió del 07/03/2025 hasta el 13/03/2025, Chiquita completó la instalación y comenzó a operar durante el día tres

(3) bombas en un pozo vertical de extracción de LFG dando un total de ciento treinta y seis (136) bombas que operan en pozos verticales de extracción de LFG. Por favor, consulte el mapa actualizado adjunto de los pozos de LFG con bombas operando.

Durante el período que va del 14/03/2025 hasta el 20/03/ 2025, dada la cantidad de bombas de desagüe instaladas hasta la fecha y el mantenimiento asociado a esas bombas, Chiquita tiene planeado instalar y comenzar a operar otras dos (2) bombas en pozos verticales de extracción de LFG en ubicaciones a lo largo de la pendiente norte y sur de la zona reactiva. Las ubicaciones de las instalaciones de las bombas para la semana que viene están sujetas a cambios debido a las condiciones climáticas y/o de seguridad.

Atentamente,

STEVEN Rubén Medina, **E.I.T.**

Profesional Asociado

SCS Engineers

3900 Kilroy Airport Way, Suite 300


Long Beach, CA 90806

858-204-4342 (c)

5160srm@scsengineers.com

Dirigidos por el Éxito de los Clientes

www.scsengineers.com

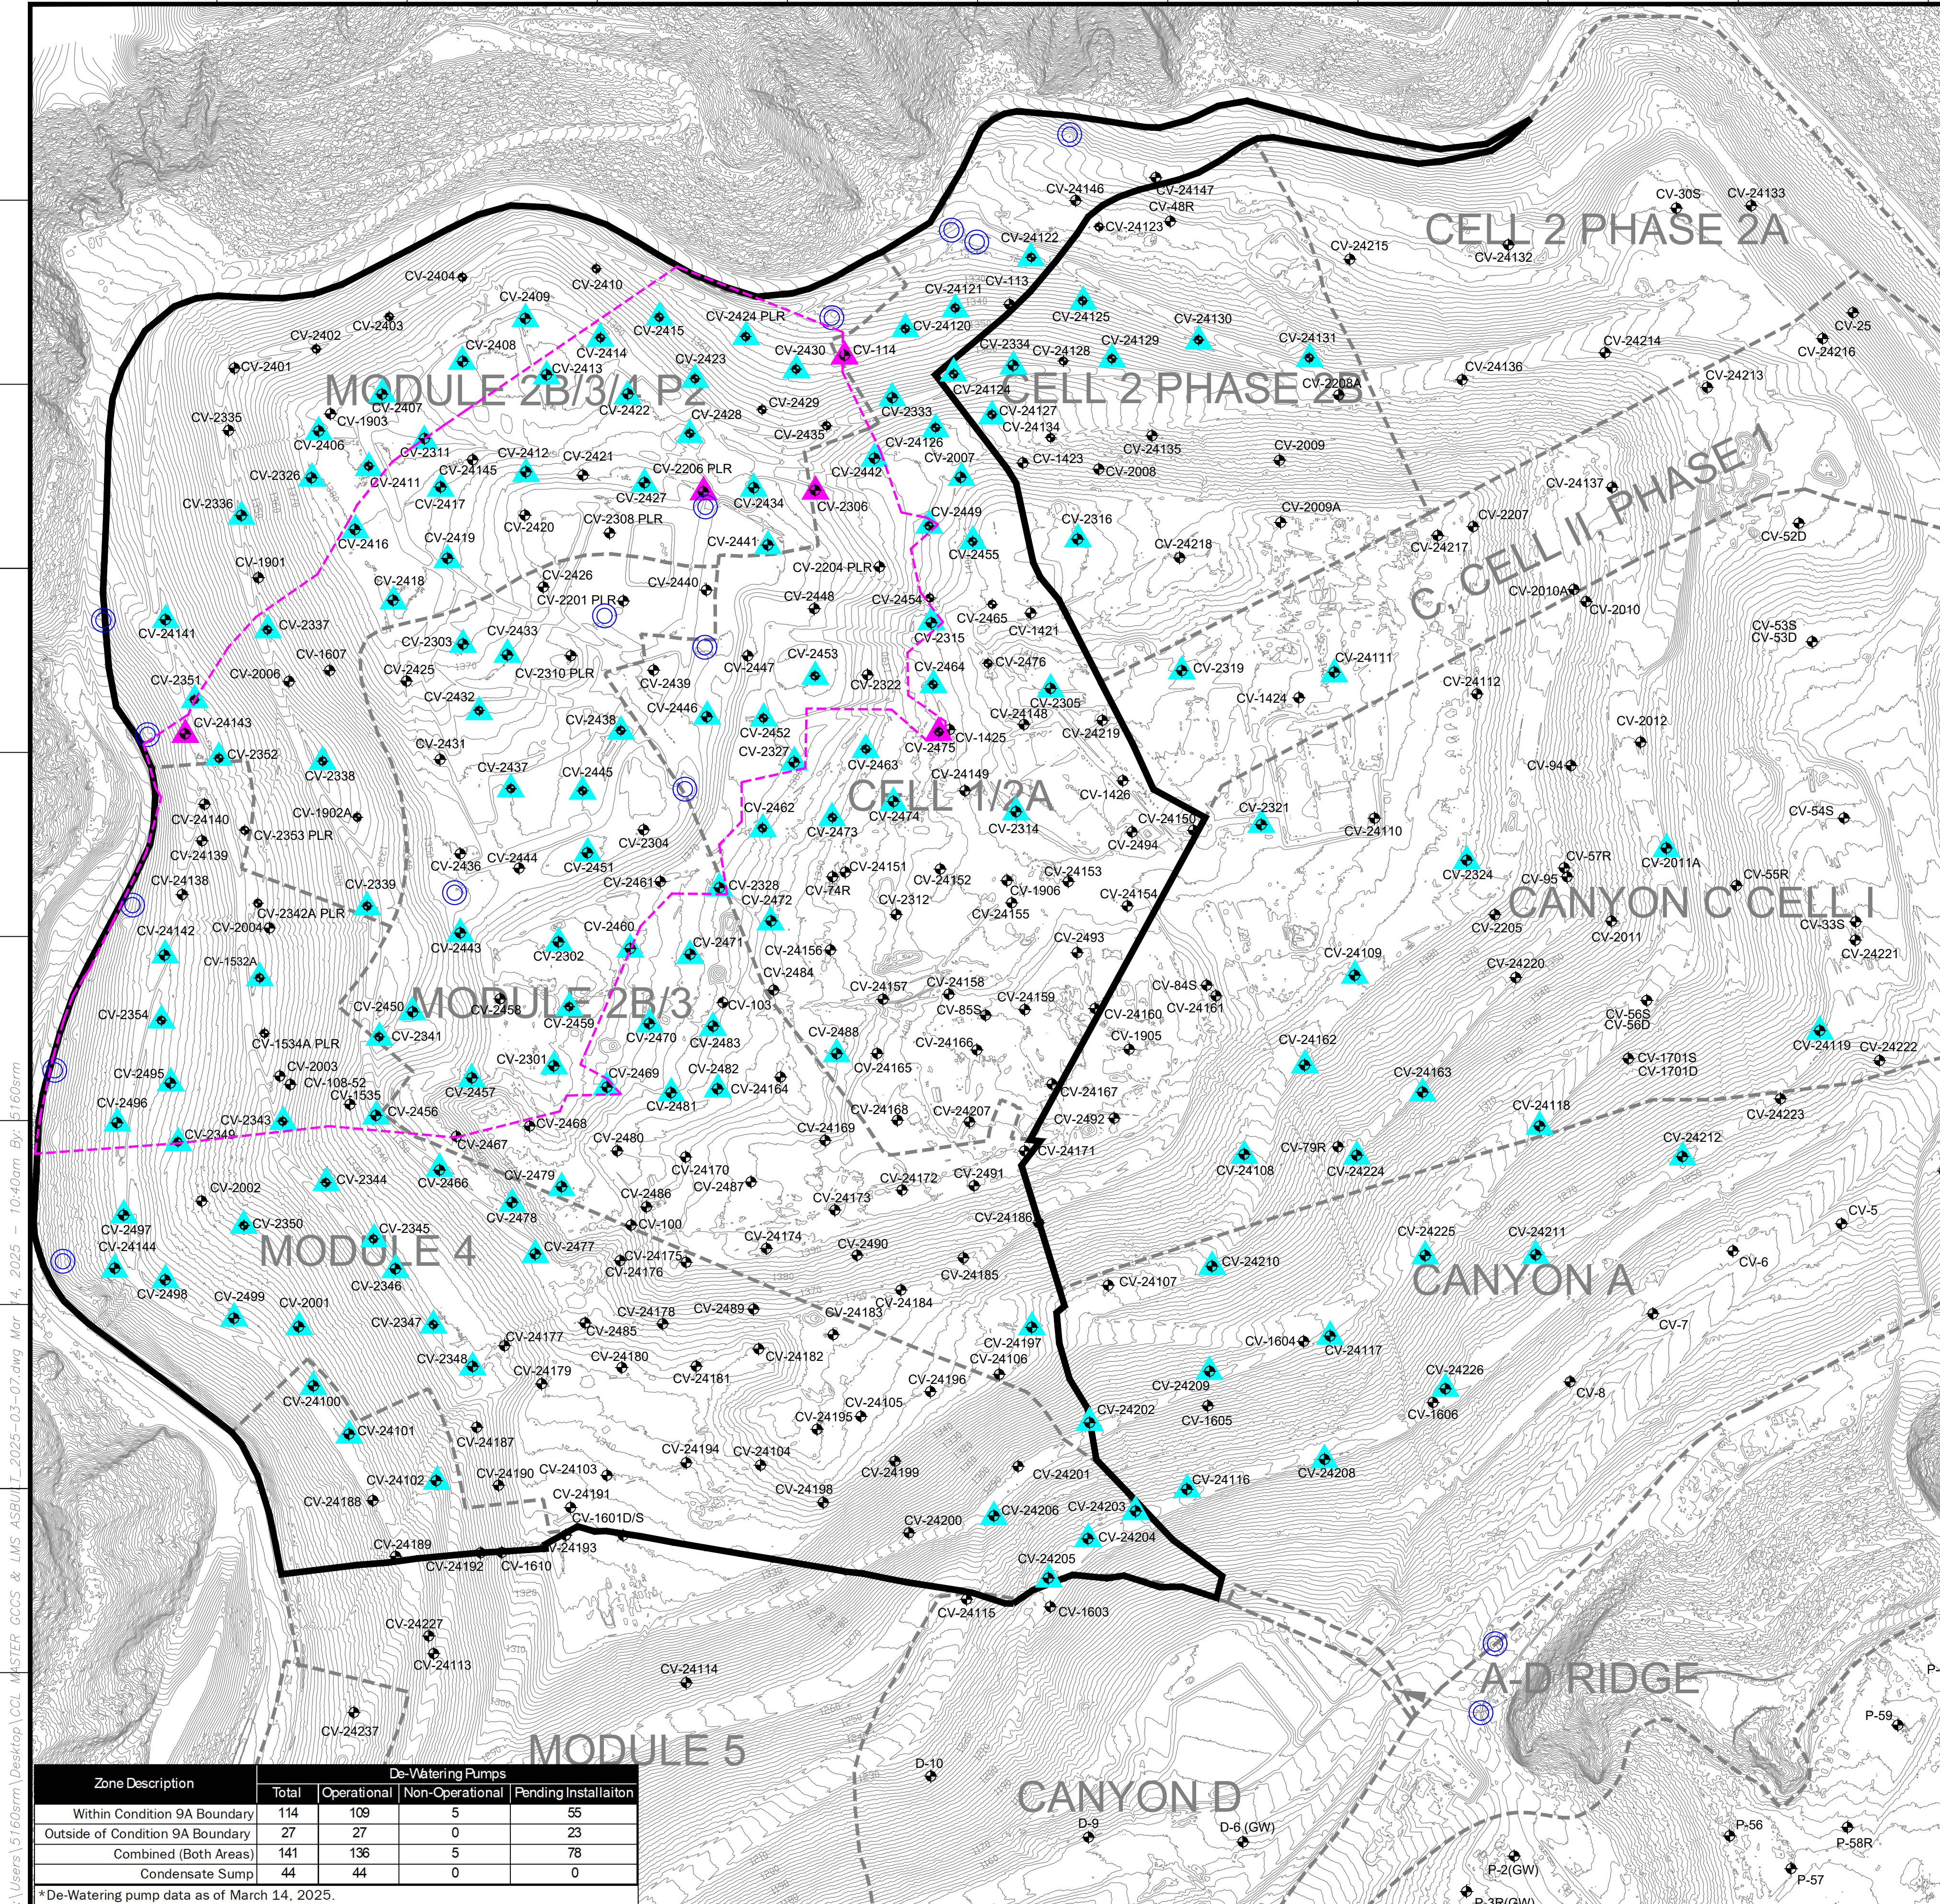

De-Watering Well Pumps that are Currently Running		
#	Well ID	Operational Startup Date
1	CV-2334	3/21/2024
2	CV-2424	3/21/2024
3	CV-2305	3/27/2024
4	CV-2321	3/27/2024
5	CV-2319	3/28/2024
6	CV-2324	3/28/2024
7	CV-2354	4/1/2024
8	CV-24144	4/8/2024
9	CV-2302	4/10/2024
10	CV-2314	4/10/2024
11	CV-2352	4/12/2024
12	CV-2316	4/19/2024
13	CV-2007	4/19/2024
14	CV-2337	4/22/2024
15	CV-2336	4/23/2024
16	CV-2351	4/23/2024
17	CV-24141	4/23/2024
18	CV-2326	4/24/2024
19	CV-2328	4/26/2024
20	CV-24142	5/3/2024
21	CV-2411	5/15/2024
22	CV-2428	5/23/2024
23	CV-24126	5/23/2024
24	CV-24127	5/23/2024
25	CV-2406	5/30/2024
26	CV-2408	5/30/2024
27	CV-2407	5/30/2024
28	CV-2414	5/31/2024
29	CV-2408	5/31/2024
30	CV-24111	6/7/2024
31	CV-2416	6/24/2024
32	CV-2419	6/26/2024
33	CV-24103	7/3/2024
34	CV-24109	7/7/2024
35	CV-24162	7/8/2024
36	CV-2499	7/17/2024
37	CV-24100	7/17/2024
38	CV-2303	7/18/2024
39	CV-2311	7/18/2024
40	CV-2315	7/19/2024
41	CV-2498	7/19/2024
42	CV-24101	7/19/2024
43	CV-2001	7/19/2024
44	CV-2345	7/19/2024
45	CV-2344	7/22/2024
46	CV-2348	7/22/2024
47	CV-2342	7/23/2024
48	CV-2347	7/24/2024
49	CV-2346	7/25/2024
50	CV-1532A	8/2/2024
51	CV-2301	8/9/2024
52	CV-2407	8/13/2024
53	CV-2417	8/13/2024
54	CV-2422	8/14/2024
55	CV-2418	8/14/2024
56	CV-2441	8/15/2024
57	CV-2477	8/15/2024
58	CV-2341	8/15/2024
59	CV-2427	8/19/2024
60	CV-2466	8/19/2024
61	CV-2412	8/20/2024
62	CV-24121	8/23/2024
63	CV-24124	8/24/2024
64	CV-2430	8/26/2024
65	CV-24120	8/26/2024
66	CV-2423	8/26/2024
67	CV-2415	8/30/2024
68	CV-24125	8/30/2024
69	CV-24129	8/30/2024
70	CV-24130	8/30/2024
71	CV-24131	8/30/2024
72	CV-2339	9/4/2024
73	CV-2409	9/4/2024
74	CV-2453	9/4/2024
75	CV-2456	9/4/2024
76	CV-2478	9/4/2024
77	CV-24108	9/4/2024
78	CV-2349	9/4/2024
79	CV-2481	9/6/2024
80	CV-2462	9/6/2024
81	CV-2333	9/9/2024
82	CV-2482	9/10/2024
83	CV-2350	9/10/2024
84	CV-2495	9/10/2024
85	CV-2469	9/13/2024
86	CV-24122	9/13/2024
87	CV-2460	9/16/2024
88	CV-2464	9/16/2024
89	CV-2483	9/16/2024
90	CV-24210	9/19/2024
91	CV-2463	9/26/2024
92	CV-2459	9/27/2024
93	CV-2472	9/27/2024
94	CV-2474	9/27/2024
95	CV-2434	9/28/2024
96	CV-2437	10/1/2024
97	CV-2443	10/1/2024
98	CV-2450	10/1/2024
99	CV-2457	10/1/2024
100	CV-2488	10/15/2024
101	CV-2327	12/3/2024
102	CV-2473	12/10/2024
103	CV-2446	12/13/2024
104	CV-2413	12/16/2024
105	CV-2438	12/17/2024
106	CV-2433	12/20/2024
107	CV-2442	12/21/2024
108	CV-2452	12/22/2024
109	CV-2451	12/23/2024
110	CV-2471	12/24/2024
111	CV-2445	1/6/2025
112	CV-2432	1/7/2025
113	CV-24116	1/10/2025
114	CV-24118	1/10/2025
115	CV-24119	1/10/2025
116	CV-24203	1/10/2025
117	CV-24204	1/10/2025
118	CV-24205	1/10/2025
119	CV-24208	1/10/2025
120	CV-24211	1/10/2025
121	CV-24212	1/10/2025
122	CV-24226	1/10/2025
123	CV-24183	1/14/2025
124	CV-2011A	1/15/2025
125	CV-24225	1/15/2025
126	CV-24117	1/17/2025
127	CV-24079	1/28/2025
128	CV-24224	1/28/2025
129	CV-24070	2/4/2025
130	CV-2338	2/8/2025
131	CV-24206	2/20/2025
132	CV-24202	2/28/2025
133	CV-24209	2/28/2025
134	CV-24197	3/11/2025
135	CV-24049	3/11/2025
136	CV-24055	3/11/2025

GRAPHIC SCALE

150 75 0 150 300 450

SCALE: 1"=150'

LEGEND

1150

TOPOGRAPHIC CONTOUR

EXISTING CELL LIMITS (APPROXIMATE)

REACTION AREA BOUNDARY - CONDITION 9A

REACTION AREA BOUNDARY - DATA ANALYSIS

CV-XX

EXISTING VERTICAL LFG EXTRACTION WELL

CV-XX PLR

EXISTING LFG VERTICAL EXTRACTION WELL - PRESSURIZED LEACHATE RELEASE

CV-XX

EXISTING CONDENSATE SUMP WITH PUMP

CV-XX

EXISTING DE-WATERING WELL WITH PUMP - CURRENTLY RUNNING

CV-XX

EXISTING DE-WATERING WELL WITH PUMP - INSTALLED

De-Watering Well Pumps That Are Currently Installed and Not in Operation

#	Well ID
1	CV-114
2	CV-2206
3	CV-2306
4	CV-2475
5	CV-24143

GENERAL DRAWING NOTES:

1. EXISTING TOPOGRAPHIC SURVEY INFORMATION SHOWN WAS PROVIDED BY PROPELLOR. AERIAL PHOTOGRAPHY DATED MARCH 11, 2025.

2. NORTH ARROW SHOWN HERE IS REFERENCE TO THE CALIFORNIA STATE PLANE ZONE V COORDINATE SYSTEM, NAD 83.

3. THE LOCATION OF ANY EXISTING GCCS COMPONENTS AND OTHER FEATURES ARE APPROXIMATE AND SHOULD BE USED FOR INFORMATION PURPOSES ONLY. ACTUAL FIELD CONDITIONS MAY VARY AND SUBJECT TO CHANGE BASED ON FUTURE FILL OPERATIONS, WASTE PLACEMENT, TOPOGRAPHIC FEATURES, AND OTHER SITE-SPECIFIC FACTORS.

4. EXISTING GCCS AS-BUILT DATED DECEMBER 05, 2024.

CLIENT:

EXISTING DE-WATERING WELL WITH PUMP MAP

PROJECT TITLE:

CHIQUITA CANYON LANDFILL
CASTAIC, CALIFORNIA

SCS ENGINEERS

ENVIRONMENTAL CONSULTANTS

2500 ALBANY AVE SUITE 250
SAN DIEGO, CA 92125
(619) 571-5500 FAX (619) 427-0805

PROJ. NO. 01204123.41
DWN. BY: SRM
CHK. BY: WCH

APP. BY: WCH

DATE:

03/14/2025

SCALE:

AS SHOWN

SHEET:

1

C:\Users\5160sm\Desktop\LCCL MASTER GCCS & LMS ASBUILT_2025-03-07.dwg Mar 14, 2025 - 10:40am By: 5160sm