



**CHIQUITA CANYON**  
*A Waste Connections Company*

April 8, 2024

*Via E-Mail*

Karen Gork  
Chief Environmental Health Specialist  
Los Angeles County Department of Public Health  
Local Enforcement Agency  
Environmental Programs Division  
5050 Commerce Drive,  
Baldwin Park, California 91706  
[KGork@ph.lacounty.gov](mailto:KGork@ph.lacounty.gov)


**Re: Chiquita Canyon, LLC's Weekly Report on the Documentation and  
Tracking of Cover Issues and Monthly Summary**

Dear Ms. Gork:

In accordance with the Local Enforcement Agency's ("LEA") May 2, 2024 letter approving Chiquita's April 16, 2024 Second Revised Written Plan for Documenting and Tracking Cover Issues ("Second Revised Written Plan"), the LEA's May 29, 2024 letter, and the LEA's June 6, 2024 Compliance Order, Chiquita presents the enclosed report for documenting and tracking cover issues for the week of March 31, 2025 to April 5, 2025. Included in this report is the monthly summary of fissures and tension cracks prepared for March 2025, pursuant to the Second Revised Written Plan.

Please contact me if you have any questions regarding this matter.

Regards,

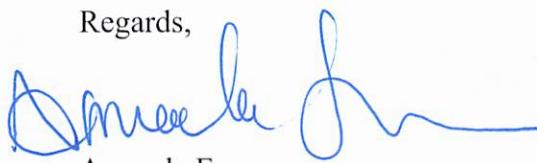

Amanda Froman  
Compliance Manager  
Chiquita Canyon, LLC

Attachment: March 31, 2025 Weekly Cover Issues Report and Monthly Summary  
cc: Mark Como, Department of Public Health  
Eric Morofuji, Department of Public Health

# **Fissures and Tension Cracks**

# 4050 - Chiquita Reaction Area Tracking of Fissures and Tension Cracks

31 Mar 2025 / Tom Roe

Complete

Conducted on

31 Mar 2025 8:56 AM PDT

Prepared by

Tom Roe

## Chiquita Reaction Area Tracking of Fissures and Tension Cracks


Chiquita Reaction Area Tracking of Fissures and Tension Cracks

Chiquita Reaction Area Tracking of Fissures and Tension Cracks  
1

**Fissure or Tension Crack Found?**

Yes

**Using the attached image, annotate all areas where inspectors identified a fissure or tension crack.**

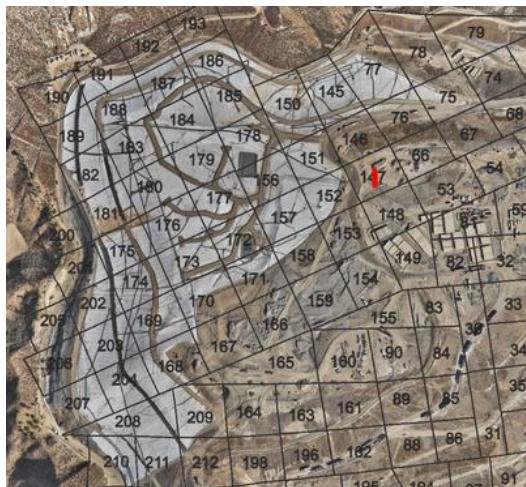

**Grid Location**

147

**Using the Media link below, attach the before photo of the fissure or tension crack.**

31 Mar 2025 9:12 AM PDT



Photo 1



Photo 2



Photo 3



Photo 4

**Length of crack (ft) or area containing multiple cracks (ft x ft)**

6ft x 35ft

**Horizontal Offset (width)**

Small 0.5-2" in width

**Vertical Offset (height)**

Extra small <0.5" in height

**Orientation (direction)**

NW to SE

**Location**

Castaic CA 91384  
United States  
(34.43567104660217,  
-118.64693914731299)

**Was Fissure or Crack fixed? If yes, add photo and description of repairs performed**

Yes



Photo 5

**Date and time of repairs**

31 Mar 2025 10:29 AM PDT

**Description of repairs**

Cracks were track walked.

Instability

**Are there any indications of slope stability concerns?**

No

# 4050 - Chiquita Reaction Area Tracking of Fissures and Tension Cracks

1 Apr 2025 / Tom Roe

Complete

Conducted on

1 Apr 2025 9:33 AM PDT

Prepared by

Tom Roe

## Chiquita Reaction Area Tracking of Fissures and Tension Cracks

Chiquita Reaction Area Tracking of Fissures and Tension Cracks

Chiquita Reaction Area Tracking of Fissures and Tension Cracks  
1

**Fissure or Tension Crack Found?**

No

Grid 147



Photo 1

Instability

**Are there any indications of slope stability concerns?**

No

# 4050 - Chiquita Reaction Area Tracking of Fissures and Tension Cracks

2 Apr 2025 / Tom Roe

Complete

Conducted on

2 Apr 2025 8:48 AM PDT

Prepared by

Tom Roe

## Chiquita Reaction Area Tracking of Fissures and Tension Cracks

Chiquita Reaction Area Tracking of Fissures and Tension Cracks

Chiquita Reaction Area Tracking of Fissures and Tension Cracks  
1

**Fissure or Tension Crack Found?**

No

Grid 146



Photo 1

Instability

**Are there any indications of slope stability concerns?**

No

# 4050 - Chiquita Reaction Area Tracking of Fissures and Tension Cracks

3 Apr 2025 / John Boucher

Complete

Conducted on

3 Apr 2025 9:50 AM PDT

Prepared by

John Boucher

## Chiquita Reaction Area Tracking of Fissures and Tension Cracks

Chiquita Reaction Area Tracking of Fissures and Tension Cracks

Chiquita Reaction Area Tracking of Fissures and Tension Cracks  
1

**Fissure or Tension Crack Found?**

No

Grid 166



Photo 1

Instability

**Are there any indications of slope stability concerns?**

No

# 4050 - Chiquita Reaction Area Tracking of Fissures and Tension Cracks

4 Apr 2025 / John Boucher

Complete

Conducted on

4 Apr 2025 10:01 AM PDT

Prepared by

John Boucher

## Chiquita Reaction Area Tracking of Fissures and Tension Cracks

Chiquita Reaction Area Tracking of Fissures and Tension Cracks

Chiquita Reaction Area Tracking of Fissures and Tension Cracks  
1

**Fissure or Tension Crack Found?**

No

Grid 164



Photo 1

Instability

**Are there any indications of slope stability concerns?**

No

# 4050 - Chiquita Reaction Area Tracking of Fissures and Tension Cracks

5 Apr 2025 / John Boucher

Complete

Conducted on

5 Apr 2025 1:31 PM PDT

Prepared by

John Boucher

## Chiquita Reaction Area Tracking of Fissures and Tension Cracks

Chiquita Reaction Area Tracking of Fissures and Tension Cracks

Chiquita Reaction Area Tracking of Fissures and Tension Cracks  
1

**Fissure or Tension Crack Found?**

No

Grid 147



Photo 1

Instability

**Are there any indications of slope stability concerns?**

No

# **Settlement**

**The bi-weekly drone flyover was not conducted this week. The drone data from the next flyover event will be included in the next weekly report.**

# **Geosynthetic Cover**

# 4050 - Geosynthetic Cover Inspection

31 Mar 2025 / Tom Roe

Complete

Flagged items

0

Conducted on

31 Mar 2025 12:32 PM PDT

Prepared by

Tom Roe

## Identification of Issues

Identified Issue

Identified Issue 1

**Are there any issues with the geosynthetic cover?**

No



Photo 1



Photo 2



Photo 3



Photo 4



Photo 5



Photo 6

Instability under the cover

**Are there any anomalous (unusual or unexpected) areas of cover damage or deformation that may indicate underlying instability?**

No

**Are there any signs of a downslope tension crack at the top of the slope or bulging at or near the toe of the slope?**

No

**Is there any movement of the equipment that vertically penetrates the cover (e.g., tilting)?**

No

# 4050 - Geosynthetic Cover Inspection

1 Apr 2025 / Tom Roe

Complete

Flagged items

0

Conducted on

1 Apr 2025 12:35 PM PDT

Prepared by

Tom Roe

## Identification of Issues

Identified Issue

Identified Issue 1

**Are there any issues with the geosynthetic cover?**

No



Photo 1



Photo 2



Photo 3



Photo 4

Instability under the cover

**Are there any anomalous (unusual or unexpected) areas of cover damage or deformation that may indicate underlying instability?**

No

**Are there any signs of a downslope tension crack at the top of the slope or bulging at or near the toe of the slope?**

No

**Is there any movement of the equipment that vertically penetrates the cover (e.g., tilting)?**

No

# 4050 - Geosynthetic Cover Inspection

2 Apr 2025 / Tom Roe

Complete

Flagged items

0

Conducted on

2 Apr 2025 1:32 PM PDT

Prepared by

Tom Roe

## Identification of Issues

Identified Issue

Identified Issue 1

**Are there any issues with the geosynthetic cover?**

No



Photo 1



Photo 2



Photo 3



Photo 4

Instability under the cover

**Are there any anomalous (unusual or unexpected) areas of cover damage or deformation that may indicate underlying instability?**

No

**Are there any signs of a downslope tension crack at the top of the slope or bulging at or near the toe of the slope?**

No

**Is there any movement of the equipment that vertically penetrates the cover (e.g., tilting)?**

No

# 4050 - Geosynthetic Cover Inspection

3 Apr 2025 / John Boucher

Complete

Flagged items

0

Conducted on

3 Apr 2025 2:19 PM PDT

Prepared by

John Boucher

## Identification of Issues

Identified Issue

Identified Issue 1

**Are there any issues with the geosynthetic cover?**

No



Photo 1



Photo 2



Photo 3



Photo 4



Photo 5

Instability under the cover

**Are there any anomalous (unusual or unexpected) areas of cover damage or deformation that may indicate underlying instability?**

No

**Are there any signs of a downslope tension crack at the top of the slope or bulging at or near the toe of the slope?**

No

**Is there any movement of the equipment that vertically penetrates the cover (e.g., tilting)?**

No

# 4050 - Geosynthetic Cover Inspection

4 Apr 2025 / John Boucher

Complete

Flagged items

0

Conducted on

4 Apr 2025 11:12 AM PDT

Prepared by

John Boucher

## Identification of Issues

Identified Issue

Identified Issue 1

**Are there any issues with the geosynthetic cover?**

No



Photo 1



Photo 2



Photo 3



Photo 4



Photo 5

Instability under the cover

**Are there any anomalous (unusual or unexpected) areas of cover damage or deformation that may indicate underlying instability?**

No

**Are there any signs of a downslope tension crack at the top of the slope or bulging at or near the toe of the slope?**

No

**Is there any movement of the equipment that vertically penetrates the cover (e.g., tilting)?**

No

# 4050 - Geosynthetic Cover Inspection

5 Apr 2025 / John Boucher

Complete

Flagged items

0

Conducted on

5 Apr 2025 1:10 PM PDT

Prepared by

John Boucher

## Identification of Issues

Identified Issue

Identified Issue 1

**Are there any issues with the geosynthetic cover?**

No



Photo 1



Photo 2



Photo 3

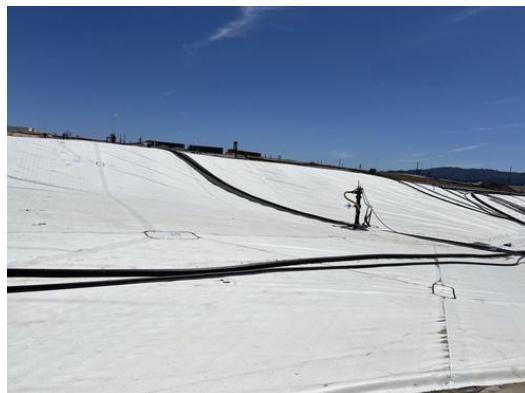


Photo 4



Photo 5



Photo 6

Instability under the cover

**Are there any anomalous (unusual or unexpected) areas of cover damage or deformation that may indicate underlying instability?**

No

**Are there any signs of a downslope tension crack at the top of the slope or bulging at or near the toe of the slope?**

No

**Is there any movement of the equipment that vertically penetrates the cover (e.g., tilting)?**

No



April 8, 2025

Mr. Steve Cassulo  
Chiquita Canyon Landfill  
29201 Henry Mayo Drive  
Castaic, California 91384

**MARCH 2025 FISSURE AND TENSION CRACK MONITORING SUMMARY  
CHIQUITA CANYON LANDFILL  
CASTAIC, CALIFORNIA**

---

Dear Mr. Cassulo:

This monthly summary report was prepared by Geo-Logic Associates, Inc. (GLA) to summarize the monitoring and tracking of fissures and tension cracks that was performed at the Chiquita Canyon Landfill (Landfill) between March 1 and March 31, 2025, in accordance with Milestone 2B of the Local Enforcement Agency's (LEA) June 6, 2024 Compliance Order, formerly referred to as Mitigation Measure #2B. This summary was prepared in accordance with Chiquita Canyon, LLC's (Chiquita) April 16, 2024 Second Revised Written Plan (Second Revised Written Plan) to document and track cover issues and is associated with Milestone 2B. The conclusions in this summary are based on GLA's review and evaluation of Chiquita's daily Reaction Area Tracking of Fissures and Tension Cracks data sheets that document and track cover issues, on information from Chiquita's drone aerial surveys, and on GLA observations during a site visit on Monday, March 31, 2025.

**March Observations**

Chiquita conducts daily monitoring of the soil cover for fissures and tension cracks and of the geomembrane-covered area for damage or evidence of possible instability. The cracks and fissures that were observed in March 2025 are summarized in Table 1. Table 2 summarizes the daily observations performed in geomembrane-covered areas in March. As indicated in these tables, no evidence of instability was observed in the soil-covered areas or the geomembrane-covered areas.

As indicated in Table 1, no cracks or fissures meeting the definition of "significant" in the Second Revised Written Plan were observed in March.<sup>1</sup> Additionally, no cracks or

---

<sup>1</sup> Pursuant to the Second Revised Written Plan, a "significant" fissure or tension crack is one that (1) is 100 feet or longer in length; (2) has a horizontal offset of 0.5 inches or more when the fissure/crack is at

fissures with “medium” or “large” horizontal offset were observed in March. The locations of the grids are shown in Figure 1. This figure does not show any cracks or fissures because no cracks meeting the definition of “significant” or having a “medium” or “large” horizontal offset were observed in March.

The two “small” and two “extra small” cracks that were observed were repaired by placing soil and track-walking over the crack. The grid locations of these cracks on the top deck of the landfill and the orientations of the cracks indicate they were likely associated with settlement and not with slope instability.

### Cross Sections

Cross sections that compare February 26, 2025 and March 26, 2025 topography are shown in Figures 2A through 2E. The locations of the cross sections are shown in Figure 1. The sections show no significant differences in slope between the February 2025 and March 2025 profiles, and no evidence of deformation indicative of instability, which is consistent with the daily site observations described above and the information summarized in Tables 1 and 2.

### Previous Monitoring Results and Trends

Previous monitoring in May, June, and December 2024 indicated potentially significant cracking in the following grids:

- **Grid 183.** The May 2024 monthly summary report described one potentially significant tension crack in Grid 183 identified on May 23, 2024 that was approximately 65 feet long with 0.5 to 2 inches of horizontal offset (defined as “small”). This crack was repaired by track-walking, and no significant or potentially significant cracks were observed in this grid during subsequent monitoring in May or June. This grid has been covered with a geomembrane and there was no evidence of instability associated with this (or any) geomembrane-covered area from July 2024 through March 2025.
- **Grid 151.** The May 2024 monthly report indicated that potentially significant cracking may have been present in Grid 151 on May 20 and May 28, 2024. The June monthly report identified a crack, although not significant, with more than 4 inches of horizontal offset (defined as “large”) and 0.5 to 2 inches of vertical offset (defined as “small”) that was observed within an approximately 15-foot x 35-foot area of multiple cracks in this grid on June 19, 2024. The July monthly report identified a non-significant crack with more than 4 inches of horizontal offset and

---

least 50 feet in length; or (3) has a vertical offset of 0.5 inches or more when the fissure/crack is at least 50 feet in length or there are multiple fissures/cracks oriented in the same direction.

0.5 to 2 inches of vertical offset that was observed in this grid on July 2, 2024. The July crack was repaired, and no cracks were observed in this grid during subsequent monitoring from August 2024 through March 2025.

- **Grid 180.** An approximately 60-foot-long crack was observed within Grid 180 on June 3, 2024. The horizontal offset was “small,” which means it was between 0.5-inches and 2-inches in width. This crack was not observed or noted during subsequent June 2024 monitoring rounds. This grid has been covered with a geomembrane and there was no evidence of instability associated with this (or any) geomembrane-covered area during subsequent monitoring from July 2024 through March 2025.
- **Grid 152.** An approximately 55-foot-long crack was observed within Grid 152 on June 24, 2024. The horizontal offset was identified as “small.” This crack was not noted during subsequent monitoring rounds in June, and there was no cracking observed in this grid during subsequent monitoring from August 2024 through March 2025. Grid 152 has been partially covered with a geomembrane and is near the center of the Landfill’s top deck.
- **Grid 146.** An approximately 55-foot-long crack was observed within Grid 146 on December 4, 2024. The horizontal offset was identified as “medium” whereas the vertical offset was identified as “extra small”. This crack was repaired by track-walking and was not observed during subsequent December monitoring rounds. No other potentially significant cracks or fissures were observed within this grid during subsequent monitoring from December 2024 through March 2025. Additionally, no cracks with “medium” or “large” horizontal offset were observed in March. Table 1 identifies non-significant cracks with “extra small” to “small” horizontal offset that were observed during March 2025 monitoring rounds. These cracks were repaired by placing soil and track-walking.

Most of the fissures and tension cracks identified between April 2024 and March 2025 were identified in grids located on the top deck of the Landfill. Although much of the reaction area has been covered with a geomembrane and the soil cover cannot be observed in the geomembrane-covered areas, the March 2025 observations are consistent with previous observations that show no evidence of slope instability. This finding is also consistent with the GLA March 31, 2025 site visit where no evidence of potential slope instability was noted. Based on the Chiquita monitoring logs and on GLA observations during the March 31 site visit, the above-described cracks documented in March 2025 were associated with settlement and do not provide evidence of slope instability.

Please let me know if you have any questions regarding the information in this report.

Very truly yours,  
**Geo-Logic Associates, Inc.**



Richard A. Mitchell, PG, CEG  
Principal Engineering Geologist



**Table 1**  
**SUMMARY OF MARCH 2025 FISSURE AND TENSION CRACK OBSERVATIONS**  
**Chiquita Canyon Landfill**

DATE	INSPECTOR	GRID	LOCATION	TYPE	LENGTH (ft)	AREA (ft x ft)	HORIZONTAL OFFSET	VERTICAL OFFSET	ORIENTATION	LATITUDE	LONGITUDE	REPAIRED	INDICATIONS OF SLOPE STABILITY CONCERNs
3/1/2025	John Boucher		No Cracks Found	Area									No
3/3/2025	Tom Roe		No Cracks Found	Area									No
3/4/2025	Tom Roe		No Cracks Found	Area									No
3/5/2025	Tom Roe		No Cracks Found	Area									No
3/6/2025	John Boucher		No Cracks Found	Area									No
3/7/2025	John Boucher		No Cracks Found	Area									No
3/8/2025	John Boucher		No Cracks Found	Area									No
3/10/2025	Tom Roe		No Cracks Found	Area									No
3/11/2025	Tom Roe		No Cracks Found	Area									No
3/12/2025	Tom Roe		No Cracks Found	Area									No
3/13/2025	Tom Roe		No Cracks Found	Area									No
3/14/2025	John Boucher		No Cracks Found	Area									No
3/15/2025	John Boucher		No Cracks Found	Area									No
3/17/2025	Tom Roe		No Cracks Found	Area									No
3/18/2025	Tom Roe		No Cracks Found	Area									No
3/19/2025	Tom Roe		No Cracks Found	Area									No
3/20/2025	John Boucher		No Cracks Found	Area									No
3/21/2025	John Boucher		No Cracks Found	Area									No
3/22/2025	John Boucher		No Cracks Found	Area									No
3/24/2025	Tom Roe	146	Top Deck	Area	10x25	Extra Small	Extra Small	NS	34.435871	-118.646540	Yes		No
3/24/2025	Tom Roe	146	Top Deck	Linear	35	Small	Extra Small	NS	34.435919	-118.647067	Yes		No
3/25/2025	Tom Roe		No Cracks Found	Area									No
3/26/2025	Tom Roe		No Cracks Found	Area									No
3/27/2025	John Boucher	147	Top Deck	Area	30x30	Extra Small	Extra Small	NW	34.435441	-118.646680	Yes		No
3/28/2025	John Boucher		No Cracks Found	Area									No
3/29/2025	John Boucher		No Cracks Found	Area									No
3/31/2025	Tom Roe	147	Top Deck	Area	6x35	Small	Extra Small	NW	34.435671	-118.646939	Yes		No

**HORIZONTAL CRACK DEFINITIONS**

Extra Small <0.5-in Width

Small 0.5-in to 2-in Width

Medium 2-in to 4-in Width

Large >4-in Width

**VERTICAL CRACK DEFINITIONS**

Extra Small <0.5-in Height

Small 0.5-in to 2-in Height

**Table 2**  
**SUMMARY OF MARCH 2025 GEOMEMBRANE COVER OBSERVATIONS**  
**Chiquita Canyon Landfill**

DATE	ISSUES OR CONCERNS			
	Issue Identified	Evidence of Underlying Deformation	Tension Cracks at Top of Slope or Bulging at Toe of Slope	Vertical Deformation of Infrastructure Such as Wells or Probes
3/1/2025	No	No	No	No
3/3/2025	No	No	No	No
3/4/2025	Yes <sup>a</sup>	No	No	No
3/5/2025	No	No	No	No
3/6/2025	No	No	No	No
3/7/2025	No	No	No	No
3/8/2025	No	No	No	No
3/10/2025	No	No	No	No
3/11/2025	No	No	No	No
3/12/2025	No	No	No	No
3/13/2025	No	No	No	No
3/14/2025	No	No	No	No
3/15/2025	No	No	No	No
3/17/2025	Yes <sup>b</sup>	No	No	No
3/18/2025	No	No	No	No
3/19/2025	Yes <sup>c</sup>	No	No	No
3/20/2025	No	No	No	No
3/21/2025	No	No	No	No
3/22/2025	No	No	No	No
3/24/2025	Yes <sup>d</sup>	No	No	No
3/25/2025	No	No	No	No
3/26/2025	Yes <sup>e</sup>	No	No	No
3/27/2025	No	No	No	No
3/28/2025	No	No	No	No
3/29/2025	Yes <sup>f</sup>	No	No	No
3/31/2025	No	No	No	No

<sup>a</sup>4-inch tear in liner in Grid 185. Tear was patched and extrusion welded on 3/4/2025.



<sup>b</sup>4-inch tear in liner in Grid 205. Tear was patched and extrusion welded on 3/17/2025.

<sup>c</sup>4-ft separation at a seam in Grid 145. Seam was patched and extrusion welded on 3/19/2025.

<sup>d</sup>2-in x 3-in tear in liner in Grid 180. Tear was patched and extrusion welded on 3/24/2025.

<sup>e</sup>5-inch tear in liner in Grid 188. Tear was patched and extrusion welded on 3/26/2025.

<sup>f</sup>Multiple small tears in liner from equipment in Grid 156. Tears were patched and extrusion welded on 3/29/2025.

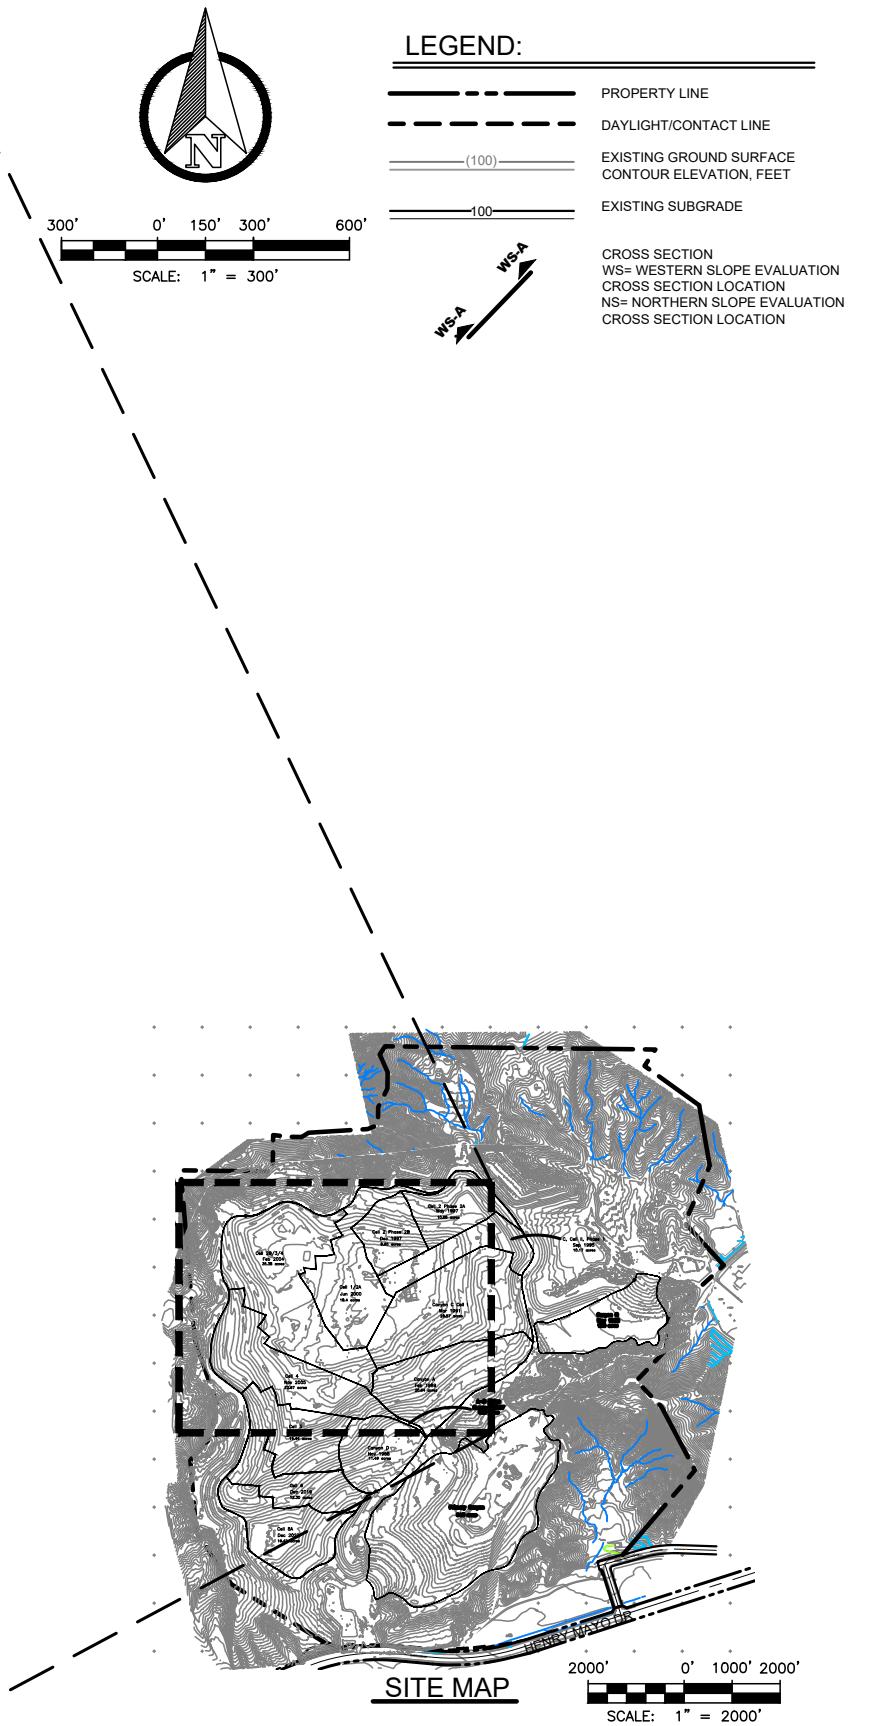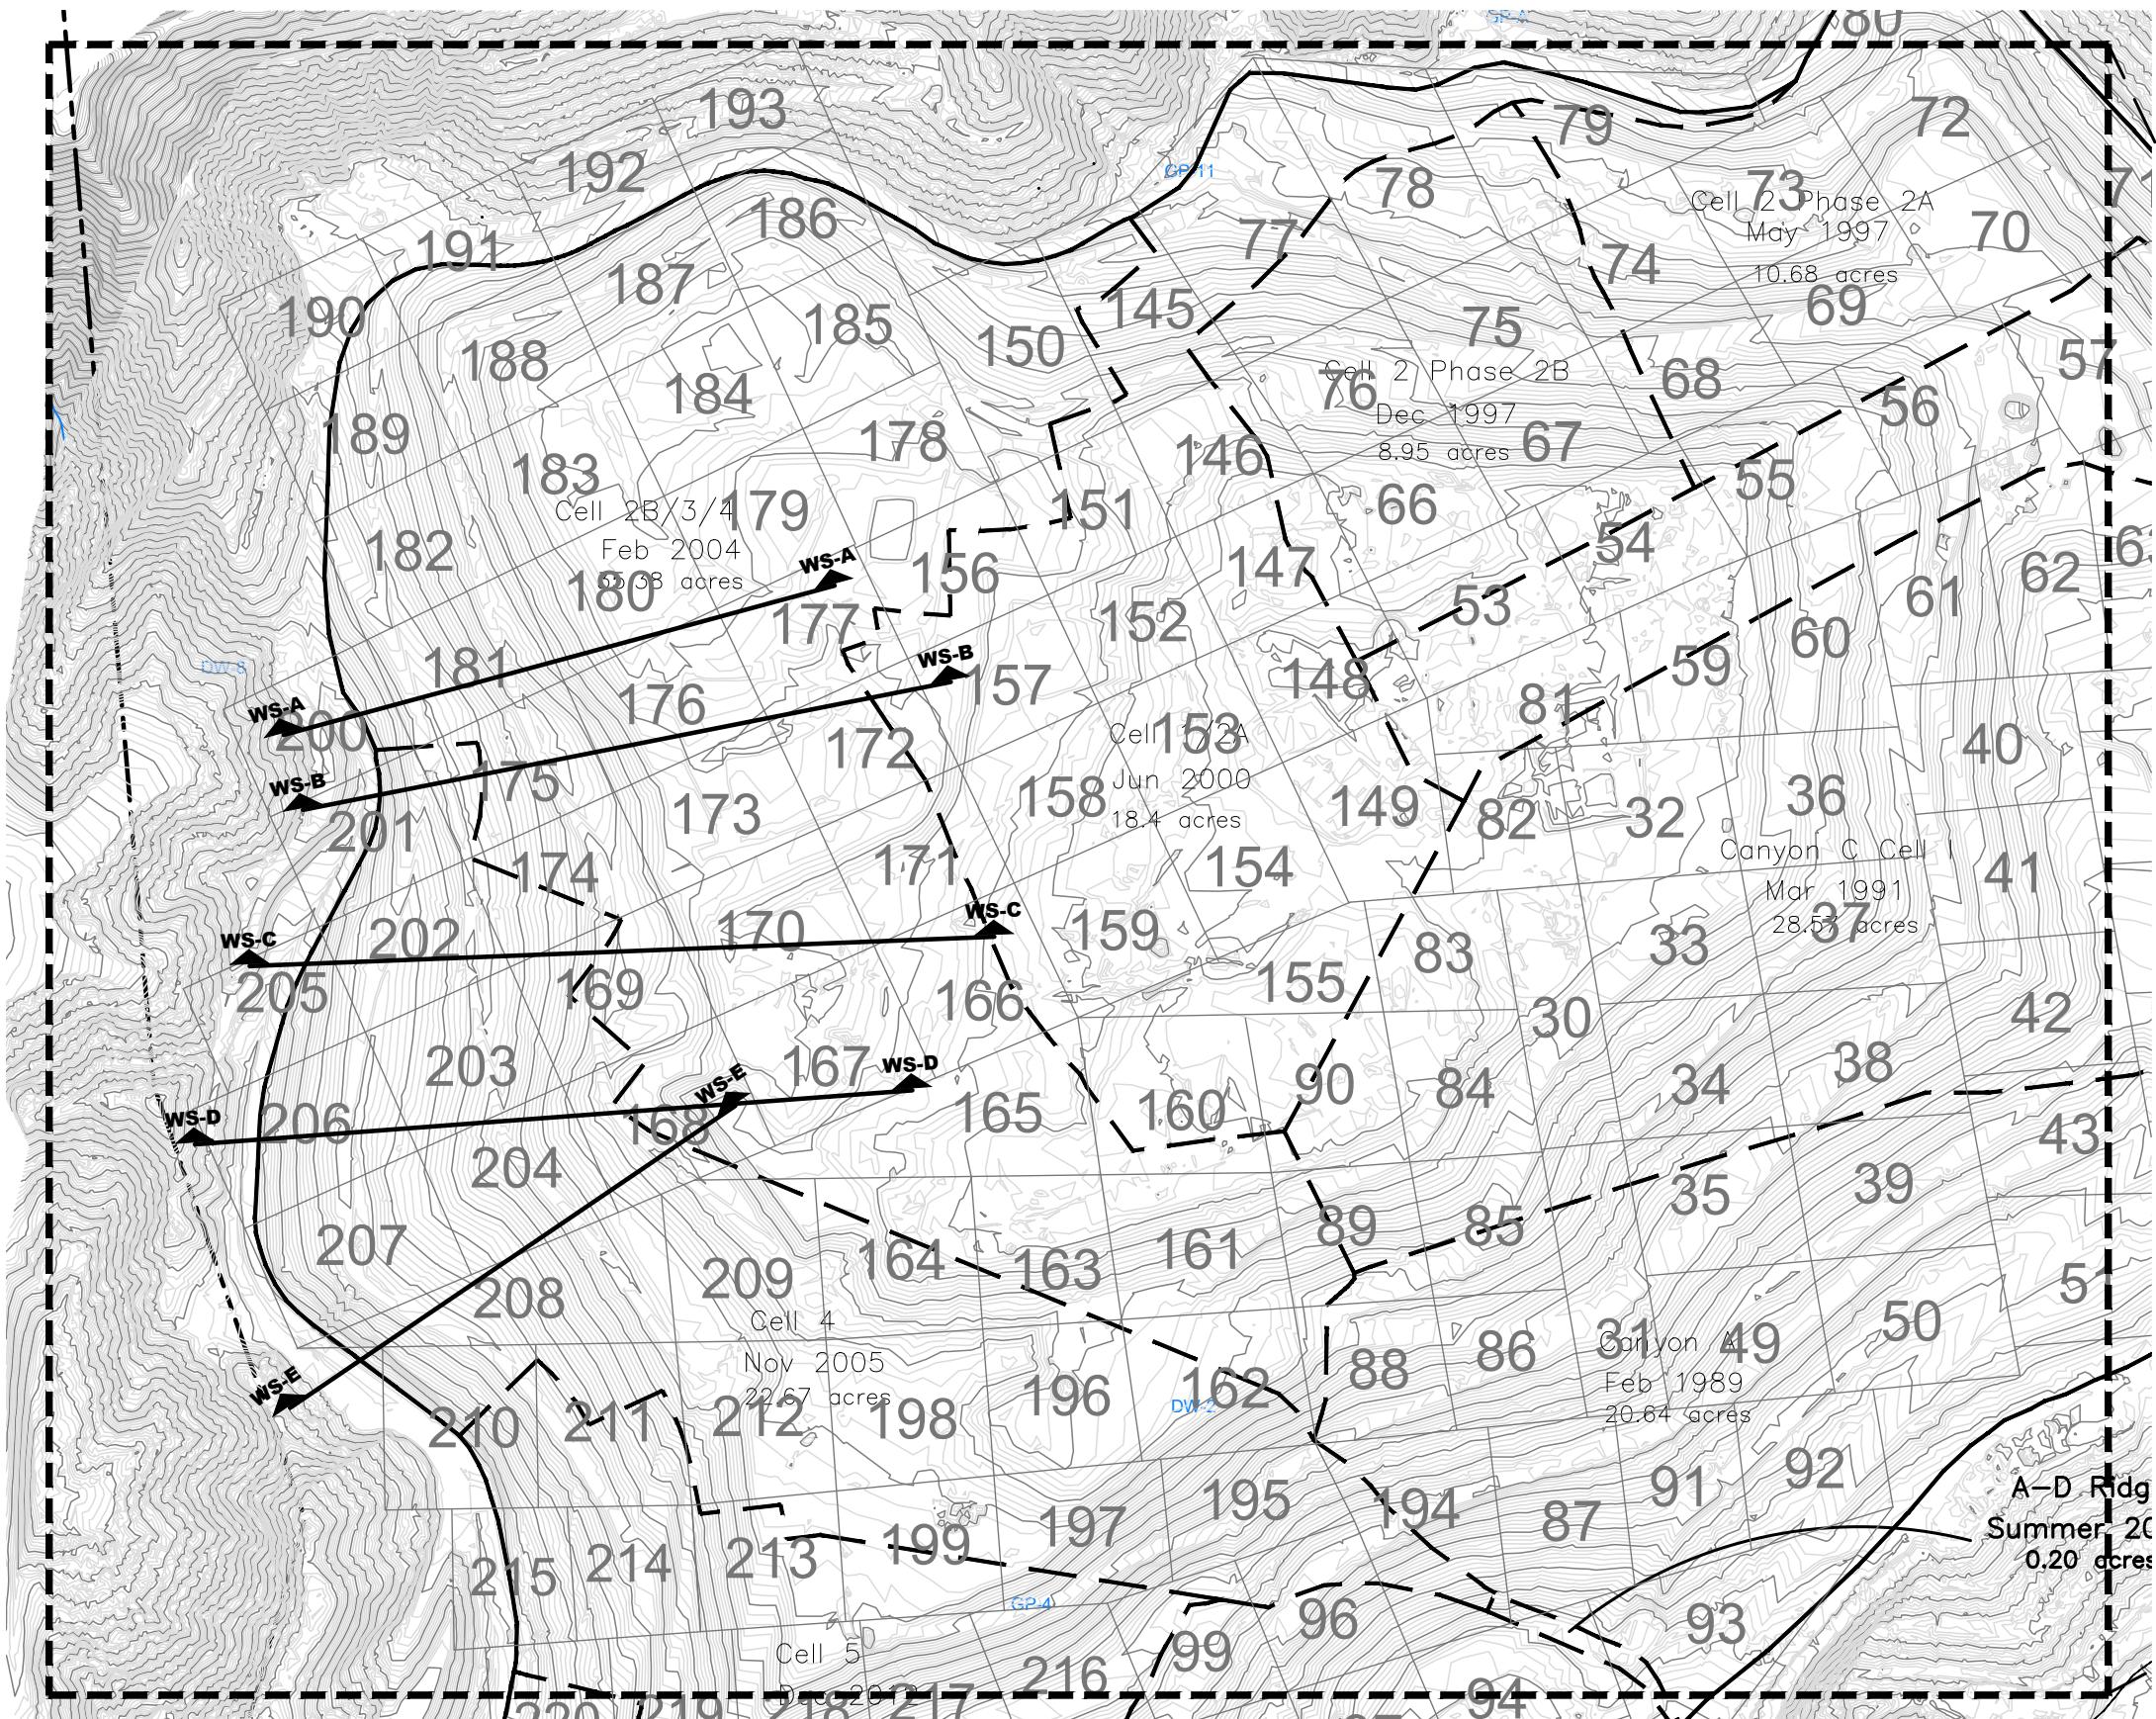

PLATES VARIOUS CIN LF MONITORING SUMMARY FIGURES VMMZ: UU-CUL-NS-TU 1-(2020-04-03).DWG APR 3, 2020 - 11:22 AM BT: GLA-USER

This drawing has not been published but rather has been prepared by Geo-Logic Associates, Inc. for use by the client named in the title block, solely in respect of the construction operation, and maintenance of the facility named in the title block. Geo-Logic Associates, Inc. shall not be liable for the use of this drawing on any other facility or for any other purpose.

REFERENCE AERIAL TOPO BASED ON JANUARY 16, 2025 AERIAL SURVEY BY TETRATECH WITH MONTHLY UPDATES ON FEBRUARY 26, 2025

REV. NO.	DATE	DESCRIPTION	APPROVED BY	DATE OF ISSUE: <u>APRIL 2025</u>
				DESIGNED BY: <u>R MITCHELL</u>
				CAD DESIGN BY: <u>L PADILLA</u>
				CHECKED BY: <u>R MITCHELL</u>
				APPROVED BY: <u>R MITCHELL</u>



# Geo-Logic ASSOCIATES

2777 EAST GUASTI ROAD  
SUITE 1  
ONTARIO, CA 91761  
(909) 626-2282  
[www.gocologic.com](http://www.gocologic.com)



# CHIQUITA CANYON





*A Waste Connections Company*

29201 HENRY MAYO DRIVE  
CASTAIC, CA 91384

MARCH 2025 MONITORING SUMMARY  
CHIQUITA CANYON LANDFILL  
COUNTY OF LOS ANGELES, CA

FIG NO.  
01

01  
PROJECT NO.  
RM22-1077

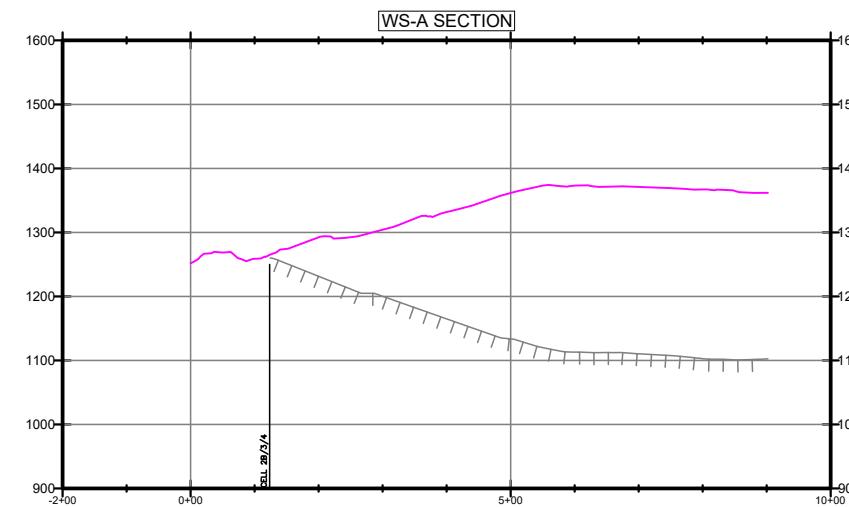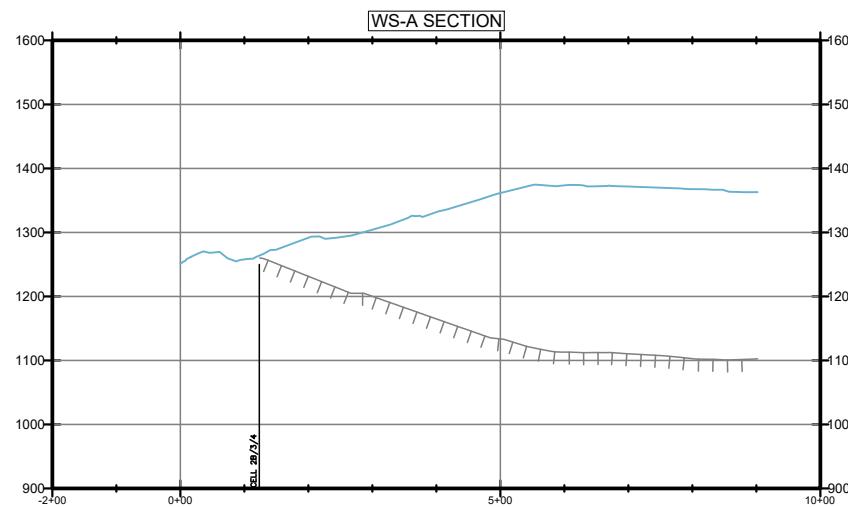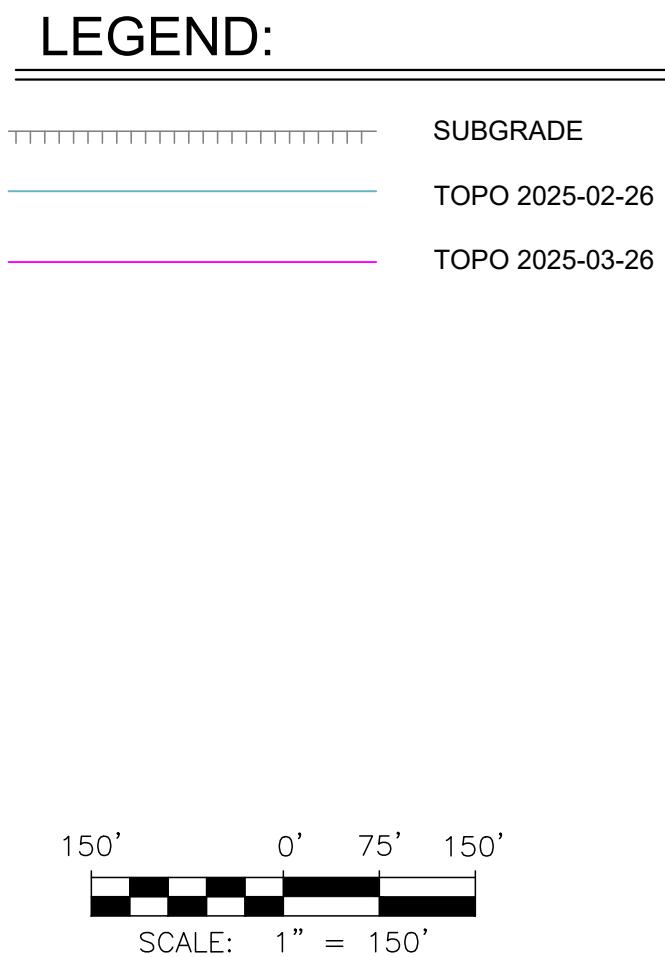
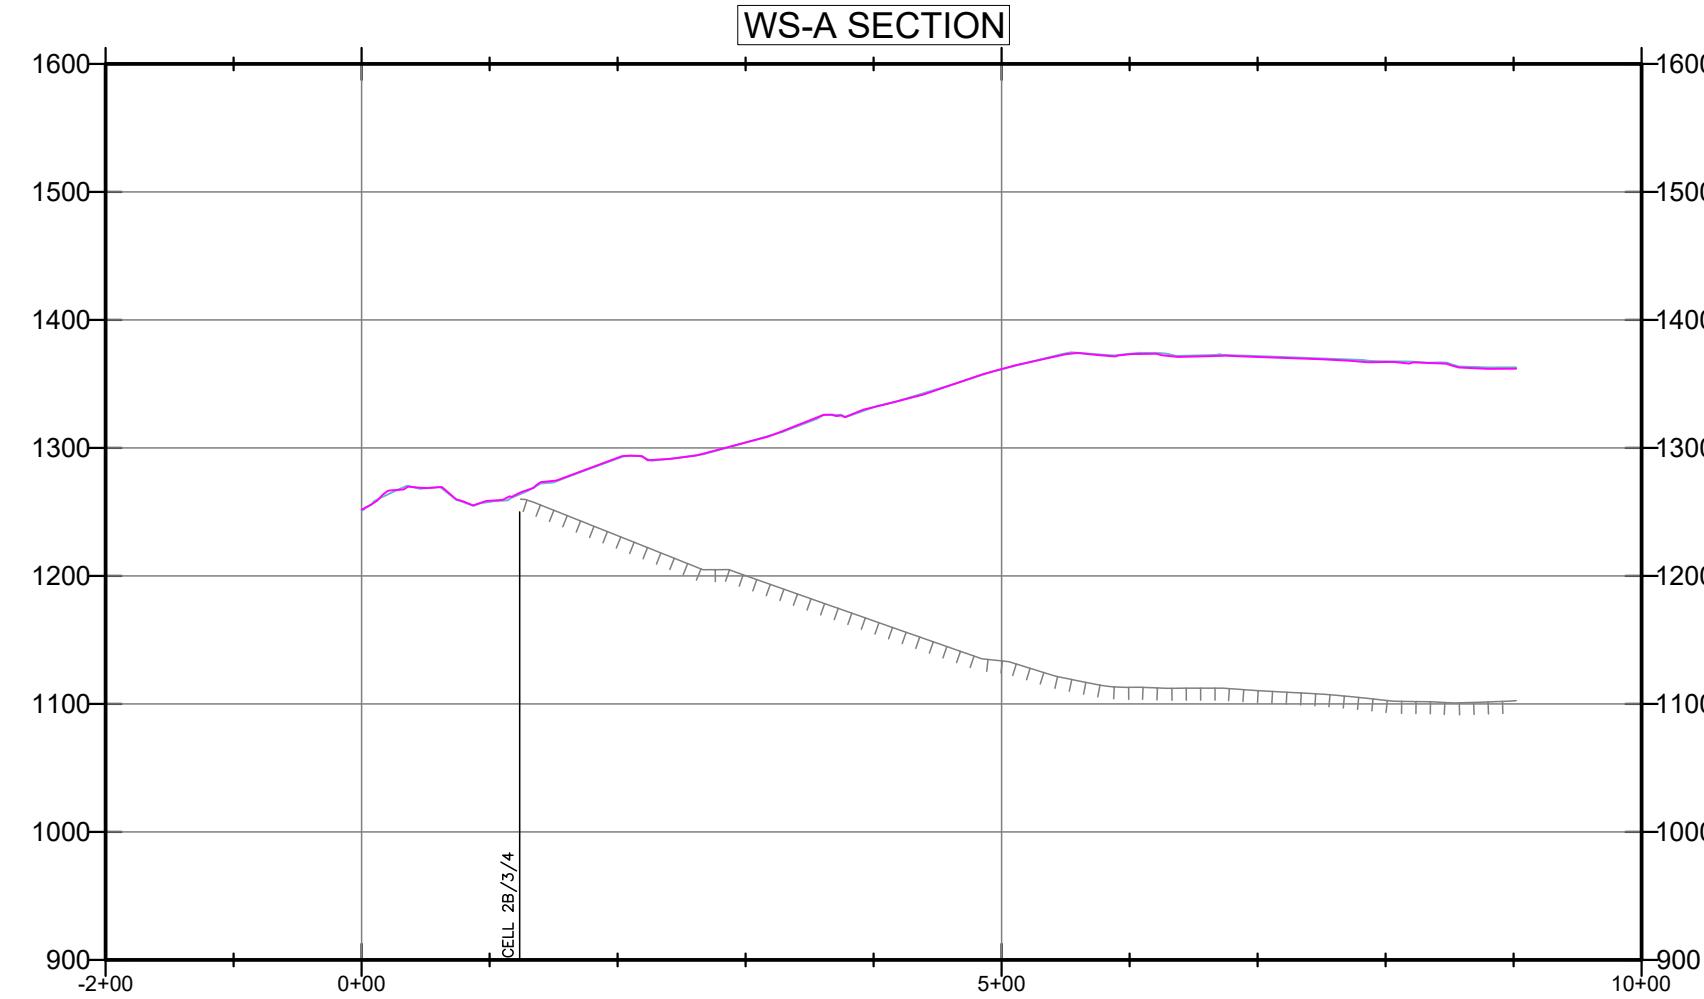


## FIGURE 2A

WESTERN SLOPE CROSS SECTION A  
MARCH 2025 MONITORING SUMMARY  
CHIQUITA CANYON LANDFILL  
COUNTY OF LOS ANGELES, CA


# Geo-Logic ASSOCIATES

DRAWN BY: LP/RM DATE: APRIL 2025 JOB NO.: RM22.1077


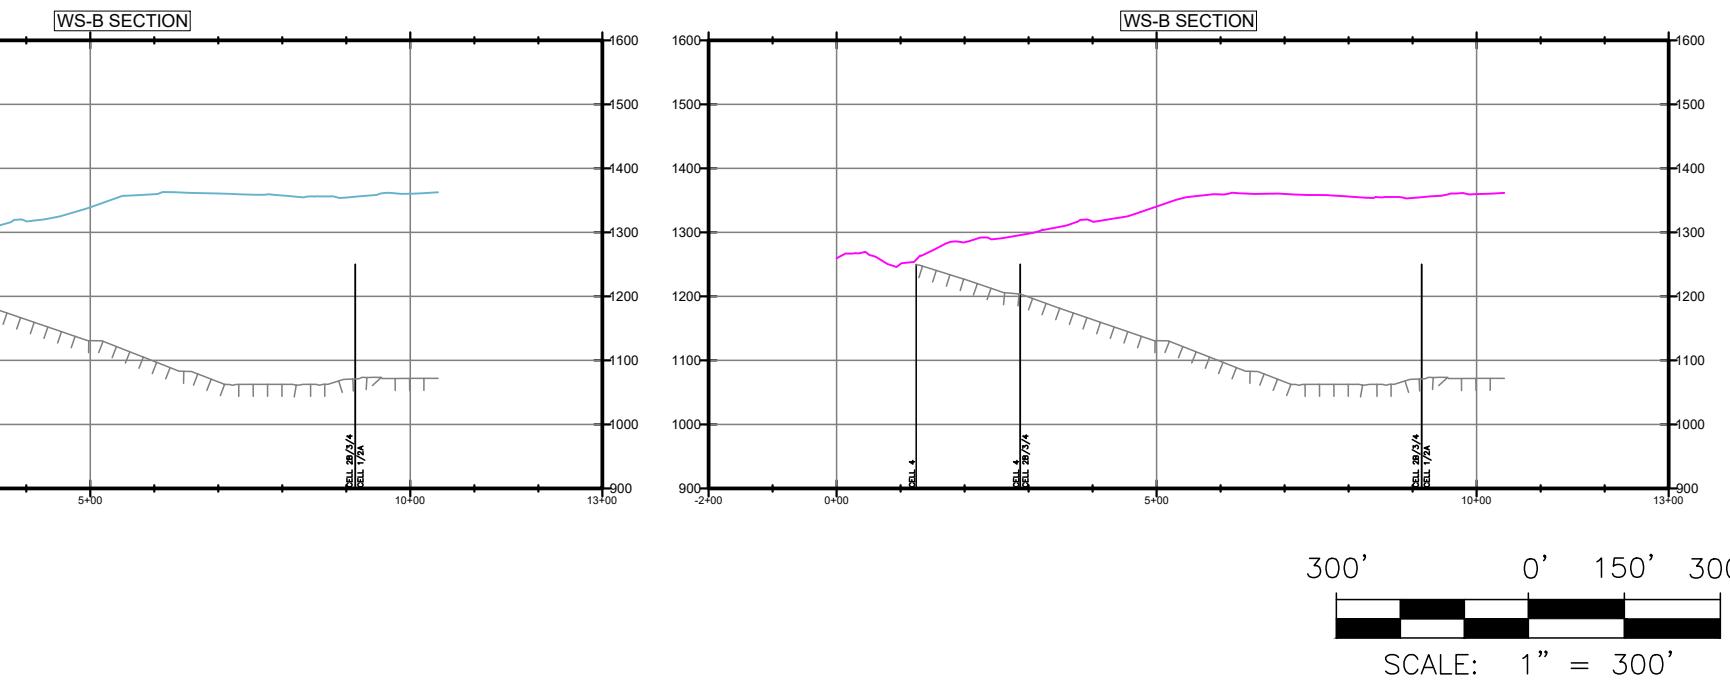
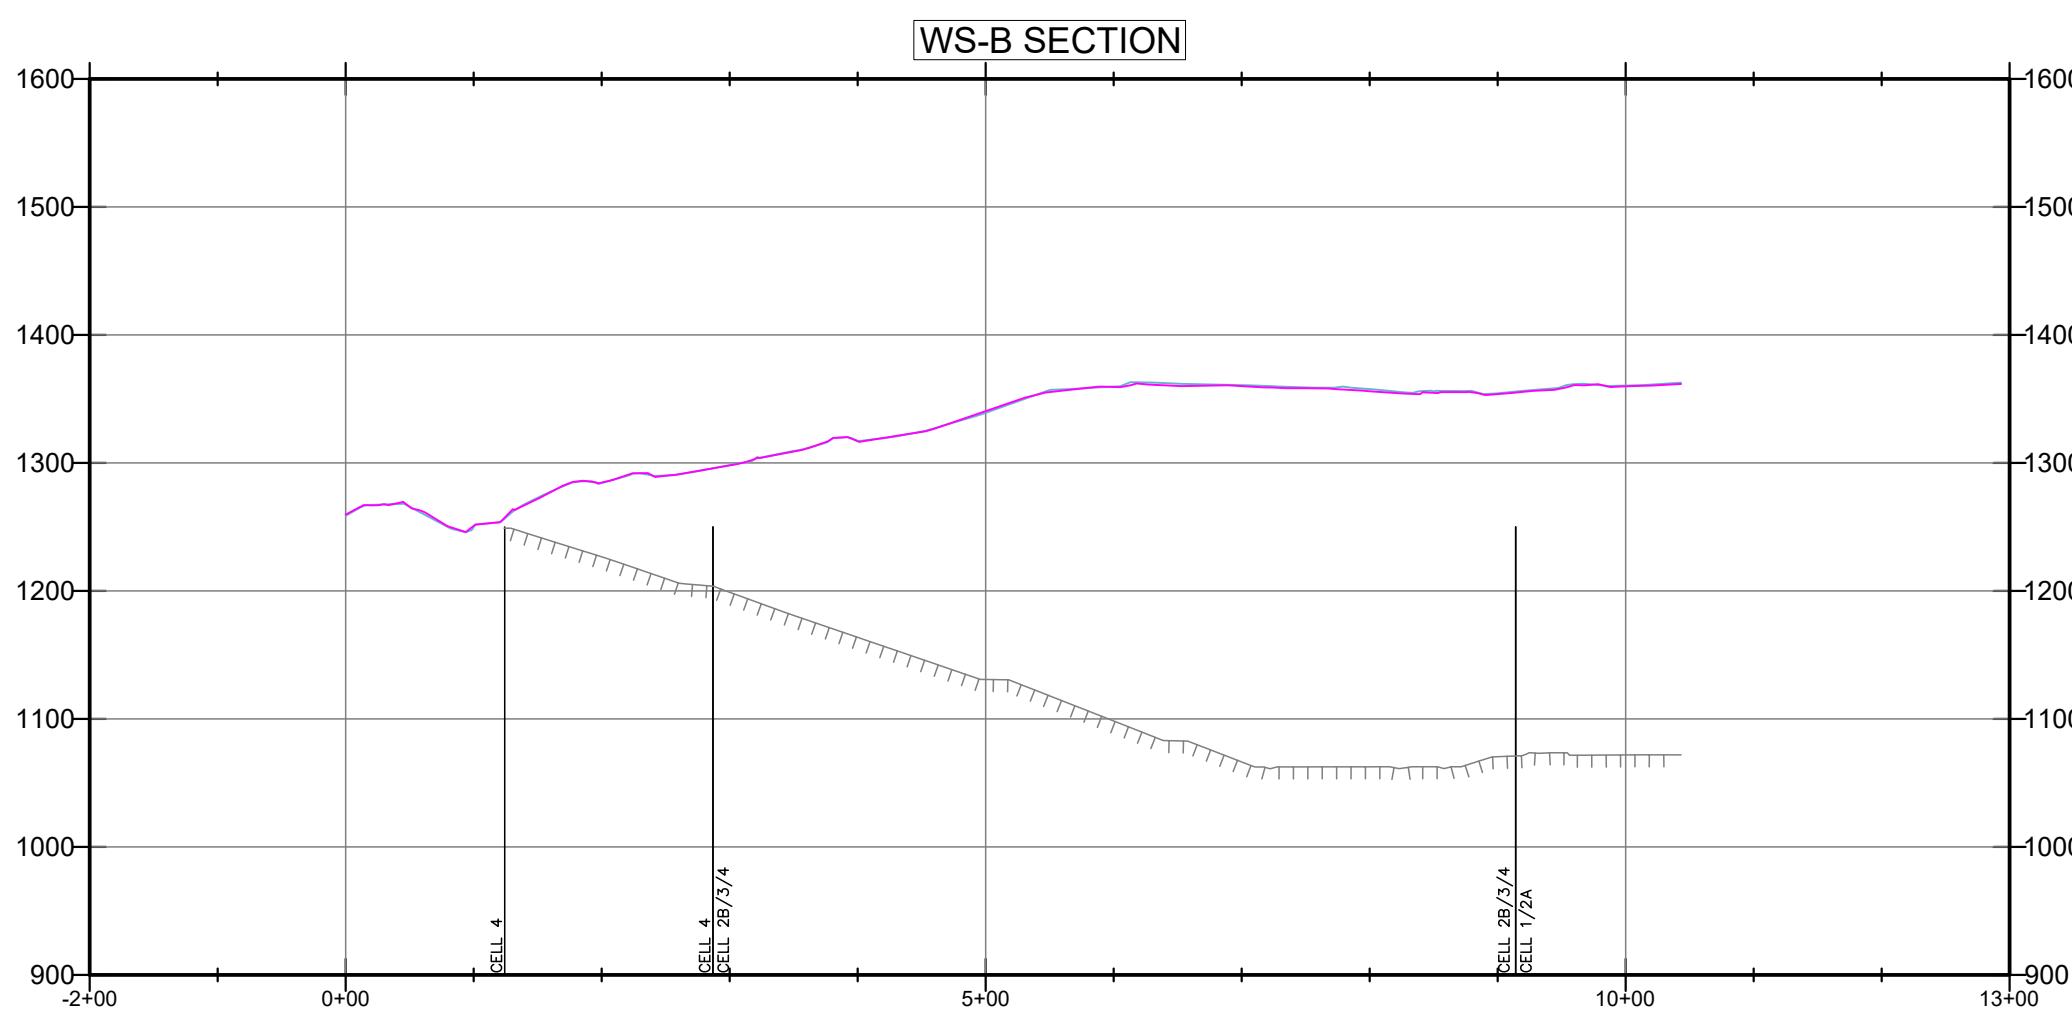


**FIGURE 2B**  
**WESTERN SLOPE CROSS SECTION B**  
**MARCH 2025 MONITORING SUMMARY**  
**CHIQUITA CANYON LANDFILL**  
**COUNTY OF LOS ANGELES, CA**

**Geo-Logic**  
**ASSOCIATES**

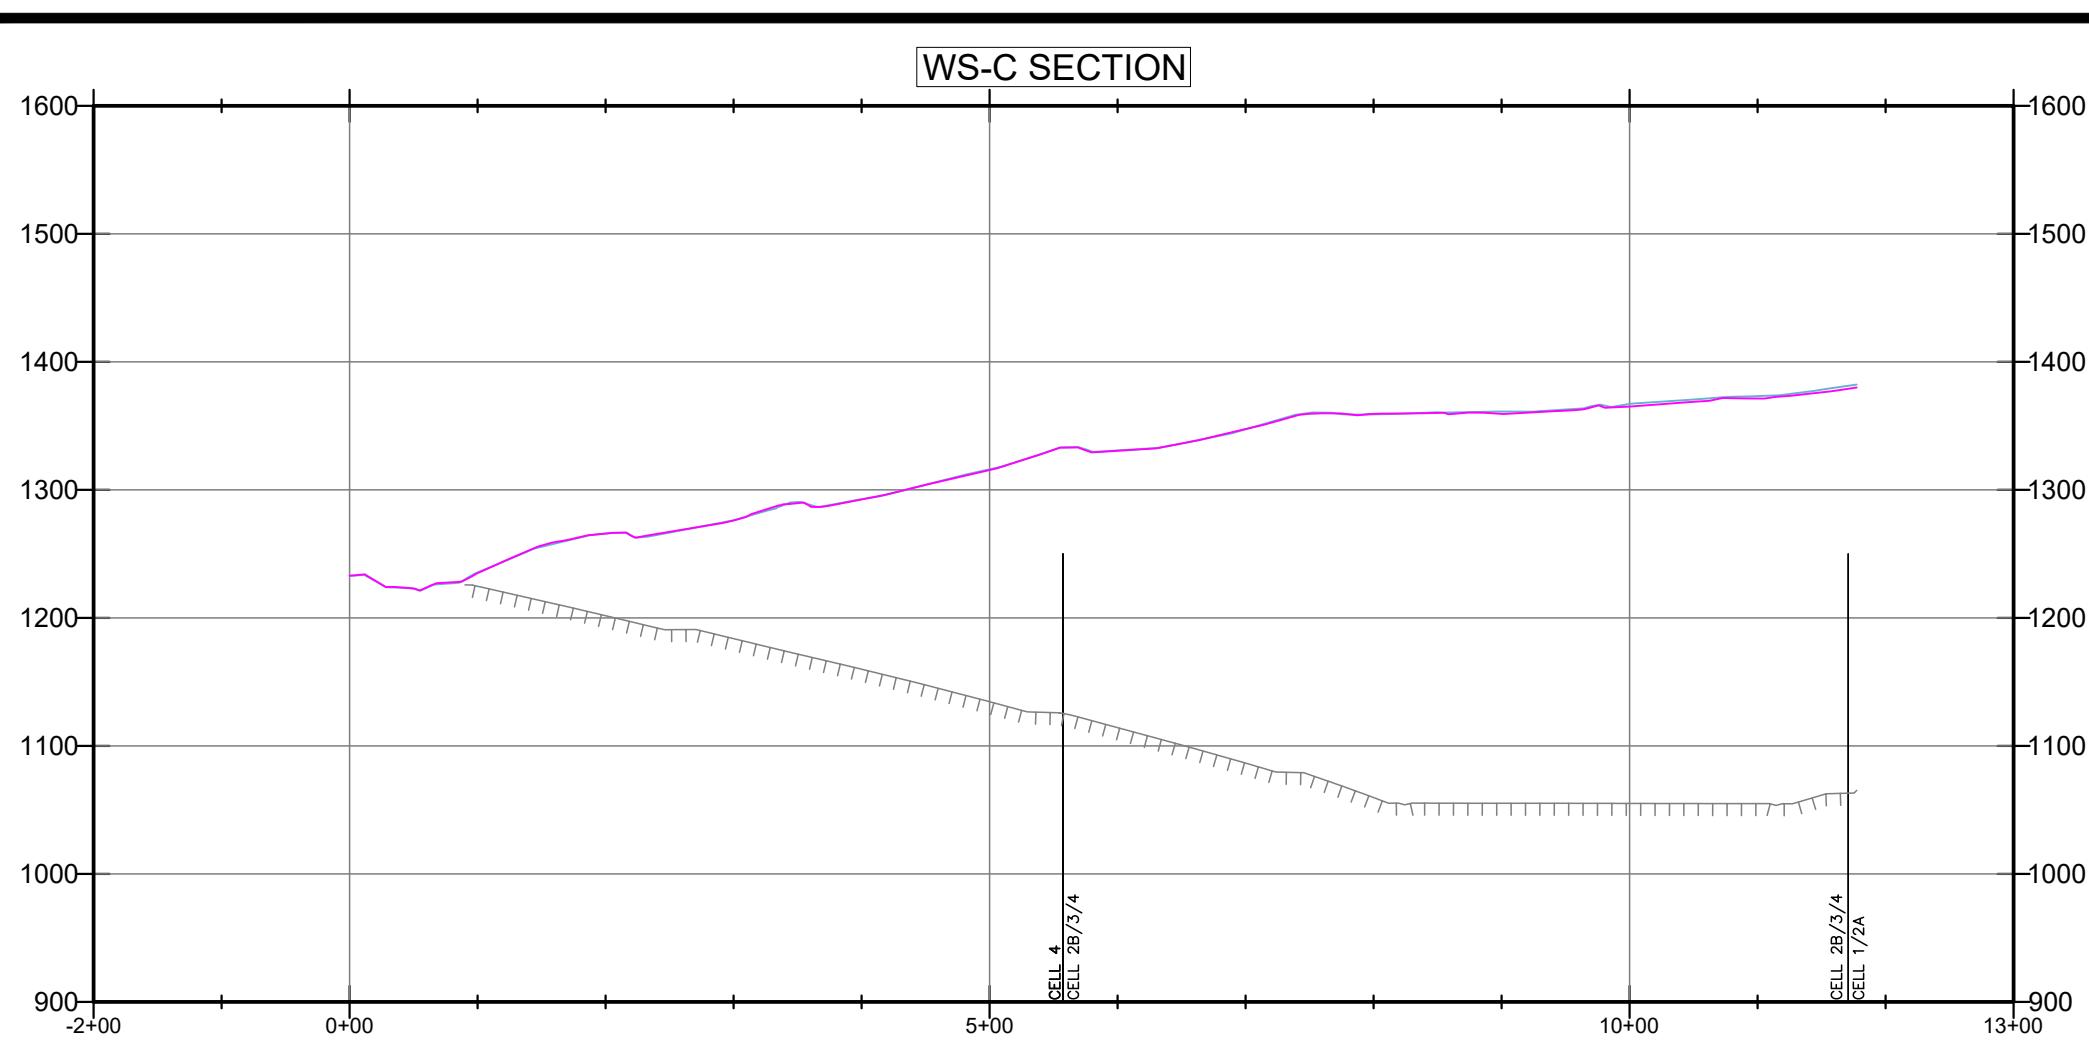



**LEGEND:**

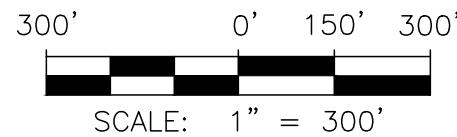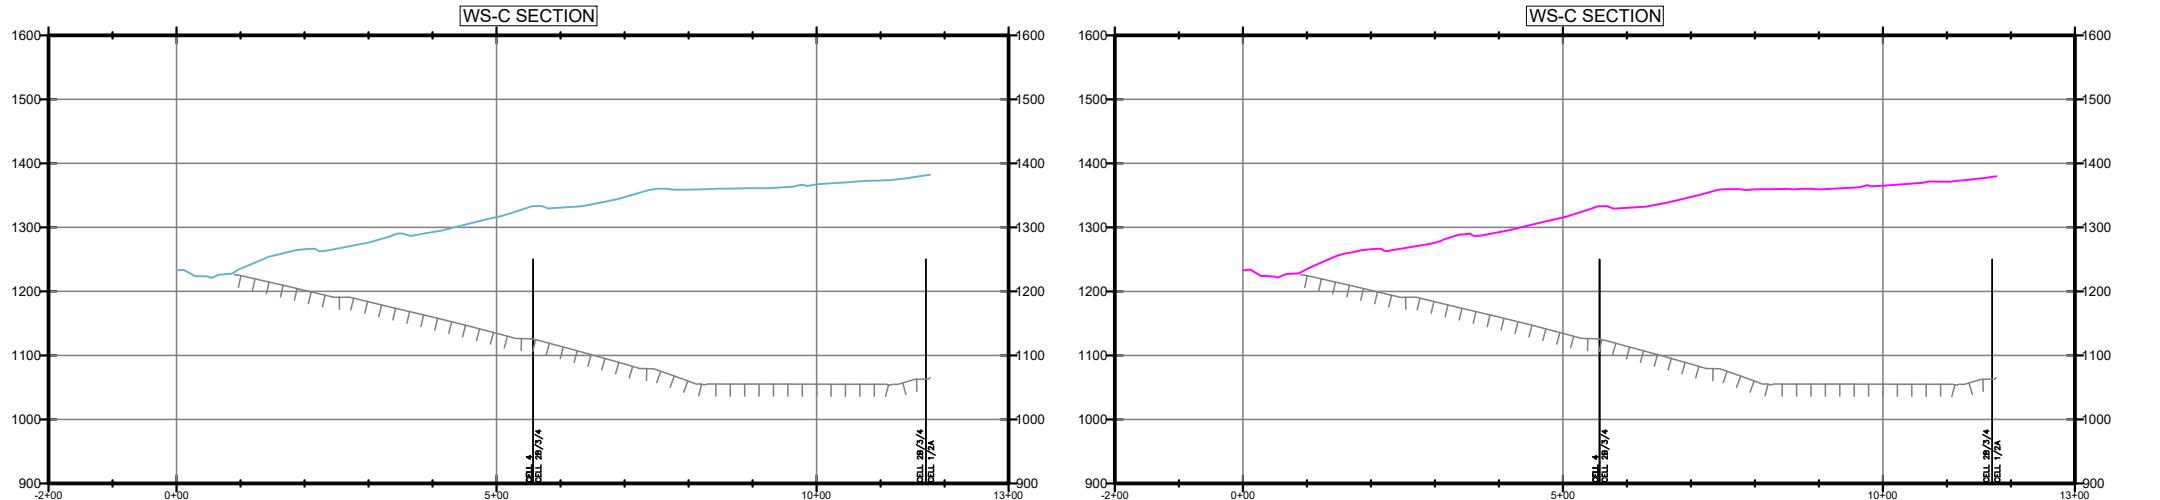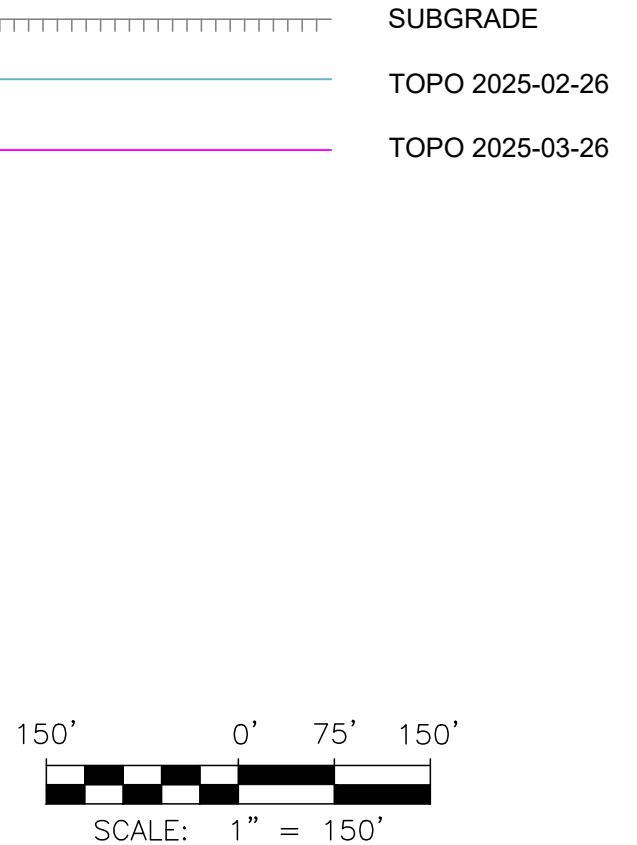

**FIGURE 2C**






**WESTERN SLOPE CROSS SECTION C**  
**MARCH 2025 MONITORING SUMMARY**  
**CHIQUITA CANYON LANDFILL**  
**COUNTY OF LOS ANGELES, CA**

**Geo-Logic**  
**ASSOCIATES**

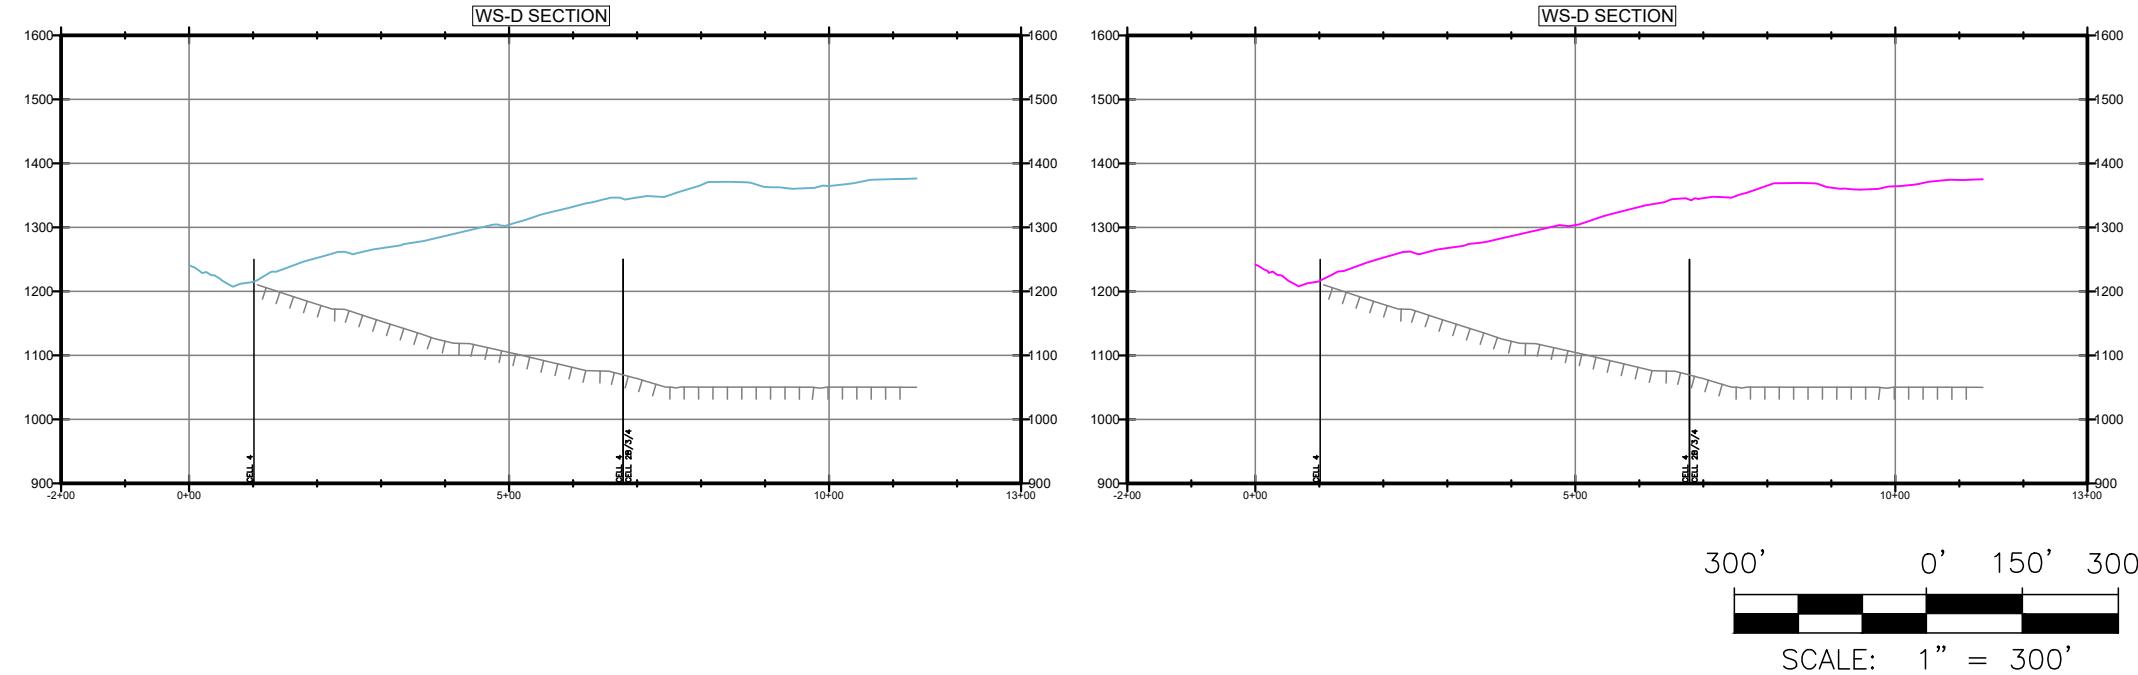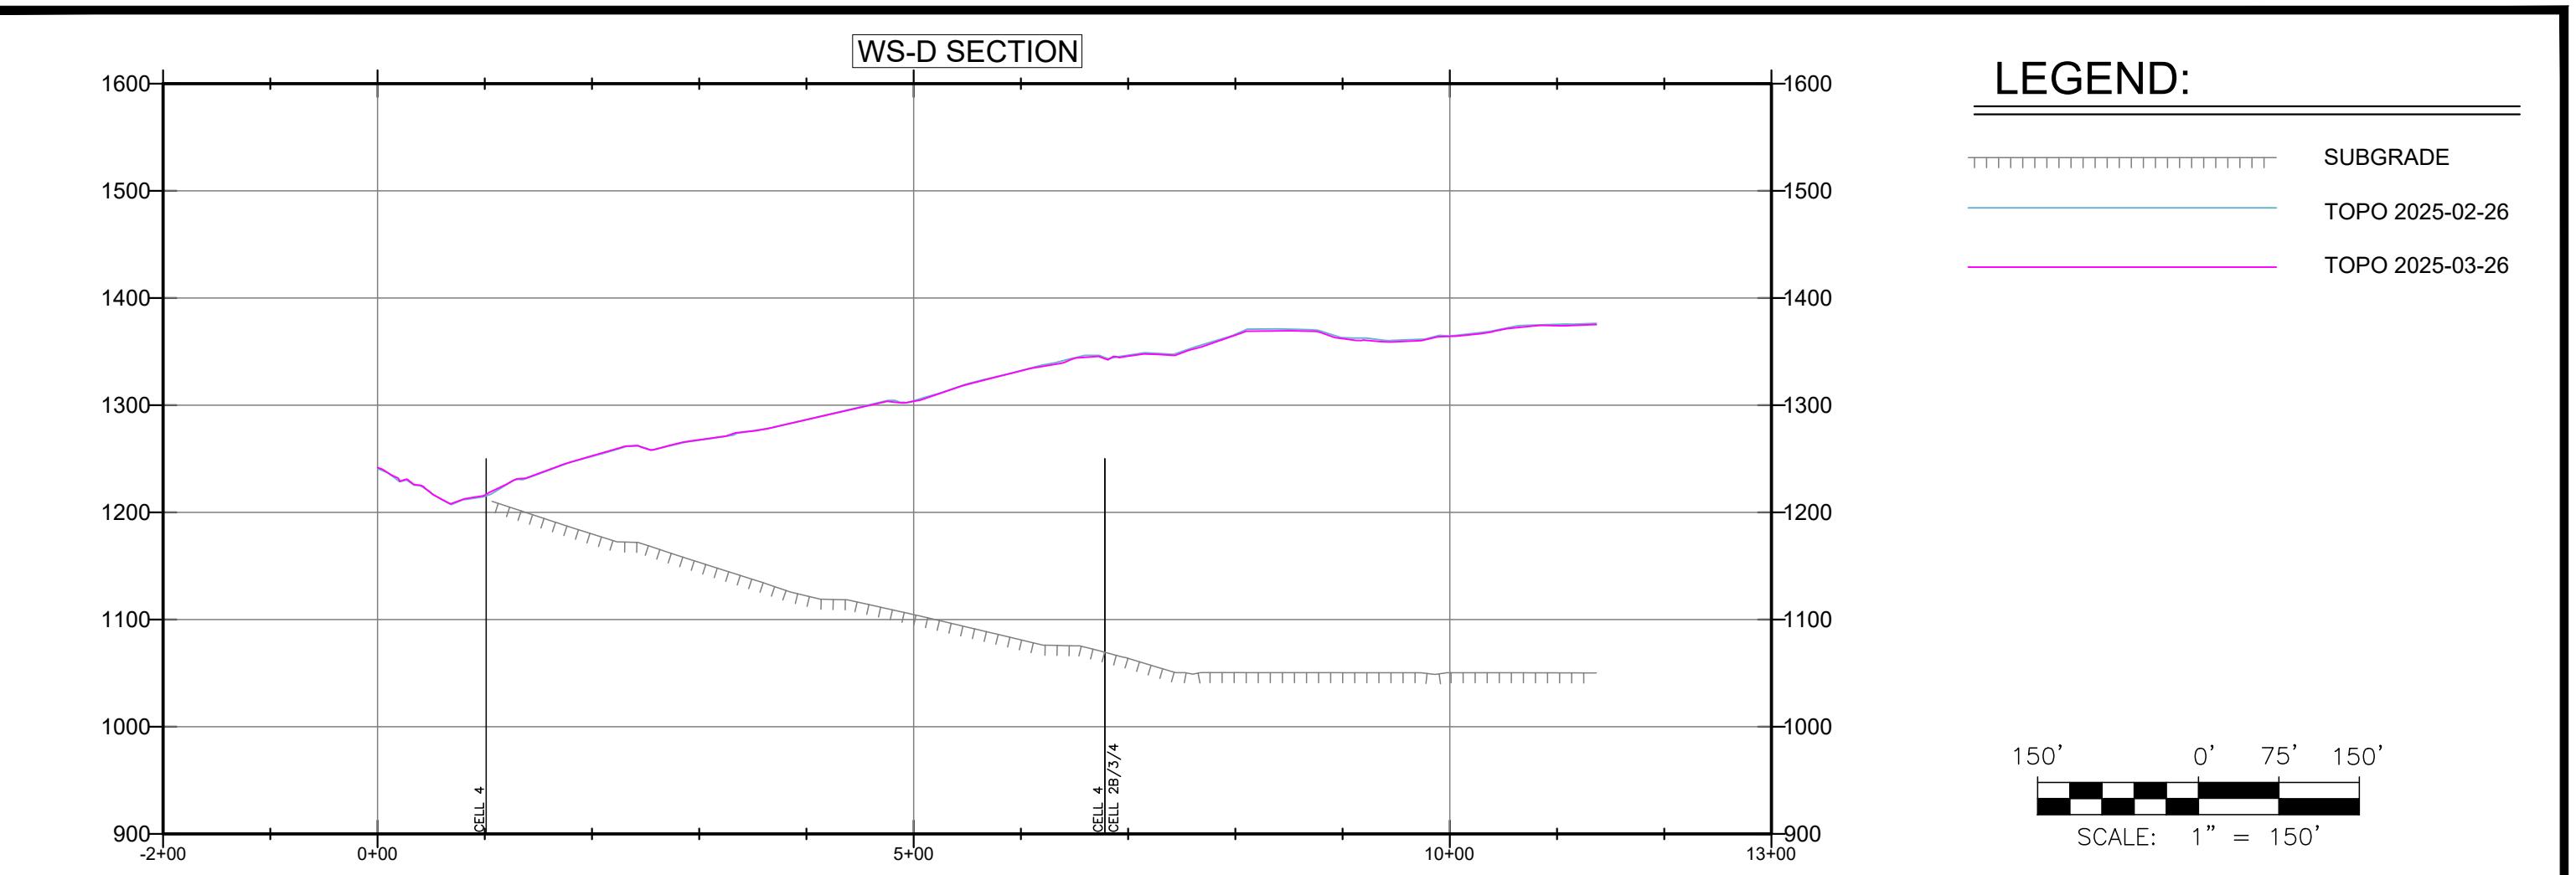

**FIGURE 2D**  
**WESTERN SLOPE CROSS SECTION D**  
**MARCH 2025 MONITORING SUMMARY**  
**CHIQUITA CANYON LANDFILL**  
**COUNTY OF LOS ANGELES, CA**


**Geo-Logic**  
**ASSOCIATES**

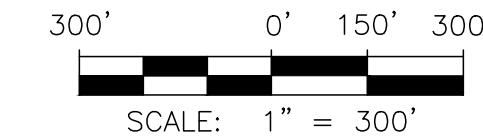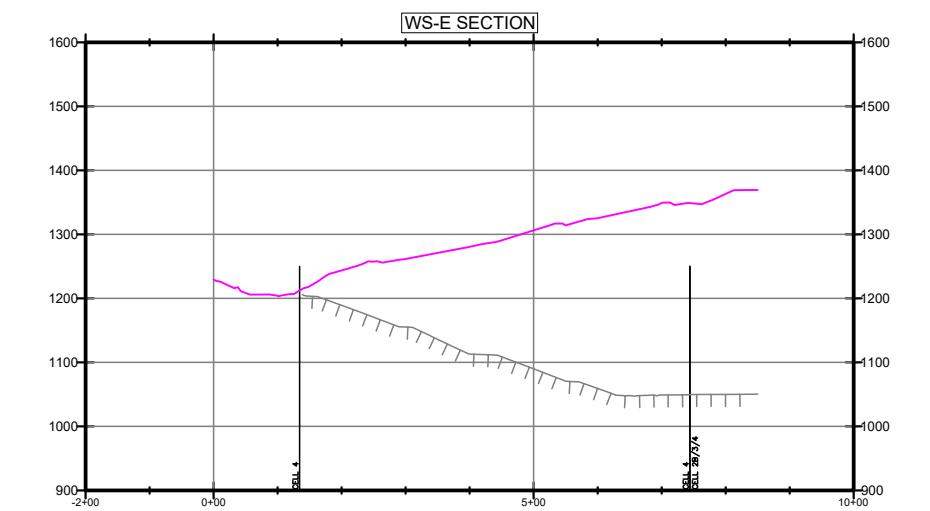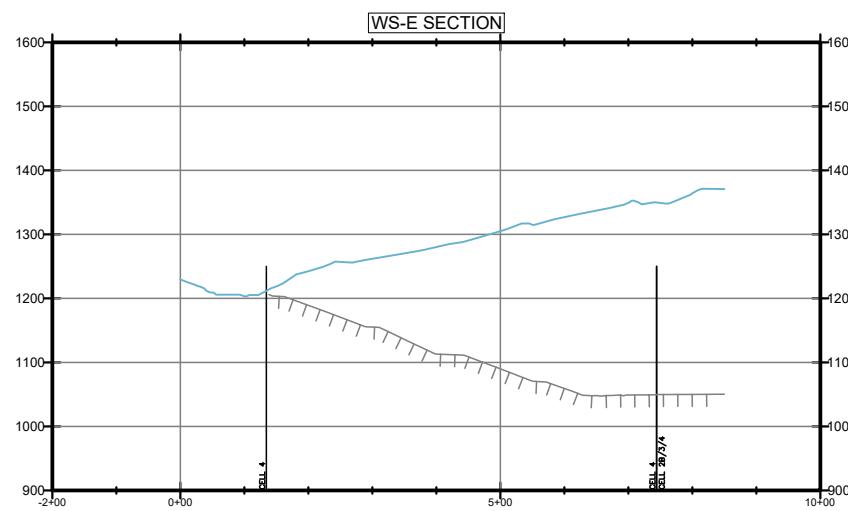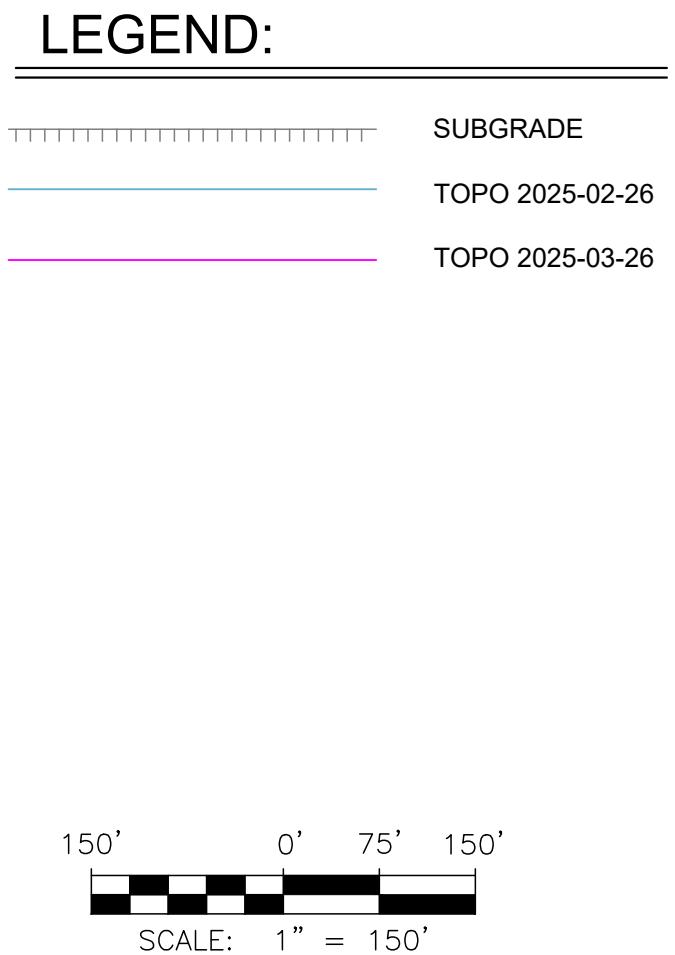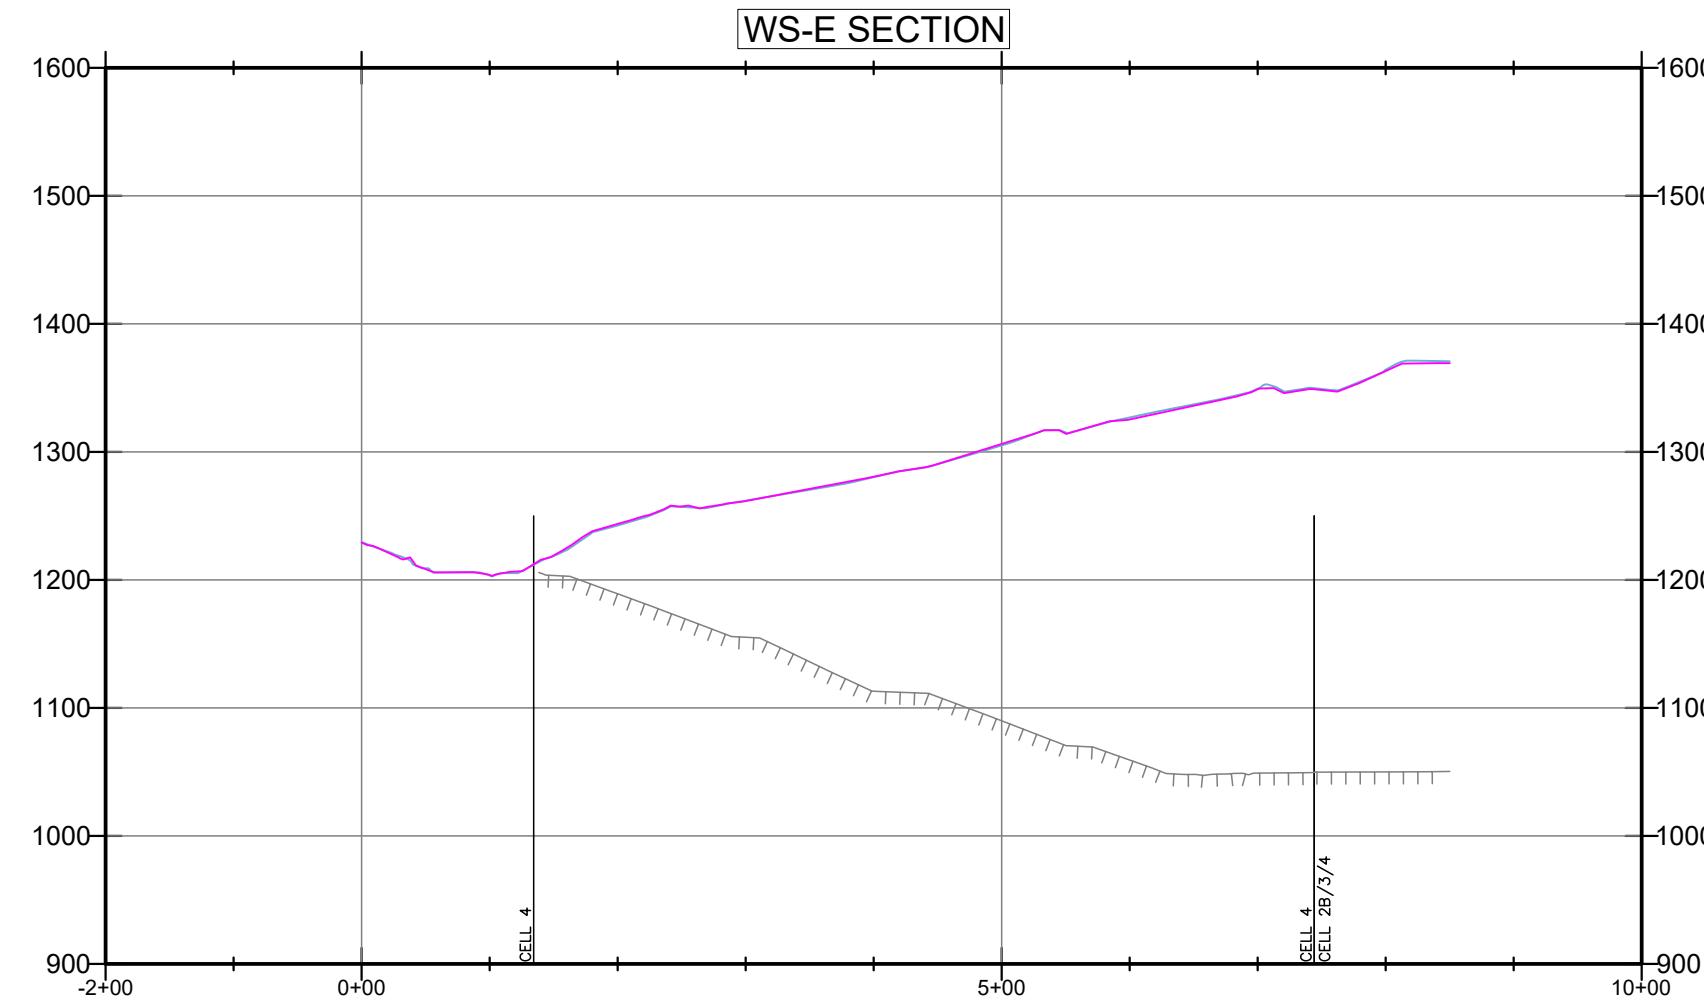

**FIGURE 2E**  
**WESTERN SLOPE CROSS SECTION E**  
**MARCH 2025 MONITORING SUMMARY**  
**CHIQUITA CANYON LANDFILL**  
**COUNTY OF LOS ANGELES, CA**

**Geo-Logic**  
**ASSOCIATES**

# Chiquita Canyon Landfill - Isopach

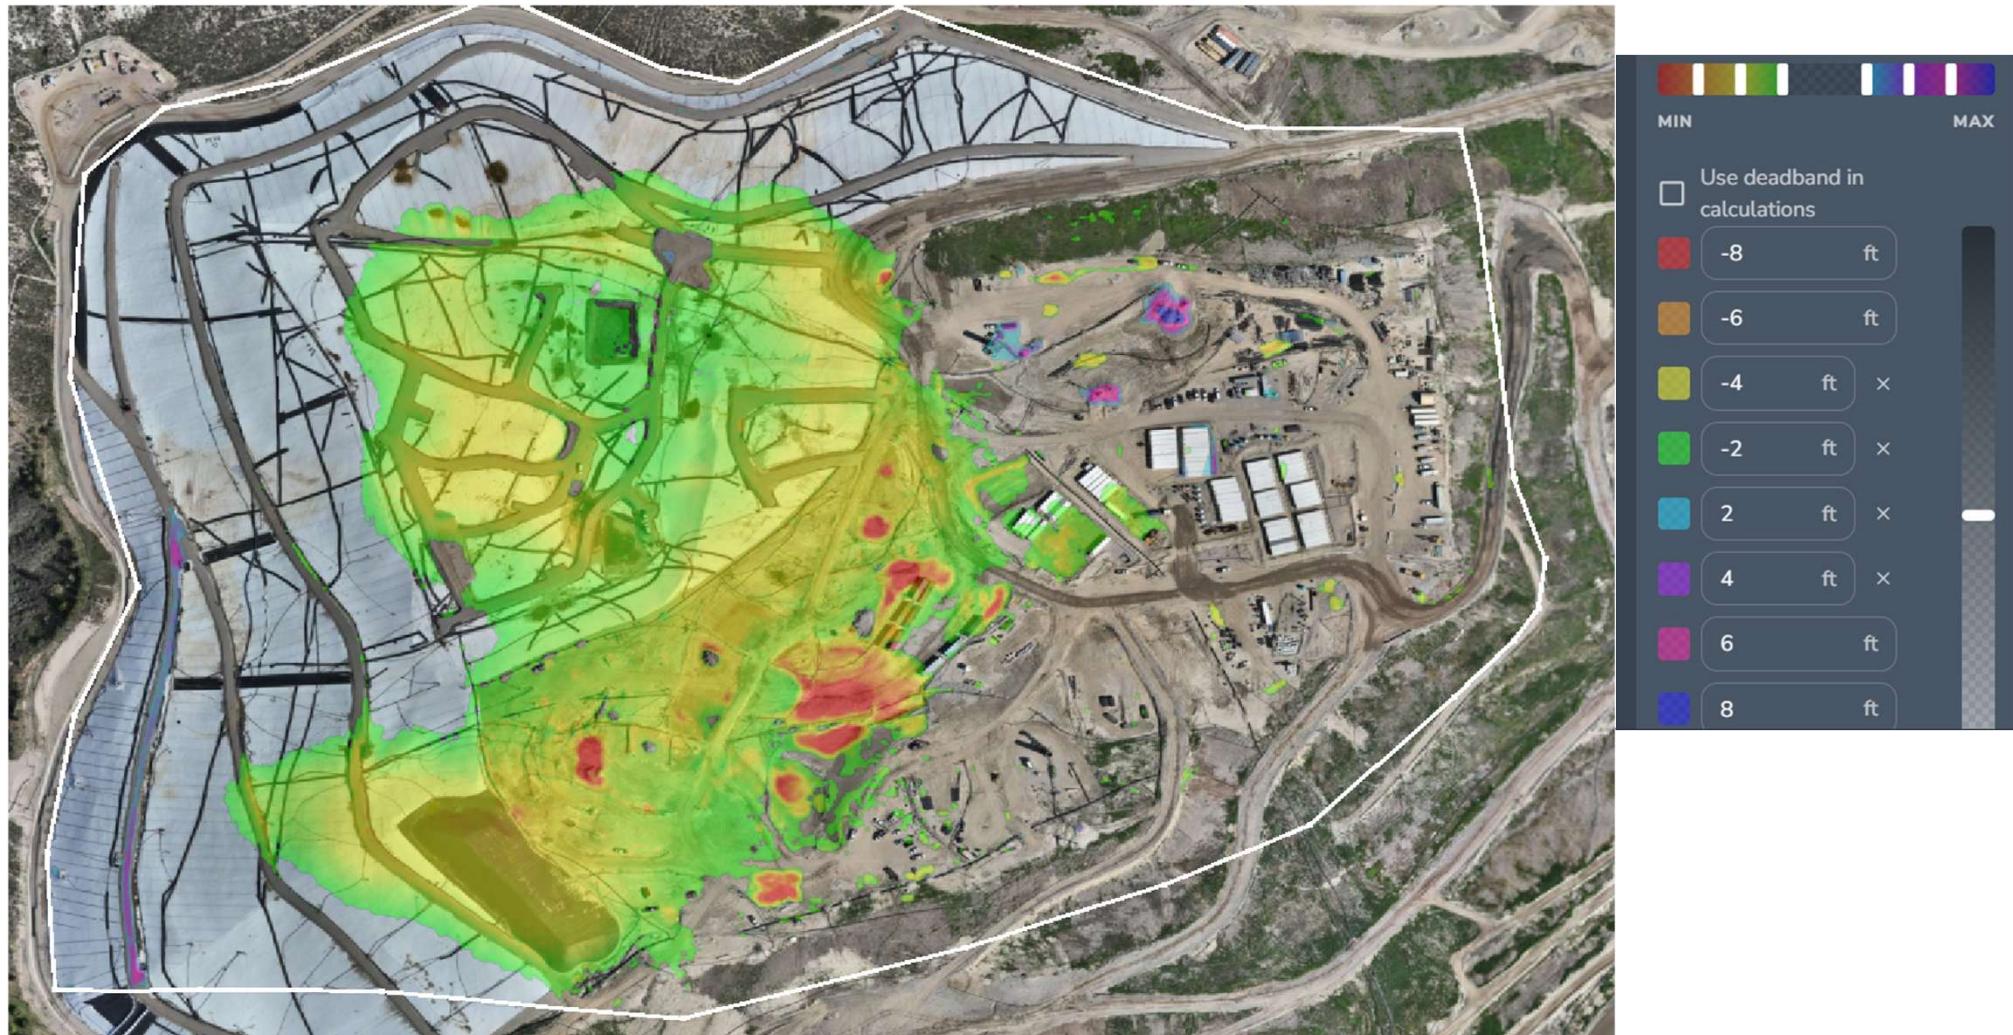

April 2, 2025 Survey Image. January 3, 2025 vs April 2, 2025