

**Archivado:** Viernes 18 de abril de 2025 10:16:13 AM

**De:** [Medina, Steven](#)

**Enviado:** Viernes 11 de abril de 2025 10:00:00 AM

**Para:** [bchen@aqmd.gov](mailto:bchen@aqmd.gov) [ndickel@aqmd.gov](mailto:ndickel@aqmd.gov) [Christina Ojeda](#)

**Cc:** [Han, Jessie](#) [Haley, William \(Bill\)](#) [Amanda Froman](#) [Kelly Kincella](#) [Steve Cassulo](#) [Nicole Ward](#) [Viswanathan, Srividhya Jones, Art](#) [kate.logan@wasteconnections.com](mailto:kate.logan@wasteconnections.com)

**Asunto:** Ref.: Orden de Depuración Estipulada del Caso No. 6177-4 - Actualización sobre la Perforación del Pozo

**Importancia:** Normal

**Sensibilidad:** Ninguna

**Adjunto:**

[Outlook-fdqfclry.png](#); [Outlook-r0vhbgs4.png](#); [Outlook-s2q2drr0.png](#); [Outlook-4kwivhay.png](#); [Outlook-msz1rprn.png](#); [Outlook-snn2unzq.png](#); [Outlook-ftoyy3wu.png](#); [Outlook-k2bojgrm.png](#); [2025 CCLF GCCS Expan Master Plan\\_Proposed LFG Extraction Well and Temp Probe Map\\_2025-04-11.pdf](#);

---

[REMITENTE EXTERNO: Tenga precaución con los enlaces/adjuntos]

---

Todos,

Según la Condición 15(c) de la Orden Estipulada, a continuación se encuentra el resumen actualizado de la construcción para el Proyecto del Plan Maestro de Ampliación de GCCS 2024 del Vertedero de Chiquita Canyon.

**Del 07/04/2025 al 11/04/2025, Chiquita completó la instalación de cero (0) pozos de extracción vertical de LFG, como se previó en nuestra actualización del 04 de abril de 2025. La cantidad total de pozos verticales de extracción de LFG instalados desde el 6 de diciembre de 2023 (la fecha de inicio de la Expansión Maestra de GTCCS) hasta hoy continúa siendo de doscientos treinta y cinco (235).**

**Del 07/04/2025 al 11/04/2025, Chiquita completó la instalación de cero (0) sondas de temperatura, como se previó en nuestra actualización del 04 de abril de 2025. La cantidad total de sondas de temperatura instaladas desde el 26 de febrero de 2024 (la fecha de inicio de las instalaciones de sondas de temperatura) hasta hoy continúa siendo de treinta y dos (32).**

**Los pozos y las sondas de temperatura programados para perforación durante la semana del 14/04/2025 al 18/04/2025 son los siguientes (sujeto a cambios):**

**Plataforma 0 (Secuencia):** La plataforma de perforación fue sacada del sitio y ya no está perforando. Los veintitrés (23) pozos propuestos, como se muestra en el mapa adjunto, están previstos para su potencial perforación este año, pero quedarán sujetos a cambios.

**Plataforma de Sondas de Temperatura (Cascade):** La perforación actualmente está en espera, como se previó en nuestra actualización del 04 de abril de 2025. Chiquita está evaluando la instalación de las otras dos sondas de temperatura (TMP-22 y TMP-23).

Atentamente,

**STEVEN** Rubén Medina, **E.I.T.**

Profesional Asociado

**SCS Engineers**

3900 Kilroy Airport Way, Suite 300


Long Beach, CA 90806

858-204-4342 (c)

[5160srm@scsengineers.com](mailto:5160srm@scsengineers.com)

**Dirigidos por el Éxito de los Clientes**

[www.scsengineers.com](http://www.scsengineers.com)

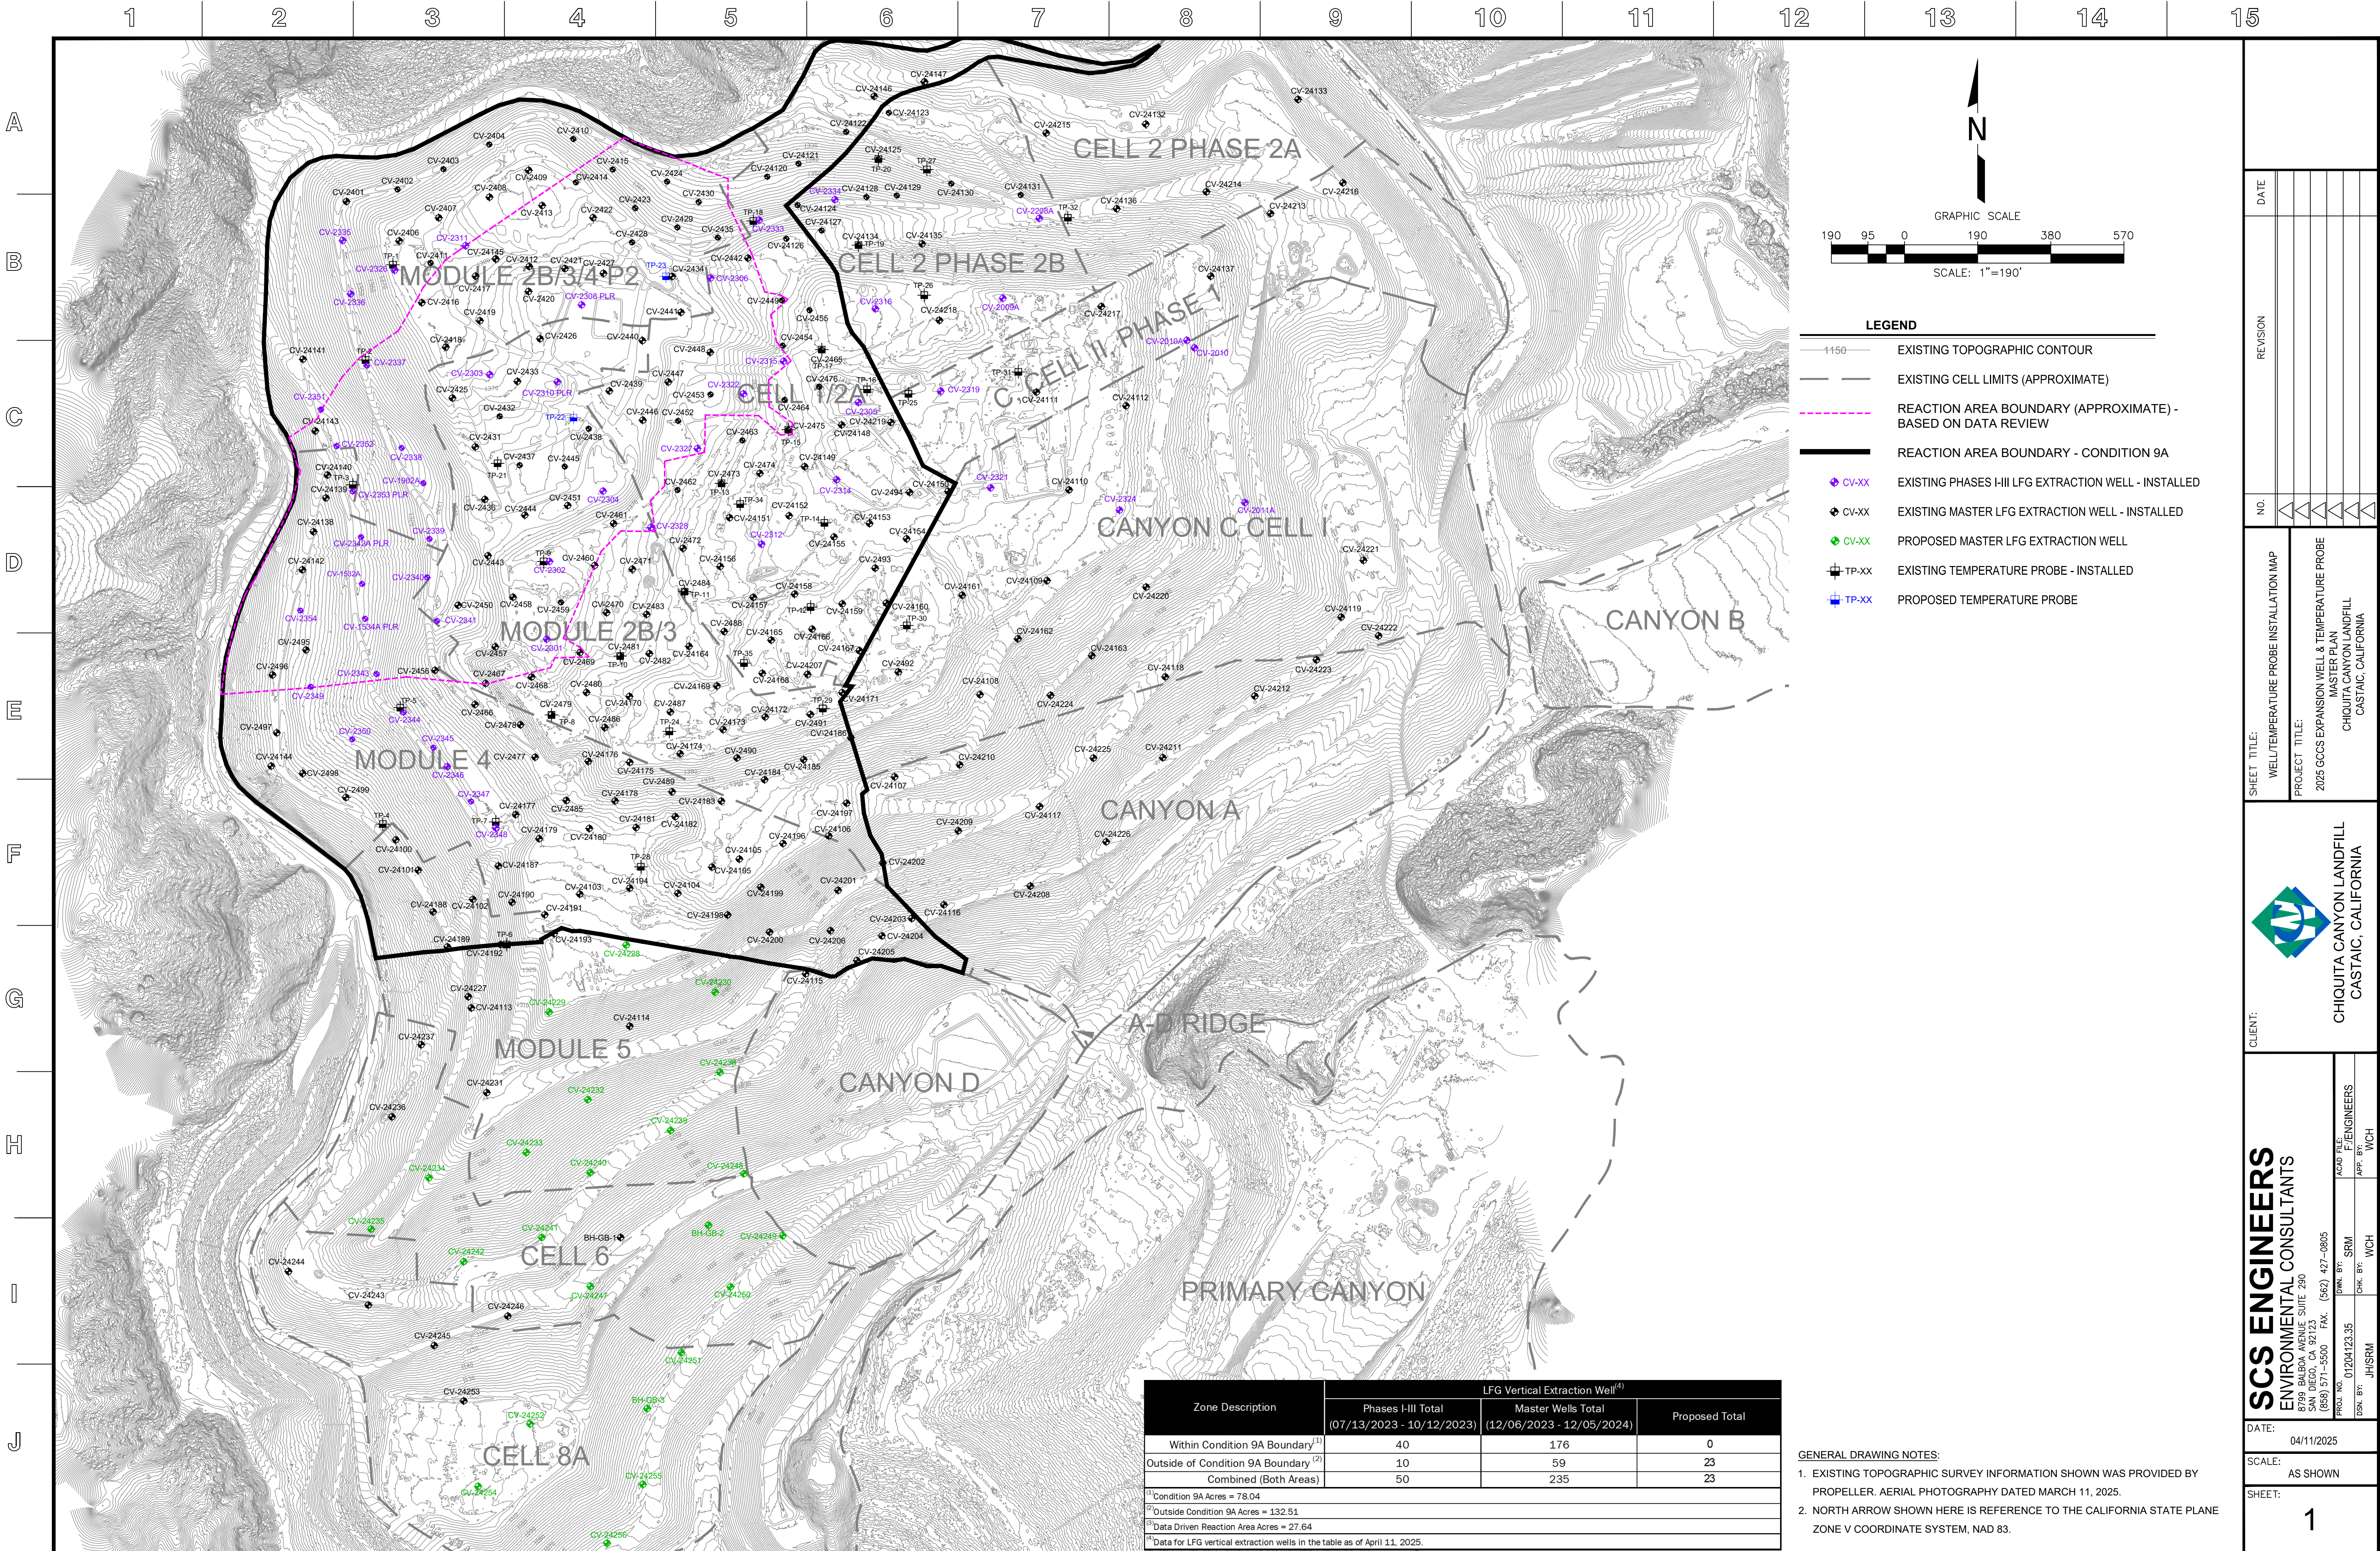

| Zone Description                                | LFG Vertical Extraction Well <sup>(4)</sup>     |                                                 |                       |
|-------------------------------------------------|-------------------------------------------------|-------------------------------------------------|-----------------------|
|                                                 | Phases I-III Total<br>(07/13/2023 - 10/12/2023) | Master Wells Total<br>(12/06/2023 - 12/05/2024) | Proposed Total        |
| Within Condition 9A Boundary <sup>(1)</sup>     | 40                                              | 176                                             | 0                     |
| Outside of Condition 9A Boundary <sup>(2)</sup> | 10                                              | 59                                              | 23                    |
| Combined (Both Areas)                           | 50                                              | 235                                             | 23                    |

<sup>(1)</sup>Condition 9A Acres = 78.04  
<sup>(2)</sup>Outside Condition 9A Acres = 132.51  
<sup>(3)</sup>Data Driven Reaction Area Acres = 27.64  
<sup>(4)</sup>Data for LFG vertical extraction wells in the table as of April 11, 2025.

GENERAL DRAWING NOTES:

1. EXISTING TOPOGRAPHIC SURVEY INFORMATION SHOWN WAS PROVIDED BY PROPELLER. AERIAL PHOTOGRAPHY DATED MARCH 11, 2025.

2. NORTH ARROW SHOWN HERE IS REFERENCE TO THE CALIFORNIA STATE PLANE ZONE V COORDINATE SYSTEM, NAD 83.

DATE

REVISION

NO.

SHEET TITLE:  
WELL/TEMPERATURE PROBE INSTALLATION MAP

PROJECT TITLE:  
2025 GCCS EXPANSION WELL & TEMPERATURE PROBE MASTER PLAN  
CHICUITA CANYON LANDFILL  
CASTAIC, CALIFORNIA

CLIENT:

SCS ENGINEERS  
ENVIRONMENTAL CONSULTANTS  
PROJ. NO. 01204123.35  
DWN. BY: SRM  
CHK. BY: WCH  
JH/SRM

DATE:  
04/11/2025

SCALE:  
AS SHOWN

SHEET:  
1

C:\Users\5160srm\Desktop\2025 CCLF GCCS Expan Master Plan\_Proposed LFG Extraction Well and Temp Probe Map\_2025-04-11.dwg Apr 11, 2025 - 8:50am By: 5160srm