

Archivado: Lunes 30 de junio de 2025 1:11:35 PM
De: [Medina, Steven](#)
Enviado: Viernes 27 de junio de 2025 2:55:33 PM
Para: bchen@aqmd.gov ndickel@aqmd.gov [Christina Ojeda](#)
Cc: [Han, Jessie](#) [Haley, William \(Bill\)](#) [Amanda Froman](#) [Steve Cassulo](#) [Nicole Ward](#) [Viswanathan, Srividhya](#) [Jones, Art](#) kate.logan@wasteconnections.com [Mark.Adams](#) [Haley, William \(Bill\)](#)
Asunto: Ref.: Orden de Depuración Estipulada del Caso No. 6177-4 - Actualización sobre la Perforación del Pozo
Importancia: Normal
Sensibilidad: Ninguna
Adjunto:
[Outlook-fdqfclry.png](#); [Outlook-r0vhbgs4.png](#); [Outlook-s2q2drr0.png](#); [Outlook-4kwivhay.png](#); [Outlook-msz1rprn.png](#);
[Outlook-snn2unzq.png](#); [Outlook-ftoyy3wu.png](#); [Outlook-k2bojgrm.png](#); [Outlook-crz2za3u.png](#); [Outlook-hpwurbl1.png](#);
[Outlook-yf5kn4ns.png](#); [Outlook-ecqir5vy.png](#); [Outlook-y50rjos4.png](#); [Outlook-eee0tdih.png](#); [Outlook-xdhek05a.png](#);
[Outlook-1e4vxasu.png](#); [Outlook-jpjsdf0y.png](#); [Outlook-sqhmxxrf.png](#); 2025 CCLF GCCS Expan Master Plan_Proposed LFG
Extraction Well and Temp Probe Map_2025-06-26.pdf;

[REMITENTE EXTERNO: Tenga precaución con los enlaces/adjuntos]

Todos,

Según la Condición 15(c) de la Orden Estipulada, a continuación, se encuentra el resumen actualizado de la construcción para el Proyecto del Plan Maestro de Ampliación de GCCS 2024 del Vertedero de Chiquita Canyon.

Desde el 23/06/2025 hasta el 27/06/2025 - Instalación de pozos verticales de extracción de LFG y sondas de temperatura incluidos:

- 1. TP-36
- 2. CV-2543
- 3. CV-2545
- 4. CV-2553
- 5. CV-2554

Del 23/06/2025 al 27/06/2025, Chiquita completó la instalación de cuatro (4) pozos de extracción vertical de LFG. La cantidad total de pozos verticales de extracción de LFG instalados desde el 6 de diciembre de 2023 (la fecha de inicio de la Expansión Maestra de GTCCS) hasta hoy es de doscientos cincuenta y cuatro (254).

Del 23/06/2025 al 27/06/2025, Chiquita completó la instalación de una (1) sonda de temperatura. La cantidad total de sondas de temperatura instaladas desde el 26 de febrero de 2024 Tres: (la fecha de inicio de las instalaciones de sondas de temperatura) hasta hoy es de treinta y tres (33).

Los pozos y las sondas de temperatura programados para perforación durante la semana del 30/06/2025 al 04/07/2025 son los siguientes (sujeto a cambios):

Plataforma (Secuencia): Debido a la necesidad de más partes de cabezales de pozos inoxidable, además del próximo feriado, el grupo de trabajo de la perforación estará en tiempo libre con goce de sueldo (PTO) y no hay perforaciones programadas para esta semana.

Plataforma de Sondas de Temperatura (Cascade): TP-37

STEVEN Rubén Medina, **E.I.T.**

Personal Profesional

SCS Engineers

3900 Kilroy Airport Way, Suite 300

Long Beach, CA 90806



858-204-4342 (c)

SMedina@scsengineers.com

Dirigidos por el Éxito de los Clientes

www.scsengineers.com



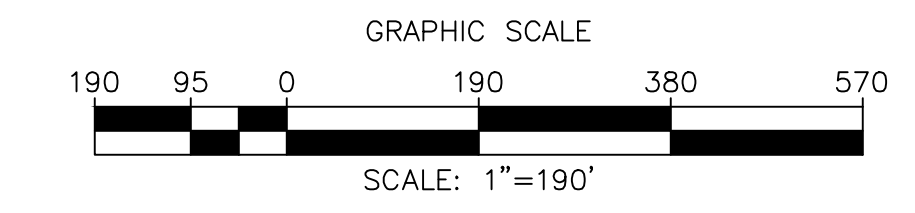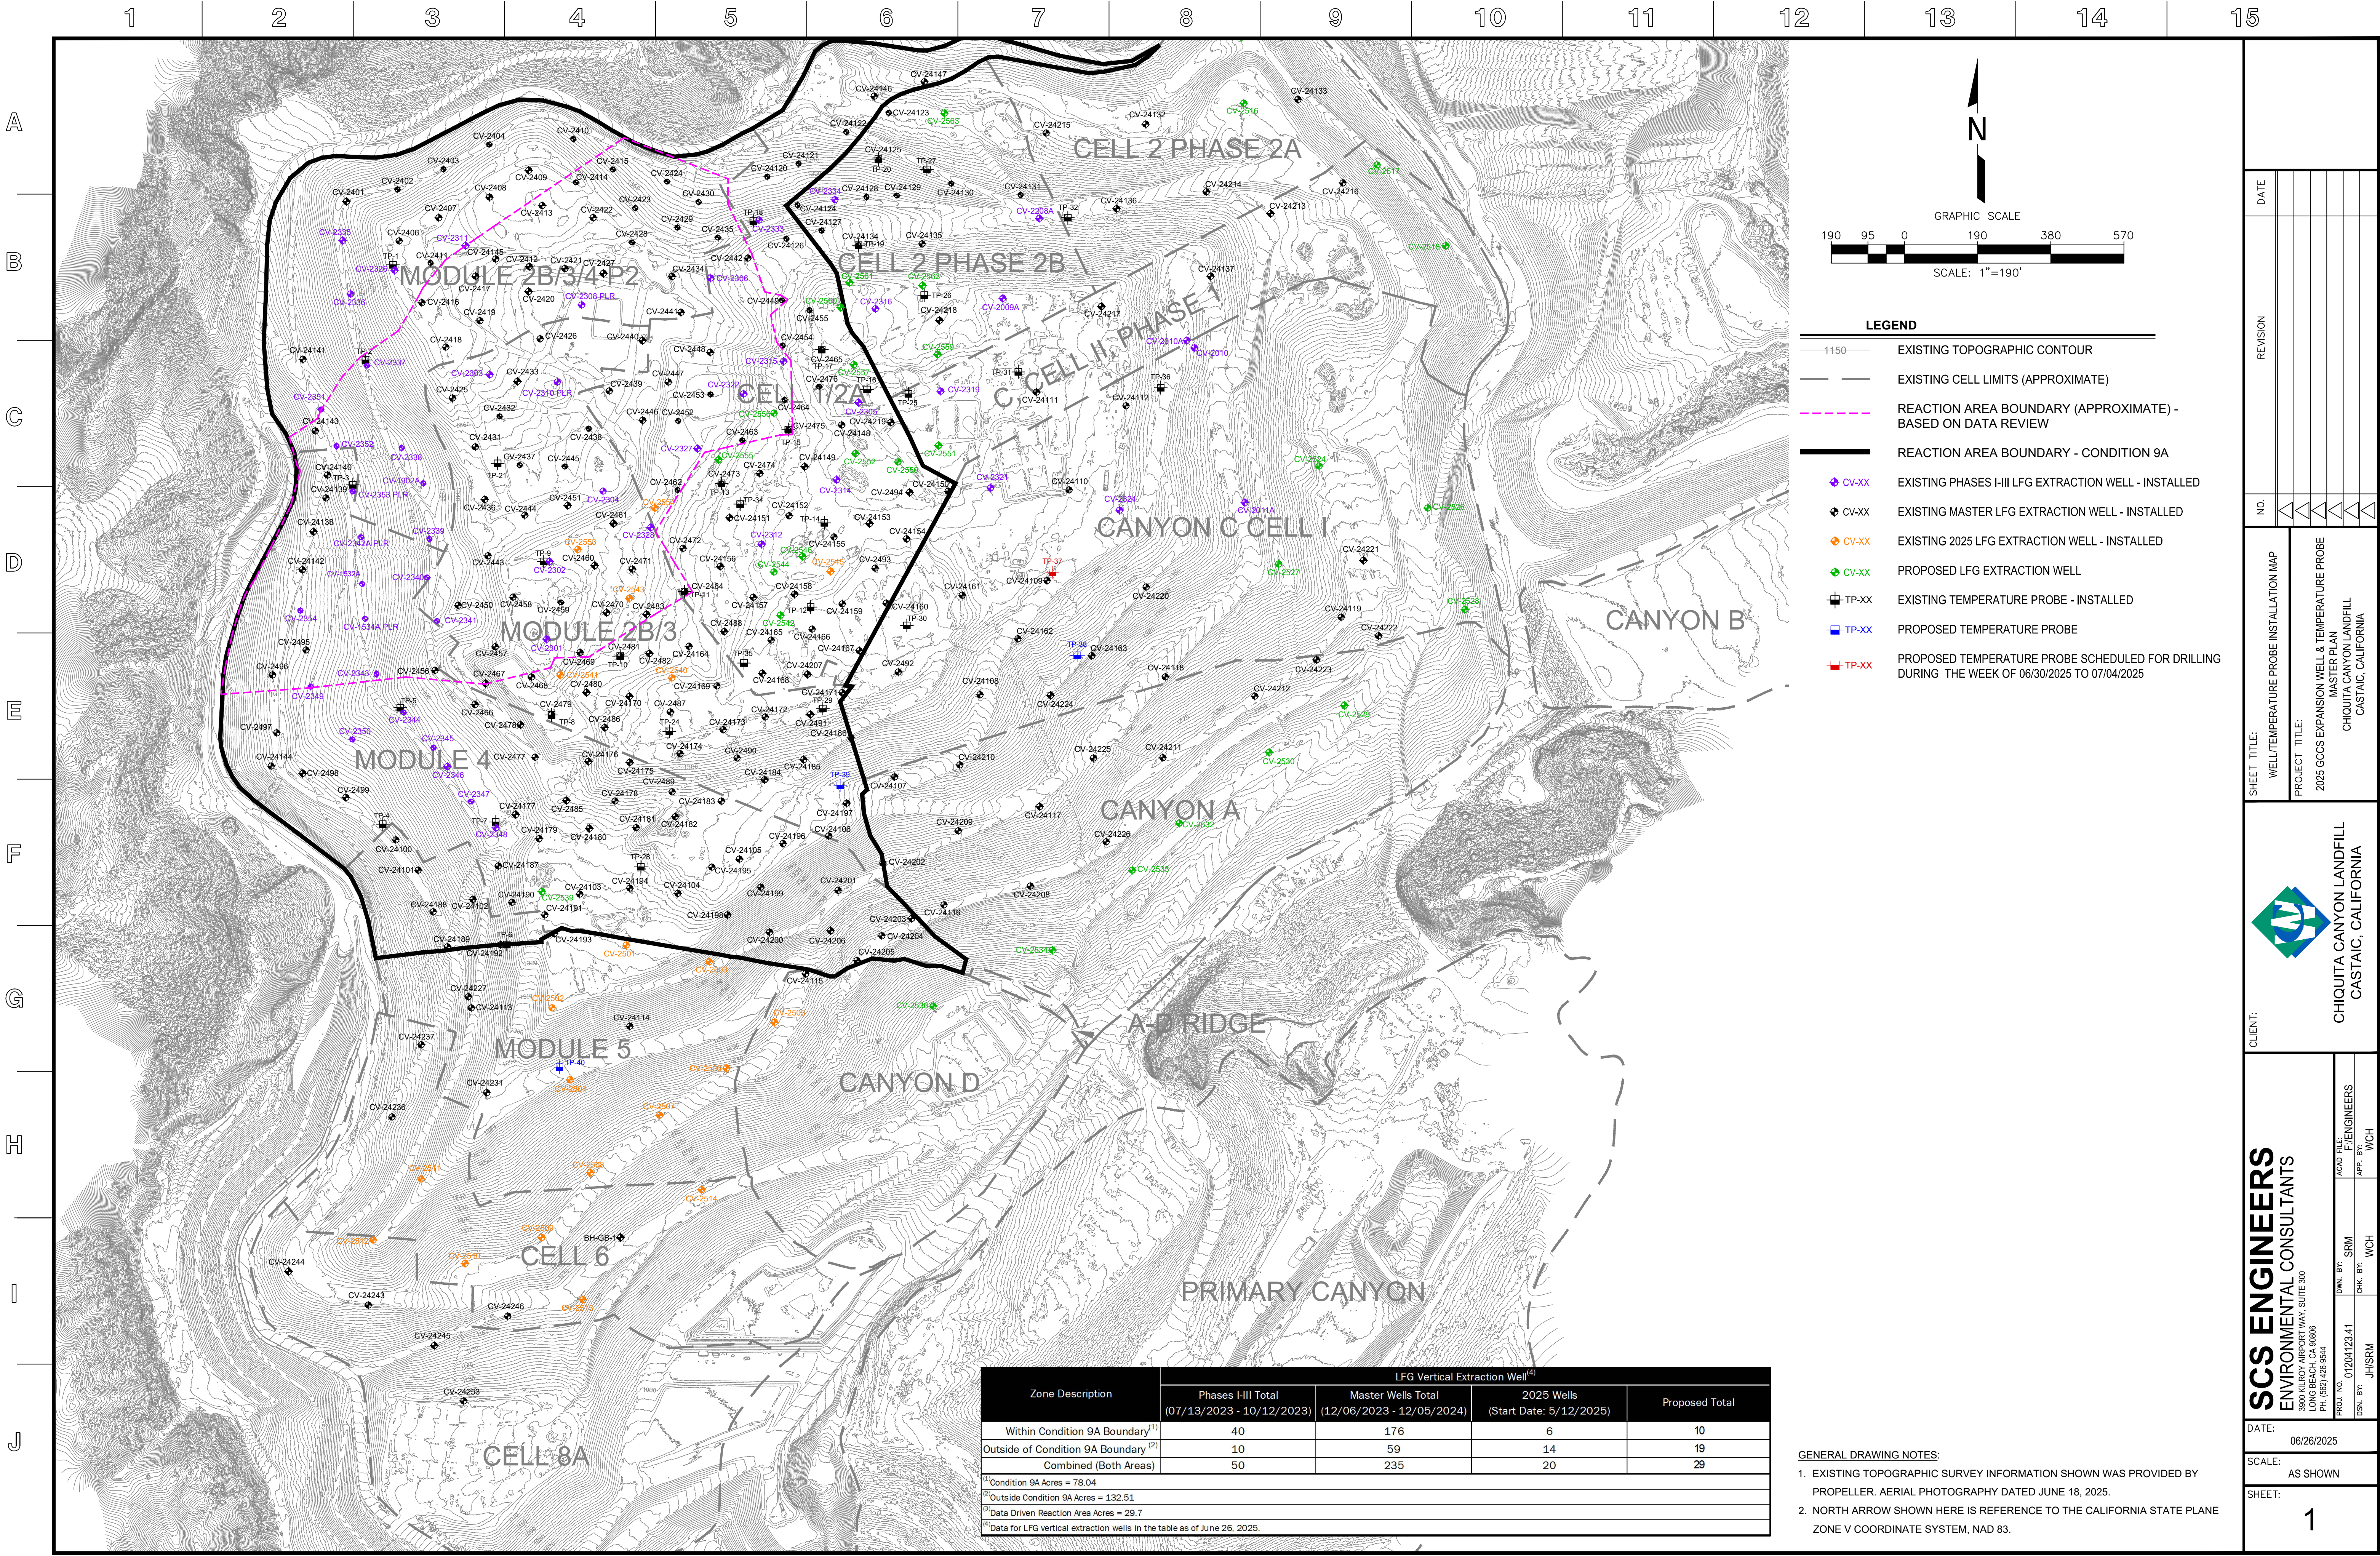

- LEGEND**
- 1150 ——— EXISTING TOPOGRAPHIC CONTOUR
 - EXISTING CELL LIMITS (APPROXIMATE)
 - - - - - REACTION AREA BOUNDARY (APPROXIMATE) - BASED ON DATA REVIEW
 - REACTION AREA BOUNDARY - CONDITION 9A
 - CV-XX (purple circle with cross) EXISTING PHASES I-III LFG EXTRACTION WELL - INSTALLED
 - CV-XX (black circle with cross) EXISTING MASTER LFG EXTRACTION WELL - INSTALLED
 - CV-XX (orange circle with cross) EXISTING 2025 LFG EXTRACTION WELL - INSTALLED
 - CV-XX (green circle with cross) PROPOSED LFG EXTRACTION WELL
 - TP-XX (black square with cross) EXISTING TEMPERATURE PROBE - INSTALLED
 - TP-XX (blue square with cross) PROPOSED TEMPERATURE PROBE
 - TP-XX (red square with cross) PROPOSED TEMPERATURE PROBE SCHEDULED FOR DRILLING DURING THE WEEK OF 06/30/2025 TO 07/04/2025

Zone Description	LFG Vertical Extraction Well ⁽⁴⁾			
	Phases I-III Total (07/13/2023 - 10/12/2023)	Master Wells Total (12/06/2023 - 12/05/2024)	2025 Wells (Start Date: 5/12/2025)	Proposed Total
Within Condition 9A Boundary ⁽¹⁾	40	176	6	10
Outside of Condition 9A Boundary ⁽²⁾	10	59	14	19
Combined (Both Areas)	50	235	20	29

⁽¹⁾ Condition 9A Acres = 78.04
⁽²⁾ Outside Condition 9A Acres = 132.51
⁽³⁾ Data Driven Reaction Area Acres = 29.7
⁽⁴⁾ Data for LFG vertical extraction wells in the table as of June 26, 2025.

GENERAL DRAWING NOTES:

- EXISTING TOPOGRAPHIC SURVEY INFORMATION SHOWN WAS PROVIDED BY PROPELLER. AERIAL PHOTOGRAPHY DATED JUNE 18, 2025.
- NORTH ARROW SHOWN HERE IS REFERENCE TO THE CALIFORNIA STATE PLANE ZONE V COORDINATE SYSTEM, NAD 83.

DATE	
REVISION	
NO.	
SHEET TITLE:	WELL/TEMPERATURE PROBE INSTALLATION MAP
PROJECT TITLE:	2025 GCCS EXPANSION WELL & TEMPERATURE PROBE MASTER PLAN CHIQUITA CANYON LANDFILL CASTAIC, CALIFORNIA
CLIENT:	CHIQUITA CANYON LANDFILL CASTAIC, CALIFORNIA
SCS ENGINEERS ENVIRONMENTAL CONSULTANTS 1800 N. MAIN STREET, SUITE 300 LONG BEACH, CA 90806 PH: (562) 426-9544	ACADE FILE: SRM APP. BY: WCH CHK. BY: WCH JH/SRM
DATE:	06/26/2025
SCALE:	AS SHOWN
SHEET:	1