



CHIQUITA CANYON
A Waste Connections Company

July 29, 2025

Via E-Mail

Karen Gork
Chief Environmental Health Specialist
Los Angeles County Department of Public Health
Local Enforcement Agency
Environmental Programs Division
5050 Commerce Drive,
Baldwin Park, California 91706
KGork@ph.lacounty.gov

Re: Chiquita Canyon, LLC's Weekly Report on the Documentation and Tracking of Cover Issues

Dear Ms. Gork:

In accordance with the Local Enforcement Agency's ("LEA") May 2, 2024 letter approving Chiquita's April 16, 2024 Second Revised Written Plan for Documenting and Tracking Cover Issues ("Second Revised Written Plan"), the LEA's May 29, 2024 letter, and the LEA's June 6, 2024 Compliance Order, Chiquita presents the enclosed report for documenting and tracking cover issues for the week of July 21, 2025 to July 26, 2025.

Please contact me if you have any questions regarding this matter.

Regards,

Amanda Froman
Compliance Manager
Chiquita Canyon, LLC

Attachment: July 29, 2025 Weekly Cover Issues Report

cc: Mark Como, Department of Public Health
Eric Morofuji, Department of Public Health

Fissures and Tension Cracks

4050 - Chiquita Reaction Area Tracking of Fissures and Tension Cracks

21 Jul 2025 / Tom Roe

Complete

Conducted on

21 Jul 2025 9:07 AM PDT

Prepared by

Tom Roe

Chiquita Reaction Area Tracking of Fissures and Tension Cracks

Chiquita Reaction Area Tracking of Fissures and Tension Cracks

Chiquita Reaction Area Tracking of Fissures and Tension Cracks
1

Fissure or Tension Crack Found?

Yes

Using the attached image, annotate all areas where inspectors identified a fissure or tension crack.



Grid Location

147

Date and Time Found

21 Jul 2025 9:14 AM PDT

Image of Fissure/Tension Crack



Photo 1



Photo 2



Photo 3

Length of crack (ft) or area containing multiple cracks (ft x ft)

30ft x 3ft

Horizontal Offset (width)

Large >4" in width

Vertical Offset (height)

Large >4" in height

Orientation (direction)

NW to SE

Location

Castaic CA 91384
United States
(34.435573306765846,
-118.6469194841398)

Was Fissure or Crack fixed? If yes, add photo and description of repairs performed

Yes



Photo 4

Date and time of repairs

21 Jul 2025 10:30 AM PDT

Description of repairs

Other (please describe)

Area was filled with dirt, compacted and track walked.


Chiquita Reaction Area Tracking of Fissures and Tension Cracks

2

Fissure or Tension Crack Found?

Yes

Using the attached image, annotate all areas where inspectors identified a fissure or tension crack.

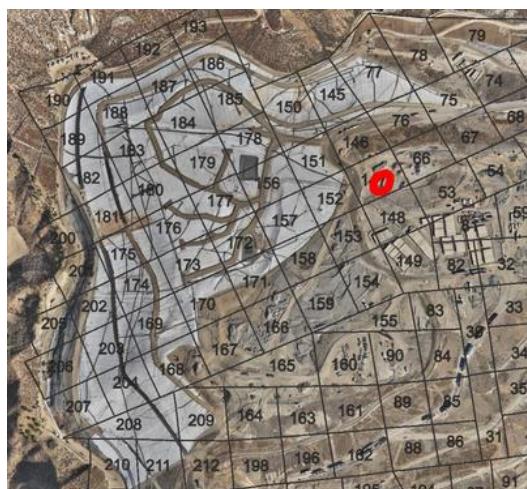

Grid Location

147

Date and Time Found

21 Jul 2025 9:17 AM PDT

Image of Fissure/Tension Crack



Photo 5



Photo 6



Photo 7



Photo 8



Photo 9

Length of crack (ft) or area containing multiple cracks (ft x ft)

25ft x 40ft

Horizontal Offset (width)

Medium 2-4" in width

Vertical Offset (height)

Small 0.5-2" in height

Orientation (direction)

NW to SE

Location

Castaic CA 91384
United States
(34.43572370804336,
-118.64672703679524)

Was Fissure or Crack fixed? If yes, add photo and description of repairs performed

Yes



Photo 10

Date and time of repairs

21 Jul 2025 9:34 AM PDT

Description of repairs


Cracks were track walked.

Chiquita Reaction Area Tracking of Fissures and Tension Cracks
3

Fissure or Tension Crack Found?

Yes

Using the attached image, annotate all areas where inspectors identified a fissure or tension crack.

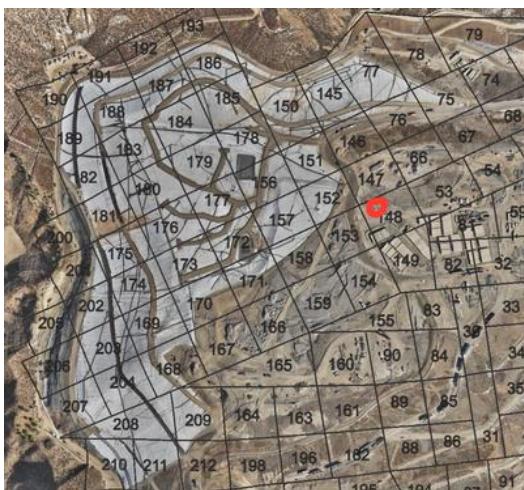

Grid Location

148

Date and Time Found

21 Jul 2025 9:21 AM PDT

Image of Fissure/Tension Crack

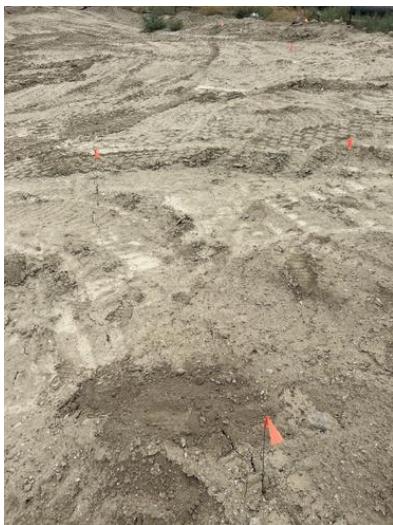


Photo 11



Photo 12



Photo 13



Photo 14



Photo 15

Length of crack (ft) or area containing multiple cracks (ft x ft)

40ft x 10ft

Horizontal Offset (width)

Small 0.5-2" in width

Vertical Offset (height)	Extra small <0.5" in height
Orientation (direction)	NW to SE
Location	Castaic CA 91384 United States (34.435416665305205, -118.64633611529703)
Was Fissure or Crack fixed? If yes, add photo and description of repairs performed	Yes



Photo 16

Date and time of repairs	21 Jul 2025 9:54 AM PDT
Description of repairs	Cracks were track walked.
Instability	
Are there any indications of slope stability concerns?	No

4050 - Chiquita Reaction Area Tracking of Fissures and Tension Cracks

22 Jul 2025 / Tom Roe

Complete

Conducted on

22 Jul 2025 10:23 AM PDT

Prepared by

Tom Roe

Chiquita Reaction Area Tracking of Fissures and Tension Cracks

Chiquita Reaction Area Tracking of Fissures and Tension Cracks

Chiquita Reaction Area Tracking of Fissures and Tension Cracks
1

Fissure or Tension Crack Found?

Yes

Using the attached image, annotate all areas where inspectors identified a fissure or tension crack.



Grid Location

146

Date and Time Found

22 Jul 2025 10:34 AM PDT

Image of Fissure/Tension Crack



Photo 1



Photo 2



Photo 3



Photo 4



Photo 5

Length of crack (ft) or area containing multiple cracks (ft x ft)

15ft x 25ft

Horizontal Offset (width)

Medium 2-4" in width

Vertical Offset (height)

Small 0.5-2" in height

Orientation (direction)

NW to SE

Location

(34.436033563899734,
-118.6471332337888)

Was Fissure or Crack fixed? If yes, add photo and description of repairs performed

Yes



Photo 6

Date and time of repairs

22 Jul 2025 12:05 PM PDT

Description of repairs

Cracks were track walked.

Chiquita Reaction Area Tracking of Fissures and Tension Cracks
2

Fissure or Tension Crack Found?

Yes

Using the attached image, annotate all areas where inspectors identified a fissure or tension crack.



Grid Location

148

Date and Time Found

22 Jul 2025 10:46 AM PDT

Image of Fissure/Tension Crack



Photo 7



Photo 8



Photo 9

Length of crack (ft) or area containing multiple cracks (ft x ft)

5ft x 10ft

Horizontal Offset (width)

Small 0.5-2" in width

Vertical Offset (height)

Extra small <0.5" in height

Orientation (direction)

NW to SE

Location

Castaic CA 91384
United States
(34.43529543470073,
-118.64653777342163)

Was Fissure or Crack fixed? If yes, add photo and description of repairs performed

Yes



Photo 10

Date and time of repairs

22 Jul 2025 12:29 PM PDT

Description of repairs


Cracks were track walked.

Chiquita Reaction Area Tracking of Fissures and Tension Cracks
3

Fissure or Tension Crack Found?

Yes

Using the attached image, annotate all areas where inspectors identified a fissure or tension crack.

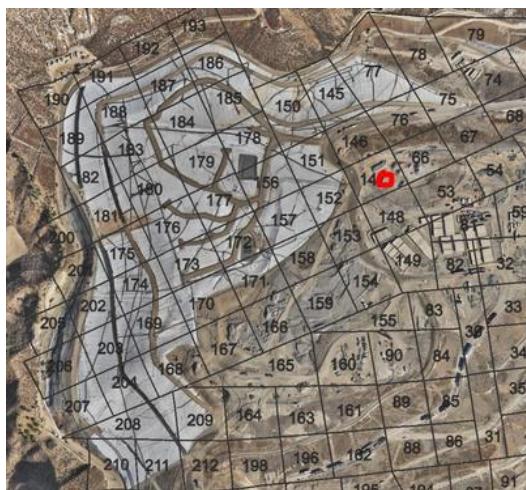

Grid Location

147

Date and Time Found

22 Jul 2025 10:57 AM PDT

Image of Fissure/Tension Crack



Photo 11



Photo 12

Length of crack (ft) or area containing multiple cracks (ft x ft)

35ft

Horizontal Offset (width)

Medium 2-4" in width

Vertical Offset (height)

Small 0.5-2" in height

Orientation (direction)

NW to SE

Location

Castaic CA 91384
United States
(34.43576469554988,
-118.64649770792447)

Was Fissure or Crack fixed? If yes, add photo and description of repairs performed

Yes



Photo 13

Date and time of repairs

22 Jul 2025 12:20 PM PDT

Description of repairs

Other (please describe)


Dirt was added and compacted.

Chiquita Reaction Area Tracking of Fissures and Tension Cracks
4

Fissure or Tension Crack Found?

Yes

Using the attached image, annotate all areas where inspectors identified a fissure or tension crack.

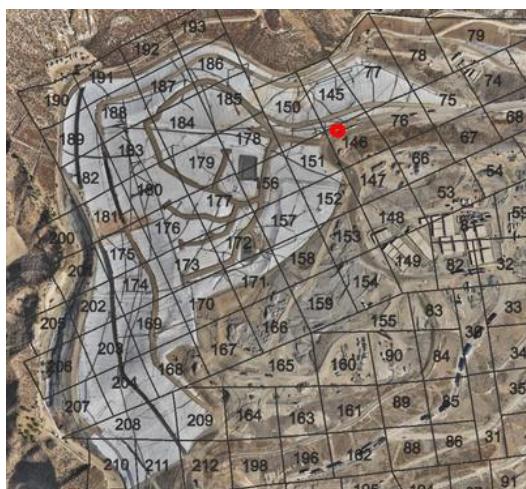

Grid Location

146

Date and Time Found

22 Jul 2025 11:34 AM PDT

Image of Fissure/Tension Crack



Photo 14



Photo 15

Length of crack (ft) or area containing multiple cracks (ft x ft)

10ft x 4ft

Horizontal Offset (width)

Small 0.5-2" in width

Vertical Offset (height)	Extra small <0.5" in height
Orientation (direction)	NW to SE
Location	Castaic CA 91384 United States (34.43647688490362, -118.64706340829491)
Was Fissure or Crack fixed? If yes, add photo and description of repairs performed	Yes
	
Photo 16	
Date and time of repairs	22 Jul 2025 12:15 PM PDT
Description of repairs	Other (please describe)
Dirt was added to area and compacted.	
Instability	
Are there any indications of slope stability concerns?	No

4050 - Chiquita Reaction Area Tracking of Fissures and Tension Cracks

23 Jul 2025 / Tom Roe

Complete

Conducted on

23 Jul 2025 8:51 AM PDT

Prepared by

Tom Roe

Chiquita Reaction Area Tracking of Fissures and Tension Cracks

Chiquita Reaction Area Tracking of Fissures and Tension Cracks

Chiquita Reaction Area Tracking of Fissures and Tension Cracks
1

Fissure or Tension Crack Found?

No

Grid 147



Photo 1

Instability

Are there any indications of slope stability concerns?

No

4050 - Chiquita Reaction Area Tracking of Fissures and Tension Cracks

24 Jul 2025 / John Boucher

Complete

Conducted on

24 Jul 2025 10:33 AM PDT

Prepared by

John Boucher

Chiquita Reaction Area Tracking of Fissures and Tension Cracks

Chiquita Reaction Area Tracking of Fissures and Tension Cracks

Chiquita Reaction Area Tracking of Fissures and Tension Cracks

Fissure or Tension Crack Found?

Yes

Using the attached image, annotate all areas where inspectors identified a fissure or tension crack.



Grid Location

147

Date and Time Found

24 Jul 2025 11:39 AM PDT

Image of Fissure/Tension Crack



Photo 1

Length of crack (ft) or area containing multiple cracks (ft x ft)

2ft

Horizontal Offset (width)	Extra Small <0.5 in width
Vertical Offset (height)	Extra small <0.5" in height
Orientation (direction)	N to S

Location Castaic CA 91384
United States
(34.43571079991239,
-118.64611892972015)

Was Fissure or Crack fixed? If yes, add photo and description of repairs performed

Yes



Photo 2

Date and time of repairs

24 Jul 2025 12:55 PM PDT

Description of repairs

Other (please describe)

Cracks were filled and compacted with fresh dirt by hand

Instability

Are there any indications of slope stability concerns?

No

4050 - Chiquita Reaction Area Tracking of Fissures and Tension Cracks

25 Jul 2025 / John Boucher

Complete

Conducted on

25 Jul 2025 2:32 PM PDT

Prepared by

John Boucher

Chiquita Reaction Area Tracking of Fissures and Tension Cracks

Chiquita Reaction Area Tracking of Fissures and Tension Cracks

Chiquita Reaction Area Tracking of Fissures and Tension Cracks
1

Fissure or Tension Crack Found?

No

Grid 159



Photo 1

Instability

Are there any indications of slope stability concerns?

No

4050 - Chiquita Reaction Area Tracking of Fissures and Tension Cracks

26 Jul 2025 / John Boucher

Complete

Conducted on

26 Jul 2025 10:09 AM PDT

Prepared by

John Boucher

Chiquita Reaction Area Tracking of Fissures and Tension Cracks

Chiquita Reaction Area Tracking of Fissures and Tension Cracks

Chiquita Reaction Area Tracking of Fissures and Tension Cracks
1

Fissure or Tension Crack Found?

No

Grid 160



Photo 1

Instability

Are there any indications of slope stability concerns?

No

Settlement

The bi-weekly drone flyover was not conducted this week. The drone data from the next flyover event will be included in the next weekly report.

Geosynthetic Cover

4050 - Geosynthetic Cover Inspection

21 Jul 2025 / Tom Roe

Complete

Flagged items

0

Conducted on

21 Jul 2025 8:12 AM PDT

Prepared by

Tom Roe

Identification of Issues

Identified Issue

Identified Issue 1

Are there any issues with the geosynthetic cover?

No



Photo 1



Photo 2



Photo 3



Photo 4

Instability under the cover

Are there any anomalous (unusual or unexpected) areas of cover damage or deformation that may indicate underlying instability?

No

Are there any signs of a downslope tension crack at the top of the slope or bulging at or near the toe of the slope?

No

Is there any movement of the equipment that vertically penetrates the cover (e.g., tilting)?

No

4050 - Geosynthetic Cover Inspection

22 Jul 2025 / Tom Roe

Complete

Flagged items

0

Conducted on

22 Jul 2025 8:49 AM PDT

Prepared by

Tom Roe

Identification of Issues

Identified Issue

Identified Issue 1

Are there any issues with the geosynthetic cover?

No



Photo 1



Photo 2



Photo 3



Photo 4

Instability under the cover

Are there any anomalous (unusual or unexpected) areas of cover damage or deformation that may indicate underlying instability?

No

Are there any signs of a downslope tension crack at the top of the slope or bulging at or near the toe of the slope?

No

Is there any movement of the equipment that vertically penetrates the cover (e.g., tilting)?

No

4050 - Geosynthetic Cover Inspection

23 Jul 2025 / Tom Roe

Complete

Flagged items

0

Conducted on

23 Jul 2025 10:45 AM PDT

Prepared by

Tom Roe

Identification of Issues

Identified Issue

Identified Issue 1

Are there any issues with the geosynthetic cover?

No



Photo 1



Photo 2



Photo 3



Photo 4

Instability under the cover

Are there any anomalous (unusual or unexpected) areas of cover damage or deformation that may indicate underlying instability?

No

Are there any signs of a downslope tension crack at the top of the slope or bulging at or near the toe of the slope?

No

Is there any movement of the equipment that vertically penetrates the cover (e.g., tilting)?

No

4050 - Geosynthetic Cover Inspection

24 Jul 2025 / John Boucher

Complete

Flagged items

0

Conducted on

24 Jul 2025 11:54 AM PDT

Prepared by

John Boucher

Identification of Issues

Identified Issue

Identified Issue 1

Are there any issues with the geosynthetic cover?

No



Photo 1



Photo 2



Photo 3



Photo 4

Instability under the cover

Are there any anomalous (unusual or unexpected) areas of cover damage or deformation that may indicate underlying instability?

No

Are there any signs of a downslope tension crack at the top of the slope or bulging at or near the toe of the slope?

No

Is there any movement of the equipment that vertically penetrates the cover (e.g., tilting)?

No

4050 - Geosynthetic Cover Inspection

25 Jul 2025 / John Boucher

Complete

Flagged items

0

Conducted on

25 Jul 2025 10:54 AM PDT

Prepared by

John Boucher

Identification of Issues

Identified Issue

Identified Issue 1

Are there any issues with the geosynthetic cover?

No



Photo 1



Photo 2



Photo 3



Photo 4

Instability under the cover

Are there any anomalous (unusual or unexpected) areas of cover damage or deformation that may indicate underlying instability?

No

Are there any signs of a downslope tension crack at the top of the slope or bulging at or near the toe of the slope?

No

Is there any movement of the equipment that vertically penetrates the cover (e.g., tilting)?

No

4050 - Geosynthetic Cover Inspection

26 Jul 2025 / John Boucher

Complete

Flagged items

0

Conducted on

26 Jul 2025 10:31 AM PDT

Prepared by

John Boucher

Identification of Issues

Identified Issue

Identified Issue 1

Are there any issues with the geosynthetic cover?

No



Photo 1



Photo 2



Photo 3



Photo 4

Instability under the cover

Are there any anomalous (unusual or unexpected) areas of cover damage or deformation that may indicate underlying instability?

No

Are there any signs of a downslope tension crack at the top of the slope or bulging at or near the toe of the slope?

No

Is there any movement of the equipment that vertically penetrates the cover (e.g., tilting)?

No