

Archivado: Viernes 8 de agosto de 2025 10:39:34 AM
De: [Kate Logan](#)
Enviado: Sábado 2 de agosto de 2025 1:04:23 PM
Para: KGork@ph.lacounty.gov
sota@ph.lacounty.gov [Thalhamer, Todd@CalRecycle](mailto:Thalhamer,Todd@CalRecycle) khabaradas@ph.lacounty.gov LFrias@ph.lacounty.gov
NQuick@ph.lacounty.gov RRagland@ph.lacounty.gov BMcphillips@counsel.lacounty.gov [Mindermann,](#)
Cc: Wes@CalRecycle mark.debie@calrecycle.ca.gov emorofuji@ph.lacounty.gov Relon.MarkAnthony@epa.gov
Holybee.Tyler@epa.gov Friedli.Laura@epa.gov [John Perkey](#) [Steve Cassulo](#) [Nicole Ward](#) [Dylan Smith](#) [Amanda](#)
[Froman](#) [Dylan Smith](#)
Asunto: Vertedero de Chiquita Canyon - Cubierta Geosintética - Medida de Mitigación 4.1
Importancia: Normal
Sensibilidad: Ninguna
[2025-07-21 EVOH Deployment Records.pdf](#); [4050 2025-07-07 Milestone 2B Chiquita Canyon LF](#)
Adjuntos: [Isopach_June 2025.pdf](#); [2025-07-10 Reaction Committee Determination - Reaction Area Map for June 2025.pdf](#);

[REMITENTE EXTERNO: Tenga precaución con los enlaces/adjuntos]

Todos,

Estoy reenviando con los adjuntos corregidos.

A continuación se encuentra la actualización de Chiquita de la primera semana sobre el estado de la instalación de la cubierta de geomembrana de EVOH de 60-mil en el Vertedero de Chiquita Canyon, conforme a la Medida de Mitigación 4.1 de la Orden de Cumplimiento de la LEA emitida el 1 de mayo de 2025.


El 21 de julio de 2025, D&E desplegó dos paneles de 22.5 pies x 150 pies (6,750 pies cuadrados) de geomembrana de EVOH de 60-mil marrón sobre la cubierta superior del vertedero, en el lugar que se muestra en la Figura 1 adjunta. El envío inicial del fabricante se limitó a un rollo de geomembrana que se utilizó para evaluar la viabilidad de la instalación. Personal de Aseguramiento de la Calidad de la Construcción (CQA) de Geo-Logic Associates (GLA) realizó un monitoreo de tiempo completo durante esta obra de instalación. Se adjuntan los registros de instalación de D&E y el Informe Diario del Campo (DFR) de GLA y los registros de CQA. Chiquita espera recibir otros rollos del fabricante a principios de la semana del 11 de agosto.

La Figura 1 muestra la extensión aproximada de la cubierta de geomembrana instalada al día de hoy, como también la zona de cobertura de geomembrana descrita en el anteproyecto del plan de trabajo para la extensión de la cubierta de geomembrana de fecha 16 de mayo de 2025 presentada a la LEA y al DTSC. Se debe tener en cuenta que Chiquita está evaluando esta área de extensión prevista en respuesta a la correspondencia del 24 de julio de 2025 de la EPA de EE.UU. También se adjunta a esta presentación el mapa isopáquico mensual de junio de 2025 y el mapa de la zona reactiva de junio de 2025 presentado como parte de la determinación mensual del Comité de la Reacción con fecha 10 de julio de 2025. Debido a limitaciones técnicas, actualmente no podemos crear una figura que incluya todos los datos descritos en la sección 4.1 de la Orden de Cumplimiento de la LEA de 2025, pero estamos trabajando activamente en una solución y prevemos tener un mapa optimizado para futuras presentaciones.

Kate Logan
Ingeniera Regional
[Vertedero de Chiquita Canyon](#)
29201 Henry Mayo Dr.

Castaic, CA 91384
(Móvil) (346) 807-5547
Kate.Logan@WasteConnections.com



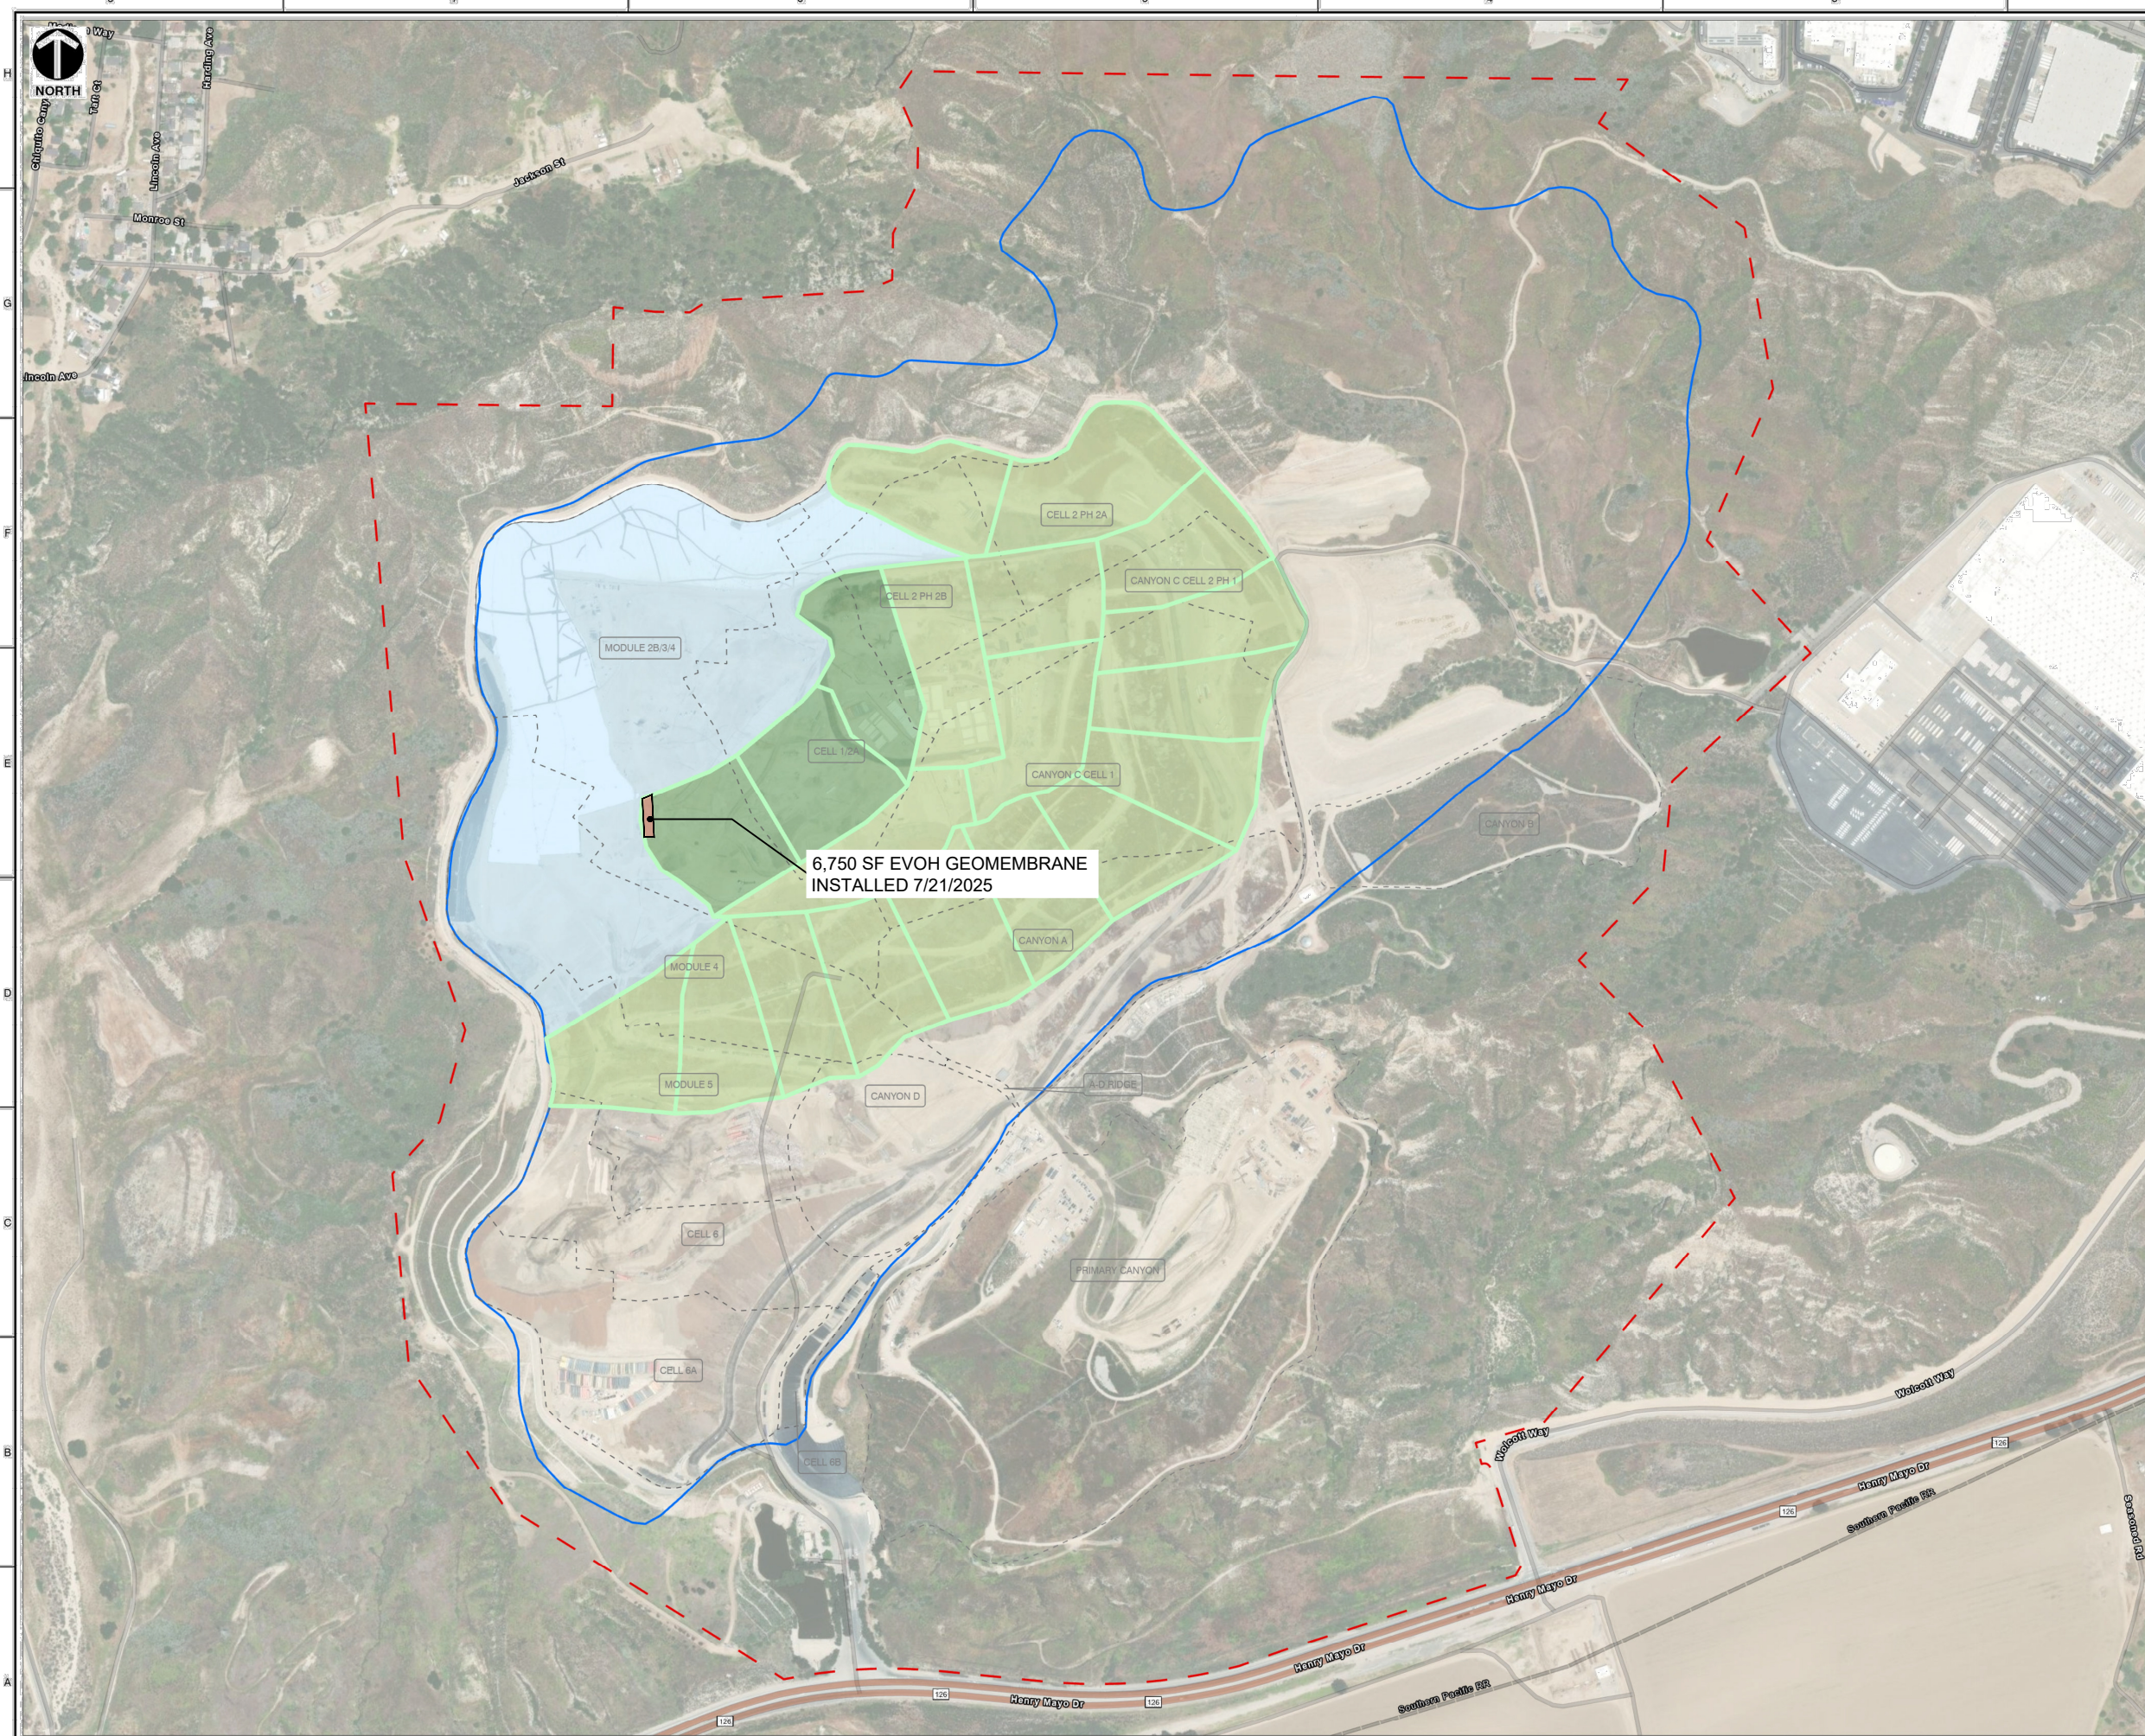

LEGEND

- - - APPROXIMATE PROPERTY BOUNDARY
- REFUSE LIMIT
- - - CELL LIMIT
- EXISTING GEOMEMBRANE DEPLOYMENT AREA
- INITIAL SUPPLEMENTAL GEOMEMBRANE DEPLOYMENT AREA
- SUBSEQUENT SUPPLEMENTAL GEOMEMBRANE DEPLOYMENT AREAS

- NOTES:**
1. EXISTING GEOMEMBRANE DEPLOYMENT AREA IS APPROXIMATELY 48.3 acres.
 2. EXISTING GEOMEMBRANE IS 30-MIL HDPE, EXCEPT FOR 1.3 ACRES OF 40-MIL HDPE.
 3. EACH PROPOSED DEPLOYMENT AREA IS APPROXIMATELY 5 ACRES
 4. NEW GEOMEMBRANE WILL BE 60-MIL HDPE WITH AN INTERNAL CORE EVOH RESIN BARRIER.

SCALE IN FEET

0' 300' 600'

Civil & Environmental Consultants, Inc.

2356 Gold Meadow Way
Suite 120
Gold River, CA 95670
Ph: 916.503.0050 • 800.365.2324
www.cecinc.com

CHIKUITA CANYON LANDFILL



DRAWN BY:	CMM	CHECKED BY:	RVH	APPROVED BY:	RVH
DATE:	4/29/2025	SCALE:	1" = 300'	PROJECT NO.:	350-750

SITE MAP

FIGURE NO. **2A**

SHEET 1 OF 2

C:\Users\jerry\Documents\GIS\Projects\Chiquita Canyon\2A\Map2A.mxd 4/29/2025 1:22 PM (jerry)

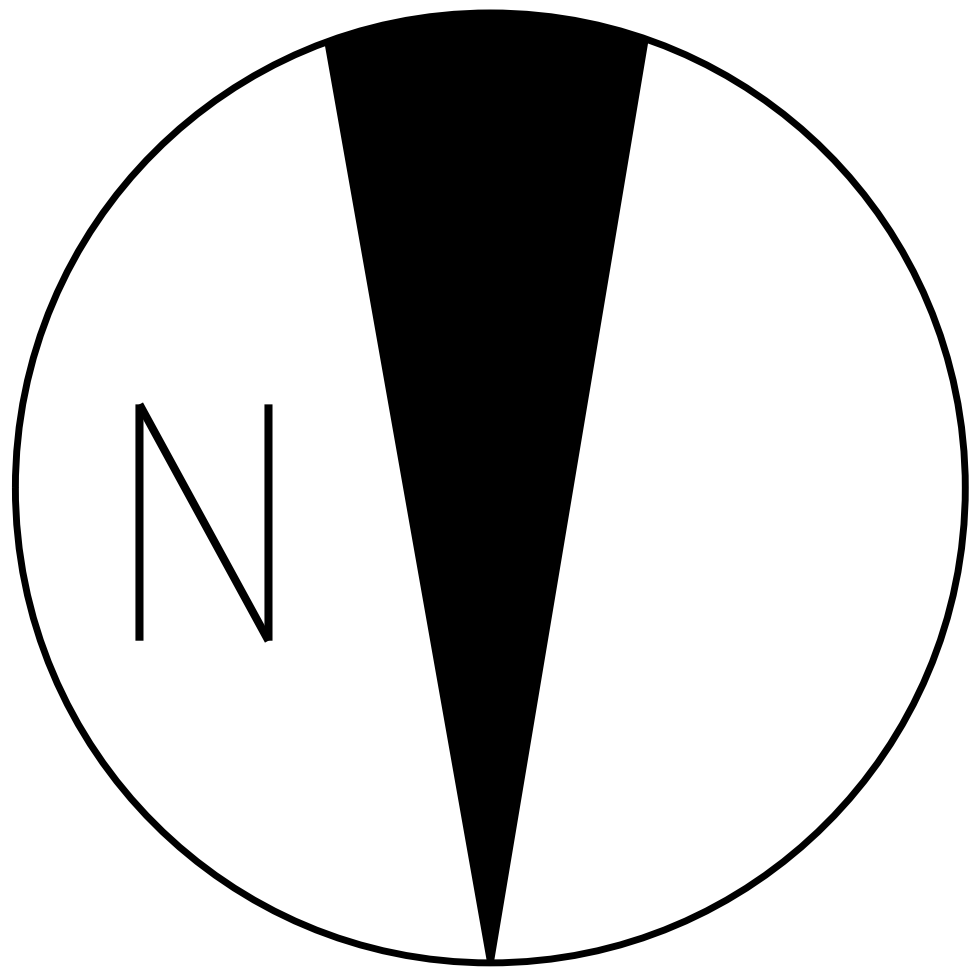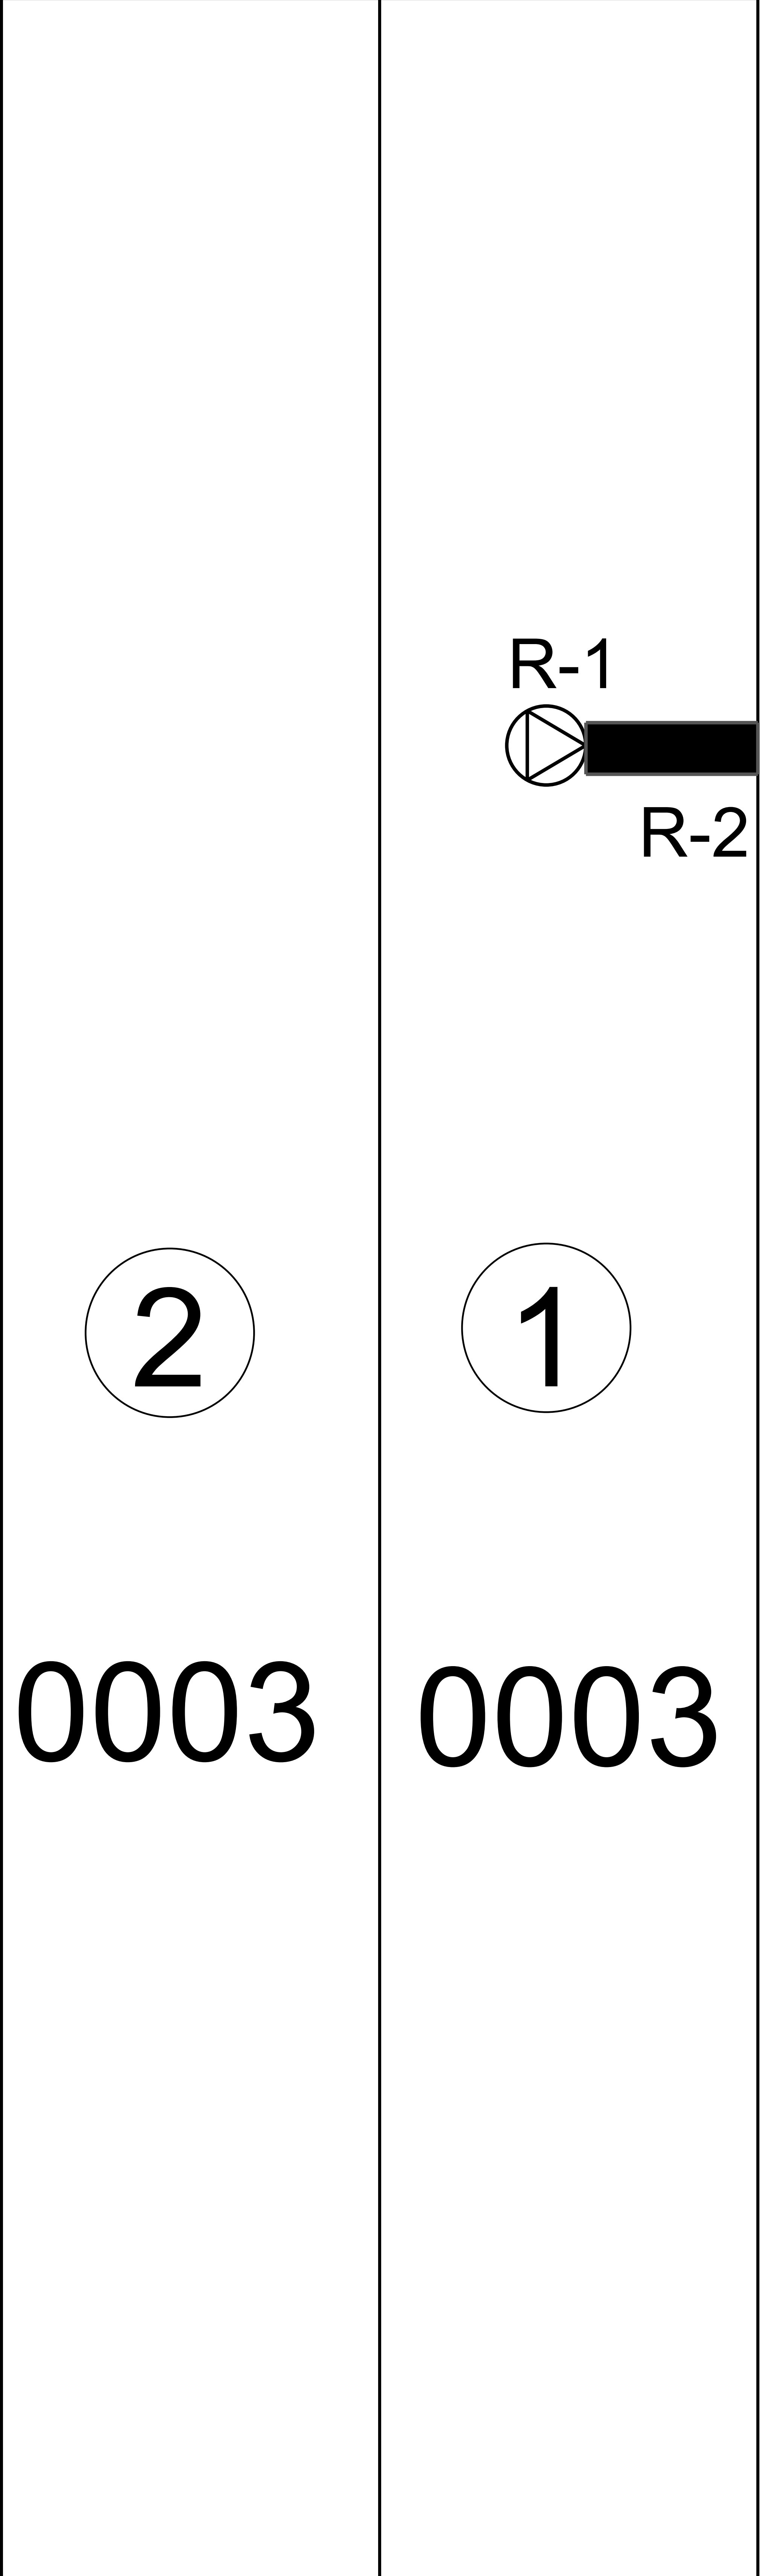


Chiquita canyon

Top deck viaflex

60 mill

Legend

0003	Roll number
1	Panel number
● —	Repair
⊠	Pipe
D&E construction	

 

Project Name:	Chiquita canyon	Top deck
QC Technician:	Jorge Luna	

[illegible]



14175 Avenue 344, Visalia, California 93292 559-732-1601 Fax 559-732-1603

REPAIR LOG

Project Name : Chiquita canyon Page:
 Project Manager : Date: 7/21/2025
 Superintendent : Job#:
 Material Type: 60 mill

Primary [x]

Secondary []

Other:

ASTM - D5641
VT=Vacuum Test

ASTM-D6365
ST=Spark Test

Repair Number	Damage Code	Seam # Or Panel#	Location	Date	Equip #	Operator	Repair Type	Approx. Size	Test Data		
									Test	Results	Date
1	Pipe	P-1	44'noses10'w	7-21-25	Mx98	Jc	P	4x4	Vt	P	7-21-25
2	Ws	P-1-ex	44'noses	7-21-25	Mx98	Jc	P	2x10			
3											
4											
Damage Code:

Repair code:

Bo-Burn out

Cr-Crease

DS #- Destruct Sample

EE- Earthwork Equipament Damage

FM - Fish Mouth

ES- Exposed Scrim

SI-Subgrade Irregularity

RW-Roller Wrinkle in Seam

WR- Wrinkle

WS- Welder Restart

BL-Blister

T-Joint

C-Cap Strip

P-Patch

B-Extrusion Bead

*TOS- Top of Slope

**BOS- Toe of Slope



14175 Avenue 344, Visalia, California 93292 559-732-1601 Fax 559-732-1603

SEAMING & AIR PRESSURE TEST ASTM D5820

Project Name : Chiquita canyon

Material: 60 mill

Project Manager:

Location: Top deck

Job #

Superintendent Dennis kennedy

Primary [x]

Secondary

Other:

Total =

Air test =

PSI for : #

Minutes: 5

Tested by: Marcel

[illegible]



14175 Avenue 344, Visalia, California 93292 559-732-1601 Fax 559-732-1603

SEAMING & AIR PRESSURE TEST ASTM D5820

Project Name : Chiquita canyon

Material: 60 mill

Job #

Project Manager:

Location: Top deck

Superintendent Dennis kennedy

Primary [x]

Secondary

Other:

PSI for : #

Minutes: 5

Tested by: Marcel

Reported By : Jorge Luna

Total =

[illegible]



14175 Avenue 344, Visalia, California 93292 559-732-1601 Fax 559-732-1603

PANEL LOGS

Project Name: CHIQUITA CANYON top deck Deployment Date: Job # Supt: Dennis Kennedy
Material: 60 mill Hvhoh Primary [x] Secondary [] Pond# Cell# Pad# Other:

Panel #	1	Roll #	OOO3	Panel #	2	Roll #	OOO3	Panel #	Roll #		
22.5 150 150				22.5 150 150							
Initial SF		Lineal Feet Trench		Initial SF		Lineal Feet Trench		Initial SF		Lineal Feet Trench	
Final SF				Final SF				Final SF			
Panel #		Roll #		Panel #		Roll #		Panel #		Roll #	
Final SF		0		Final SF		0		Final SF		0	
Initial SF		0		Initial SF		0		Initial SF		0	
Panel #		Roll #		Panel #		Roll #		Total Initial SF This Page			
								Total Final SF This Page			
								Anchor Trench Total Linear Feet Trench 0 LF X Depth And With Allowed In Trench LF =Total SF In Trench SF			
								Total Pay Area This Page			
								Total Previous Page			
Final SF		0		Final SF		0		Total Pay Area To Date			
Initial SF		0		Initial SF		0		0			

Project Name: Chiquita Canyon Cell 8 Tank Farm		Project No. RM22.1077		Daily Field Report Sequence Number: 059	
Location of Work: Santa Clarita, CA		Client Waste Connections		Date: July 21, 2025	
General Contractor: Sukut Construction, Inc.		Liner Contractor: D&E Construction		Project Manager: Rick Mitchell	
General Foreman: Matt Rodarte		Liner Superintendent: Dennis Kennedy		GLA CQA Officer: Tom Runyan	
Source and Description of Fill Material: Imported Gravel		Weather: Overcast to Sunny: 60°F to 93°F Wind: Calm to 9mph		CQA Technician: Magno Jara	
Equipment on utilized: Water Truck, Cat 834 RTD, Cat D3 Dozer, Cat D5 LGP Dozer, Smooth Drum Roller.					

NOTES (Describe work completed during the day, any problems and their solutions:)

Sukut Construction, Inc:

- The Cat D3 dozer finish grades Pad #1 berms. The laborers detail grades the liner subgrade.
- The water trucks provide moisture conditioning as necessary.
- The smooth drum roller proof rolled at Pad #1.
- Water Truck provides dust control as necessary.

D&E:

- Geomembrane panels (P1-P2) were deployed on top deck (new cap area).
- Panel seams were wedge welded and welds were air tested, no leaks indicated.
- Repairs were extrusion welded and extrusion welded seams were vacuum box tested. Tests did not indicate any leaks.
- Pipe boots were fabricated at penetrations.
- Trial welds were performed and observed prior to welding.

GLA-CQA:

- Monitored, observed, documented and photographed CQA activities

Notes/Conversations:

NA

Prepared By: Magno Jara

Reviewed By: Tom Runyan

Photos:



Picture 1: Anchor trench construction (Pad #1).



Picture 2: Pad 1 East Slope Backfill

Prepared By: Magno Jara

Reviewed By: Tom Runyan



Picture 3: Fabricated Pipe Boots (Top deck)

GEOMEMBRANE SEAMING LOG

Project: Chiquita Canyon Landfill

Project No.: RM22.1077 Phase 5


Material Type: 30mil HVOH HDPE - Double-Sided Textured

☒ Primary ☐ Secondary ☐ Other


[illegible]

[illegible]

Chiquita Canyon Landfill - Isopach

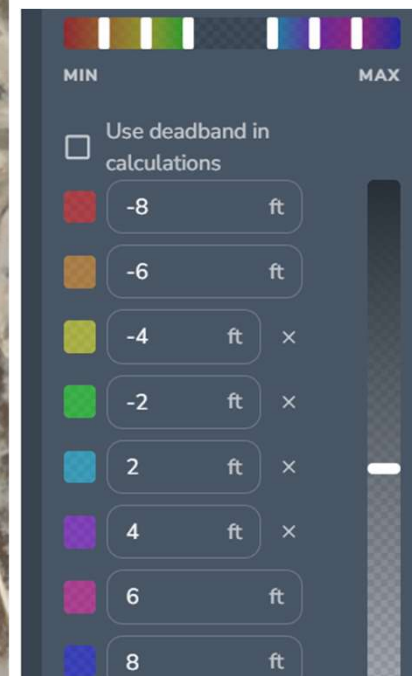

June 28, 2025 Survey Image. May 28, 2025 vs June 28, 2025

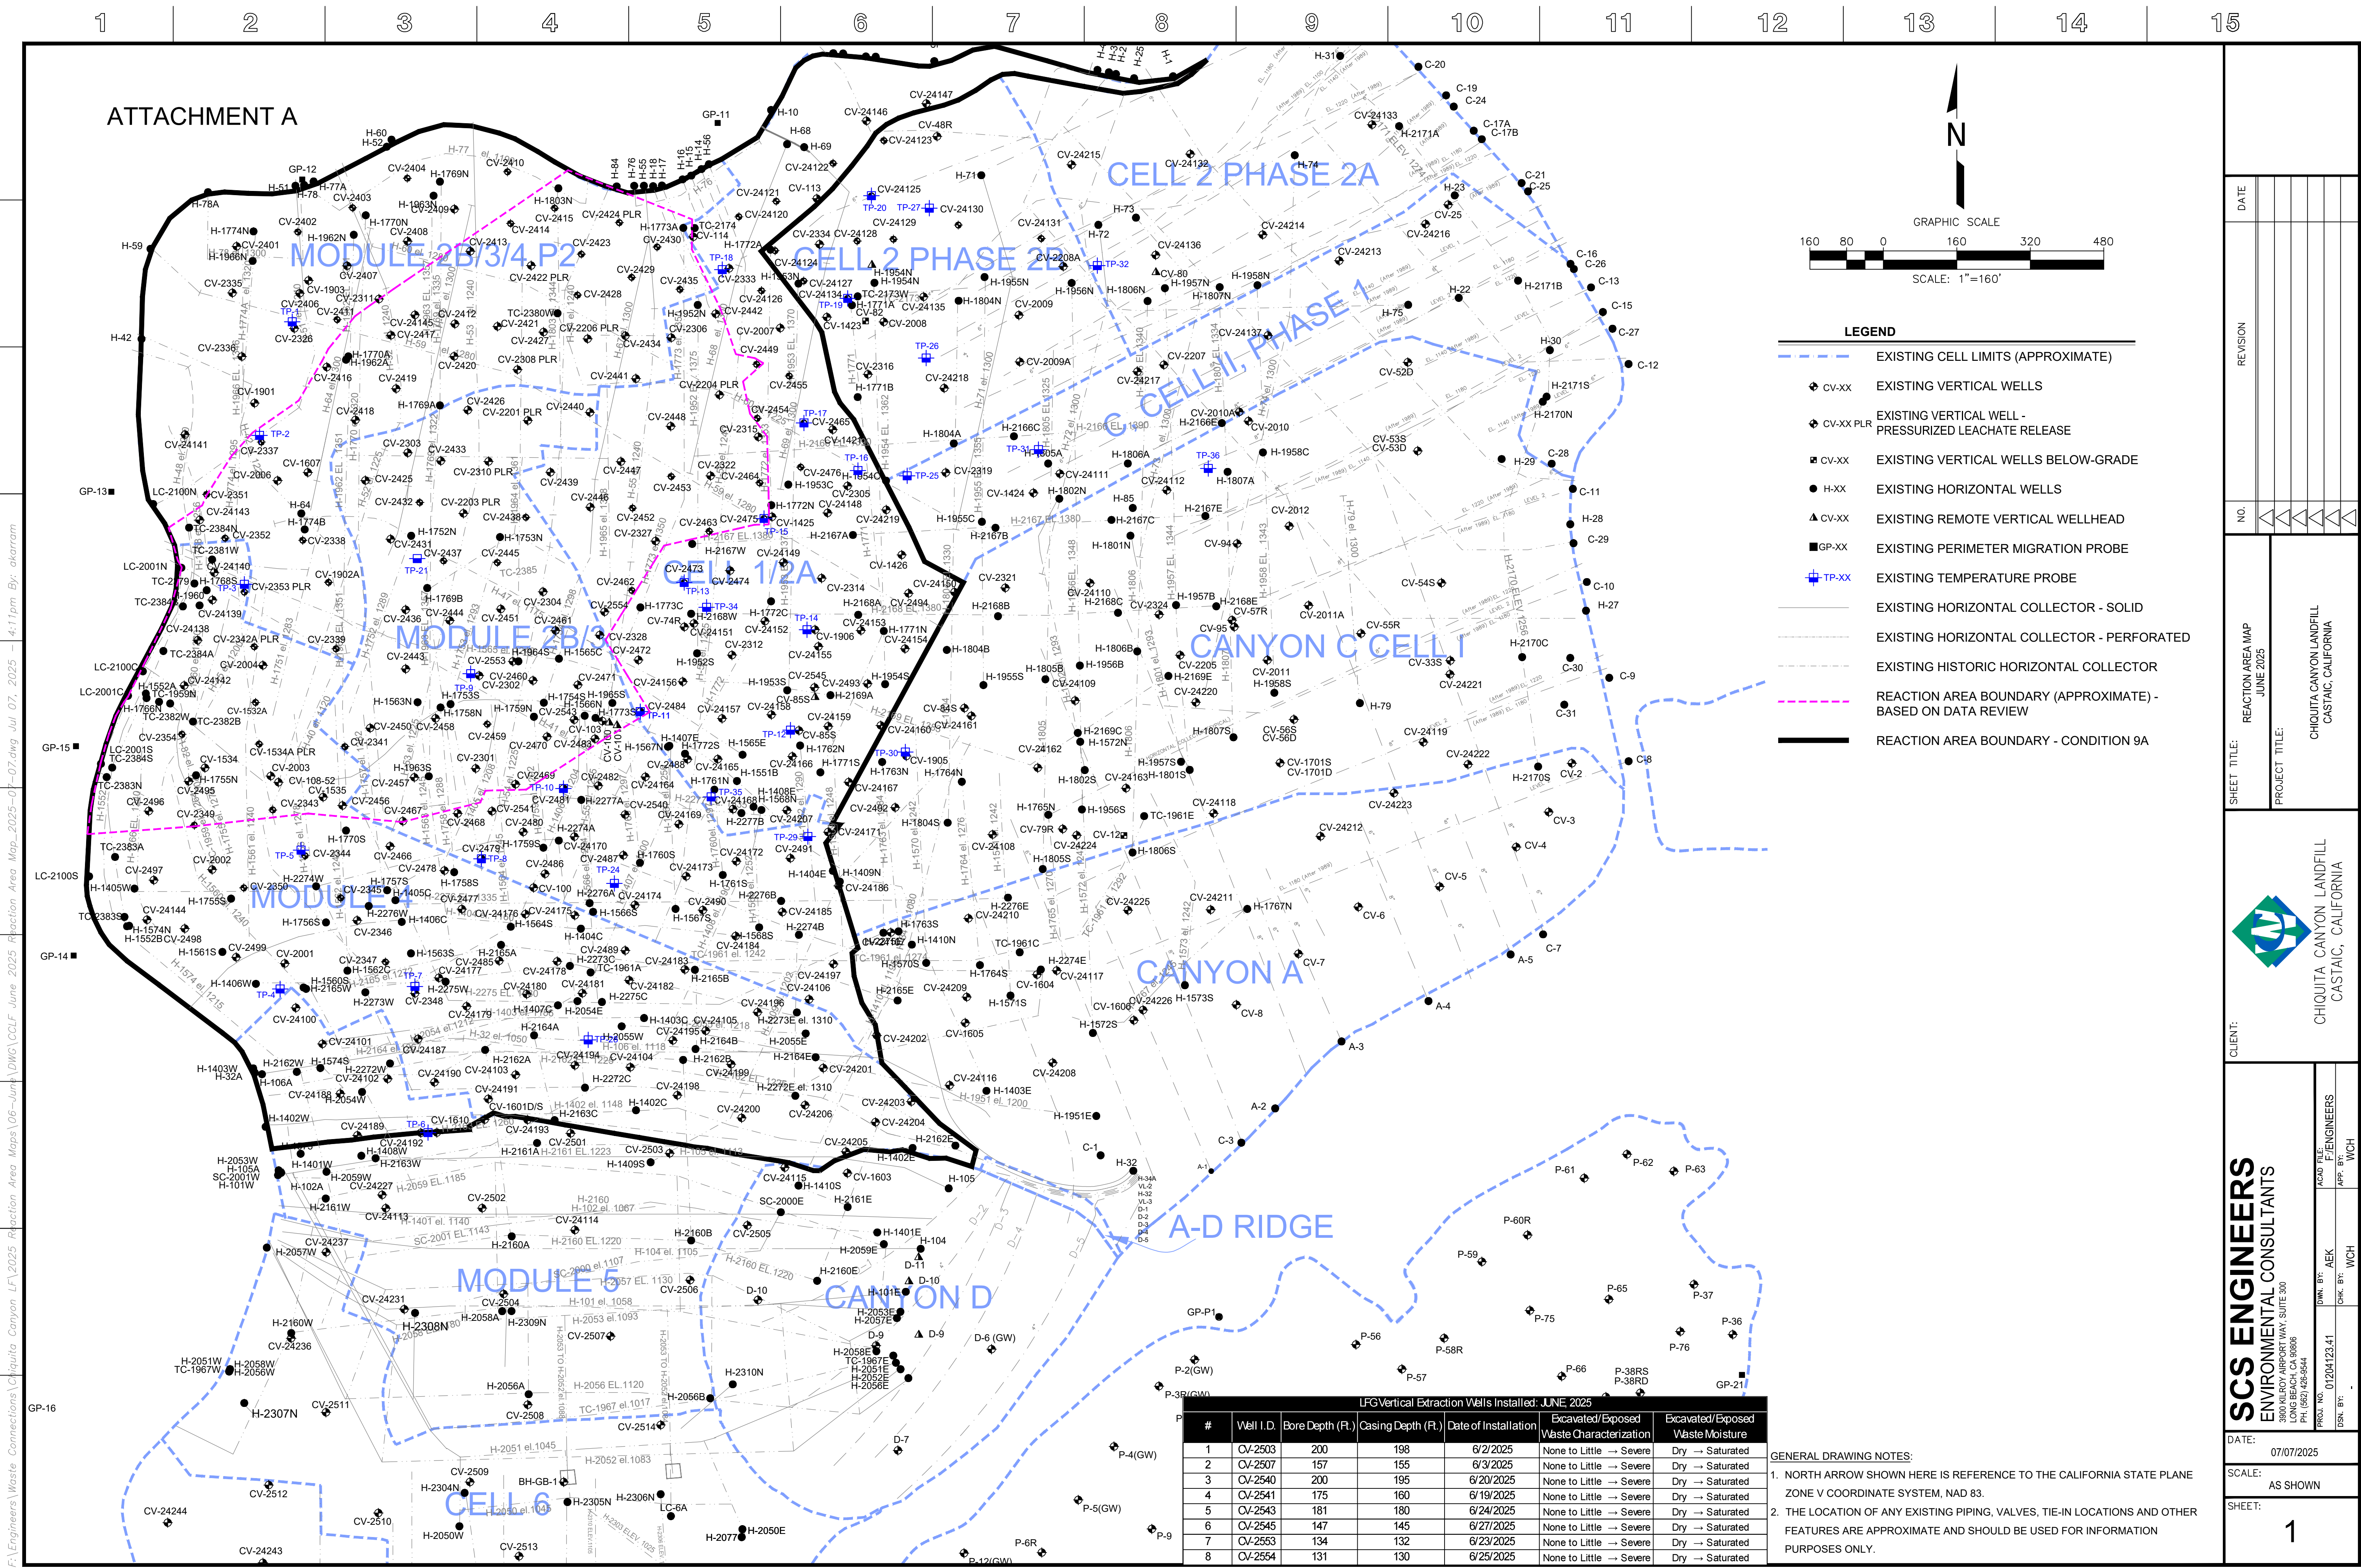

LEGEND

- EXISTING CELL LIMITS (APPROXIMATE)
- CV-XX EXISTING VERTICAL WELLS
- CV-XX PLR EXISTING VERTICAL WELL - PRESSURIZED LEACHATE RELEASE
- CV-XX EXISTING VERTICAL WELLS BELOW-GRADE
- H-XX EXISTING HORIZONTAL WELLS
- CV-XX EXISTING REMOTE VERTICAL WELLHEAD
- GP-XX EXISTING PERIMETER MIGRATION PROBE
- TP-XX EXISTING TEMPERATURE PROBE
- EXISTING HORIZONTAL COLLECTOR - SOLID
- EXISTING HORIZONTAL COLLECTOR - PERFORATED
- EXISTING HISTORIC HORIZONTAL COLLECTOR
- - - REACTION AREA BOUNDARY (APPROXIMATE) - BASED ON DATA REVIEW
- REACTION AREA BOUNDARY - CONDITION 9A

LFG Vertical Extraction Wells Installed: JUNE 2025						
#	Well I.D.	Bore Depth (ft.)	Casing Depth (ft.)	Date of Installation	Excavated/Exposed Waste Characterization	Excavated/Exposed Waste Moisture
1	CV-2503	200	198	6/2/2025	None to Little → Severe	Dry → Saturated
2	CV-2507	157	155	6/3/2025	None to Little → Severe	Dry → Saturated
3	CV-2540	200	195	6/20/2025	None to Little → Severe	Dry → Saturated
4	CV-2541	175	160	6/19/2025	None to Little → Severe	Dry → Saturated
5	CV-2543	181	180	6/24/2025	None to Little → Severe	Dry → Saturated
6	CV-2545	147	145	6/27/2025	None to Little → Severe	Dry → Saturated
7	CV-2553	134	132	6/23/2025	None to Little → Severe	Dry → Saturated
8	CV-2554	131	130	6/25/2025	None to Little → Severe	Dry → Saturated

GENERAL DRAWING NOTES:

- NORTH ARROW SHOWN HERE IS REFERENCE TO THE CALIFORNIA STATE PLANE ZONE V COORDINATE SYSTEM, NAD 83.
- THE LOCATION OF ANY EXISTING PIPING, VALVES, TIE-IN LOCATIONS AND OTHER FEATURES ARE APPROXIMATE AND SHOULD BE USED FOR INFORMATION PURPOSES ONLY.

DATE

REVISION

NO.

SHEET TITLE:

REACTION AREA MAP

JUNE 2025

CLIENT:

CHIQUITA CANYON LANDFILL

CASTAIC, CALIFORNIA

PROJECT TITLE:

CHIQUITA CANYON LANDFILL

CASTAIC, CALIFORNIA

SCS ENGINEERS

ENVIRONMENTAL CONSULTANTS

15000 W. ORANGE AVE., SUITE 300

LONG BEACH, CA 90806

PH: (562) 426-9544

DATE:

07/07/2025

SCALE:

AS SHOWN

SHEET:

1

ACAD FILE:

F:\ENGINEERS

DWN. BY:

AEK

CHK. BY:

WCH

APP. BY:

WCH