

From: Medina, Steven <SMedina@scsengineers.com>
Sent: Friday, August 8, 2025 10:43 AM
To: bchen@aqmd.gov; ndickel@aqmd.gov; Christina Ojeda
Cc: Han, Jessie; Haley, William (Bill); Amanda Froman; Steve Cassulo; Nicole Ward; Viswanathan, Srividhya; Jones, Art; Kate Logan; Mark.Adams
Subject: Re: Case No. 6177-4 Stipulated Order for Abatement – Well Drilling Update
Attachments: 2025 CCLF GCCS Expan Master Plan_Proposed LFG Extraction Well and Temp Probe Map_2025-08-08.pdf

[EXTERNAL SENDER: Use caution with links/attachments]

All,

In accordance with Condition 15(c) of the Stipulated Order, below is the up-to-date construction summary for the Chiquita Canyon Landfill 2025 GCCS Expansion Master Plan Project.

As of 08/04/2025 to 08/08/2025 - Installation of LFG vertical extraction wells included:

1. CV-2531
2. CV-2533
3. CV-2534
4. CV-2549
5. CV-2564

During 08/04/2025 to 08/08/2025, Chiquita completed the installation of five (5) vertical LFG extraction wells. The total count of vertical LFG extraction wells installed from December 6, 2023 (the start date of the GCCS Master Expansion) through today is two hundred seventy-seven (277).

During 08/04/2025 to 08/08/2025, Chiquita completed the installation of zero (0) temperature probes, as forecasted in our August 01, 2025, update. The total count of temperature probes installed from February 26th, 2024 (the start date of the temperature probe installations) through today remains thirty-three (33).

The wells and temperature probes scheduled for drilling during the week of 08/11/2025 to 08/15/2025 are as follows (subject to change):

Rig (Continuum): CV-2547, CV-2548, CV-2550, CV-2551, CV-2558

Temperature Probe Rig (Boart Longyear): Drilling for the temperature probes is scheduled to resume on August 15th.

Regards,

STEVEN Ruben Medina, **E.I.T.**

Staff Professional

SCS Engineers


3900 Kilroy Airport Way, Suite 300

Long Beach, CA 90806
858-204-4342 (c)
SMedina@scsengineers.com

Driven by Client Success
www.scsengineers.com

*2024 Conrad Quality Focus
Award Recipient*



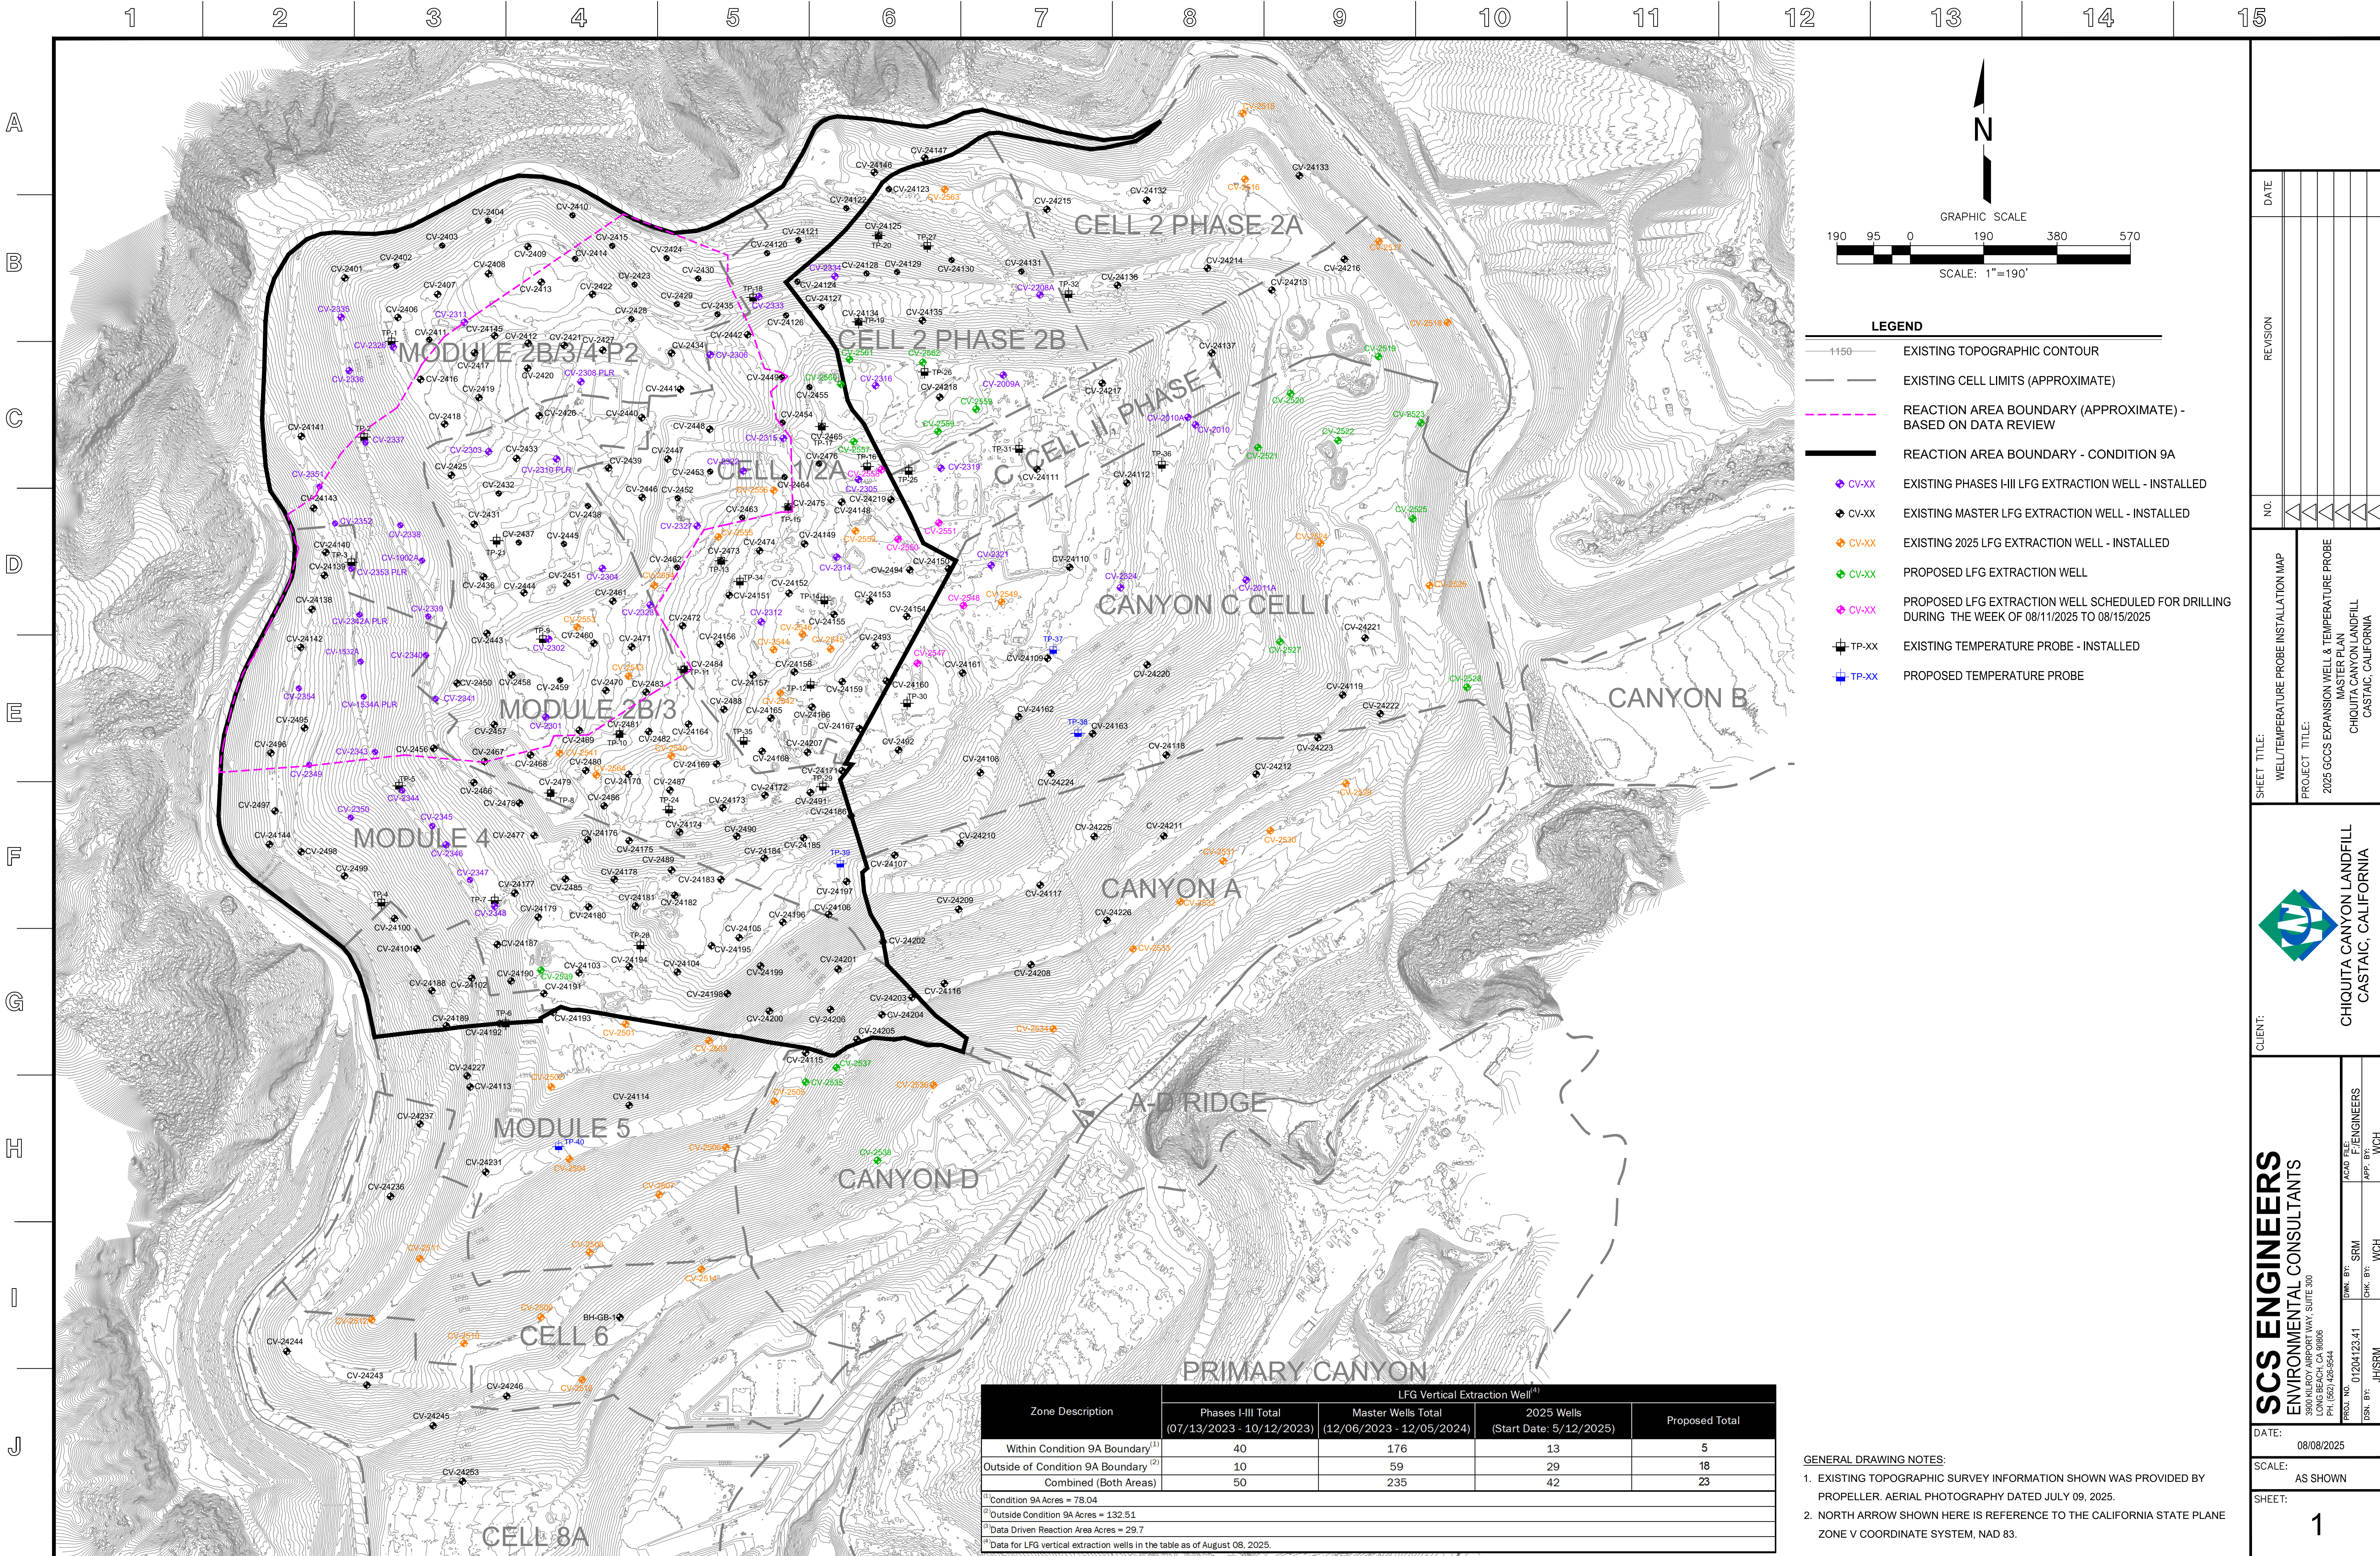

GENERAL DRAWING NOTES:

- EXISTING TOPOGRAPHIC SURVEY INFORMATION SHOWN WAS PROVIDED BY PROPELLER. AERIAL PHOTOGRAPHY DATED JULY 09, 2025.
- NORTH ARROW SHOWN HERE IS REFERENCE TO THE CALIFORNIA STATE PLANE ZONE V COORDINATE SYSTEM, NAD 83.