

De: Medina, Steven <SMedina@scsengineers.com>
Enviado: Viernes 29 de agosto de 2025 12:03 PM
Para: bchen@aqmd.gov; ndickel@aqmd.gov; Christina Ojeda
Cc: Han, Jessie; Haley, William (Bill); Amanda Froman; Steve Cassulo; Nicole Ward; Viswanathan, Srividhya; Jones, Art; Kate Logan; Mark.Adams
Asunto: Ref.: Orden de Depuración Estipulada del Caso No. 6177-4 - Actualización sobre la Perforación del Pozo
Adjuntos: 2025 CCLF GCCS Expan Master Plan_Proposed LFG Extraction Well and Temp Probe Map_2025-08-29.pdf

[REMITENTE EXTERNO: Tenga precaución con los enlaces/adjuntos]

Todos,

Según la Condición 15(c) de la Orden Estipulada, a continuación se encuentra el resumen actualizado de la construcción para el Proyecto del Plan Maestro de Ampliación de GCCS 2025 del Vertedero de Chiquita Canyon.

Desde el 25/08/2025 hasta el 29/08/2025 - Instalación de pozos verticales de extracción de LFG y sondas de temperatura incluidos:

1. TP-37
2. CV-2519
3. CV-2559

Del 25/08/2025 al 29/08/2025, Chiquita completó la instalación de dos (2) pozos de extracción vertical de LFG. La cantidad total de pozos verticales de extracción de LFG instalados desde el 6 de diciembre de 2023 (la fecha de inicio de la Expansión Maestra de GCCS) hasta hoy es de doscientos ochenta y cuatro (284).

Del 25/08/2025 al 29/08/2025, Chiquita completó la instalación de una (1) sonda de temperatura. La cantidad total de sondas de temperatura instaladas desde el 26 de febrero de 2024 cuatro: (la fecha de inicio de las instalaciones de sondas de temperatura) hasta hoy es de treinta y cuatro (34).

Los pozos y las sondas de temperatura programados para perforación durante la semana del 01/09/2025 al 05/9/2025 son los siguientes (sujeto a cambios):

Plataforma (Secuencia): CV-2520, CV-2521, CV-2522, CV-2523

Plataforma de Sondas de Temperatura (Boart Longyear): TP-38, TP39

Atentamente,

STEVEN Rubén Medina, **E.I.T.**

Personal Profesional


SCS Engineers



3900 Kilroy Airport Way, Suite 300

Long Beach, CA 90806
858-204-4342 (c)
SMedina@scsengineers.com

Dirigidos por el Éxito de los Clientes
www.scsengineers.com

*2024 Conrad Quality Focus
Award Recipient*

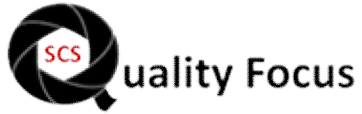

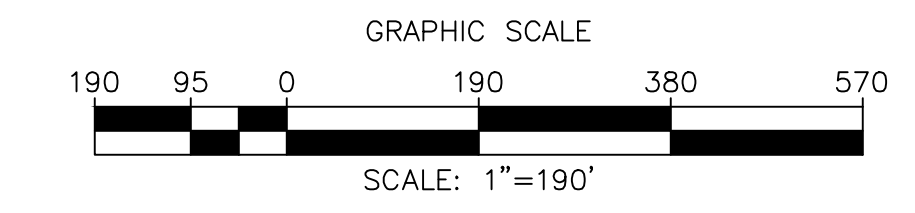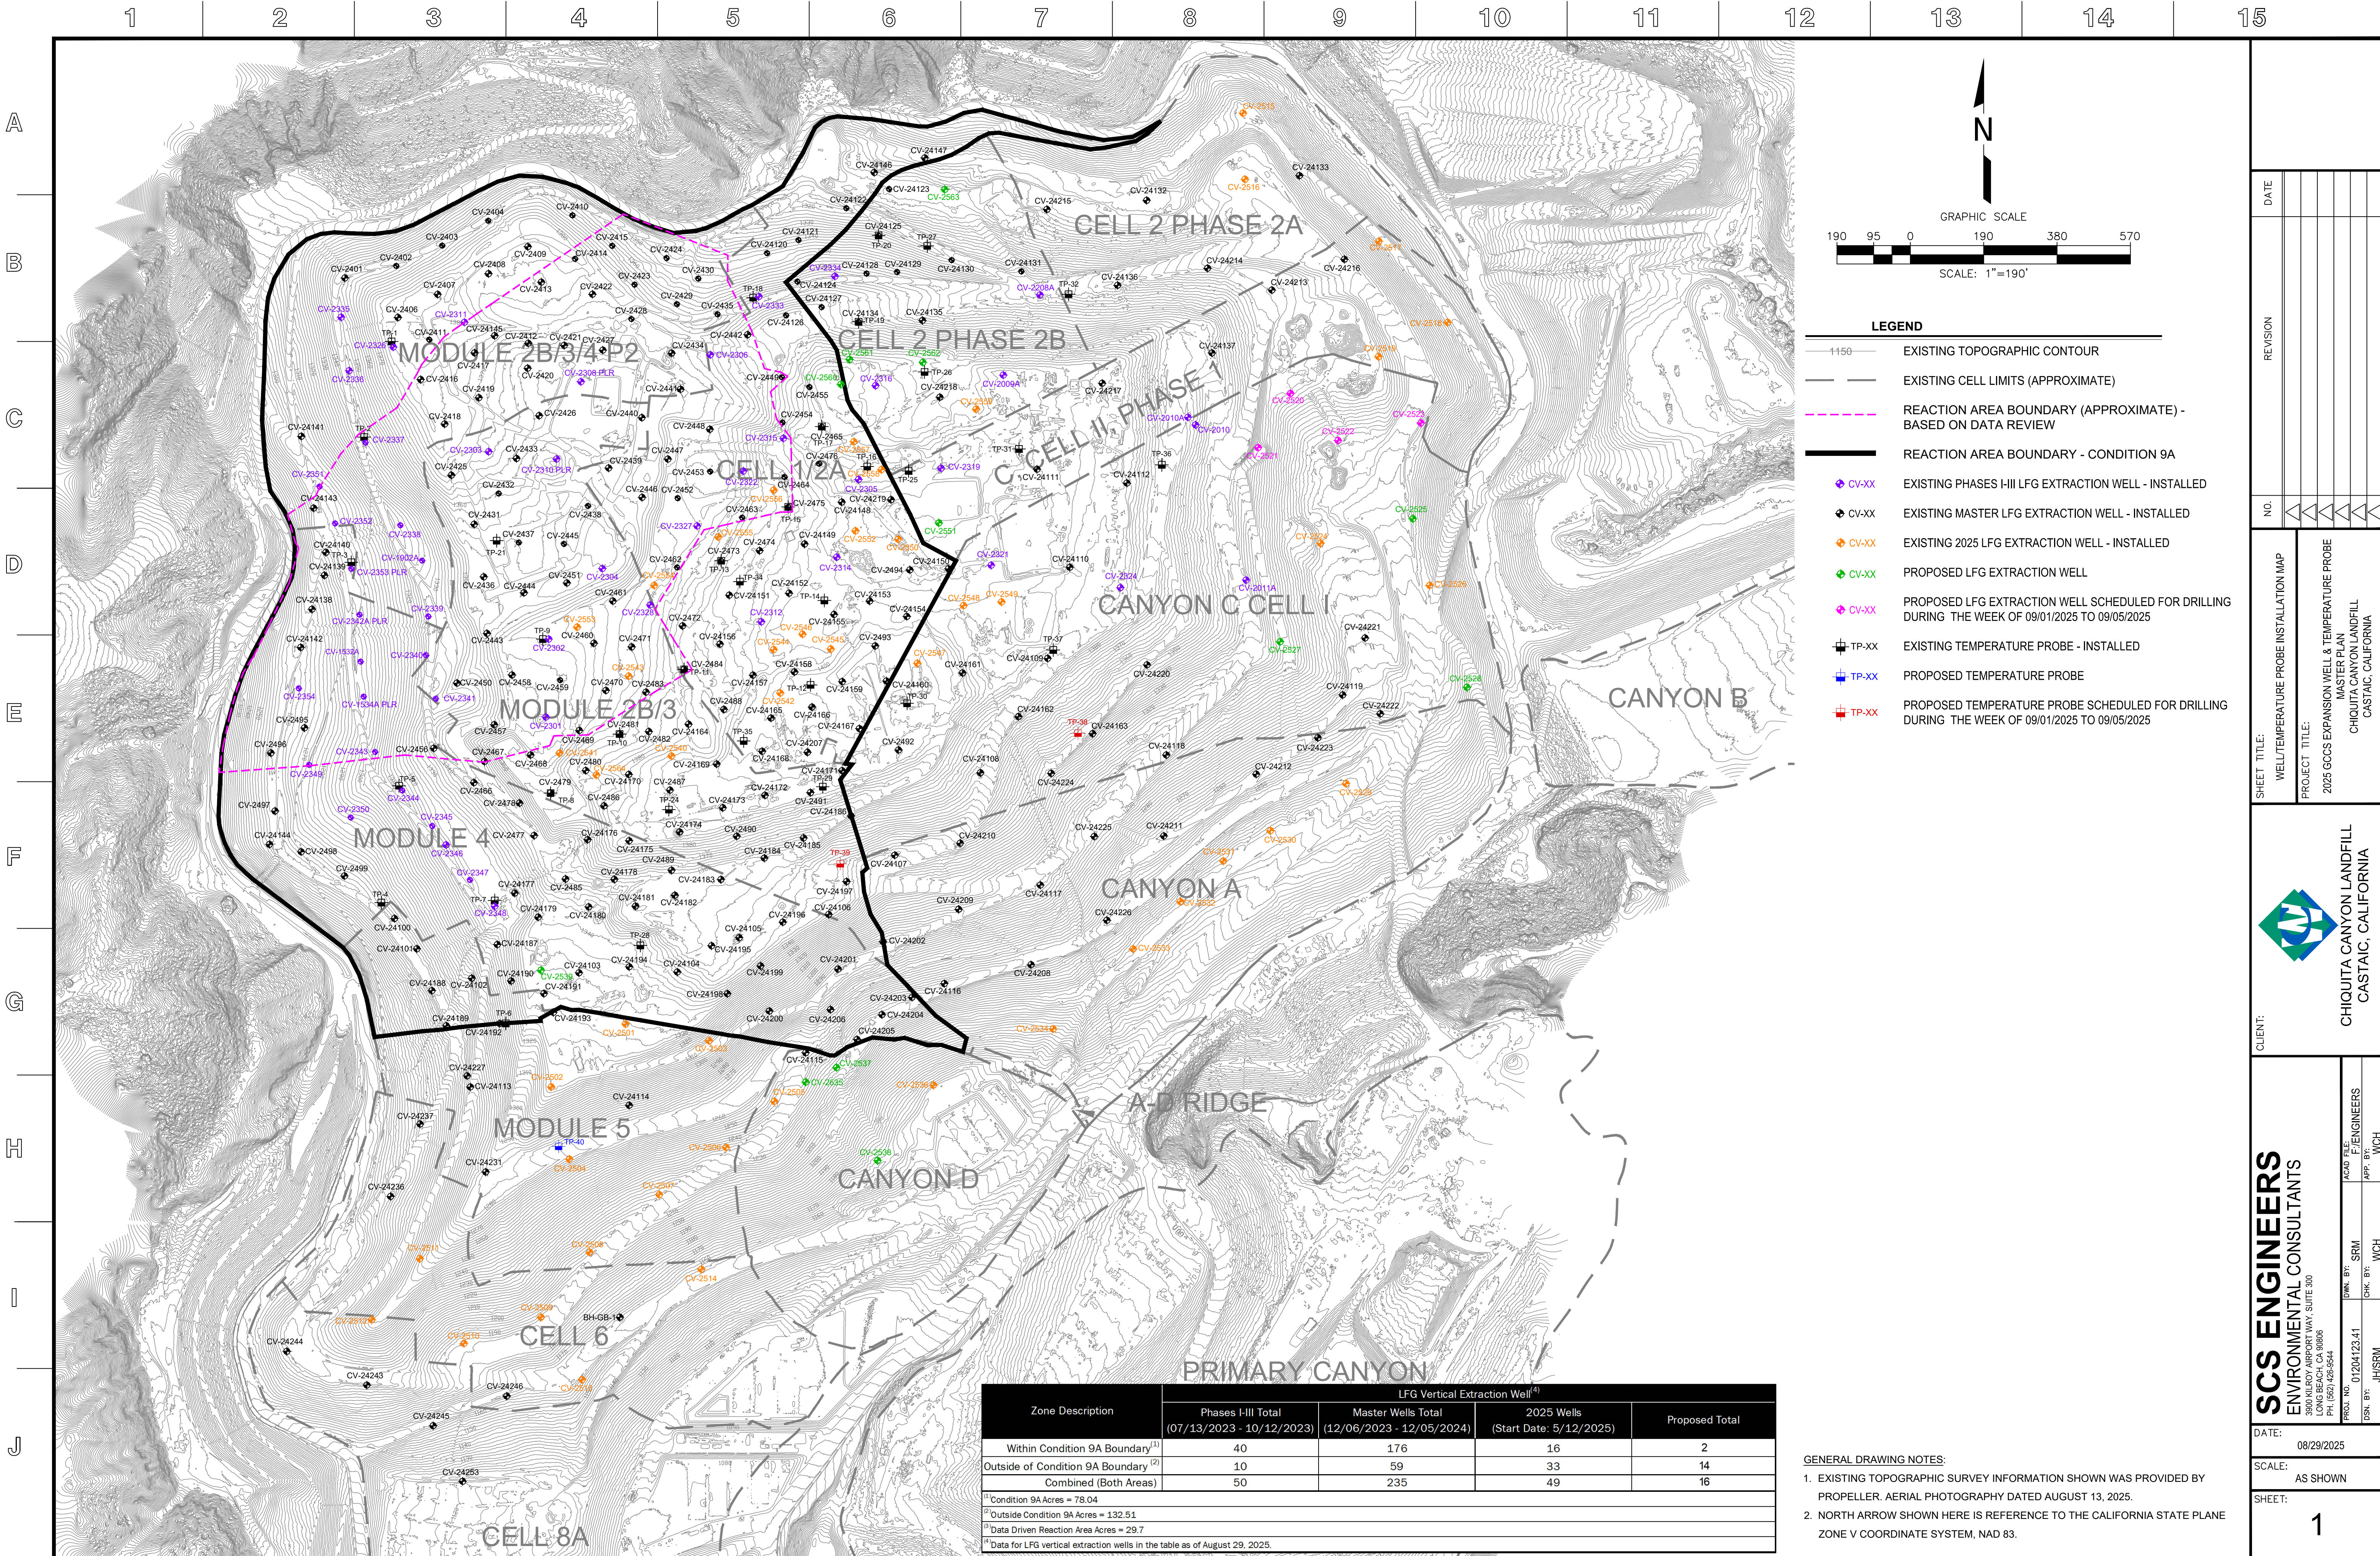

- LEGEND**
- 1150 EXISTING TOPOGRAPHIC CONTOUR
 - EXISTING CELL LIMITS (APPROXIMATE)
 - REACTION AREA BOUNDARY (APPROXIMATE) - BASED ON DATA REVIEW
 - REACTION AREA BOUNDARY - CONDITION 9A
 - EXISTING PHASES I-III LFG EXTRACTION WELL - INSTALLED
 - EXISTING MASTER LFG EXTRACTION WELL - INSTALLED
 - EXISTING 2025 LFG EXTRACTION WELL - INSTALLED
 - PROPOSED LFG EXTRACTION WELL
 - PROPOSED LFG EXTRACTION WELL SCHEDULED FOR DRILLING DURING THE WEEK OF 09/01/2025 TO 09/05/2025
 - EXISTING TEMPERATURE PROBE - INSTALLED
 - PROPOSED TEMPERATURE PROBE
 - PROPOSED TEMPERATURE PROBE SCHEDULED FOR DRILLING DURING THE WEEK OF 09/01/2025 TO 09/05/2025

Zone Description	LFG Vertical Extraction Well ⁽¹⁾			
	Phases I-III Total (07/13/2023 - 10/12/2023)	Master Wells Total (12/06/2023 - 12/05/2024)	2025 Wells (Start Date: 5/12/2025)	Proposed Total
Within Condition 9A Boundary ⁽¹⁾	40	176	16	2
Outside of Condition 9A Boundary ⁽²⁾	10	59	33	14
Combined (Both Areas)	50	235	49	16

⁽¹⁾ Condition 9A Acres = 78.04
⁽²⁾ Outside Condition 9A Acres = 132.51
⁽³⁾ Data Driven Reaction Area Acres = 29.7
⁽⁴⁾ Data for LFG vertical extraction wells in the table as of August 29, 2025.

GENERAL DRAWING NOTES:

- EXISTING TOPOGRAPHIC SURVEY INFORMATION SHOWN WAS PROVIDED BY PROPELLER. AERIAL PHOTOGRAPHY DATED AUGUST 13, 2025.
- NORTH ARROW SHOWN HERE IS REFERENCE TO THE CALIFORNIA STATE PLANE ZONE V COORDINATE SYSTEM, NAD 83.

DATE

REVISION

NO.

SHEET TITLE:
WELL/TEMPERATURE PROBE INSTALLATION MAP

PROJECT TITLE:
2025 GCCS EXPANSION WELL & TEMPERATURE PROBE MASTER PLAN
CHIUQUITA CANYON LANDFILL
CASTAIC, CALIFORNIA

CLIENT:

SCS ENGINEERS
ENVIRONMENTAL CONSULTANTS
15000 WILSON AVENUE, SUITE 300
LONG BEACH, CA 90806
PH: (562) 426-9544

DATE: 08/29/2025

SCALE:
AS SHOWN

SHEET:
1

ACAD FILE:
F:\ENGINEERS

DWN. BY: SRM

CHK. BY: WCH

APP. BY: WCH

JHSRM