

From: Medina, Steven <SMedina@scsengineers.com>
Sent: Friday, September 19, 2025 1:06 PM
To: bchen@aqmd.gov; ndickel@aqmd.gov; Christina Ojeda
Cc: Han, Jessie; Haley, William (Bill); Amanda Froman; Steve Cassulo; Nicole Ward; Viswanathan, Srividhya; Jones, Art; Kate Logan; Mark.Adams
Subject: Re: Case No. 6177-4 Stipulated Order for Abatement – Well Drilling Update
Attachments: 2025 CCLF GCCS Expan Master Plan_Proposed LFG Extraction Well and Temp Probe Map_2025-09-19.pdf

[EXTERNAL SENDER: Use caution with links/attachments]

All,

In accordance with Condition 15(c) of the Stipulated Order, below is the up-to-date construction summary for the Chiquita Canyon Landfill 2025 GCCS Expansion Master Plan Project.

As of 09/15/2025 to 09/19/2025 - Installation of LFG vertical extraction wells included:

1. CV-25104S/D
2. CV-25105S/D
3. CV-25107S/D

During 09/15/2025 to 09/19/2025, Chiquita completed the installation of three (3) vertical LFG extraction wells. The total count of vertical LFG extraction wells installed from December 6, 2023 (the start date of the GCCS Master Expansion) through today is two hundred ninety-three (293).

During 09/15/2025 to 09/19/2025, Chiquita completed the installation of zero (0) temperature probe. The total count of temperature probes installed from February 26th, 2024 (the start date of the temperature probe installations) through today is thirty-five (35).

The wells and temperature probes scheduled for drilling during the week of 09/22/2025 to 09/26/2025 are as follows (subject to change):

Rig (Continuum): CV-2560, CV-2561, CV-2562, CV-251013S/D, CV-25106S/D

Temperature Probe Rig (Boart Longyear): TP-39, TP-40

Regards,


STEVEN Ruben Medina, **E.I.T.**
Staff Professional
SCS Engineers
3900 Kilroy Airport Way, Suite 300
Long Beach, CA 90806
858-204-4342 (c)
SMedina@scsengineers.com

Driven by Client Success

www.scsengineers.com

*2024 Conrad Quality Focus
Award Recipient*



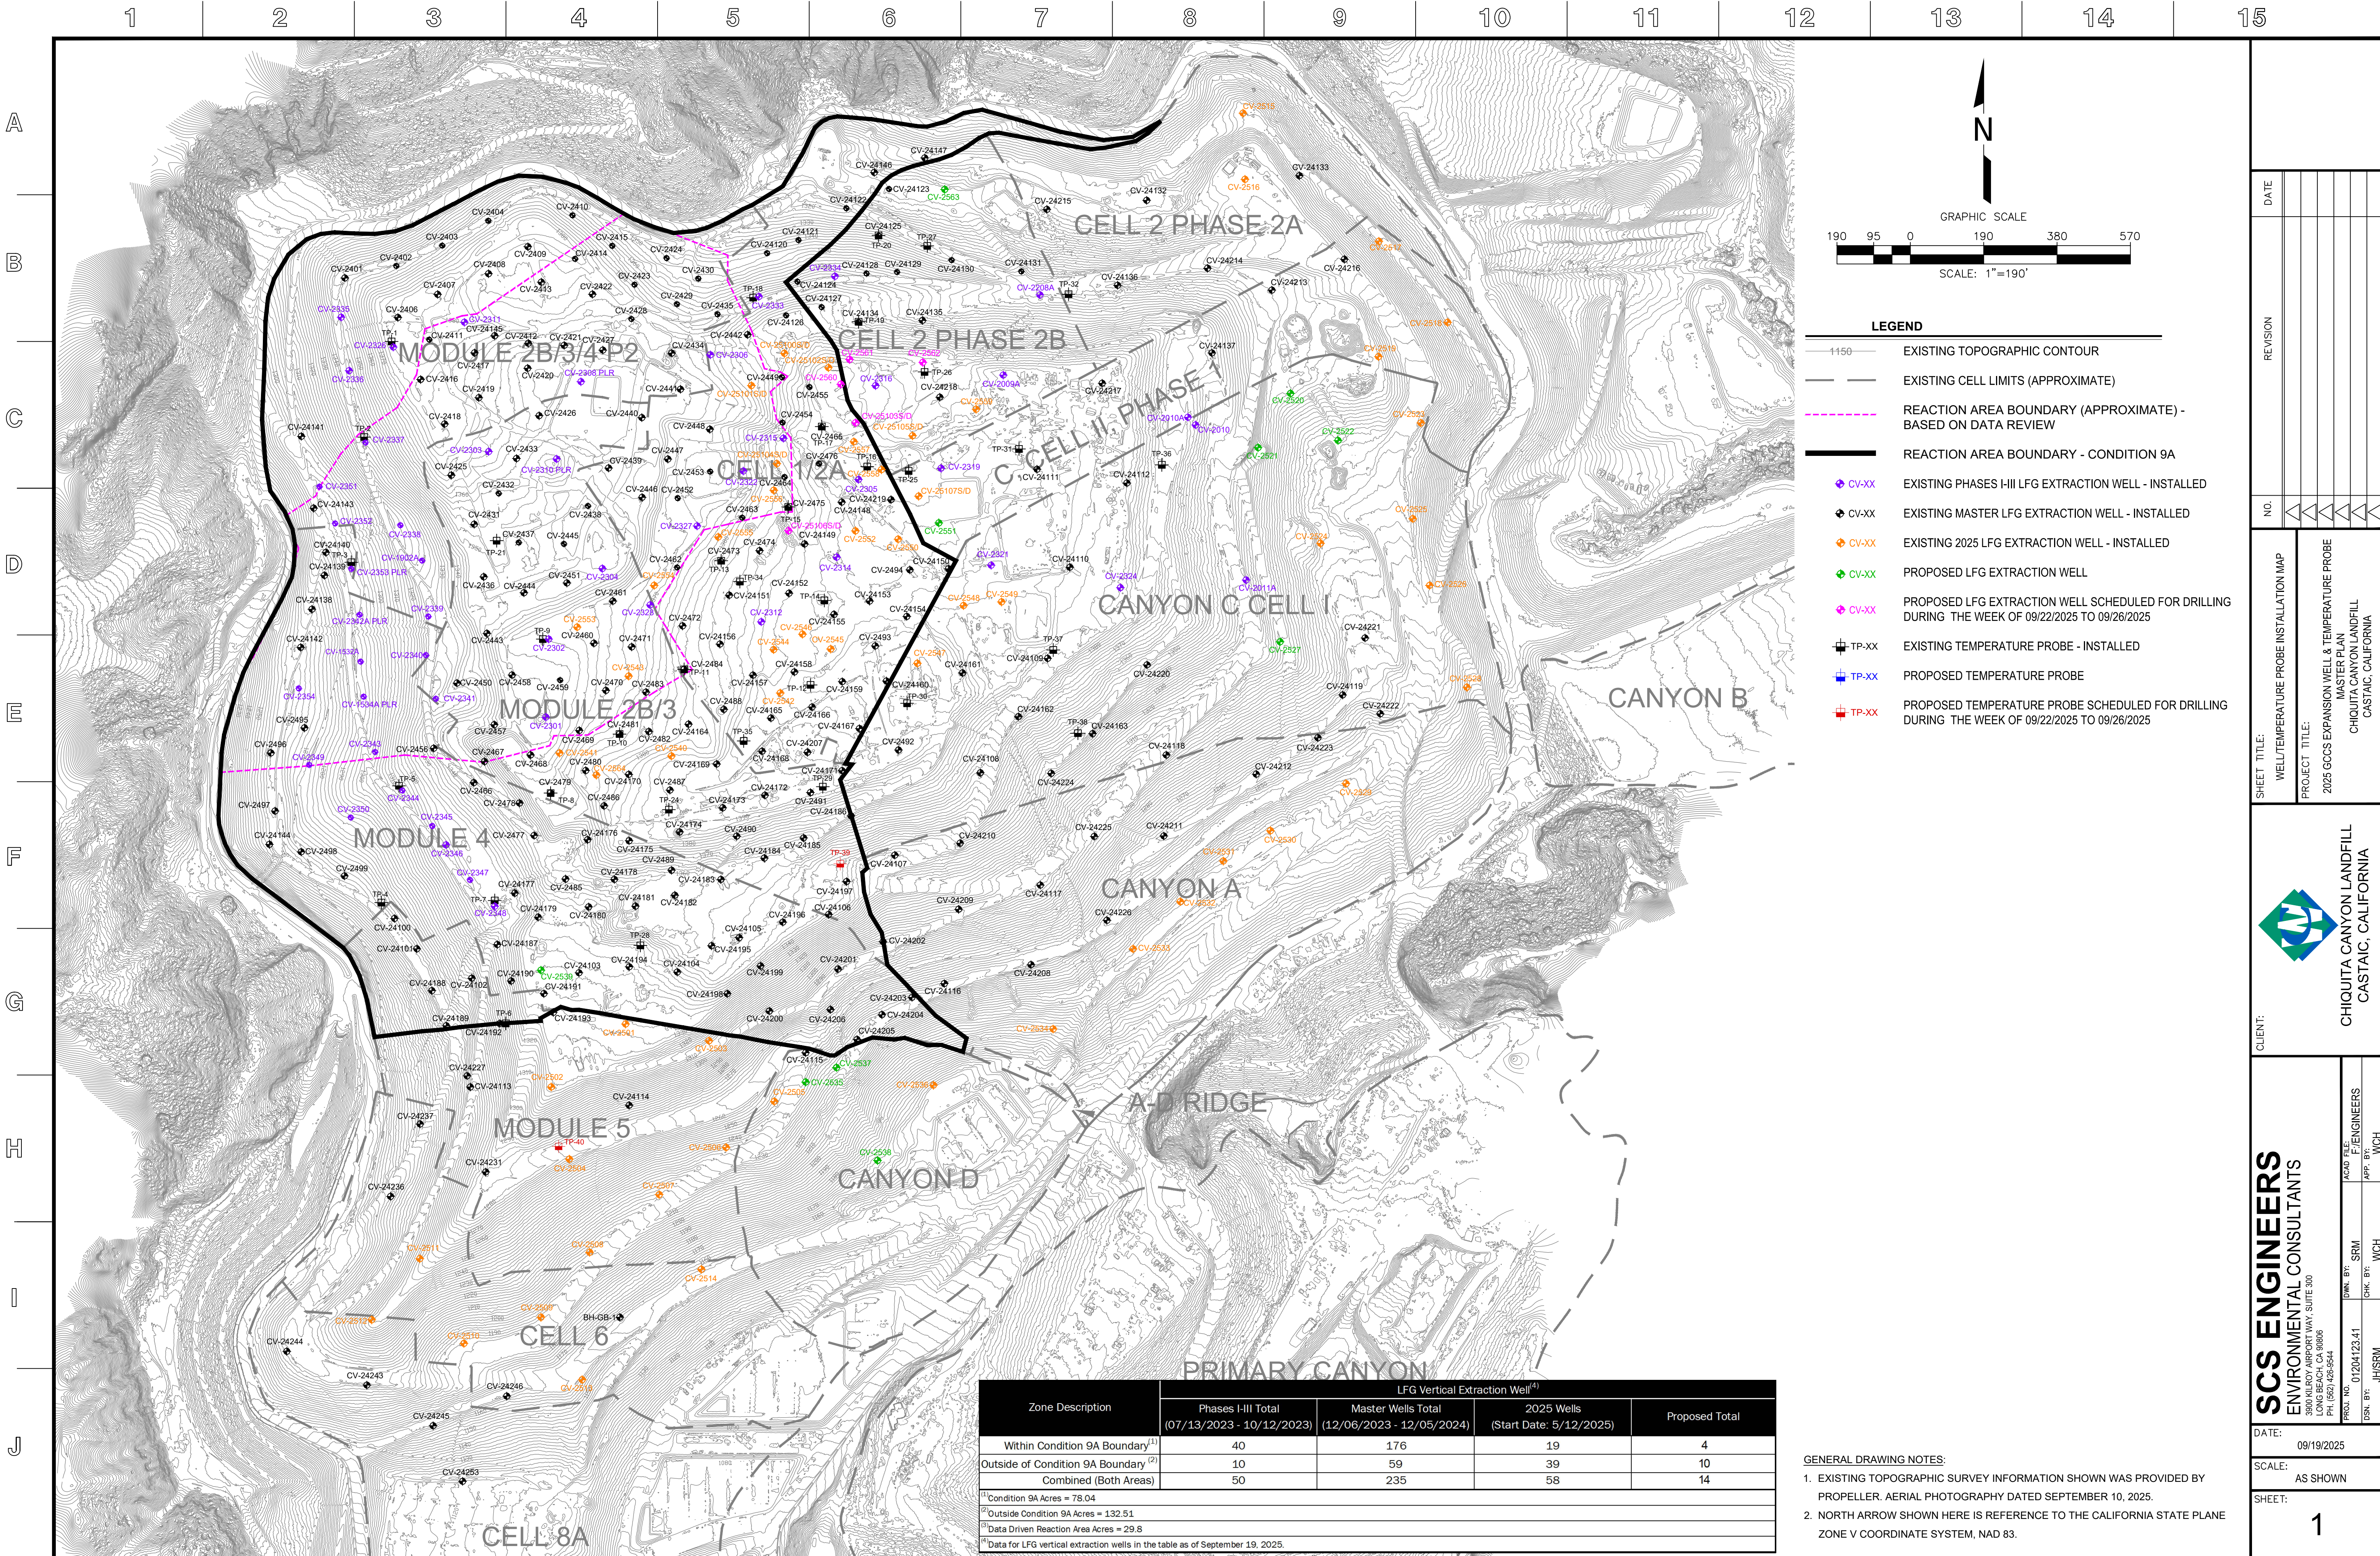

Zone Description	LFG Vertical Extraction Well ⁽¹⁾			
	Phases I-III Total (07/13/2023 - 10/12/2023)	Master Wells Total (12/06/2023 - 12/05/2024)	2025 Wells (Start Date: 5/12/2025)	Proposed Total
Within Condition 9A Boundary ⁽¹⁾	40	176	19	4
Outside of Condition 9A Boundary ⁽²⁾	10	59	39	10
Combined (Both Areas)	50	235	58	14

⁽¹⁾ Condition 9A Acres = 78.04
⁽²⁾ Outside Condition 9A Acres = 132.51
⁽³⁾ Data Driven Reaction Area Acres = 29.8
⁽⁴⁾ Data for LFG vertical extraction wells in the table as of September 19, 2025.

GENERAL DRAWING NOTES:
1. EXISTING TOPOGRAPHIC SURVEY INFORMATION SHOWN WAS PROVIDED BY PROPELLER. AERIAL PHOTOGRAPHY DATED SEPTEMBER 10, 2025.
2. NORTH ARROW SHOWN HERE IS REFERENCE TO THE CALIFORNIA STATE PLANE ZONE V COORDINATE SYSTEM, NAD 83.

DATE

REVISION

NO.

SHEET TITLE:
WELL/TEMPERATURE PROBE INSTALLATION MAP

PROJECT TITLE:
2025 GCCS EXPANSION WELL & TEMPERATURE PROBE MASTER PLAN
CHIUQUITA CANYON LANDFILL
CASTAIC, CALIFORNIA

CLIENT:
CHIUQUITA CANYON LANDFILL
CASTAIC, CALIFORNIA

SCS ENGINEERS
ENVIRONMENTAL CONSULTANTS
LONG BEACH, CA 90806
PH: (562) 426-9544
DWN. BY: SRM
CHK. BY: WCH
APP. BY: WCH
JH/SRM

DATE:
09/19/2025

SCALE:
AS SHOWN

SHEET:
1