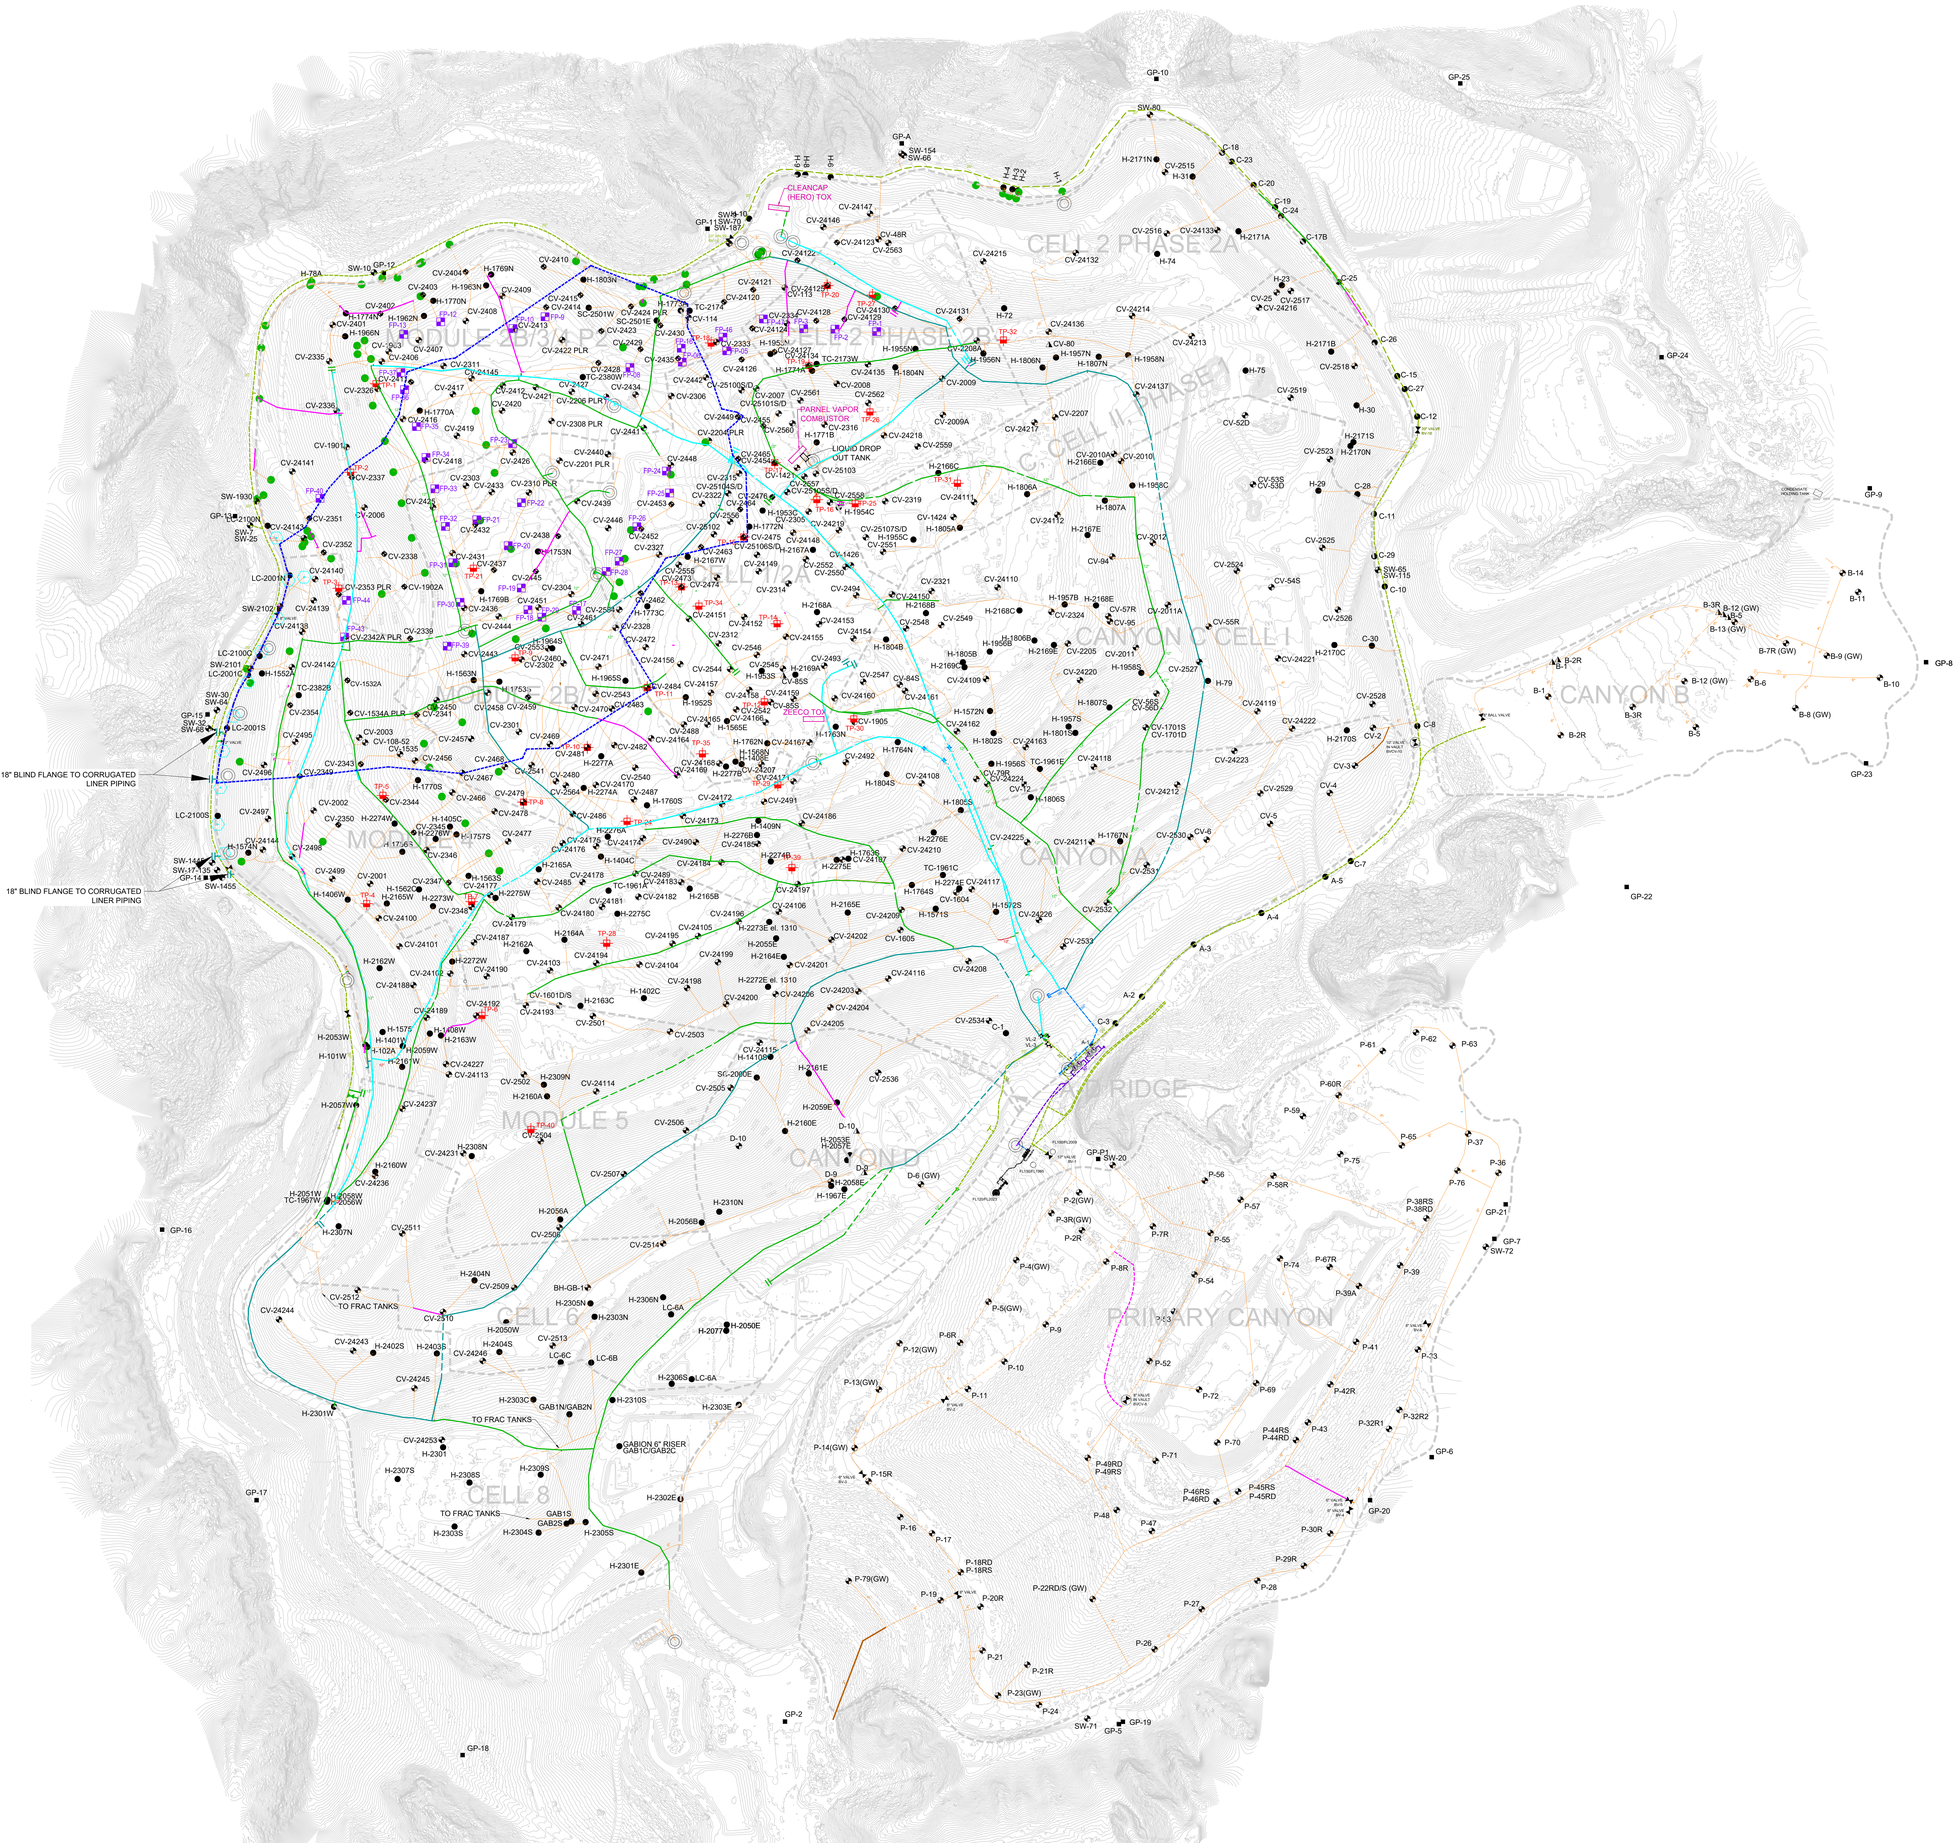

N

GRAPHIC SCALE

150 75 0 150 300 450

SCALE: 1"=150'

LEGEND

- TOPOGRAPHIC CONTOUR
- EXISTING CELL LIMITS (APPROXIMATE)
- CV-XX EXISTING LFG VERTICAL EXTRACTION WELL
- CV-XX PLR EXISTING LFG VERTICAL EXTRACTION WELL - PRESSURIZED LEACHATE RELEASE
- BH-GB EXISTING GABION LFG COLLECTOR WELL
- SW-XX EXISTING SOIL VAPOR EXTRACTION WELL
- FP-XX EXISTING SURFACE COLLECTOR WELLHEAD
- H-XX EXISTING HORIZONTAL WELLS
- C-XX EXISTING REMOTE VERTICAL WELLHEAD
- GP-XX EXISTING PERIMETER MIGRATION PROBE
- TP-XX EXISTING TEMPERATURE PROBE
- EXISTING ISOLATION VALVE
- AC EXISTING ACTIVATED CARBON VESSEL
- EXISTING CONDENSATE SUMP
- EXISTING HDPE LINER RISER
- EXISTING CORRUGATED LINER RISER
- 36" EXISTING 36" LFG COLLECTION HEADER PIPING
- 30" EXISTING 30" LFG COLLECTION HEADER PIPING
- 24" EXISTING 24" LFG COLLECTION HEADER PIPING
- 20" EXISTING 20" LFG COLLECTION HEADER PIPING
- 18" EXISTING 18" LFG COLLECTION HEADER PIPING
- 12" EXISTING 12" LFG COLLECTION HEADER PIPING
- 10" EXISTING 10" LFG COLLECTION HEADER PIPING
- 8" EXISTING 8" LFG COLLECTION LATERAL PIPING
- 4"/6" EXISTING 4"/6" LFG COLLECTION LATERAL PIPING
- 2"/3" EXISTING 2"/3" LFG COLLECTION LATERAL PIPING
- BELOW-GRADE PIPES ARE SHOWN DASHED
- REACTION AREA BOUNDARY (APPROXIMATE) - BASED ON DATA REVIEW
- EXISTING CAP

GENERAL DRAWING NOTES:

1. EXISTING TOPOGRAPHIC SURVEY INFORMATION SHOWN WAS PROVIDED BY PROPELLOR. AERIAL PHOTOGRAPHY DATED SEPTEMBER 24, 2025.
2. NORTH ARROW SHOWN HERE IS REFERENCE TO THE CALIFORNIA STATE PLANE ZONE V COORDINATE SYSTEM, NAD 83.
3. THE LOCATION OF ANY EXISTING PIPING, VALVES, TIE-IN LOCATIONS AND OTHER FEATURES ARE APPROXIMATE AND SHOULD BE USED FOR INFORMATION PURPOSES ONLY. ACTUAL FIELD CONDITIONS MAY VARY AND SUBJECT TO CHANGE BASED ON FUTURE FILL OPERATIONS, WASTE PLACEMENT, TOPOGRAPHIC FEATURES, AND OTHER SITE-SPECIFIC FACTORS.
4. EXISTING GCCS AS-BUILT DATED OCTOBER 01, 2025.

NO.	REVISION	DATE

SHEET TITLE: EXISTING GCCS MAP

PROJECT TITLE: CHIQUITA CANYON LANDFILL CASTAIC, CALIFORNIA

CLIENT: CHIQUITA CANYON LANDFILL CASTAIC, CALIFORNIA

SCS ENGINEERS
ENVIRONMENTAL CONSULTANTS
3900 KILROY AIRPORT WAY, SUITE 300
LONG BEACH, CA 90806
PH. (562) 426-9544

PROJ. NO.: - | DWN. BY: JHSRM | CHK. BY: - | APP. BY: -

DATE: 10/01/2025

SCALE: AS SHOWN

C:\Users\5160srm\Desktop\CCL MASTER EXISTING GCCS MAP ONLY_2025-08-13.dwg Oct 01, 2025 - 2:44pm By: smedina