



**CHIQUITA CANYON**  
*A Waste Connections Company*

November 18, 2025

***Via E-Mail***

Karen Gork  
Chief Environmental Health Specialist  
Los Angeles County Department of Public Health  
Local Enforcement Agency  
Environmental Programs Division  
5050 Commerce Drive,  
Baldwin Park, California 91706  
[KGork@ph.lacounty.gov](mailto:KGork@ph.lacounty.gov)

**Re: Chiquita Canyon, LLC's Weekly Report on the Documentation and Tracking of Cover Issues**

Dear Ms. Gork:

In accordance with the Local Enforcement Agency's ("LEA") May 2, 2024 letter approving Chiquita's April 16, 2024 Second Revised Written Plan for Documenting and Tracking Cover Issues ("Second Revised Written Plan"), the LEA's May 29, 2024 letter, and the LEA's June 6, 2024 Compliance Order, Chiquita presents the enclosed report for documenting and tracking cover issues for the week of November 10, 2025 to November 15, 2025.

Please contact me if you have any questions regarding this matter.

Regards,

*Amanda Froman*

Amanda Froman  
Compliance Manager  
Chiquita Canyon, LLC

Attachment: November 18, 2025 Weekly Cover Issues Report  
cc: Mark Como, Department of Public Health  
Eric Morofuji, Department of Public Health

# **Fissures and Tension Cracks**

# 4050 - Chiquita Reaction Area Tracking of Fissures and Tension Cracks

10 Nov 2025 / Tom Roe

Complete

Conducted on

10 Nov 2025 8:58 AM PST

Prepared by

Tom Roe

## Chiquita Reaction Area Tracking of Fissures and Tension Cracks

Chiquita Reaction Area Tracking of Fissures and Tension Cracks

Chiquita Reaction Area Tracking of Fissures and Tension Cracks  
1

**Fissure or Tension Crack Found?**

Yes

**Using the attached image, annotate all areas where inspectors identified a fissure or tension crack.**



**Grid Location**

146

**Date and Time Found**

10 Nov 2025 9:18 AM PST

**Image of Fissure/Tension Crack**



Photo 1



Photo 2



Photo 3



Photo 4

**Length of crack (ft) or area containing multiple cracks (ft x ft)**

40ft x 15ft

**Horizontal Offset (width)**

Small 0.5-2" in width

**Vertical Offset (height)**

Extra small <0.5" in height

**Orientation (direction)**

N to S

**Location**

Castaic CA 91384  
United States  
(34.436072772400856,  
-118.64689718942962)

**Was Fissure or Crack fixed? If yes, add photo and description of repairs performed**

Yes



Photo 5

**Date and time of repairs**

10 Nov 2025 9:58 AM PST

**Description of repairs**

Cracks were track walked.

Instability

**Are there any indications of slope stability concerns?**

No

# 4050 - Chiquita Reaction Area Tracking of Fissures and Tension Cracks

11 Nov 2025 / Tom Roe

Complete

Conducted on

11 Nov 2025 10:17 AM PST

Prepared by

Tom Roe

## Chiquita Reaction Area Tracking of Fissures and Tension Cracks

Chiquita Reaction Area Tracking of Fissures and Tension Cracks

Chiquita Reaction Area Tracking of Fissures and Tension Cracks  
1

**Fissure or Tension Crack Found?**

No

Grid 147



Photo 1

Instability

**Are there any indications of slope stability concerns?**

No

# 4050 - Chiquita Reaction Area Tracking of Fissures and Tension Cracks

12 Nov 2025 / Tom Roe

Complete

Conducted on

12 Nov 2025 9:12 AM PST

Prepared by

Tom Roe

## Chiquita Reaction Area Tracking of Fissures and Tension Cracks

Chiquita Reaction Area Tracking of Fissures and Tension Cracks

Chiquita Reaction Area Tracking of Fissures and Tension Cracks  
1

**Fissure or Tension Crack Found?**

Yes

**Using the attached image, annotate all areas where inspectors identified a fissure or tension crack.**



**Grid Location**

146

**Date and Time Found**

12 Nov 2025 9:15 AM PST

**Image of Fissure/Tension Crack**



Photo 1



Photo 2



Photo 3

**Length of crack (ft) or area containing multiple cracks (ft x ft)**

8ft x 25ft

**Horizontal Offset (width)**

Small 0.5-2" in width

**Vertical Offset (height)**

Extra small <0.5" in height

**Orientation (direction)**

NW to SE

**Location**

Castaic CA 91384  
United States  
(34.43648100738489,  
-118.64679440910662)

**Was Fissure or Crack fixed? If yes, add photo and description of repairs performed**

Yes



Photo 4

**Date and time of repairs**

12 Nov 2025 10:06 AM PST

**Description of repairs**

Cracks were track walked.

Instability

**Are there any indications of slope stability concerns?**

No

# 4050 - Chiquita Reaction Area Tracking of Fissures and Tension Cracks

13 Nov 2025 / John Boucher

Complete

Conducted on

13 Nov 2025 9:52 AM PST

Prepared by

John Boucher

## Chiquita Reaction Area Tracking of Fissures and Tension Cracks

## Chiquita Reaction Area Tracking of Fissures and Tension Cracks

# Chiquita Reaction Area Tracking of Fissures and Tension Cracks

## **Fissure or Tension Crack Found?**

Yes

**Using the attached image, annotate all areas where inspectors identified a fissure or tension crack.**



## Grid Location

89

#### Date and Time Found

13 Nov 2025 11:11 AM PST

## Image of Fissure/Tension Crack



Photo 1



Photo 2



Photo 3



Photo 4

**Length of crack (ft) or area containing multiple cracks (ft x ft)**

25ftx4ft area

**Horizontal Offset (width)**

Small 0.5-2" in width

**Vertical Offset (height)**

Extra small <0.5" in height

**Orientation (direction)**

NE to SW

**Location**

Castaic CA 91384  
United States  
(34.43305905430511,  
-118.64750840127373)

**Was Fissure or Crack fixed? If yes, add photo and description of repairs performed**

Yes



Photo 5

**Date and time of repairs**

13 Nov 2025 12:08 PM PST

**Description of repairs**


Cracks were track walked.

Chiquita Reaction Area Tracking of Fissures and Tension Cracks  
2

**Fissure or Tension Crack Found?**

Yes

Using the attached image, annotate all areas where inspectors identified a fissure or tension crack.

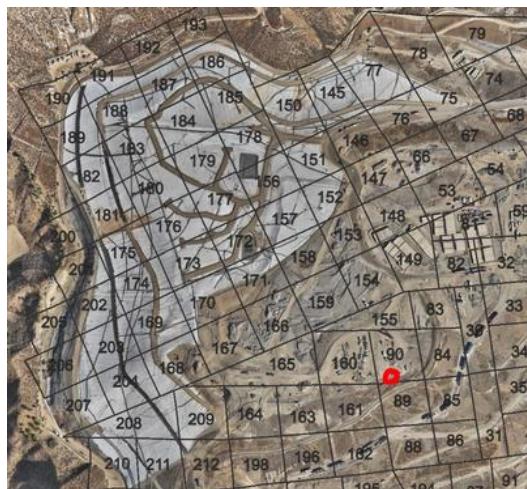

**Grid Location**

90

**Date and Time Found**

13 Nov 2025 11:53 AM PST

**Image of Fissure/Tension Crack**



Photo 6

**Length of crack (ft) or area containing multiple cracks (ft x ft)**

9ft

**Horizontal Offset (width)**

Small 0.5-2" in width

**Vertical Offset (height)**

Extra small <0.5" in height

Orientation (direction)

N to S

Location

Valencia CA 91355  
United States  
(34.429690773052,  
-118.64505754432885)

Was Fissure or Crack fixed? If yes, add photo and description of repairs performed

Yes



Photo 7



Photo 8

Date and time of repairs

13 Nov 2025 12:12 PM PST

Description of repairs


Cracks were track walked.

Chiquita Reaction Area Tracking of Fissures and Tension Cracks  
3

Fissure or Tension Crack Found?

Yes

Using the attached image, annotate all areas where inspectors identified a fissure or tension crack.

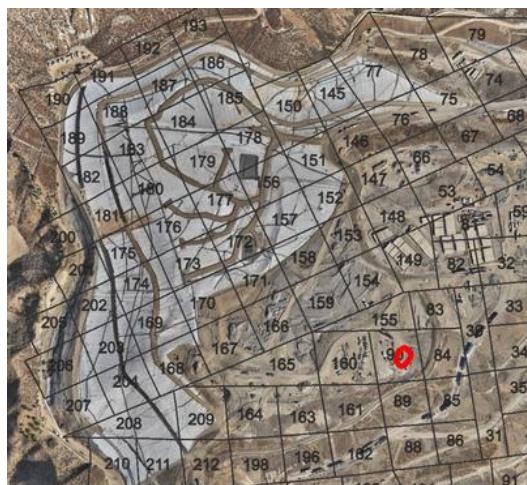

**Grid Location**

90

**Date and Time Found**

13 Nov 2025 11:55 AM PST

**Image of Fissure/Tension Crack**



Photo 9



Photo 10



Photo 11

**Length of crack (ft) or area containing multiple cracks (ft x ft)**

17ftx6ft area

**Horizontal Offset (width)**

Small 0.5-2" in width

**Vertical Offset (height)**

Extra small <0.5" in height

**Orientation (direction)**

E to W

**Location**

Castaic CA 91384  
United States  
(34.431958013057134,  
-118.6456645832425)

**Was Fissure or Crack fixed? If yes, add photo and description of repairs performed**

Yes



Photo 12

**Date and time of repairs**

13 Nov 2025 12:18 PM PST

**Description of repairs**

Cracks were track walked.

Instability

**Are there any indications of slope stability concerns?**

No

# 4050 - Chiquita Reaction Area Tracking of Fissures and Tension Cracks

14 Nov 2025 / John Boucher

Complete

Conducted on

14 Nov 2025 10:04 AM PST

Prepared by

John Boucher

## Chiquita Reaction Area Tracking of Fissures and Tension Cracks

Chiquita Reaction Area Tracking of Fissures and Tension Cracks

Chiquita Reaction Area Tracking of Fissures and Tension Cracks  
1

**Fissure or Tension Crack Found?**

No

Grid 147



Photo 1

Instability

**Are there any indications of slope stability concerns?**

No

# 4050 - Chiquita Reaction Area Tracking of Fissures and Tension Cracks

15 Nov 2025 / John Boucher

Complete

Conducted on

15 Nov 2025 8:16 AM PST

Prepared by

John Boucher

## Chiquita Reaction Area Tracking of Fissures and Tension Cracks

Chiquita Reaction Area Tracking of Fissures and Tension Cracks

Chiquita Reaction Area Tracking of Fissures and Tension Cracks  
1

**Fissure or Tension Crack Found?**

No

Grid 148



Photo 1

Instability

**Are there any indications of slope stability concerns?**

No

# **Settlement**

**The bi-weekly drone flyover was not conducted this week. The drone data from the next flyover event will be included in the next weekly report.**

# **Geosynthetic Cover**

# 4050 - Geosynthetic Cover Inspection

10 Nov 2025 / Tom Roe

Complete

Flagged items

0

Conducted on

10 Nov 2025 9:08 AM PST

Prepared by

Tom Roe

## Identification of Issues

Identified Issue

Identified Issue 1

**Are there any issues with the geosynthetic cover?**

No



Photo 1



Photo 2



Photo 3



Photo 4

Instability under the cover

**Are there any anomalous (unusual or unexpected) areas of cover damage or deformation that may indicate underlying instability?**

No

**Are there any signs of a downslope tension crack at the top of the slope or bulging at or near the toe of the slope?**

No

**Is there any movement of the equipment that vertically penetrates the cover (e.g., tilting)?**

No

# 4050 - Geosynthetic Cover Inspection

11 Nov 2025 / Tom Roe

Complete

Flagged items

0

Conducted on

11 Nov 2025 7:18 AM PST

Prepared by

Tom Roe

## Identification of Issues

Identified Issue

Identified Issue 1

**Are there any issues with the geosynthetic cover?**

No



Photo 1



Photo 2



Photo 3



Photo 4

Instability under the cover

**Are there any anomalous (unusual or unexpected) areas of cover damage or deformation that may indicate underlying instability?**

No

**Are there any signs of a downslope tension crack at the top of the slope or bulging at or near the toe of the slope?**

No

**Is there any movement of the equipment that vertically penetrates the cover (e.g., tilting)?**

No

# 4050 - Geosynthetic Cover Inspection

12 Nov 2025 / Tom Roe

Complete

Flagged items

0

Conducted on

12 Nov 2025 9:27 AM PST

Prepared by

Tom Roe

## Identification of Issues

Identified Issue

Identified Issue 1

**Are there any issues with the geosynthetic cover?**

No



Photo 1



Photo 2



Photo 3



Photo 4

Instability under the cover

**Are there any anomalous (unusual or unexpected) areas of cover damage or deformation that may indicate underlying instability?**

No

**Are there any signs of a downslope tension crack at the top of the slope or bulging at or near the toe of the slope?**

No

**Is there any movement of the equipment that vertically penetrates the cover (e.g., tilting)?**

No

# 4050 - Geosynthetic Cover Inspection

13 Nov 2025 / John Boucher

Complete

Flagged items

0

Conducted on

13 Nov 2025 11:27 AM PST

Prepared by

John Boucher

## Identification of Issues

Identified Issue

Identified Issue 1

**Are there any issues with the geosynthetic cover?**

No



Photo 1



Photo 2



Photo 3



Photo 4



Photo 5

Instability under the cover

**Are there any anomalous (unusual or unexpected) areas of cover damage or deformation that may indicate underlying instability?**

No

**Are there any signs of a downslope tension crack at the top of the slope or bulging at or near the toe of the slope?**

No

**Is there any movement of the equipment that vertically penetrates the cover (e.g., tilting)?**

No

# 4050 - Geosynthetic Cover Inspection

14 Nov 2025 / John Boucher

Complete

Flagged items

0

Conducted on

14 Nov 2025 10:31 AM PST

Prepared by

John Boucher

## Identification of Issues

Identified Issue

Identified Issue 1

**Are there any issues with the geosynthetic cover?**

No



Photo 1



Photo 2



Photo 3



Photo 4



Photo 5

Instability under the cover

**Are there any anomalous (unusual or unexpected) areas of cover damage or deformation that may indicate underlying instability?**

No

**Are there any signs of a downslope tension crack at the top of the slope or bulging at or near the toe of the slope?**

No

**Is there any movement of the equipment that vertically penetrates the cover (e.g., tilting)?**

No

# 4050 - Geosynthetic Cover Inspection

15 Nov 2025 / John Boucher

Complete

Flagged items

0

Conducted on

15 Nov 2025 8:16 AM PST

Prepared by

John Boucher

## Identification of Issues

Identified Issue

Identified Issue 1

**Are there any issues with the geosynthetic cover?**

No



Photo 1



Photo 2



Photo 3



Photo 4



Photo 5

Instability under the cover

**Are there any anomalous (unusual or unexpected) areas of**

No

cover damage or deformation that may indicate underlying instability?	
Are there any signs of a downslope tension crack at the top of the slope or bulging at or near the toe of the slope?	No
Is there any movement of the equipment that vertically penetrates the cover (e.g., tilting)?	No