

From: Medina, Steven <SMedina@scsengineers.com>
Sent: Tuesday, December 23, 2025 4:59 PM
To: bchen@aqmd.gov; ndickel@aqmd.gov; Christina Ojeda
Cc: Haley, William (Bill); Amanda Froman; Christopher.Fear@WasteConnections.com; Viswanathan, Srividhya; Kate Logan; Mark.Adams; Han, Jessie
Subject: Re: Case No. 6177-4 Stipulated Order for Abatement - Weekly Pump Installation and operation update
Attachments: 2025 CCLF Existing De-Watering Well with Pump Map_2025-12-23.pdf

[EXTERNAL SENDER: Use caution with links/attachments]

All,

In accordance with Condition 65 of the Modified Stipulated Order, below is the summary of the installation and operation of dewatering pumps for the Chiquita Canyon Landfill. This information is subject to change based on further review and verification.

This summary is being submitted early because no dewatering pumps will be installed in vertical LFG extraction wells from December 24-25, 2025, due to the Christmas holiday.

During 12/19/2025 to 12/25/2025, Chiquita completed the installation of, and began operating during the day, two (2) pumps in a vertical LFG extraction well for a total of one hundred and forty-three (143) pumps operating in vertical LFG extraction wells. Please refer to the attached, up-to-date map of LFG wells with operating pumps.

During 12/26/2025 to 01/01/2026, given the number of dewatering pumps installed to date, and the maintenance associated with those pumps, Chiquita plans to install and begin operating an additional two (2) pumps in vertical LFG extraction wells in locations along the north and south slope of the reaction area. The pump installation locations for next week are subject to change due to weather and/or safety conditions.


Regards,

STEVEN Ruben Medina, **E.I.T.**
Staff Professional
SCS Engineers
3900 Kilroy Airport Way, Suite 300
Long Beach, CA 90806
858-204-4342 (c)
SMedina@scsengineers.com

Driven by Client Success
www.scsengineers.com

*2024 Conrad Quality Focus
Award Recipient*



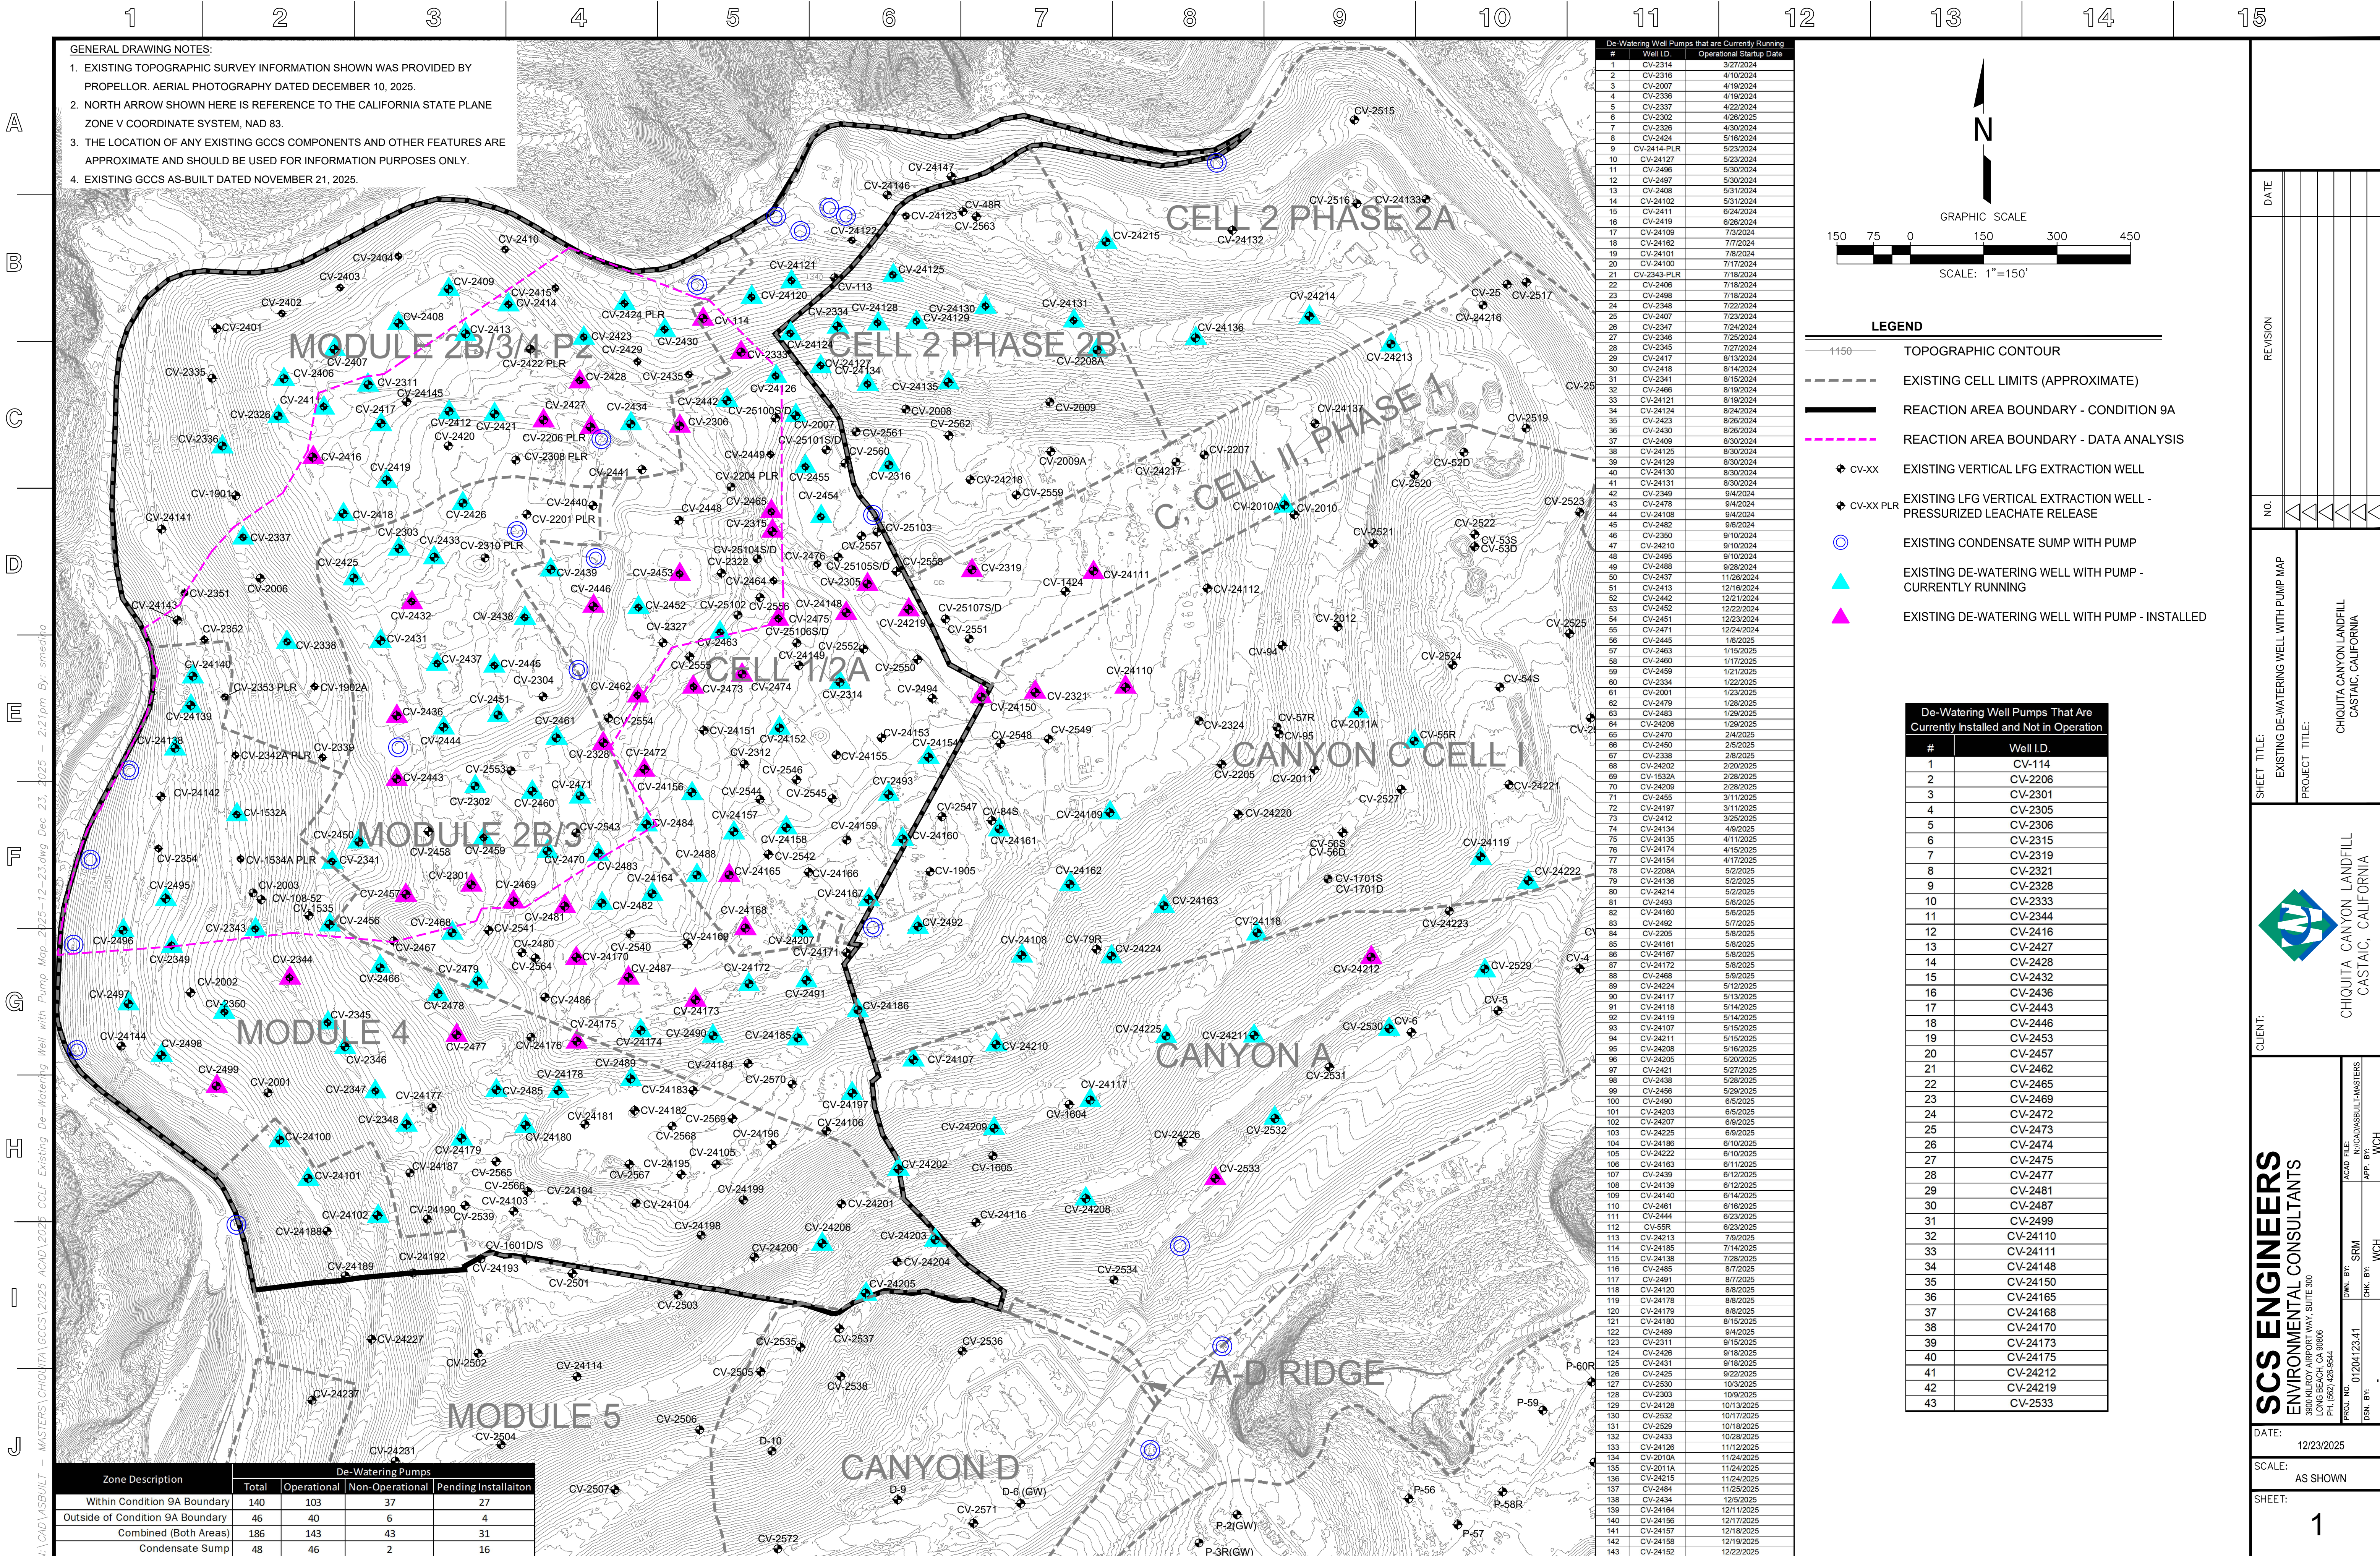

Zone Description

Zone Description	De-Watering Pumps			
	Total	Operational	Non-Operational	Pending Installation
Within Condition 9A Boundary	140	103	37	27
Outside of Condition 9A Boundary	46	40	6	4
Combined (Both Areas)	186	143	43	31
Condensate Sump	48	46	2	16

CLIENT:

CHIQUITA CANYON LANDFILL
CASTAIC, CALIFORNIA

PROJECT TITLE:

EXISTING DE-WATERING WELL WITH PUMP MAP

SHEET TITLE:

EXISTING DE-WATERING WELL WITH PUMP MAP

DATE:

12/23/2025

SCALE:

AS SHOWN

SHEET:

1