


Archived: Thursday, February 26, 2026 9:34:00 AM
From: [Han, Jessie](#)
Sent: Friday, February 20, 2026 11:56:59 AM
To: bchen@aqmd.gov
Cc: [Haley, William \(Bill\)](#)
Subject: RE: Case No. 6177-4 Stipulated Order for Abatement – Well Drilling Update
Importance: Normal
Sensitivity: None
Attachments: [2025 CCLF GCCS Expan Master Plan_Proposed LFG Extraction Well and Temp Probe Map_2026-02-20.pdf](#) 

[EXTERNAL SENDER: Use caution with links/attachments]

All,

In accordance with Condition 15(c) of the Stipulated Order, below is the up-to-date construction summary for the Chiquita Canyon Landfill 2025 GCCS Expansion Master Plan Project.

During 02/16/2026 to 02/20/2026, Chiquita completed the installation of zero (0) vertical LFG extraction wells. The total count of vertical LFG extraction wells installed from December 6, 2023 (the start date of the GCCS Master Expansion) through today is three hundred fifteen (315).

During 02/16/2026 to 02/20/2026, Chiquita completed the installation of zero (0) temperature probes. The total count of temperature probes installed from February 26th, 2024 (the start date of the temperature probe installations) through today is forty (40).


The wells and temperature probes scheduled for drilling during the week of 02/23/2026 to 02/27/2026 are as follows (subject to change):


Rig (Continuum): CV-2574 & CV-2575 (BH-GB-2). Well installation locations scheduled for drilling next week are subject to change due to weather and/or safety conditions.

Temperature Probe Rig (Boart Longyear): Drilling of the temperature probes and Soil Vapor Extraction (SVE) wells has been completed.

Jessie Han
SCS Engineers
3900 Kilroy Airport Way, Suite 300
Long Beach, CA 90806
Mobile: 562-508-2497
JHan@scsengineers.com



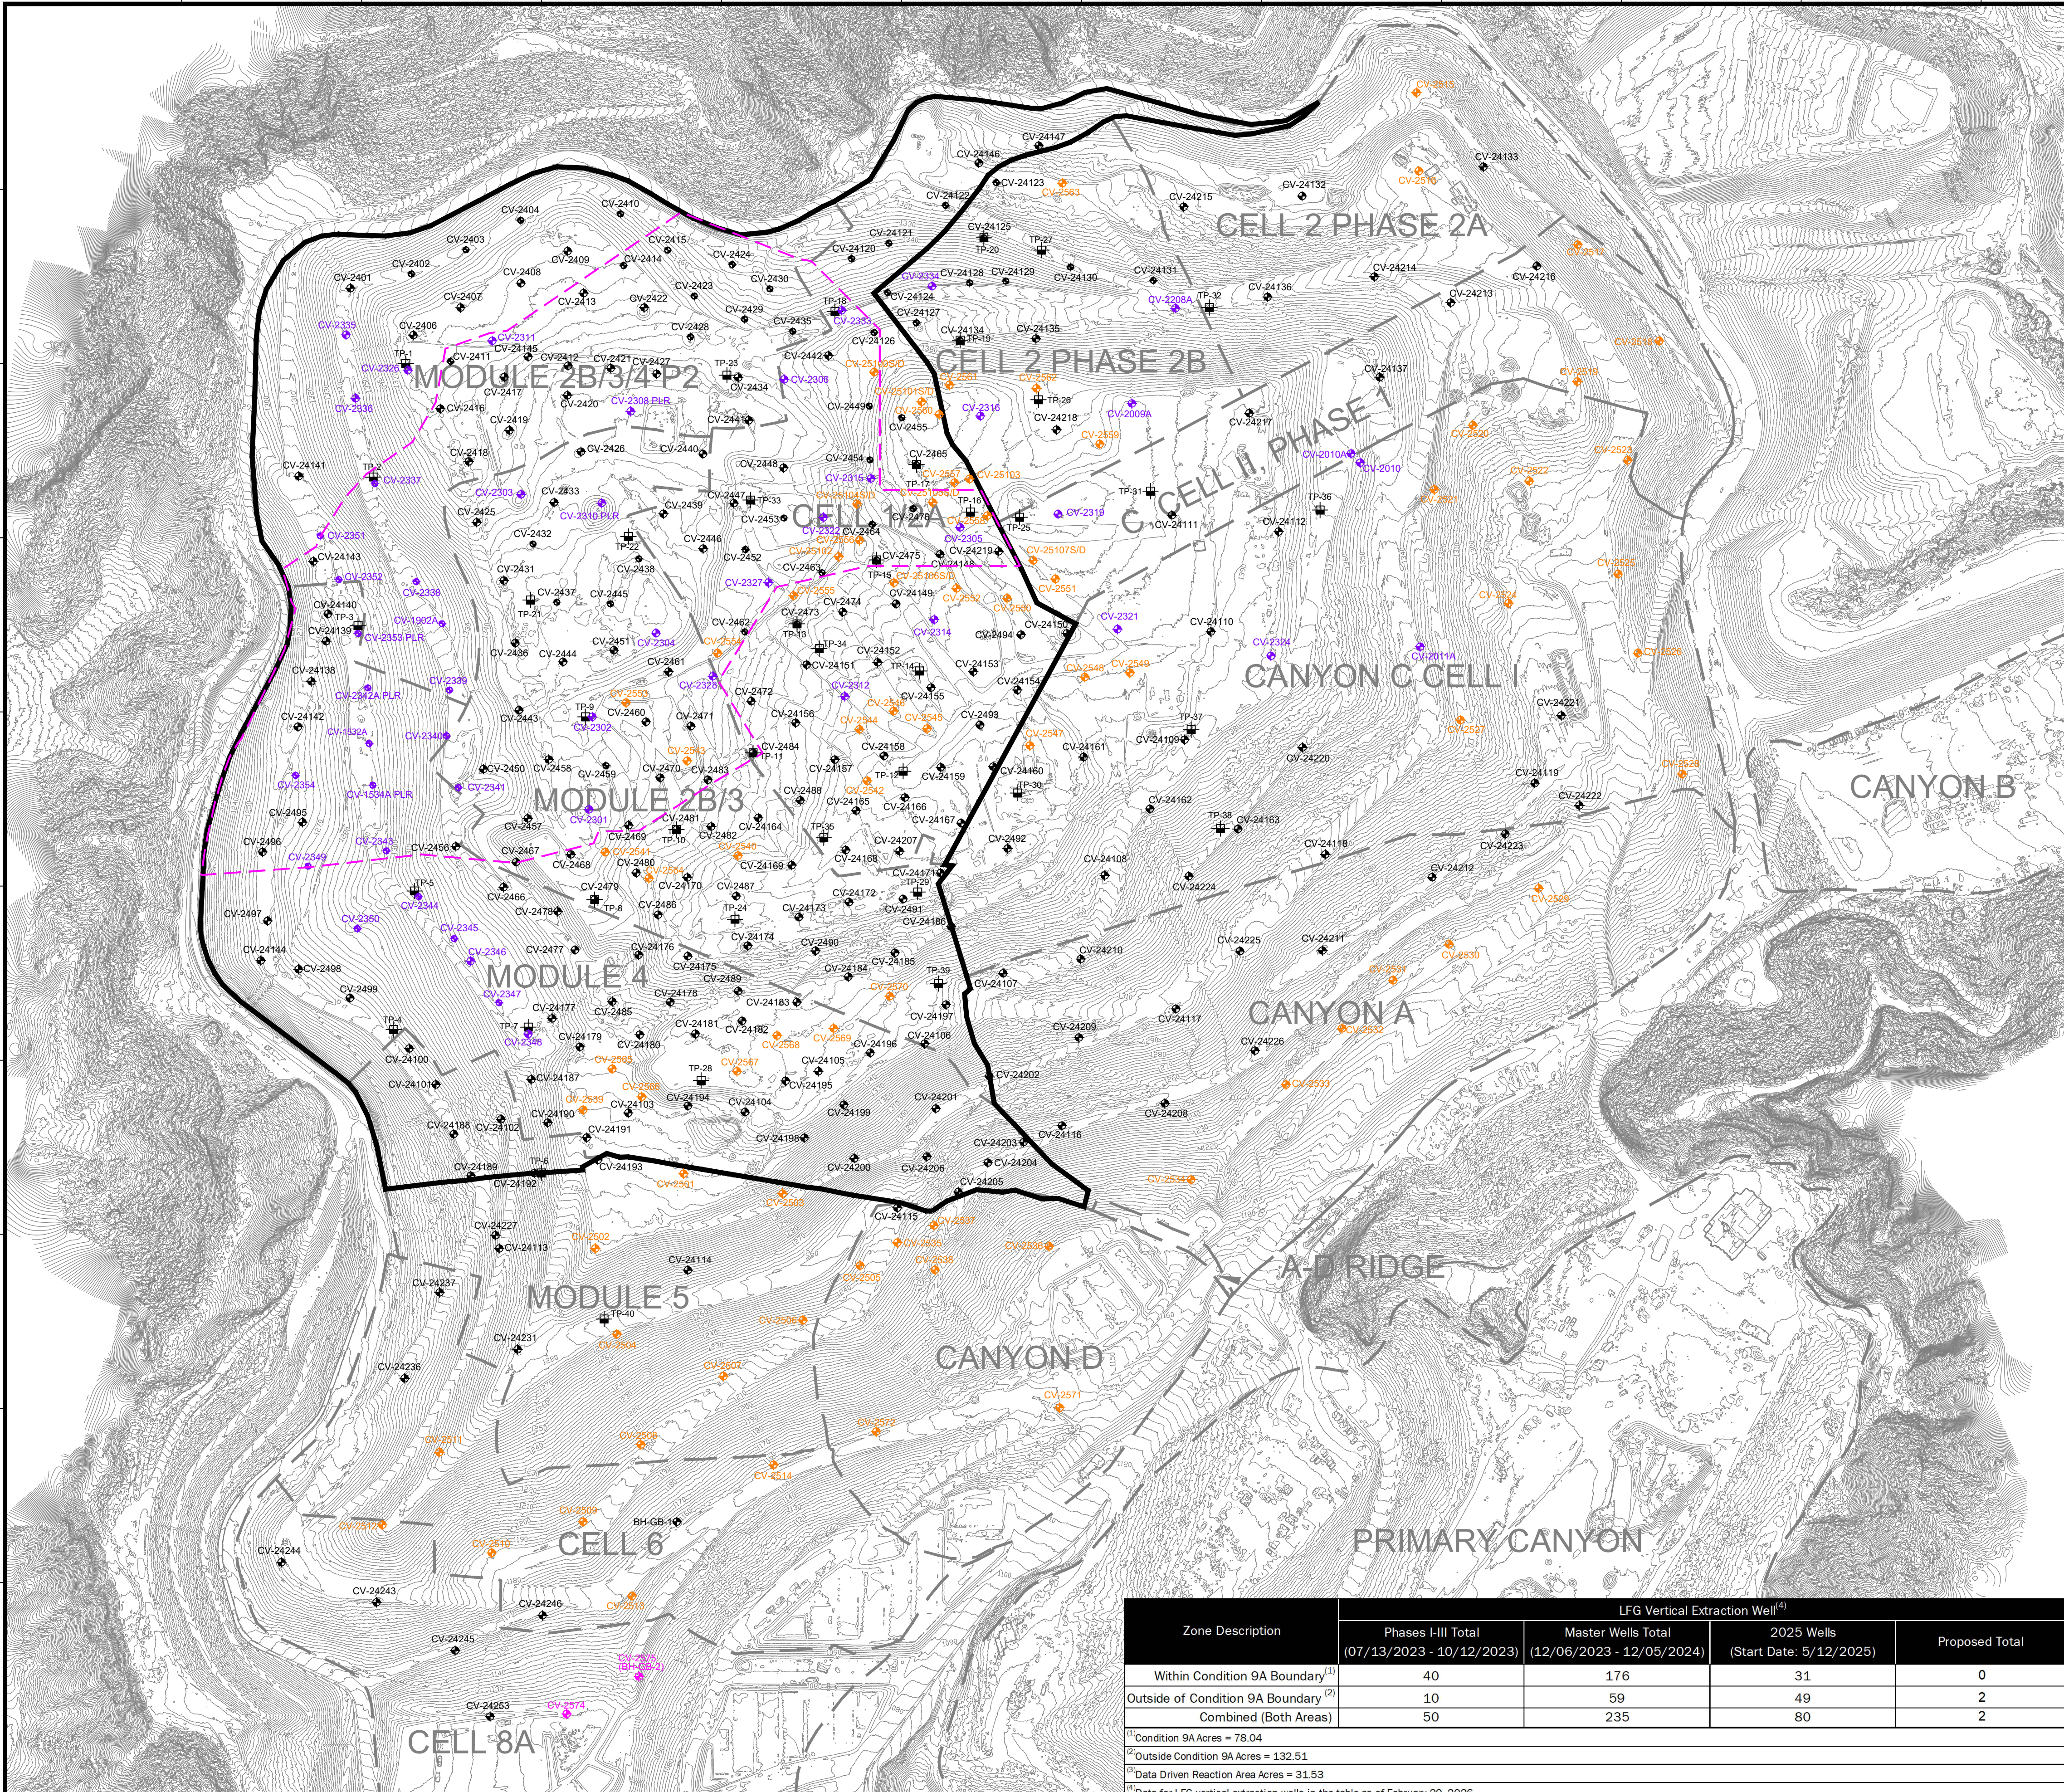






Driven by Client Success
www.scsengineers.com






GRAPHIC SCALE
190 95 0 190 380 570
SCALE: 1"=190'

LEGEND

-  EXISTING TOPOGRAPHIC CONTOUR
-  EXISTING CELL LIMITS (APPROXIMATE)
-  REACTION AREA BOUNDARY (APPROXIMATE) - BASED ON DATA REVIEW
-  REACTION AREA BOUNDARY - CONDITION 9A
-  EXISTING PHASES I-III LFG EXTRACTION WELL - INSTALLED
-  EXISTING MASTER LFG EXTRACTION WELL - INSTALLED
-  EXISTING 2025 LFG EXTRACTION WELL - INSTALLED
-  PROPOSED LFG EXTRACTION WELL SCHEDULED FOR DRILLING DURING THE WEEK OF 02/23/2026 TO 02/27/2026
-  EXISTING TEMPERATURE PROBE - INSTALLED

DATE	
REVISION	
NO.	
SHEET TITLE:	WELL/TEMPERATURE PROBE INSTALLATION MAP
PROJECT TITLE:	2025 GCCS EXPANSION WELL & TEMPERATURE PROBE MASTER PLAN CHIQUITA CANYON LANDFILL CASTAIC, CALIFORNIA
CLIENT:	 CHIQUITA CANYON LANDFILL CASTAIC, CALIFORNIA
DATE:	02/20/2026
SCALE:	AS SHOWN
SHEET:	1

Zone Description	LFG Vertical Extraction Well ⁽⁴⁾			
	Phases I-III Total (07/13/2023 - 10/12/2023)	Master Wells Total (12/06/2023 - 12/05/2024)	2025 Wells (Start Date: 5/12/2025)	Proposed Total
Within Condition 9A Boundary ⁽¹⁾	40	176	31	0
Outside of Condition 9A Boundary ⁽²⁾	10	59	49	2
Combined (Both Areas)	50	235	80	2

⁽¹⁾Condition 9A Acres = 78.04
⁽²⁾Outside Condition 9A Acres = 132.51
⁽³⁾Data Driven Reaction Area Acres = 31.53
⁽⁴⁾Data for LFG vertical extraction wells in the table as of February 20, 2026.

GENERAL DRAWING NOTES:

- EXISTING TOPOGRAPHIC SURVEY INFORMATION SHOWN WAS PROVIDED BY PROPELLER. AERIAL PHOTOGRAPHY DATED FEBRUARY 10, 2026.
- NORTH ARROW SHOWN HERE IS REFERENCE TO THE CALIFORNIA STATE PLANE ZONE V COORDINATE SYSTEM, NAD 83.