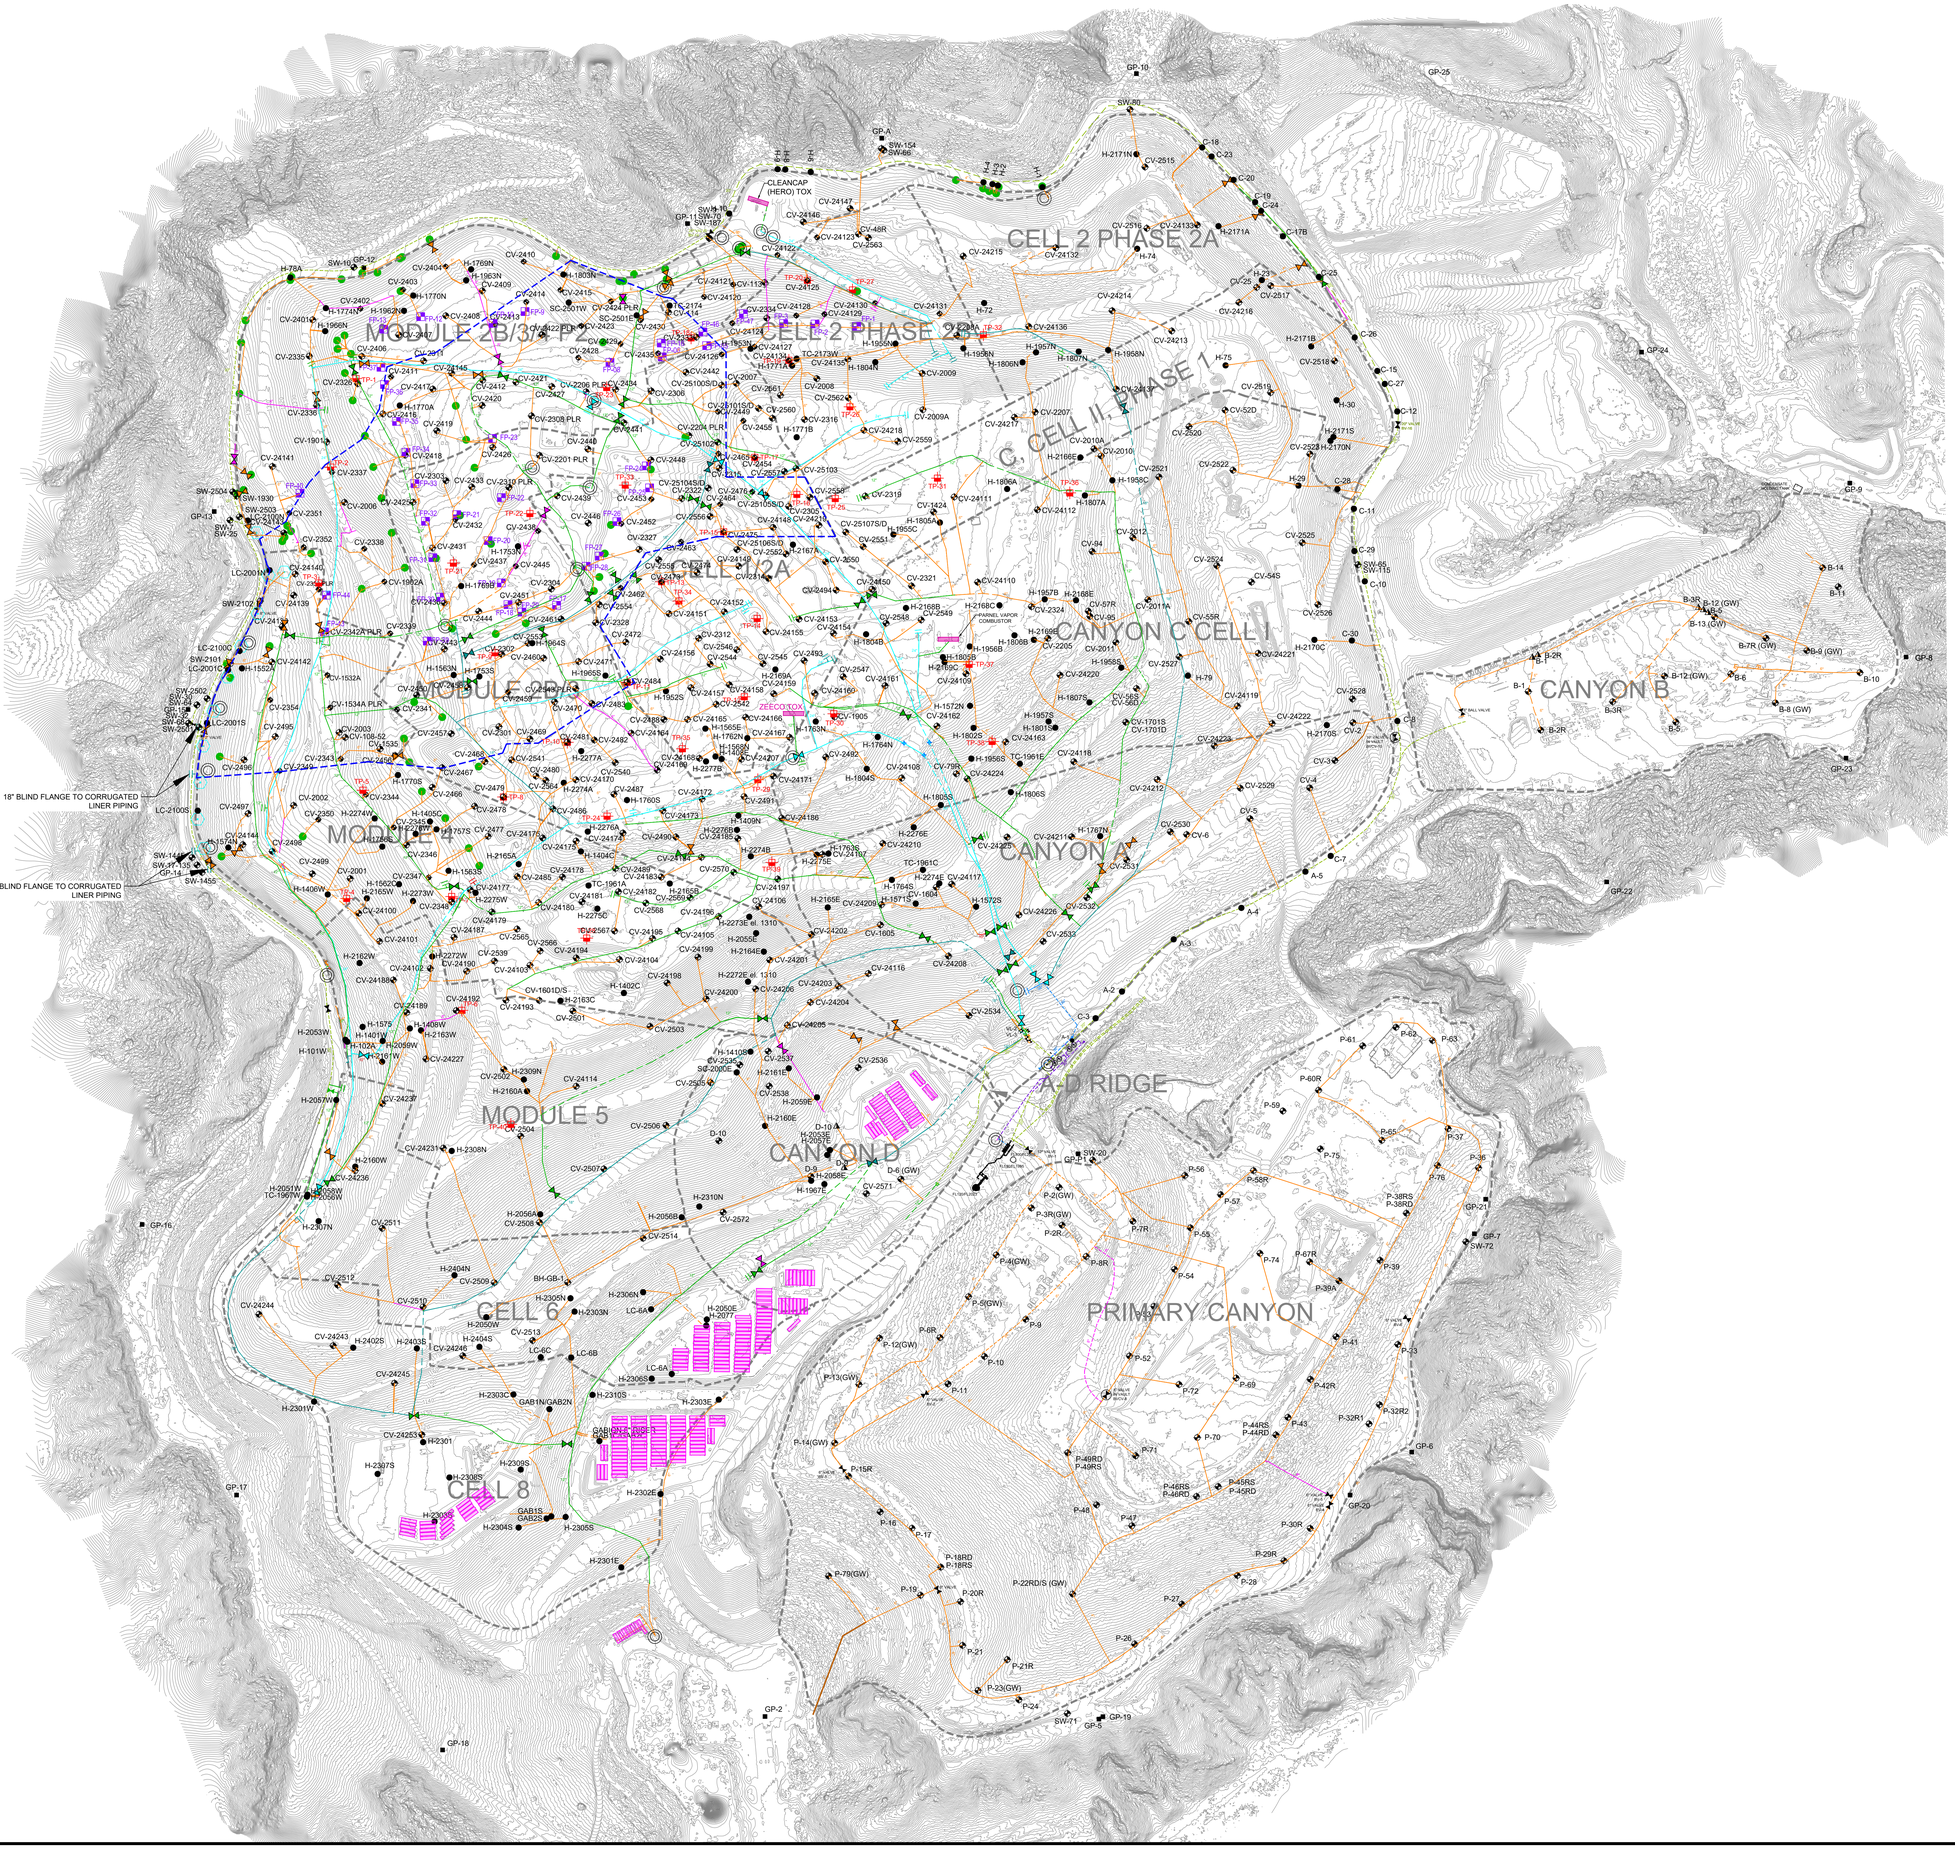

LEGEND

- TOPOGRAPHIC CONTOUR
- EXISTING CELL LIMITS (APPROXIMATE)
- EXISTING LFG VERTICAL EXTRACTION WELL
- EXISTING LFG VERTICAL EXTRACTION WELL - PRESSURIZED LEACHATE RELEASE
- EXISTING GABION LFG COLLECTOR WELL
- EXISTING SOIL VAPOR EXTRACTION WELL
- EXISTING SURFACE COLLECTOR WELLHEAD
- EXISTING HORIZONTAL WELLS
- EXISTING REMOTE VERTICAL WELLHEAD
- EXISTING PERIMETER MIGRATION PROBE
- EXISTING TEMPERATURE PROBE
- EXISTING ISOLATION VALVE
- EXISTING ACTIVATED CARBON VESSEL
- EXISTING CONDENSATE SUMP
- EXISTING HDPE LINER RISER
- EXISTING CORRUGATED LINER RISER
- EXISTING 36" LFG COLLECTION HEADER PIPING
- EXISTING 30" LFG COLLECTION HEADER PIPING
- EXISTING 24" LFG COLLECTION HEADER PIPING
- EXISTING 20" LFG COLLECTION HEADER PIPING
- EXISTING 18" LFG COLLECTION HEADER PIPING
- EXISTING 12" LFG COLLECTION HEADER PIPING
- EXISTING 10" LFG COLLECTION HEADER PIPING
- EXISTING 8" LFG COLLECTION LATERAL PIPING
- EXISTING 4"/6" LFG COLLECTION LATERAL PIPING
- EXISTING 2"/3" LFG COLLECTION LATERAL PIPING
- BELOW-GRADE PIPES ARE SHOWN DASHED
- REACTION AREA BOUNDARY (APPROXIMATE) - BASED ON DATA REVIEW
- EXISTING BLIND FLANGE
- EXISTING FRAC TANKS

GENERAL DRAWING NOTES:

1. EXISTING TOPOGRAPHIC SURVEY INFORMATION SHOWN WAS PROVIDED BY PROPELLOR. AERIAL PHOTOGRAPHY DATED FEBRUARY 10, 2026.
2. NORTH ARROW SHOWN HERE IS REFERENCE TO THE CALIFORNIA STATE PLANE ZONE V COORDINATE SYSTEM, NAD 83.
3. THE LOCATION OF ANY EXISTING PIPING, VALVES, TIE-IN LOCATIONS AND OTHER FEATURES ARE APPROXIMATE AND SHOULD BE USED FOR INFORMATION PURPOSES ONLY. ACTUAL FIELD CONDITIONS MAY VARY AND SUBJECT TO CHANGE BASED ON TOPOGRAPHIC FEATURES AND OTHER SITE-SPECIFIC FACTORS.
4. EXISTING GCCS AS-BUILT DATED FEBRUARY 18, 2026.

DATE | REVISION | NO.

SHEET TITLE: EXISTING GCCS MAP

PROJECT TITLE: CHIQUITA CANYON LANDFILL CASTAIC, CALIFORNIA

CLIENT: CHIQUITA CANYON LANDFILL CASTAIC, CALIFORNIA

SCS ENGINEERS
ENVIRONMENTAL CONSULTANTS
3900 KILROY AIRPORT WAY, SUITE 300
LONG BEACH, CA 90806
PH: (562) 426-9544

PROJ. NO: - | DWN. BY: SRM | ACAD. FILE: N:\CAD\ASBUILT-MASTERS\ | APP. BY: -
DSN. BY: - | CHK. BY: -

DATE: 02/18/2026

SCALE: AS SHOWN

1 of 1

N:\CAD\ASBUILT - MASTERS\CHIQUITA\GCCS\CCLF MASTER EXISTING GCCS MAP_2026-02-18.dwg Feb 18, 2026 - 3:02pm By: smedina