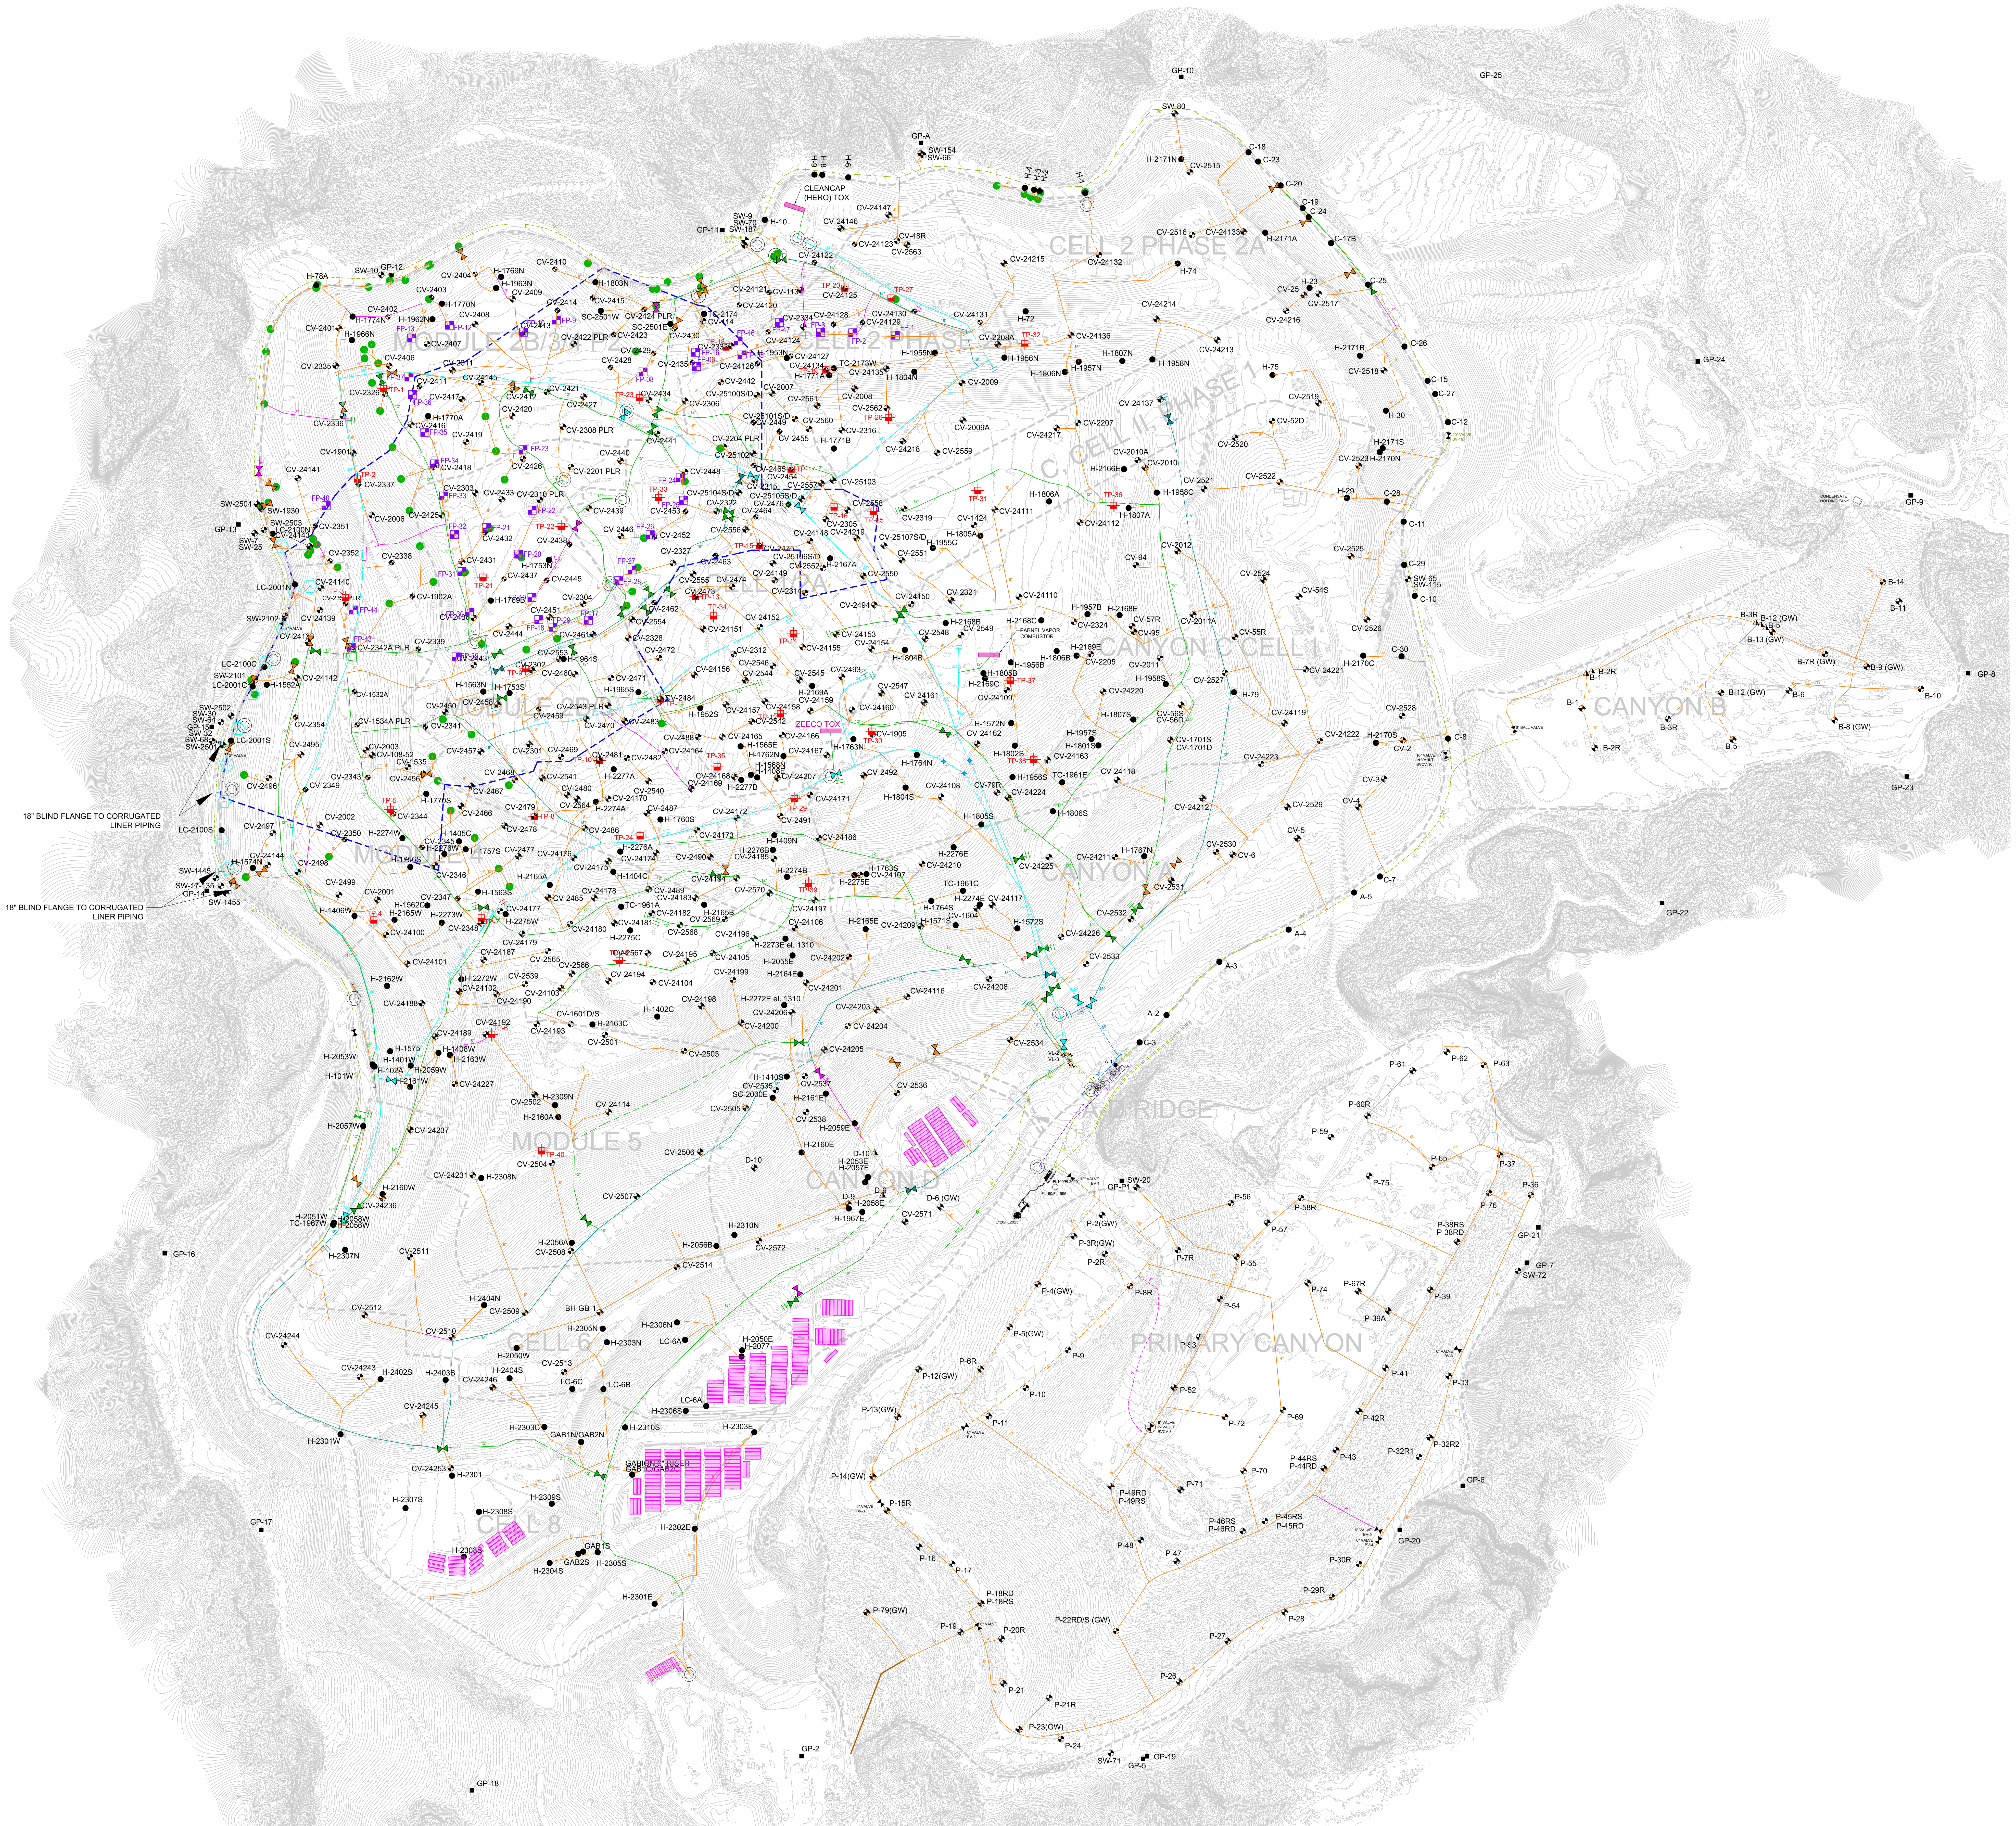

N

GRAPHIC SCALE

150 75 0 150 300 450

SCALE: 1"=150'

LEGEND

Symbol	Description
1150	TOPOGRAPHIC CONTOUR
	EXISTING CELL LIMITS (APPROXIMATE)
CV/B/D/P-XX	EXISTING LFG VERTICAL EXTRACTION WELL - MAIN CANYON, CANYON B, CANYON D, PRIMARY CANYON
CV-XX PLR	EXISTING LFG VERTICAL EXTRACTION WELL - PRESSURIZED LEACHATE RELEASE
BH-GB	EXISTING GABION LFG COLLECTOR WELL
SW-XX	EXISTING SOIL VAPOR EXTRACTION WELL
FP-XX	EXISTING SURFACE COLLECTOR WELLHEAD
H/TC/SC-XX	EXISTING HORIZONTAL, TRENCH, SLOPE, COLLECTOR WELL
C-XX	EXISTING REMOTE VERTICAL WELLHEAD
GP-XX	EXISTING PERIMETER MIGRATION PROBE
TP-XX	EXISTING TEMPERATURE PROBE
	EXISTING ISOLATION VALVE
AC	EXISTING ACTIVATED CARBON VESSEL
	EXISTING CONDENSATE SUMP
	EXISTING HDPE LINER RISER
	EXISTING CORRUGATED LINER RISER
36"	EXISTING 36" LFG COLLECTION HEADER PIPING
30"	EXISTING 30" LFG COLLECTION HEADER PIPING
24"	EXISTING 24" LFG COLLECTION HEADER PIPING
20"	EXISTING 20" LFG COLLECTION HEADER PIPING
18"	EXISTING 18" LFG COLLECTION HEADER PIPING
12"	EXISTING 12" LFG COLLECTION HEADER PIPING
10"	EXISTING 10" LFG COLLECTION HEADER PIPING
8"	EXISTING 8" LFG COLLECTION LATERAL PIPING
4"/6"	EXISTING 4"/6" LFG COLLECTION LATERAL PIPING
	BELOW-GRADE PIPES ARE SHOWN DASHED
	REACTION AREA BOUNDARY (APPROXIMATE) - BASED ON DATA REVIEW
	EXISTING BLIND FLANGE
	EXISTING FRAC TANKS

GENERAL DRAWING NOTES:

1. EXISTING TOPOGRAPHIC SURVEY INFORMATION SHOWN WAS PROVIDED BY PROPELLOR. AERIAL PHOTOGRAPHY DATED MAY 06, 2026.
2. NORTH ARROW SHOWN HERE IS REFERENCE TO THE CALIFORNIA STATE PLANE ZONE V COORDINATE SYSTEM, NAD 83.
3. THE LOCATION OF ANY EXISTING PIPING, VALVES, TIE-IN LOCATIONS AND OTHER FEATURES ARE APPROXIMATE AND SHOULD BE USED FOR INFORMATION PURPOSES ONLY. ACTUAL FIELD CONDITIONS MAY VARY AND SUBJECT TO CHANGE BASED ON TOPOGRAPHIC FEATURES AND OTHER SITE-SPECIFIC FACTORS.
4. EXISTING GCCS AS-BUILT DATED MAY 13, 2026.

DATE | REVISION | NO.

SHEET TITLE: EXISTING GCCS MAP

PROJECT TITLE: CHIQUITA CANYON LANDFILL
CASTAIC, CALIFORNIA

CLIENT: CHIQUITA CANYON LANDFILL
CASTAIC, CALIFORNIA

SCS ENGINEERS
ENVIRONMENTAL CONSULTANTS
3900 KILROY AIRPORT WAY, SUITE 300
LONG BEACH, CA 90806
PH. (562) 426-9544

PROJ. NO. - | DSN. BY: - | DWN. BY: SRM | CHK. BY: - | ACAD FILE: N://CAD/ASBUILT-MASTERS | APP. BY: -

DATE: 05/13/2026

SCALE: AS SHOWN

1 of 1

N:\CAD\ASBUILT - MASTERS\CHIQUITA\GCCS\CCLF MASTER EXISTING GCCS MAP_2026-05-13.dwg May 13, 2026 - 11:12am By: smedina