

Archived: Thursday, August 6, 2026 6:40:52 PM
From: WILLIAM.HALEY@WasteConnections.com
Sent: Friday, July 31, 2026 1:09:45 PM
To: [Karen Gork](#)
Cc: Todd.Thalhamer@Calrecycle.ca.gov
Subject: Re: Chiquita Canyon Landfill – Geosynthetic Cover – Mitigation Measure 4.1
Importance: Normal
Sensitivity: None
Attachments: [RM22.1077-CCL-EVOH-FIG 1-\(2026-07-30\).pdf](#)  [CLF Reaction Area _Reactive Wells_2026-07-20.pdf](#) 
[Milestone 2B Chiquita Canyon LF Isopach_June.2026.pdf](#) 

Below is Chiquita's weekly update on the status of the installation of the 60-mil EVOH/HDPE geomembrane cover at the Chiquita Canyon Landfill, in accordance with Mitigation Measure 4.1 of the LEA's Compliance Order issued May 1, 2025.

As of July 24, 2026, D&E, on behalf of Chiquita, D&E has installed approximately 3,050,016 square feet of tan 60-mil EVOH/HDPE geomembrane cover. Of this total, approximately 736,689 square feet has been deployed on top of the existing 30mil geomembrane to augment its effectiveness. Work conducted the week of July 20 also included repairs and detailing of existing panels, including boot fabrication, patching, extrusion welding, and re-seaming, as needed. Work continued during the week of July 27, 2026.

The attached site map shows the approximate extent of geomembrane cover installed as of Wednesday, July 22, 2026, as well as the geomembrane coverage described in the revised draft workplan for extension of the geomembrane cover area submitted to the LEA, the US EPA, and DTSC on March 13, 2026. Also attached to this submission are the June 2026 monthly isopach map and a figure identifying wells showing signs of reaction as of July 20, 2026 based on the June Reaction Mitigation Area. Due to technical limitations, we are currently unable to create one figure including all of this data.

Thank you,

Bill Haley


Sr. Project Engineer


O: 661.257.3655 | C: 661.964.5821

Waste Connections | 29201 Henry Mayo Dr. | Castaic, CA 91384


Connect With the Future © www.wasteconnections.com

P:\SITES\CHIQUITA CYN LF\MONITORING SUMMARY\FIGURES-WEEKLY\RM22.1077-CCL-EVOH-FIG 1--(2026-07-30).DWG July 30, 2026 - 4:29 PM BY: GLA--USER

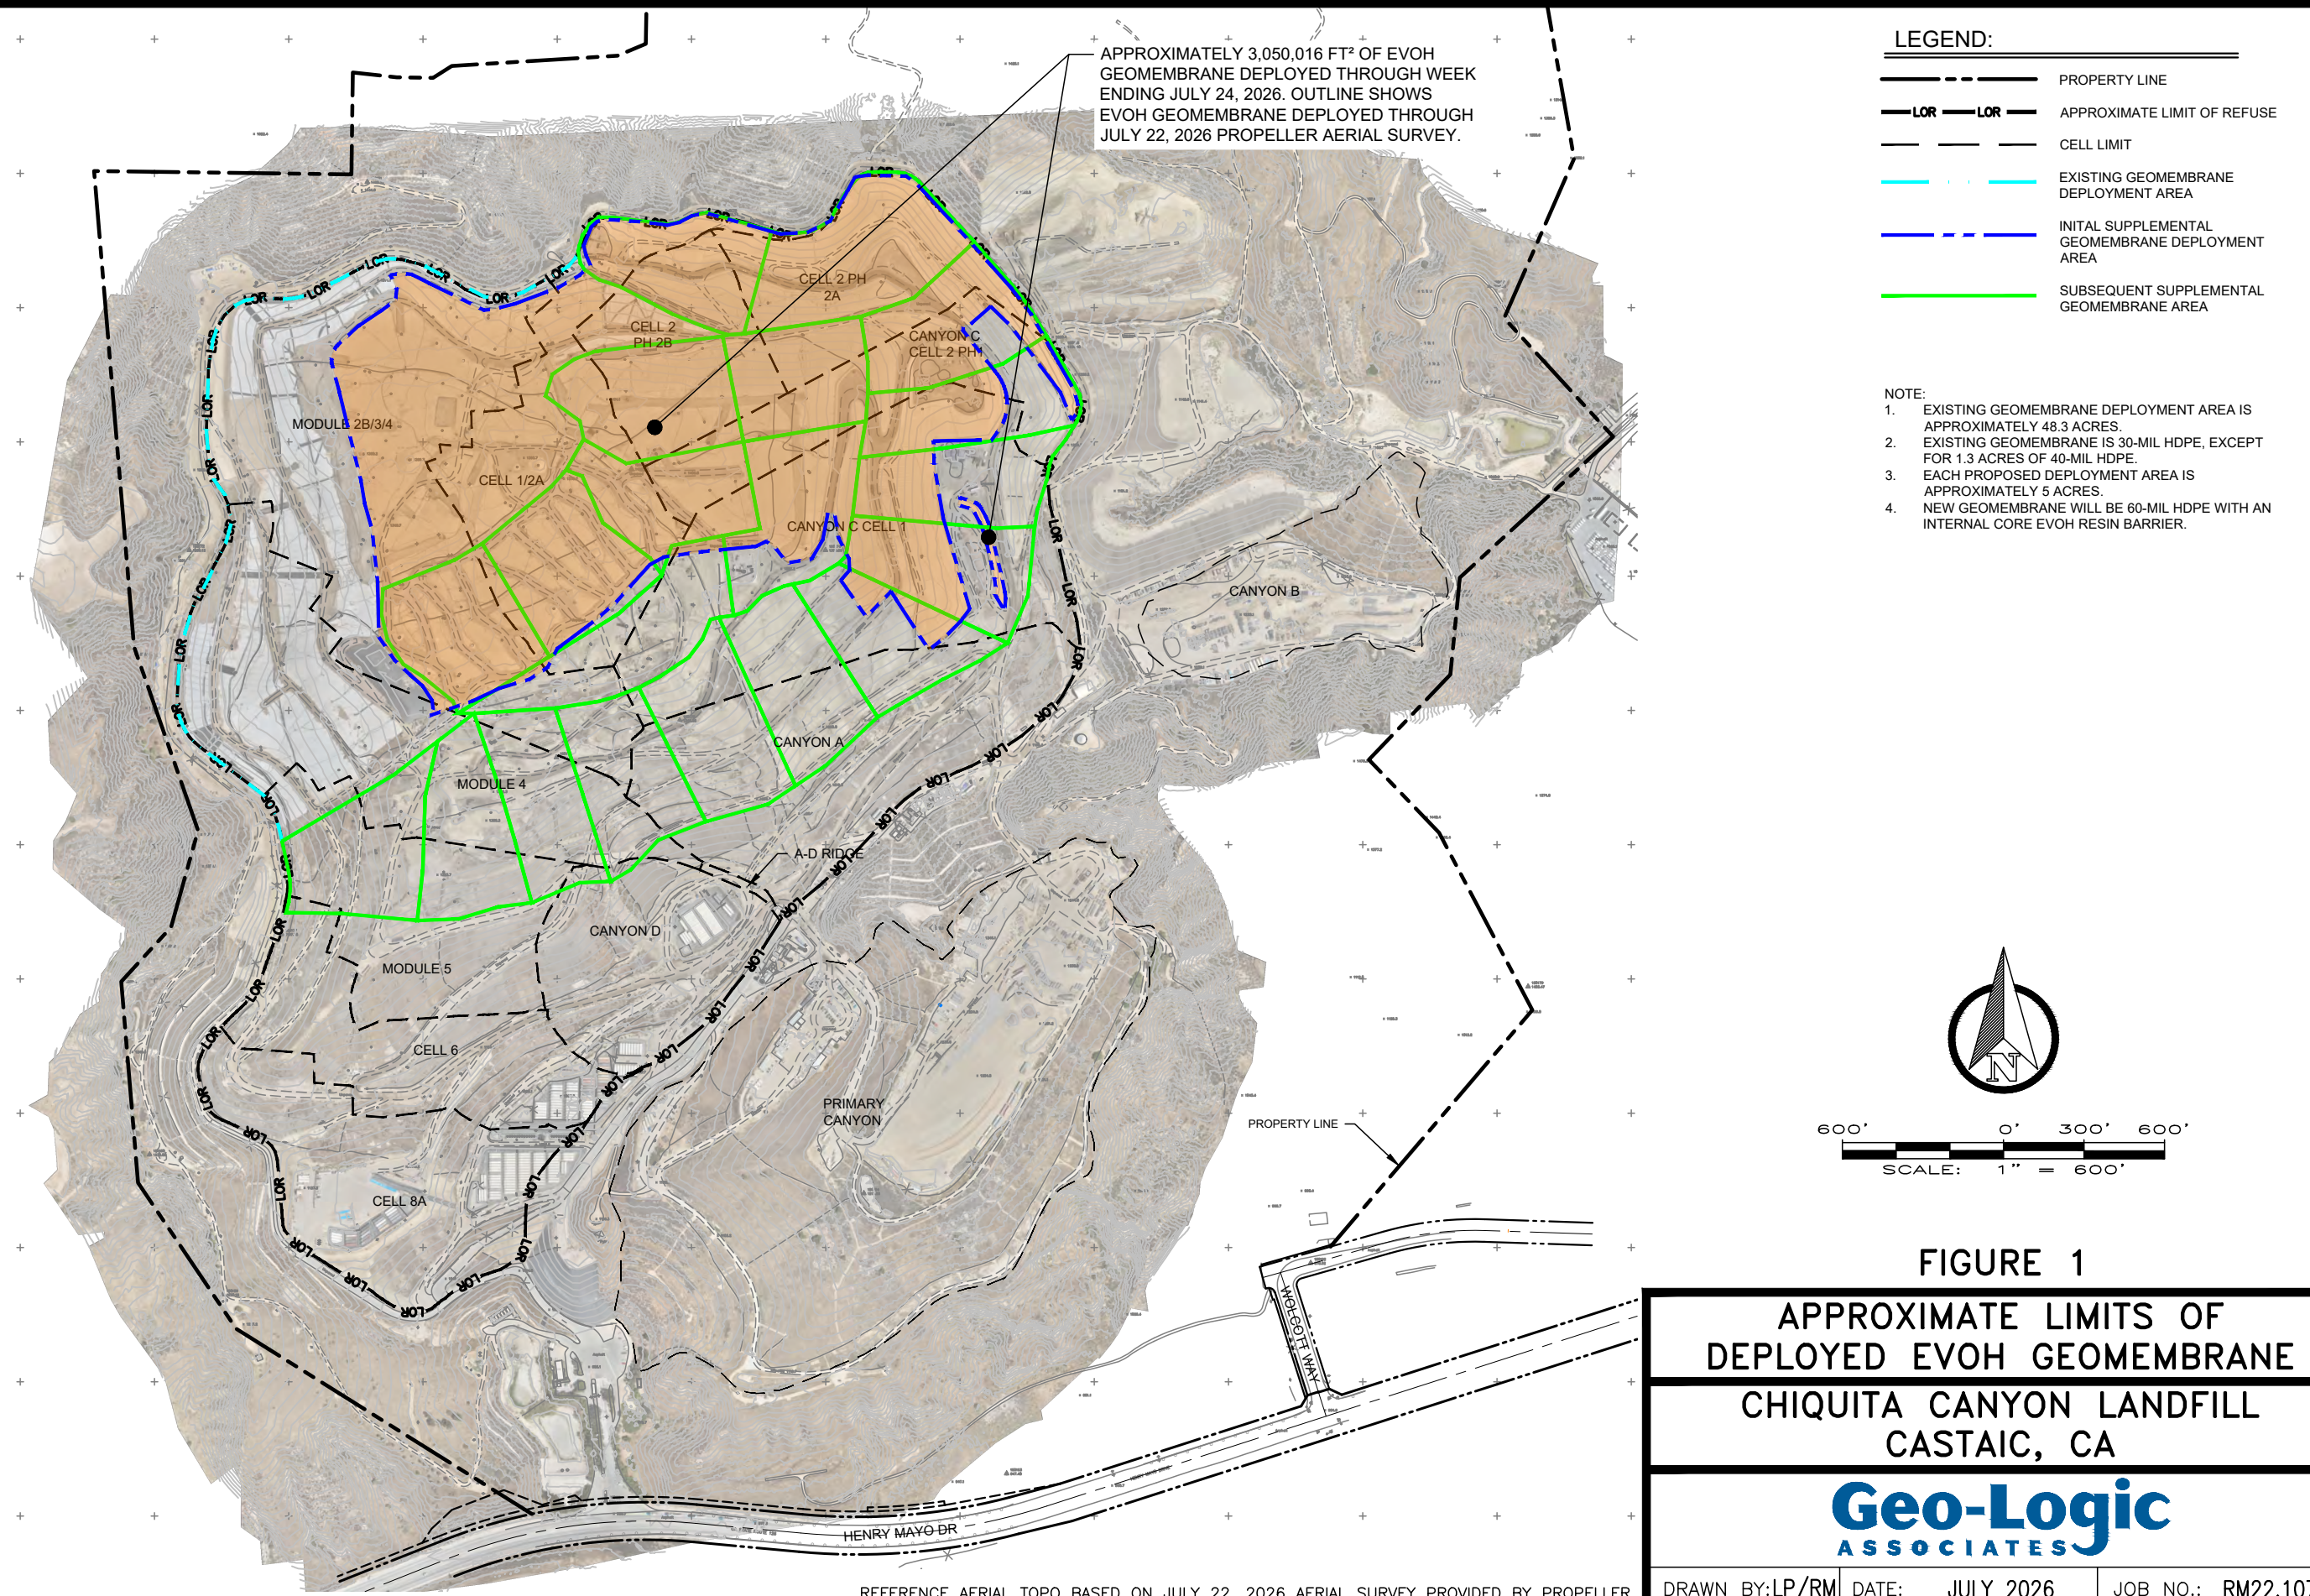

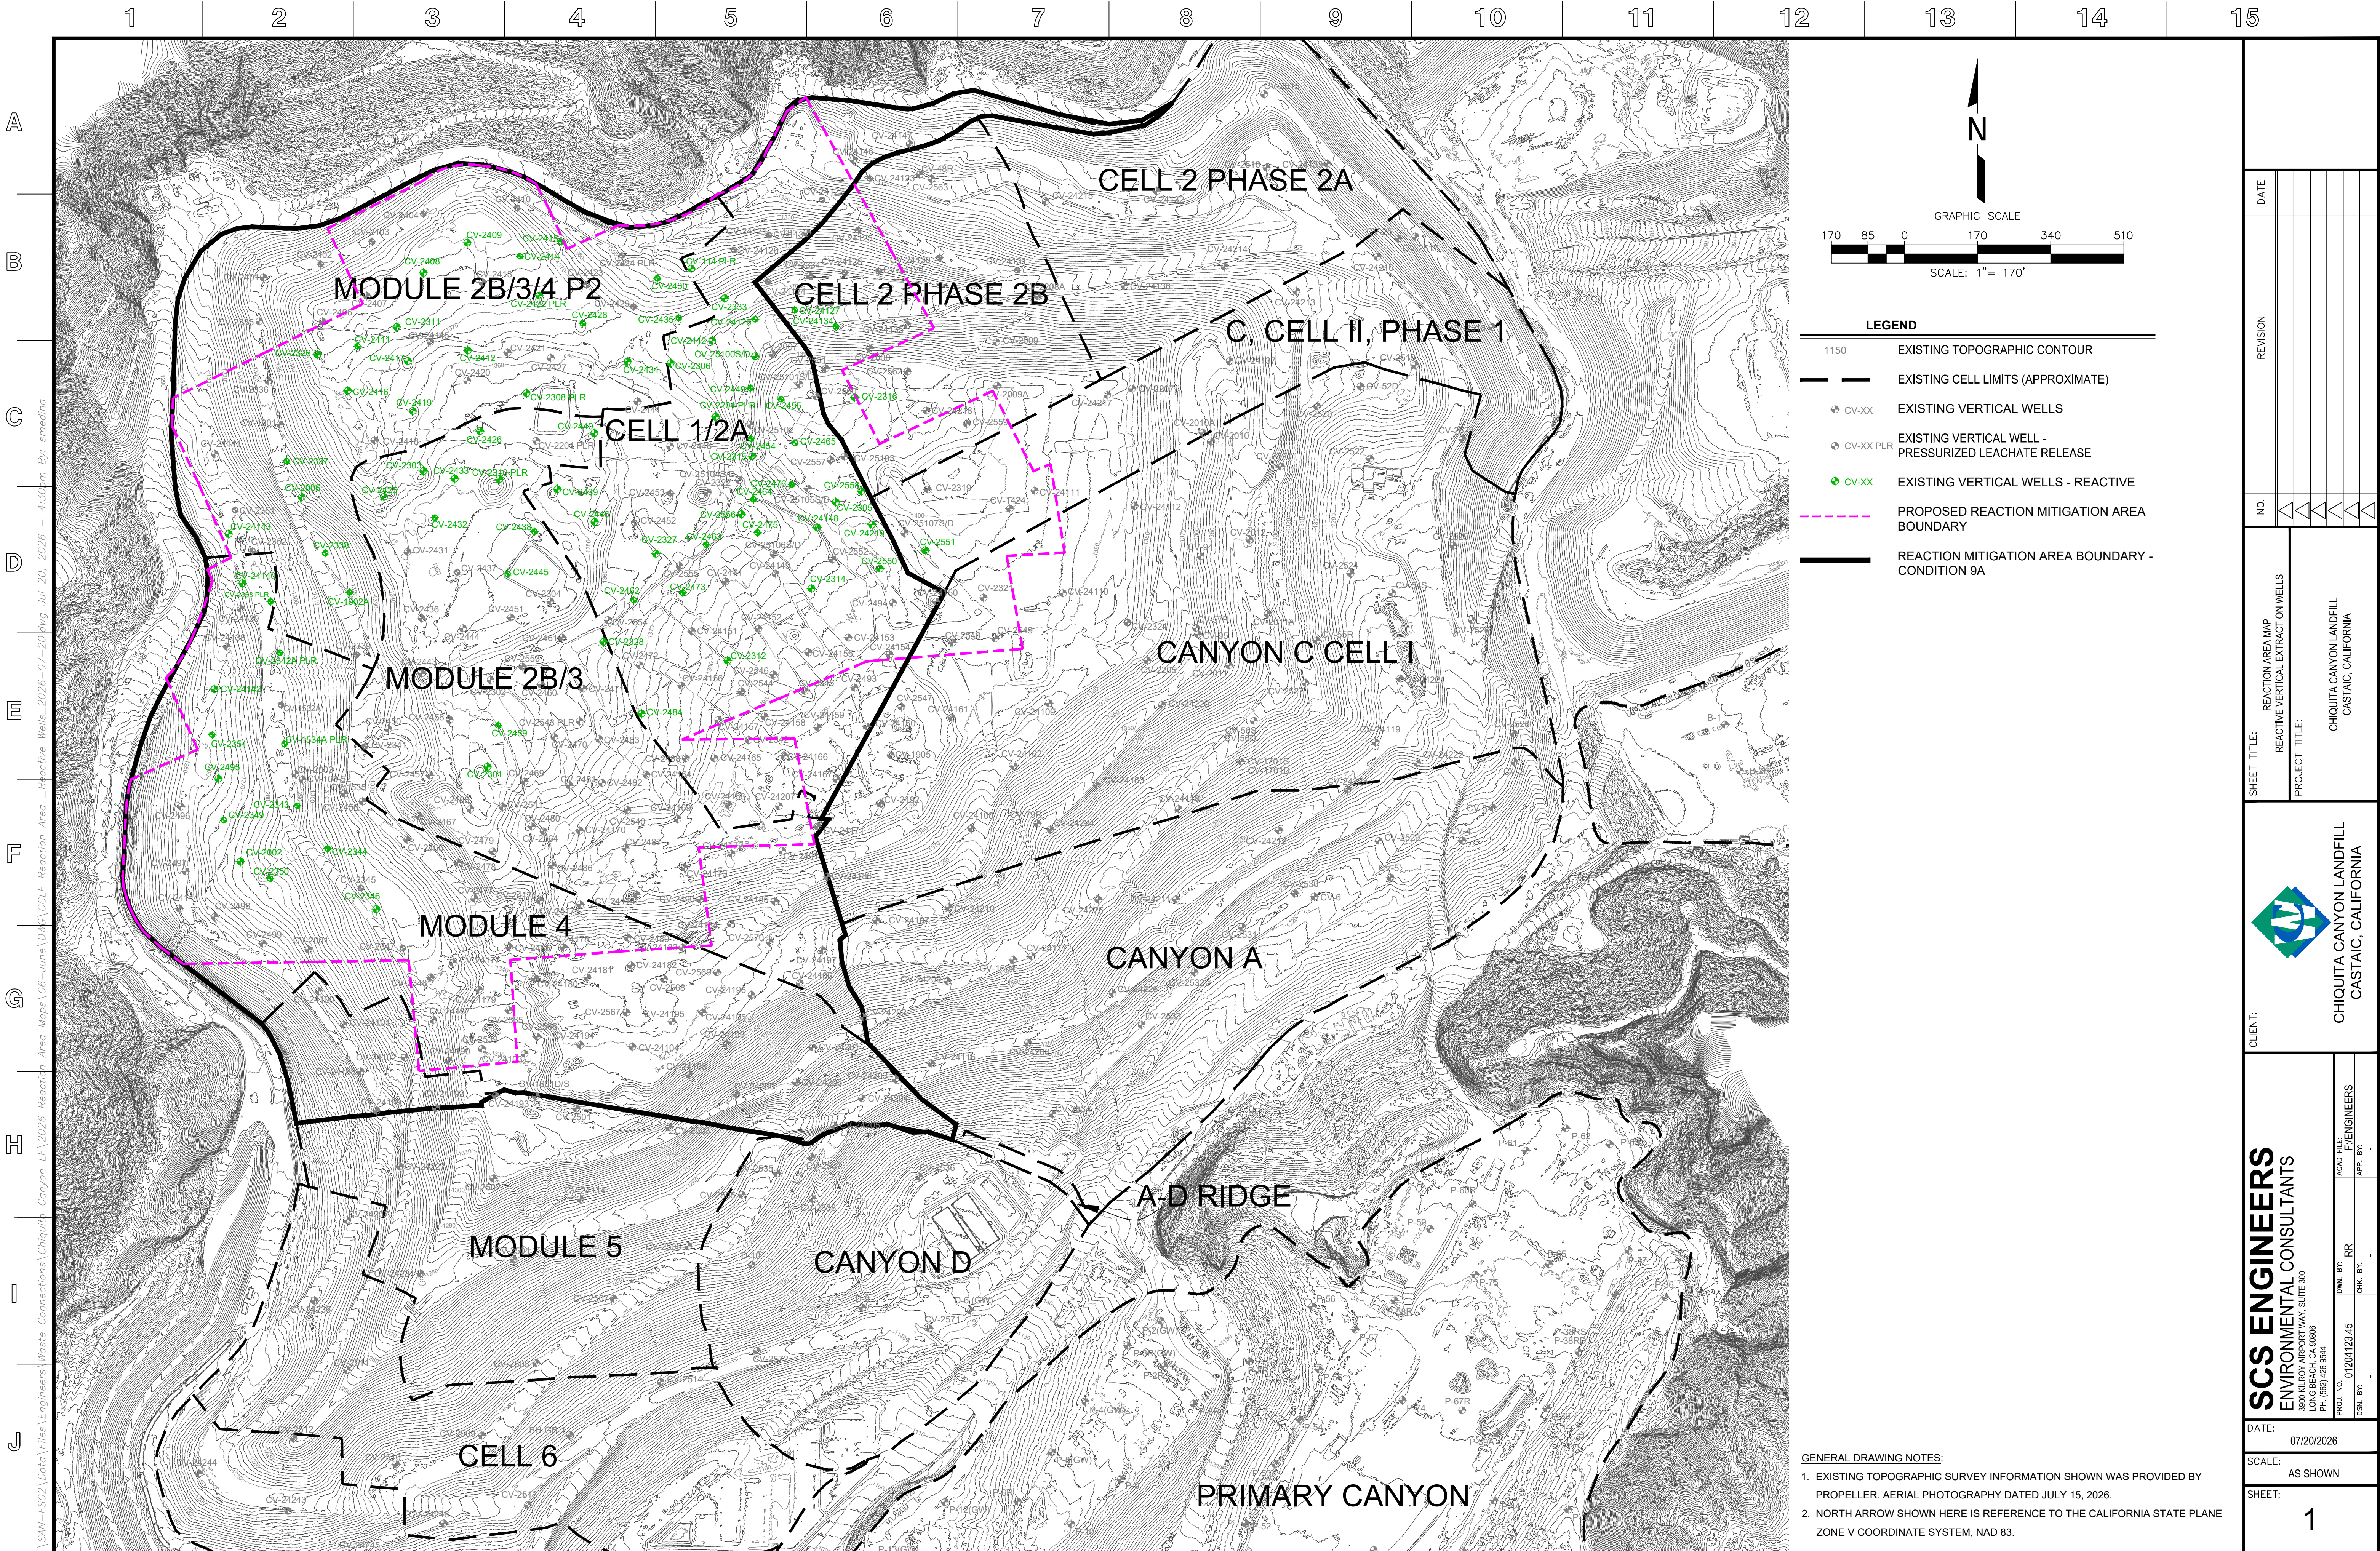

Chiquita Canyon Landfill -Isopach

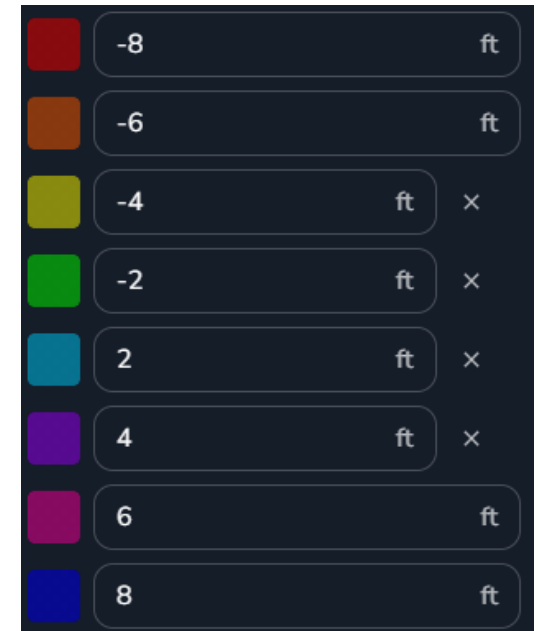

June 24, 2026 Survey Image. June 2, 2026 vs June 24, 2026