\\san-fs02\Data\Files\Engineers\Waste Connections\Chiquita Canyon LF\2026 LEA Corespondence\CCLF Weekly LEA Maps\2026-09-09_CCLF LEA Report Figure.dwg Sep 04, 2026 – 2:16pm By: cway

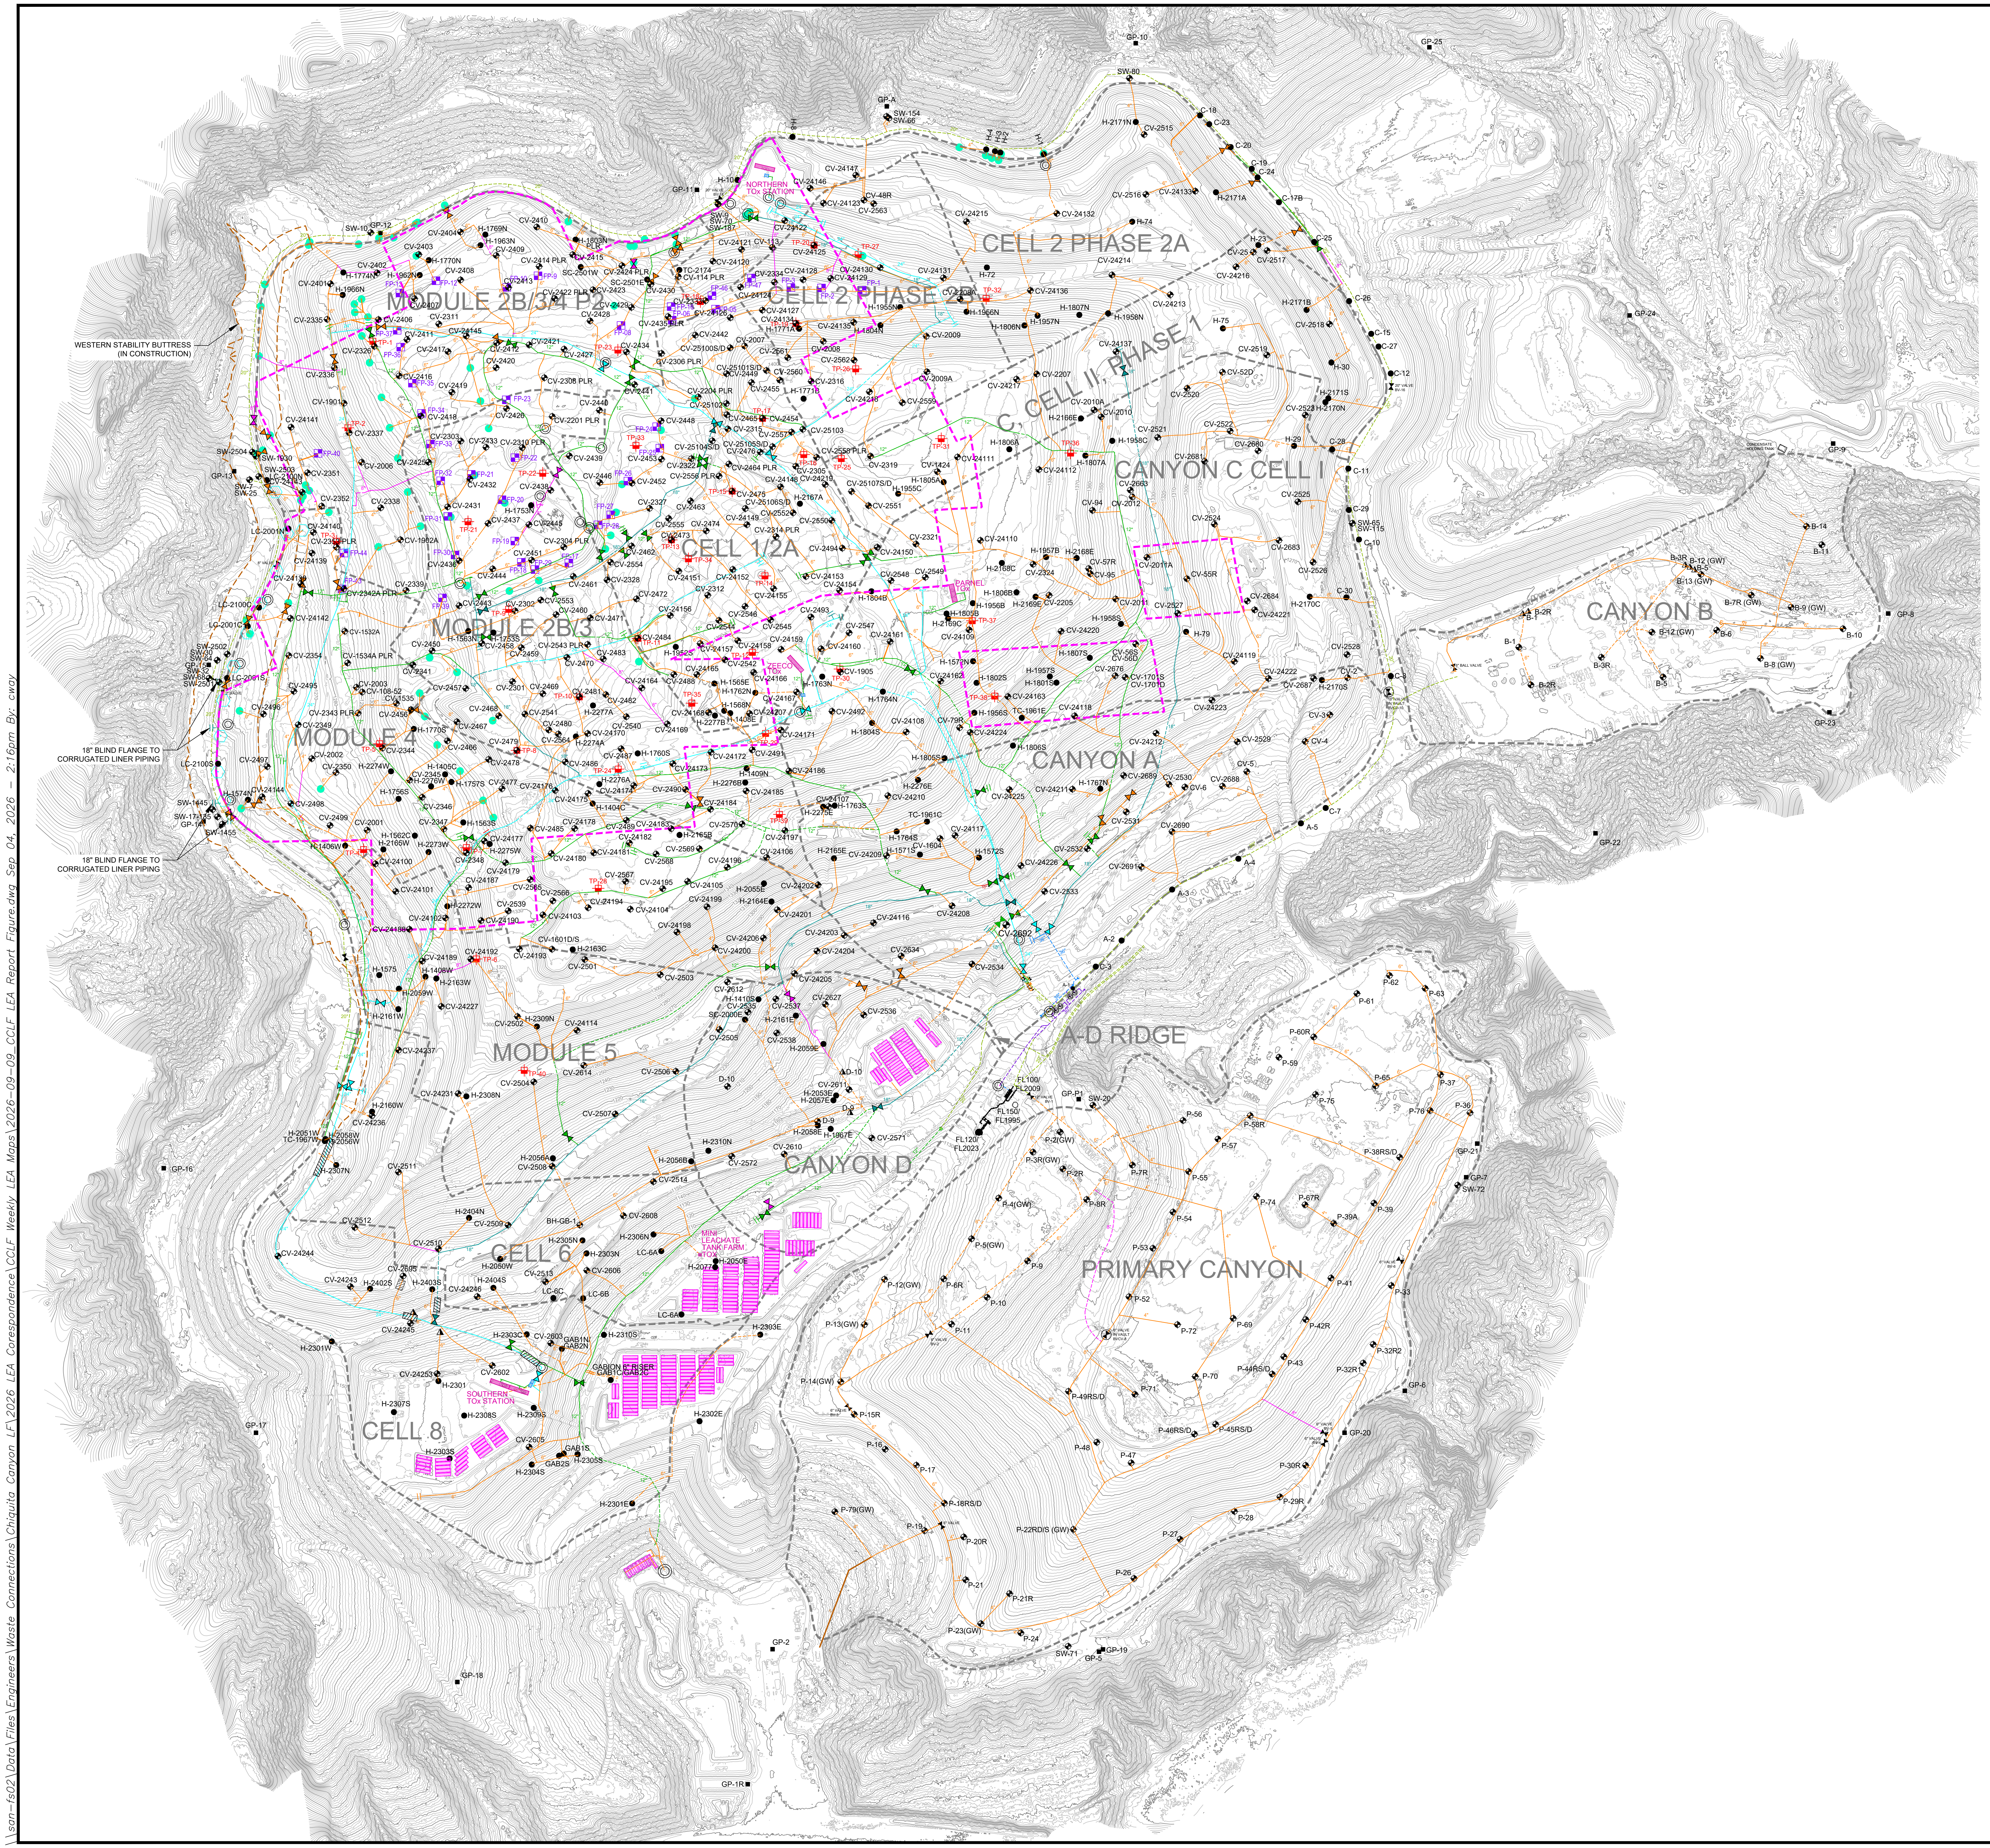

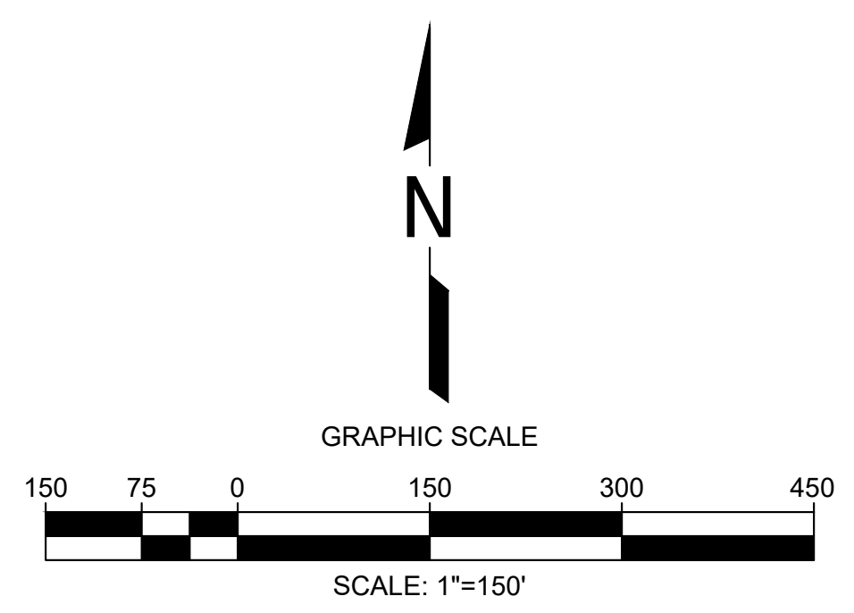

LEGEND

1150	TOPOGRAPHIC CONTOUR
- - - -	EXISTING CELL LIMITS (APPROXIMATE)
- - - -	WESTERN BUTRESS FILL LIMITS
- - - -	REACTION AREA BOUNDARY (APPROXIMATE) - BASED ON DATA REVIEW
36"	EXISTING 36" LFG COLLECTION HEADER PIPING
30"	EXISTING 30" LFG COLLECTION HEADER PIPING
24"	EXISTING 24" LFG COLLECTION HEADER PIPING
20"	EXISTING 20" LFG COLLECTION HEADER PIPING
18"	EXISTING 18" LFG COLLECTION HEADER PIPING
12"	EXISTING 12" LFG COLLECTION HEADER PIPING
10"	EXISTING 10" LFG COLLECTION HEADER PIPING
8"	EXISTING 8" LFG COLLECTION LATERAL PIPING
4"/6"	EXISTING 4"/6" LFG COLLECTION LATERAL PIPING
- - - -	BELOW-GRADE PIPES ARE SHOWN DASHED
▭	EXISTING FRAC TANKS
▬	EXISTING TOx UNITS
▦	EXISTING BLOWER SKIDS
AC	EXISTING ACTIVATED CARBON VESSEL
◎	EXISTING CONDENSATE SUMP
●	EXISTING HDPE LINER RISER
⬡	EXISTING CORRUGATED LINER RISER
CV/B/D/P-XX	EXISTING LFG VERTICAL EXTRACTION WELL - MAIN CANYON, CANYON B, D, PRIMARY CANYON
CV-XX PLR	EXISTING LFG VERTICAL EXTRACTION WELL - PRESSURIZED LEACHATE RELEASE
BH-GB	EXISTING GABION LFG COLLECTOR WELL
SW-XX	EXISTING SOIL VAPOR EXTRACTION WELL
FP-XX	EXISTING SURFACE COLLECTOR WELLHEAD
● H/TC/SC-XX	EXISTING HORIZONTAL, TRENCH, SLOPE, OR COLLECTOR WELL
▲ C-XX	EXISTING REMOTE VERTICAL WELLHEAD
■ GP-XX	EXISTING PERIMETER MIGRATION PROBE
TP-XX	EXISTING TEMPERATURE PROBE
⋈	EXISTING ISOLATION VALVE
⊣	EXISTING BLIND FLANGE
⊐	EXISTING LFG END CAP

GENERAL DRAWING NOTES:

1. EXISTING GCCS AS-BUILT DATED SEPTEMBER 9, 2026.
2. EXISTING TOPOGRAPHIC SURVEY INFORMATION SHOWN WAS PROVIDED BY PROPELLOR DATED SEPTEMBER 2, 2026.
3. APPROXIMATED REACTION MITIGATION AREA BOUNDARY ADJUSTMENTS DATED AUGUST 10, 2026, BASED ON JULY 2026 DATA.
4. NORTH ARROW SHOWN HERE IS REFERENCE TO THE CALIFORNIA STATE PLANE ZONE V COORDINATE SYSTEM, NAD 83.
5. THE LOCATION OF ANY EXISTING PIPING, VALVES, TIE-IN LOCATIONS AND OTHER FEATURES ARE APPROXIMATE AND SHOULD BE USED FOR INFORMATION PURPOSES ONLY. ACTUAL FIELD CONDITIONS MAY VARY AND ARE SUBJECT TO CHANGE BASED ON TOPOGRAPHIC FEATURES AND SITE-SPECIFIC FACTORS.

NO.	REVISION	DATE
△		
△		
△		
△		
△		
△		

SHEET TITLE:
EXISTING MASTER GCCS MAP

PROJECT TITLE:
CHIQUITA CANYON LANDFILL
CASTAIC, CALIFORNIA

CLIENT:
CHIQUITA CANYON LANDFILL
CASTAIC, CALIFORNIA

SCS ENGINEERS
ENVIRONMENTAL CONSULTANTS
3900 KILROY AIRPORT WAY, SUITE 300
LONG BEACH, CA 90806
PH. (562) 426-9544

PROJ. NO. 01204123.45
DSN. BY: SRM / RNH
DWN. BY: CNW
CHK. BY: -
ACAD FILE: N://CAD/ASBUILT-MASTERS
APP. BY: -

DATE: 09/09/2026

SCALE: AS SHOWN