F:\Engineers\Waste Connections\Chiquita Canyon LF\2026 LEA Corespondence\CCLF Weekly LEA Maps\2026-10-14_CCLF LEA Report Figure.dwg Oct 14, 2026 – 10:53am By: abroeckx

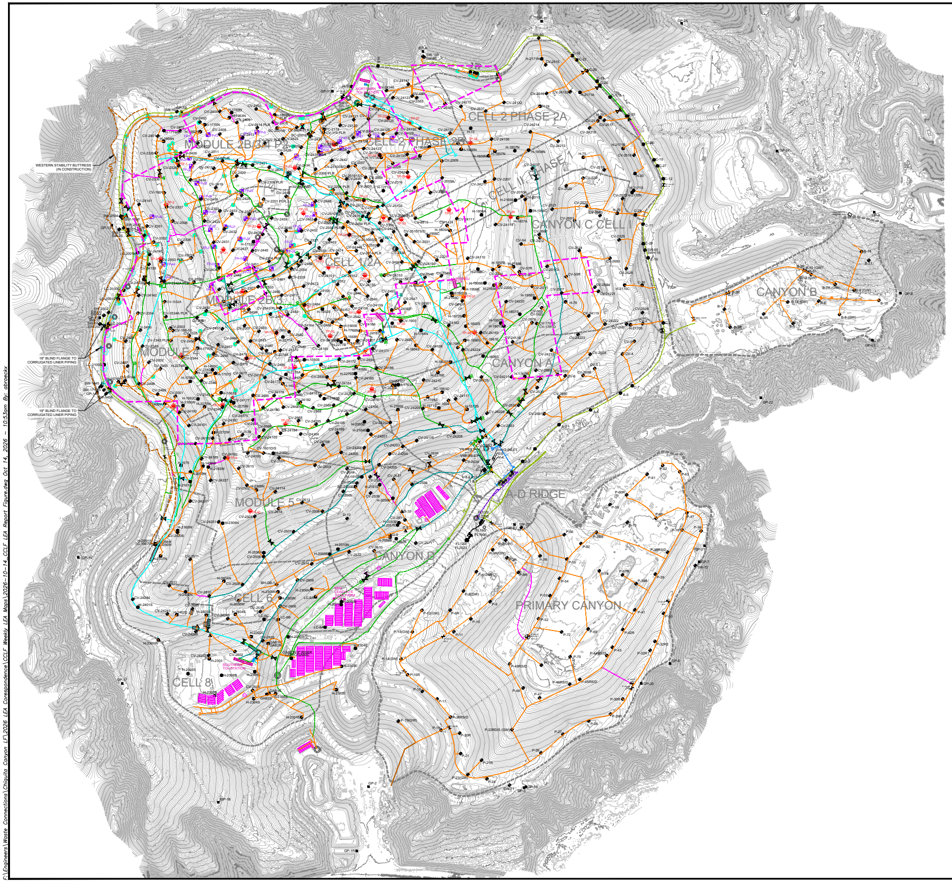
CELL 2 PHASE 2A
CELL 2 PHASE 2B
MODULE 2B/3/4 P2
CELL II PHASE 1
CANYON C CELL I
CELL 1/2A
MODULE 2B/3/4
MODULE 1
CANYON A
CANYON B
A-D RIDGE
MODULE 5
CANYON D
CELL 6
PRIMARY CANYON
CELL 8
WESTERN STABILITY BUTTRESS (IN CONSTRUCTION)
18" BLIND FLANGE TO CORRUGATED LINER PIPING
18" BLIND FLANGE TO CORRUGATED LINER PIPING
NORTHERN TOx STATION
SOUTHERN TOx STATION
LEACHATE TANK FARM

N

GRAPHIC SCALE

150 75 0 150 300 450

SCALE: 1"=150'

LEGEND

150	TOPOGRAPHIC CONTOUR
	EXISTING CELL LIMITS (APPROXIMATE)
	WESTERN BUTRESS FILL LIMITS
	REACTION AREA BOUNDARY (APPROXIMATE) - BASED ON DATA REVIEW
36"	EXISTING 36" LFG COLLECTION HEADER PIPING
30"	EXISTING 30" LFG COLLECTION HEADER PIPING
24"	EXISTING 24" LFG COLLECTION HEADER PIPING
20"	EXISTING 20" LFG COLLECTION HEADER PIPING
18"	EXISTING 18" LFG COLLECTION HEADER PIPING
12"	EXISTING 12" LFG COLLECTION HEADER PIPING
10"	EXISTING 10" LFG COLLECTION HEADER PIPING
8"	EXISTING 8" LFG COLLECTION LATERAL PIPING
4"/6"	EXISTING 4"/6" LFG COLLECTION LATERAL PIPING
	BELOW-GRADE PIPES ARE SHOWN DASHED
▭	EXISTING FRAC TANKS
▬	EXISTING TOx UNITS
■	EXISTING BLOWER SKIDS
⊖	EXISTING ACTIVATED CARBON VESSEL
◎	EXISTING CONDENSATE SUMP
●	EXISTING HDPE LINER RISER
⬡	EXISTING CORRUGATED LINER RISER
● CV/B/D/P-XX	EXISTING LFG VERTICAL EXTRACTION WELL - MAIN CANYON, CANYON B, D, PRIMARY CANYON
● CV-XX PLR	EXISTING LFG VERTICAL EXTRACTION WELL - PRESSURIZED LEACHATE RELEASE
● BH-GB	EXISTING GABION LFG COLLECTOR WELL
● SW-XX	EXISTING SOIL VAPOR EXTRACTION WELL
● FP-XX	EXISTING SURFACE COLLECTOR WELLHEAD
● H/TC/SC-XX	EXISTING HORIZONTAL, TRENCH, SLOPE, OR COLLECTOR WELL
▲ C-XX	EXISTING REMOTE VERTICAL WELLHEAD
■ GP-XX	EXISTING PERIMETER MIGRATION PROBE
✚ TP-XX	EXISTING TEMPERATURE PROBE
⋈	EXISTING ISOLATION VALVE
⊣	EXISTING BLIND FLANGE
⊣	EXISTING LFG END CAP
◎	EXISTING SAMPLE POINT

GENERAL DRAWING NOTES:

1. EXISTING GCCS AS-BUILT DATED OCTOBER 14, 2026.
2. EXISTING TOPOGRAPHIC SURVEY INFORMATION SHOWN WAS PROVIDED BY PROPELLER AERIAL PHOTOGRAPHY DATED OCTOBER 07, 2026.
3. APPROXIMATED REACTION MITIGATION AREA BOUNDARY ADJUSTMENTS DATED OCTOBER 10, 2026, BASED ON SEPTEMBER 2026 WELLFIELD DATA, PER SOFA CONDITION 8(m), AS DEFINED IN 9(A).
4. NORTH ARROW SHOWN HERE IS REFERENCE TO THE CALIFORNIA STATE PLANE ZONE V COORDINATE SYSTEM, NAD 83.
5. THE LOCATION OF ANY EXISTING PIPING, VALVES, TIE-IN LOCATIONS AND OTHER FEATURES ARE APPROXIMATE AND SHOULD BE USED FOR INFORMATION PURPOSES ONLY. ACTUAL FIELD CONDITIONS MAY VARY AND ARE SUBJECT TO CHANGE BASED ON TOPOGRAPHIC FEATURES AND SITE-SPECIFIC FACTORS.

NO.	REVISION	DATE
△		
△		
△		
△		
△		
△		
△		

SHEET TITLE:
EXISTING GCCS MASTER MAP

PROJECT TITLE:
CHIQUITA CANYON LANDFILL
CASTAIC, CALIFORNIA

CLIENT:
CHIQUITA CANYON LANDFILL
CASTAIC, CALIFORNIA

SCS ENGINEERS
ENVIRONMENTAL CONSULTANTS
3900 KILROY AIRPORT WAY, SUITE 300
LONG BEACH, CA 90806
PH. (562) 426-9544

PROJ. NO. 01204123.45
DSN. BY: SRM / RNH
DWN. BY: APB
CHK. BY: RNH
ACAD FILE: N:\CAD\ASBUILT-MASTERS
APP. BY: -

DATE: 10/14/2026

SCALE: AS SHOWN

1 of 1