From: WILLIAM.HALEY@WasteConnections.com
Sent: Friday, November 6, 2026 5:43 PM
To: Karen Gork
Cc: Todd.Thalhamer@Calrecycle.ca.gov; LFrias@ph.lacounty.gov; NQuick@ph.lacounty.gov; RRagland@ph.lacounty.gov; BMcphillips@counsel.lacounty.gov; Wes.Mindermann@CalRecycle.ca.gov; mark.debie@calrecycle.ca.gov; mark.debie@calrecycle.ca.gov; emorofuji@ph.lacounty.gov; btway@ph.lacounty.gov; Relon.MarkAnthony@epa.gov; Holybee.Tyler@epa.gov; Friedli.Laura@epa.gov; John Perkey; Sarah Phillips; Gregory.Shaffer@dtsc.ca.gov; Natasha.DiPietro@dtsc.ca.gov; Gregory.Gentile@dtsc.ca.gov; Dylan Smith
Subject: Re: Chiquita Canyon Landfill – Geosynthetic Cover – Mitigation Measure 4.1
Attachments: RM22.1077-CCL-EVOH-FIG 1-(2026-11-06).pdf; Milestone 2B Chiquita Canyon LF Isopach_Oct.2026.pdf; 2026-10-16_CCLF Reaction Area - Reactive Wells - September_V1.0.pdf

Below is Chiquita's weekly update on the status of the installation of the 60-mil EVOH/HDPE geomembrane cover at the Chiquita Canyon Landfill, in accordance with Mitigation Measure 4.1 of the LEA's Compliance Order issued May 1, 2025.

As of October 30, 2026, D&E, on behalf of Chiquita, has installed approximately 4,968,094 square feet of tan 60-mil EVOH/HDPE geomembrane cover. Of this total, approximately 986,357 square feet has been deployed on top of the existing 30mil geomembrane to augment its effectiveness. Work conducted the week of October 26 included extensive repairs and detailing of existing panels, including boot fabrication, patching, extrusion welding, re-seaming, and sand bag placement as needed. Work continued during the week of November 2, 2026. Chiquita has included the below summary total of Liner quantities:

	New EVOH Liner Installed	EVOH over existing 30-mil Installed	Existing 30-mil Liner	Total Liner Coverage
8/7/2026	2,629,969	736,689	1,564,950	4,931,608
8/14/2026	2,752,615	736,689	1,564,950	5,054,254
8/21/2026	2,860,533	736,689	1,564,950	5,162,172
8/28/2026	2,972,601	736,689	1,564,950	5,274,240
9/4/2026	3,070,743	736,689	1,564,950	5,372,382
9/11/2026	3,130,545	736,689	1,564,950	5,432,184
9/18/2026	3,232,497	736,689	1,564,950	5,534,136
9/25/2026	3,411,786	736,689	1,564,950	5,713,425
10/2/2026	3,411,786	756,444	1,545,195	5,713,425
10/9/2026	3,499,254	796,226	1,545,195	5,840,675
10/16/2026	3,565,834	845,796	1,545,195	5,907,255
10/23/2026	3,812,309	986,357	1,404,634	6,153,730

10/30/2026	3,981,737	986,357	1,404,634	6,372,728

*Note a correction to last weeks totals was made based upon deployment logs from third party CQA being previously miss categorized.

The attached site map shows the approximate extent of geomembrane cover installed as of Wednesday, October 30, 2026, as well as the geomembrane coverage described in the revised draft workplan for extension of the geomembrane cover area submitted to the LEA, the US EPA, and DTSC on March 13, 2026. Also attached to this submission are the December 2026 monthly isopach map and a figure identifying wells showing signs of reaction as of October 16, 2026 based on the October Reaction Mitigation Area. Due to technical limitations, we are currently unable to create one figure including all of this data.

Thank you,

Bill Haley, PE
Sr. Project Engineer
O: 661.257.3655 | C: 661.964.5821
Chiquita Canyon Landfill | 29201 Henry Mayo Dr. | Castaic, CA 91384
Connect With the Future © *www.wasteconnections.com*

Chiquita Canyon Landfill -Isopach



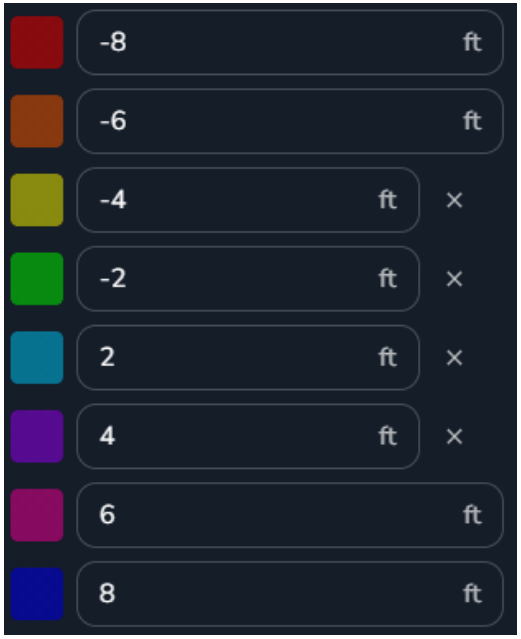

Oct 28, 2026 Survey Image. Oct 07, 2026 vs Oct 28, 2026

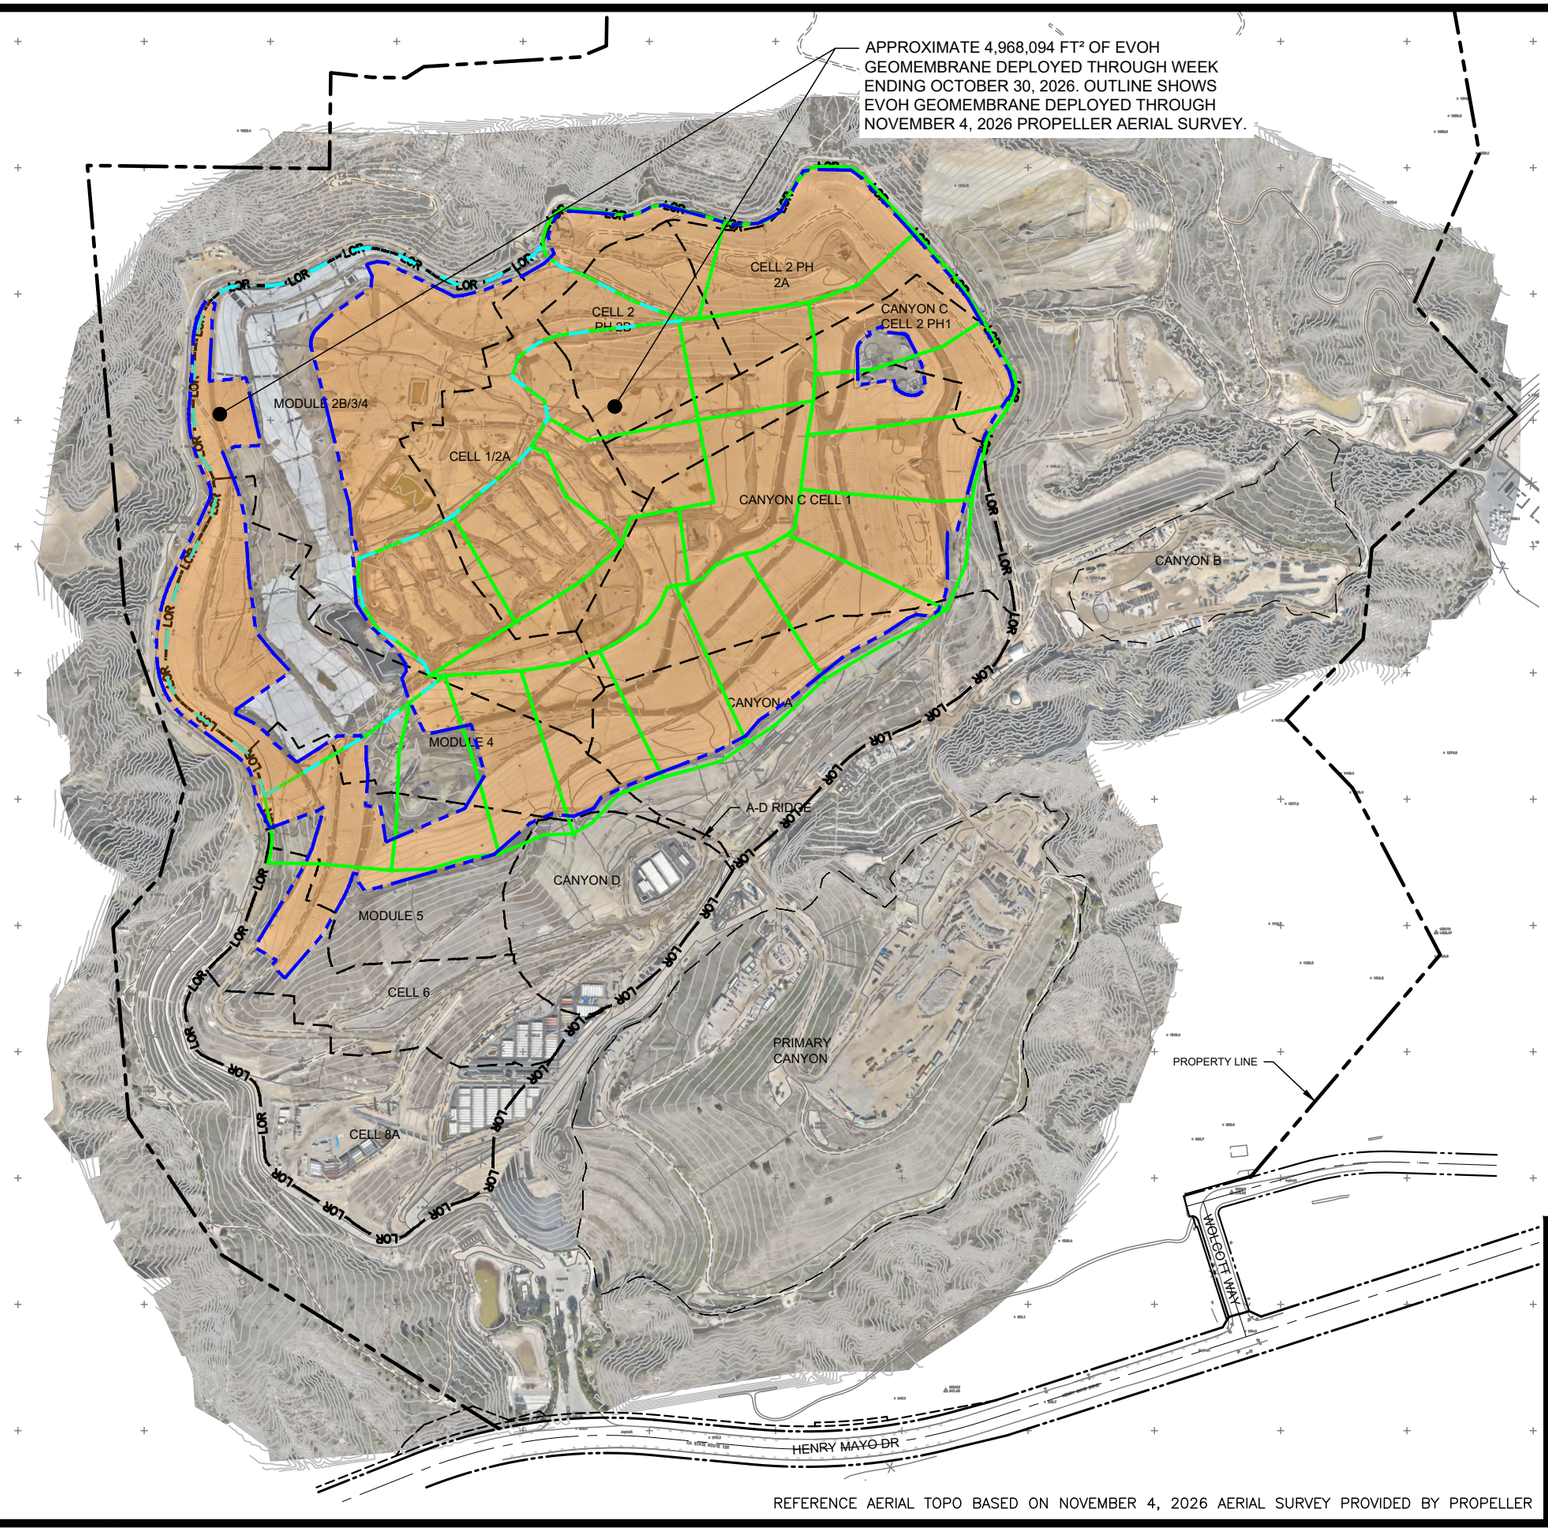

REFERENCE AERIAL TOPO BASED ON NOVEMBER 4, 2026 AERIAL SURVEY PROVIDED BY PROPELLER

LEGEND:

- PROPERTY LINE
- LOR LOR — APPROXIMATE LIMIT OF REFUSE
- CELL LIMIT
- EXISTING GEOMEMBRANE DEPLOYMENT AREA
- INITAL SUPPLEMENTAL GEOMEMBRANE DEPLOYMENT AREA
- SUBSEQUENT SUPPLEMENTAL GEOMEMBRANE AREA

NOTE:

1. EXISTING GEOMEMBRANE DEPLOYMENT AREA IS APPROXIMATELY 48.3 ACRES.
2. EXISTING GEOMEMBRANE IS 30-MIL HDPE, EXCEPT FOR 1.3 ACRES OF 40-MIL HDPE.
3. EACH PROPOSED DEPLOYMENT AREA IS APPROXIMATELY 5 ACRES.
4. NEW GEOMEMBRANE WILL BE 60-MIL HDPE WITH AN INTERNAL CORE EVOH RESIN BARRIER.

N

600' 0' 300' 600'

SCALE: 1" = 600'

FIGURE 1

APPROXIMATE LIMITS OF DEPLOYED EVOH GEOMEMBRANE

CHIQUITA CANYON LANDFILL CASTAIC, CA

Geo-Logic ASSOCIATES

DRAWN BY: LP/RM | DATE: NOVEMBER 2026 | JOB NO.: RM22.1077

P:\SITES\CHIQUITA CYN LF\MONITORING SUMMARY\FIGURES-WEEKLY\RM22.1077-CCL-EVOH-FIG 1-(2026-11-06).DWG November 6, 2026 - 10:08 AM BY: GLA-USER