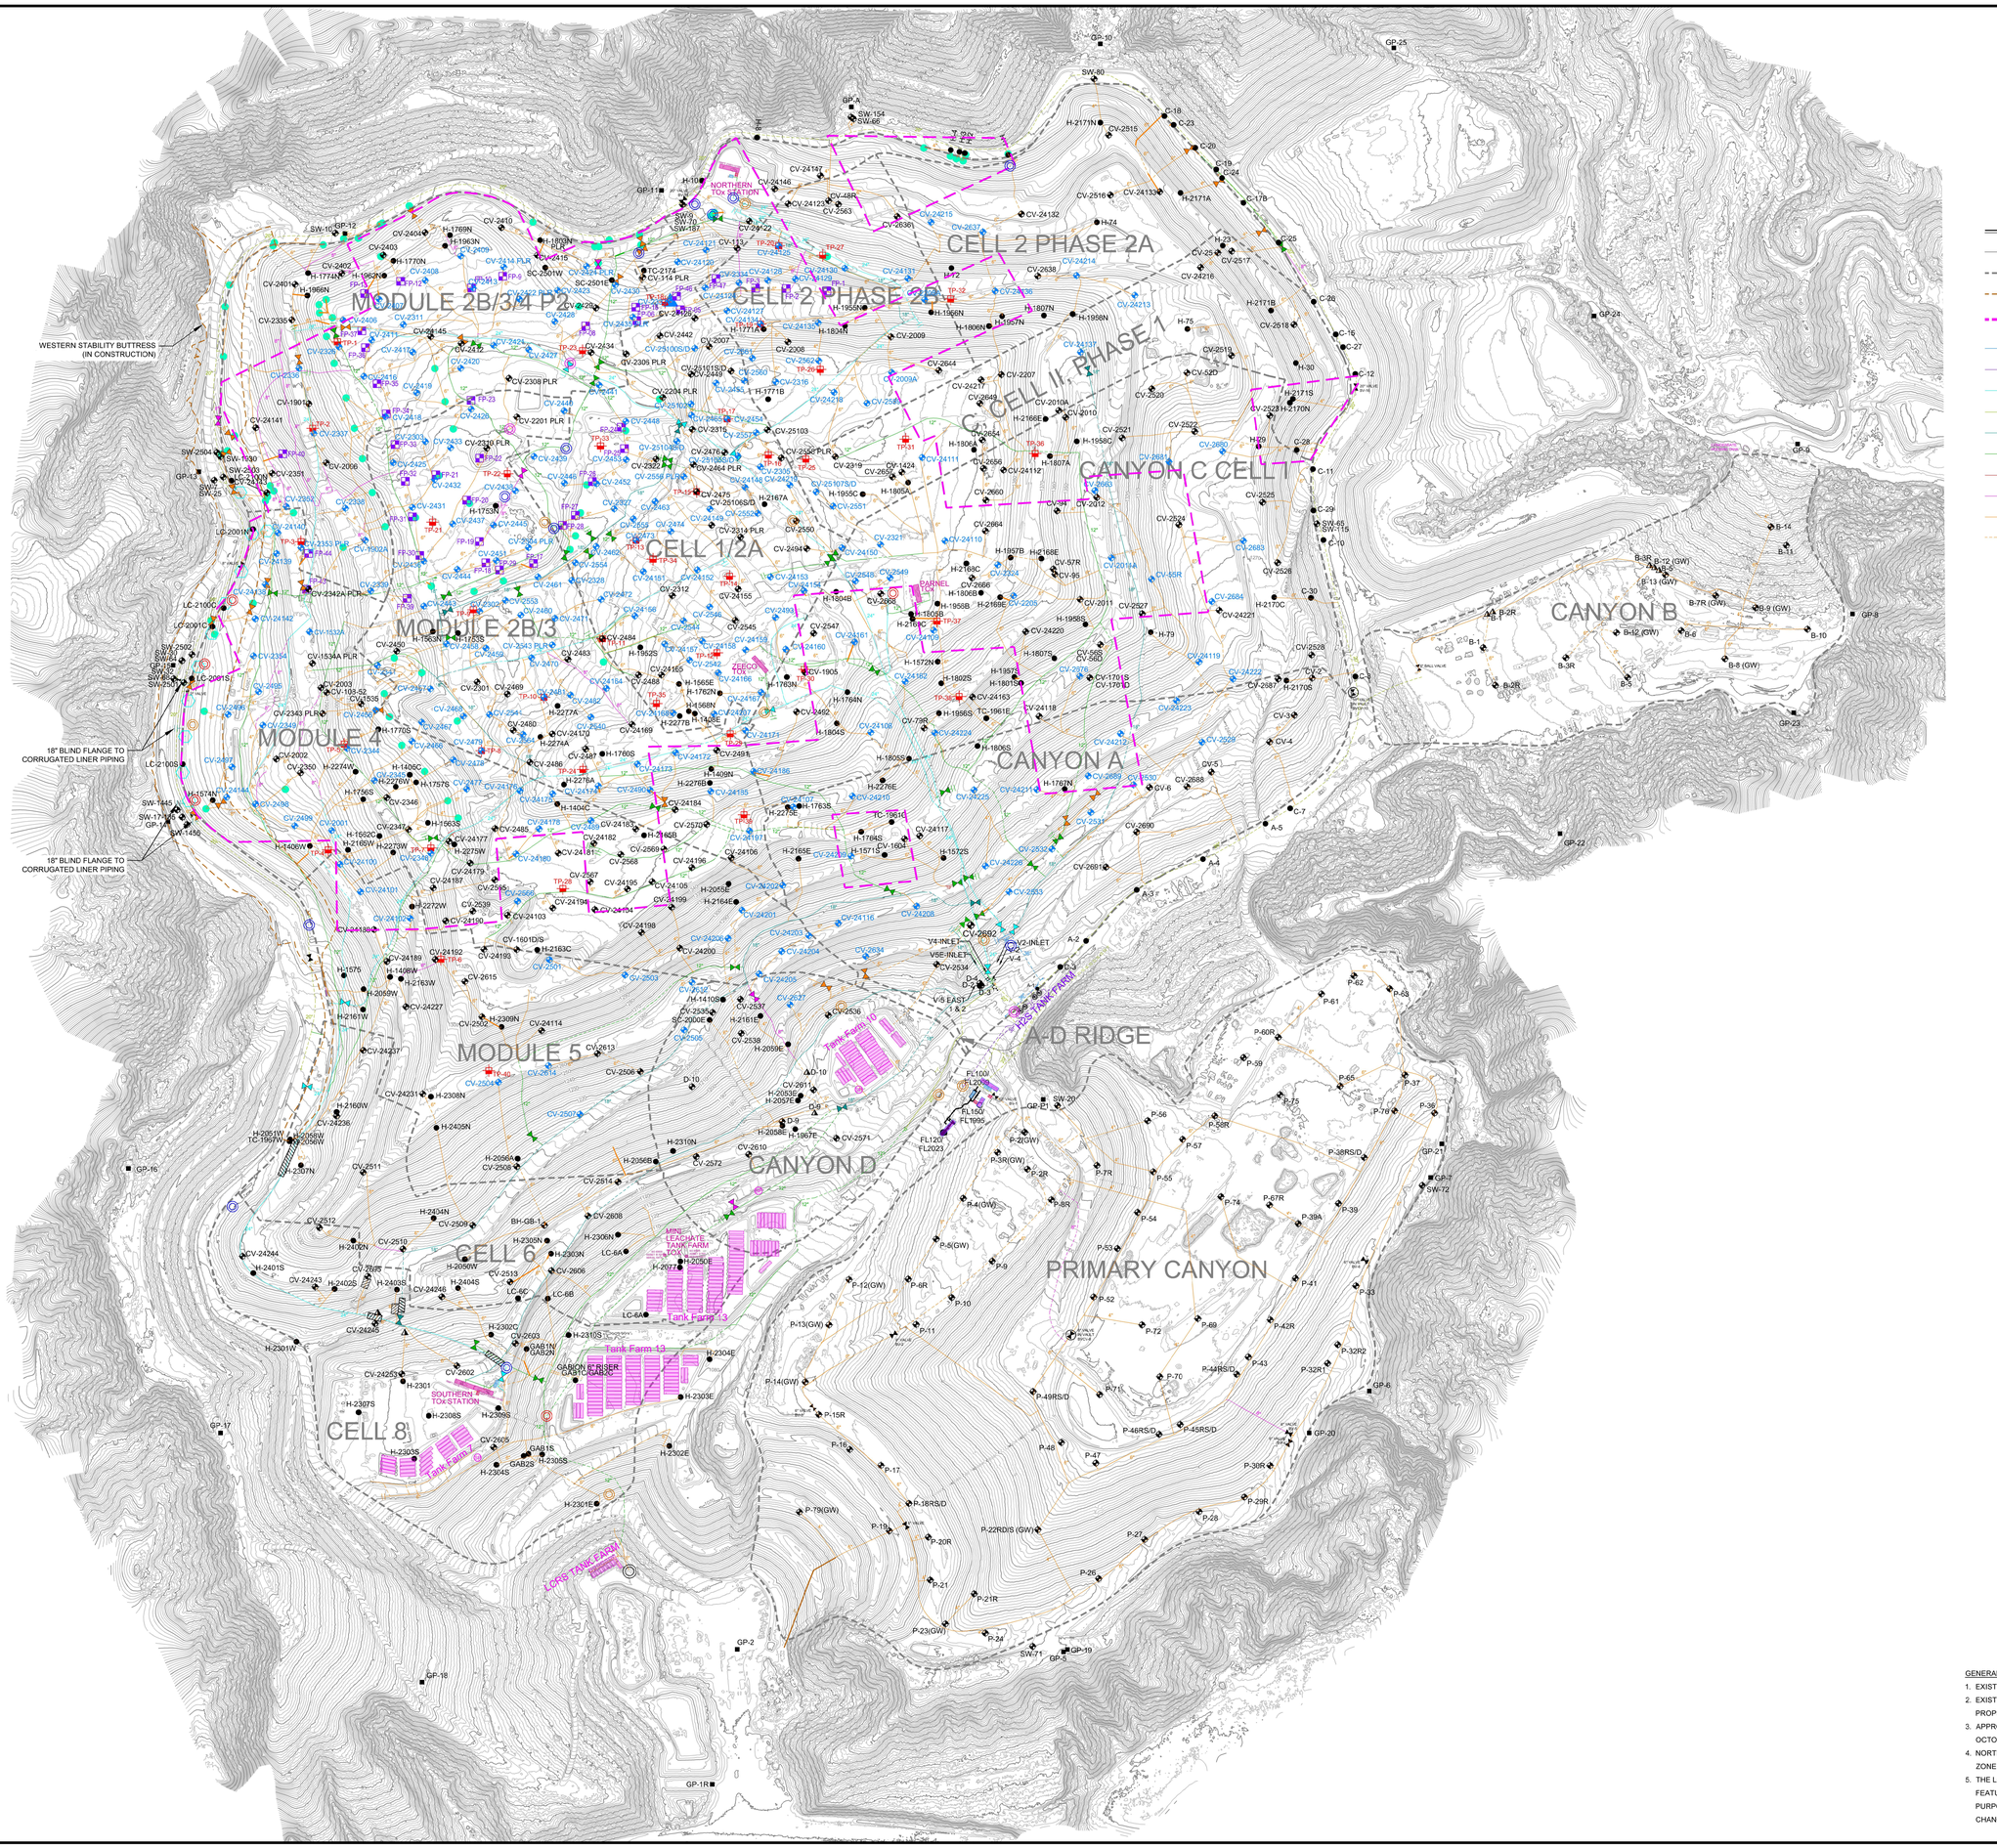

GENERAL DRAWING NOTES:

1. EXISTING GCCS AS-BUILT DATED NOVEMBER 13, 2026.
2. EXISTING TOPOGRAPHIC SURVEY INFORMATION SHOWN WAS PROVIDED BY PROPELLER AERIAL PHOTOGRAPHY DATED NOVEMBER 11, 2026.
3. APPROXIMATED REACTION MITIGATION AREA BOUNDARY ADJUSTMENTS DATED OCTOBER 10, 2026, BASED ON OCTOBER 2026 DATA.
4. NORTH ARROW SHOWN HERE IS REFERENCE TO THE CALIFORNIA STATE PLANE ZONE V COORDINATE SYSTEM, NAD 83.
5. THE LOCATION OF ANY EXISTING PIPING, VALVES, TIE-IN LOCATIONS AND OTHER FEATURES ARE APPROXIMATE AND SHOULD BE USED FOR INFORMATION PURPOSES ONLY. ACTUAL FIELD CONDITIONS MAY VARY AND ARE SUBJECT TO CHANGE BASED ON TOPOGRAPHIC FEATURES AND SITE-SPECIFIC FACTORS.

NO.	REVISION	DATE

SHEET TITLE: EXISTING GCCS MASTER AS-BUILT MAP

PROJECT TITLE: CHIQUITA CANYON LANDFILL CASTAIC, CALIFORNIA

CLIENT: CHIQUITA CANYON LANDFILL CASTAIC, CALIFORNIA

SCS ENGINEERS
ENVIRONMENTAL CONSULTANTS
3900 KILROY AIRPORT WAY, SUITE 300
LONG BEACH, CA 90806
PH: (562) 426-9544

PROJ. NO.	DSN. BY:	DWN. BY:	CHK. BY:	APP. BY:
01204123.45	SRM / RNH	APB	-	-

ACAD. FILE: ACADASBUILT-MASTERS

DATE: 11/13/2026

SCALE: AS SHOWN

1 of 1

\\lbc-fs01\Data\CAD\ASBUILT - MASTERS\CHIQUITA\AOMD Weekly Asbuilt\2026-11-13_Weekly AOMD Master GCCS_Temp.dwg Nov 13, 2026 - 3:50pm By: abroeckx