

Archivado: Lunes 22 de diciembre de 2025 12:37:55 PM
De: [Medina, Steven](#)
Enviado: Viernes 19 de diciembre de 2025 1:15:22 PM
Para: bchen@aqmd.gov
Cc: [Haley, William \(Bill\)](#)
Asunto: Ref.: Orden de Depuración Estipulada del Caso No. 6177-4 - Actualización sobre la Perforación del Pozo
Importancia: Normal
Sensibilidad: Ninguna
Adjuntos: Outlook-mio5buum.png; 2025 CCLF GCCS Expan Master Plan_Proposed LFG Extraction Well and Temp Probe Map_2025-12-19.pdf;

[REMITENTE EXTERNO: Tenga precaución con los enlaces/adjuntos]

Hola a todos,

Según la Condición 15(c) de la Orden Estipulada a continuación, se encuentra el resumen actualizado de la construcción para el Proyecto del Plan Maestro de Ampliación de GCCS 2025 del Vertedero de Chiquita Canyon.

Del 15/12/2025 al 19/12/2025, Chiquita completó la instalación de cero (0) pozos de extracción vertical de LFG debido a las reparaciones en curso de la plataforma de perforación. La cantidad total de pozos verticales de extracción de LFG instalados desde el 6 de diciembre de 2023 (la fecha de inicio de la Expansión Maestra de GCCS) hasta hoy es de trescientos quince (315).

Del 15/12/2025 al 19/12/2025, Chiquita completó la instalación de cero (0) sondas de temperatura. La cantidad total de sondas de temperatura instaladas desde el 26 de febrero de 2024 cuatro: (la fecha de inicio de las instalaciones de sondas de temperatura) hasta hoy es de cuarenta (40).

Los pozos y las sondas de temperatura programados para perforación durante la semana del 22/12/2025 al 26/12/2025 son los siguientes (sujeto a cambios):

Plataforma (Secuencia): La perforación está programada para retomar el 5 de enero de 2026 debido a las continuas reparaciones de perforación y a la rotación del equipo de trabajo asociada a las próximas fiestas.

Plataforma de Sondas de Temperatura (Boart Longyear): Se completó la perforación de las sondas de temperatura y los pozos de Extracción de Vapor del Suelo (SVE).

Atentamente,

STEVEN Rubén Medina, **E.I.T.**

Personal Profesional

SCS Engineers

3900 Kilroy Airport Way, Suite 300



Long Beach, CA 90806

858-204-4342 (c)

SMedina@scsengineers.com

Dirigidos por el Éxito de los Clientes

www.scsengineers.com

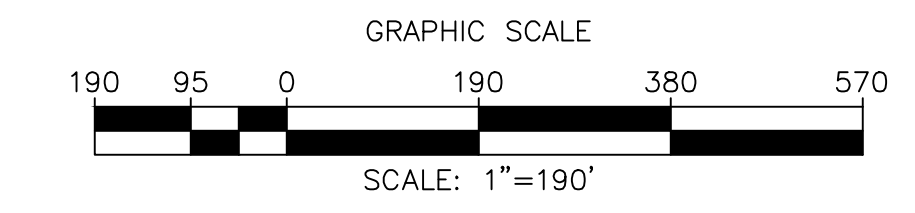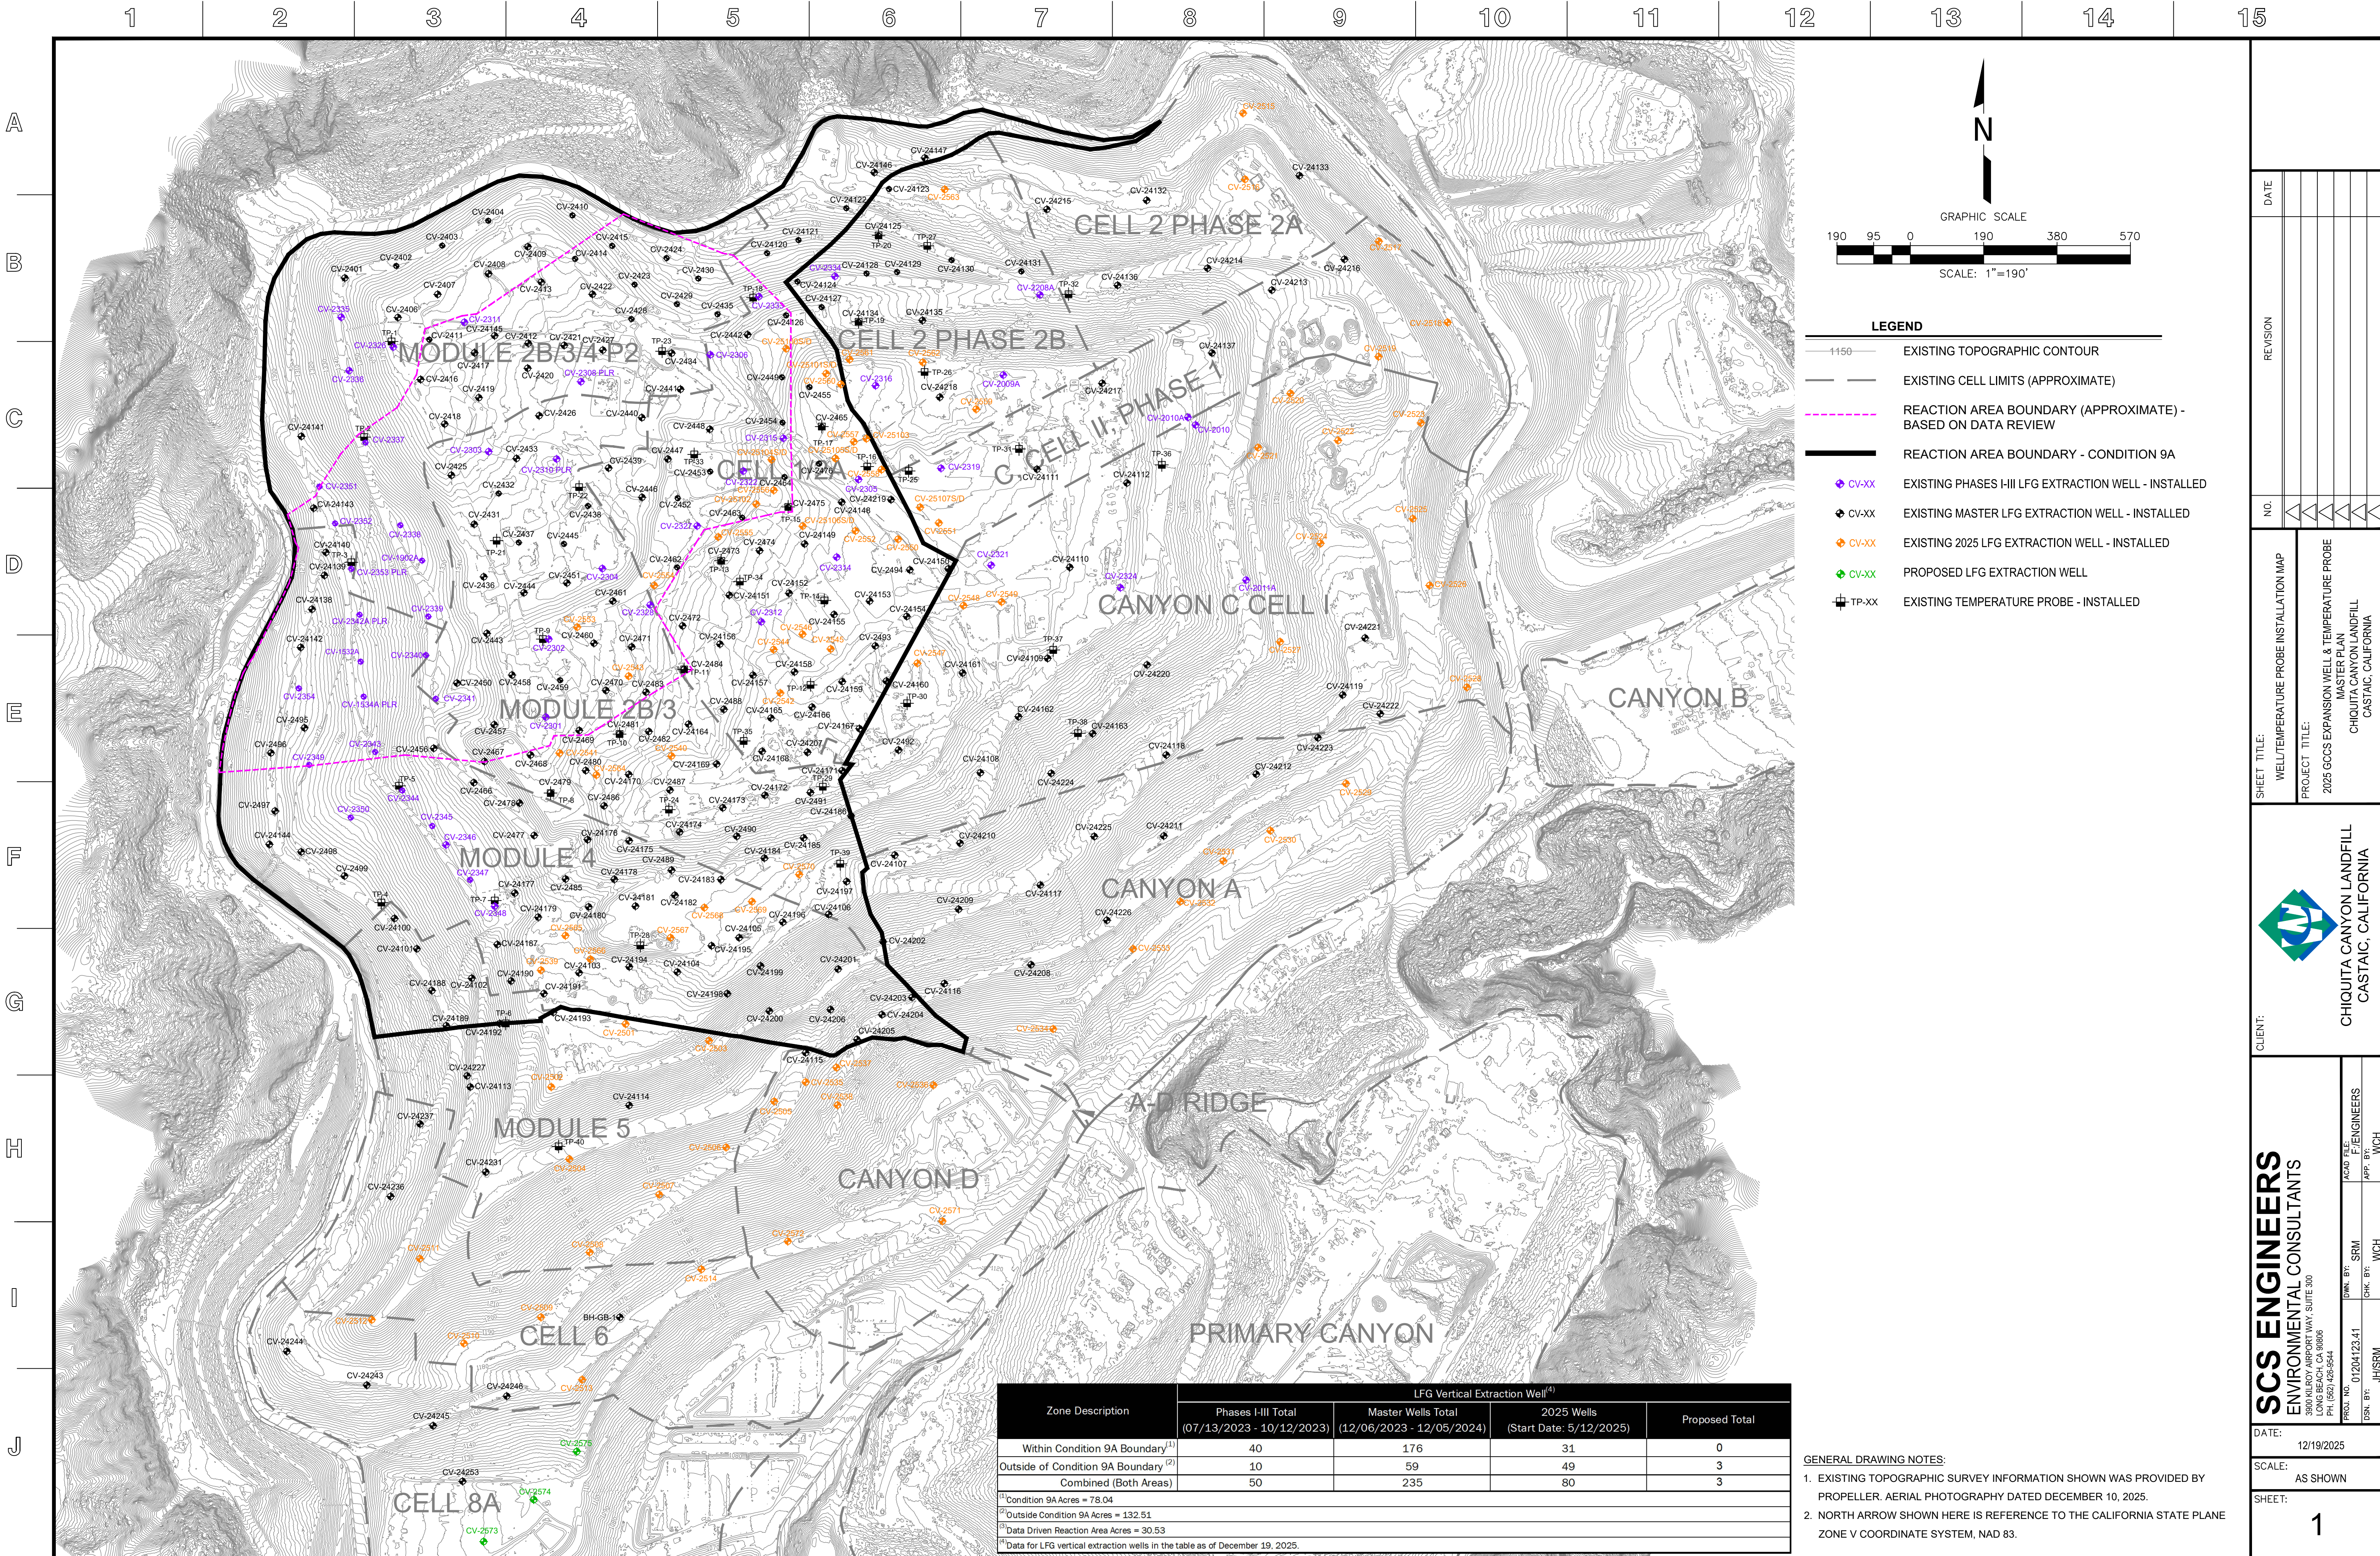

- LEGEND**
- 1150 EXISTING TOPOGRAPHIC CONTOUR
 - EXISTING CELL LIMITS (APPROXIMATE)
 - REACTION AREA BOUNDARY (APPROXIMATE) - BASED ON DATA REVIEW
 - REACTION AREA BOUNDARY - CONDITION 9A
 - EXISTING PHASES I-III LFG EXTRACTION WELL - INSTALLED
 - EXISTING MASTER LFG EXTRACTION WELL - INSTALLED
 - EXISTING 2025 LFG EXTRACTION WELL - INSTALLED
 - PROPOSED LFG EXTRACTION WELL
 - EXISTING TEMPERATURE PROBE - INSTALLED

Zone Description	LFG Vertical Extraction Well ⁽⁴⁾			
	Phases I-III Total (07/13/2023 - 10/12/2023)	Master Wells Total (12/06/2023 - 12/05/2024)	2025 Wells (Start Date: 5/12/2025)	Proposed Total
Within Condition 9A Boundary ⁽¹⁾	40	176	31	0
Outside of Condition 9A Boundary ⁽²⁾	10	59	49	3
Combined (Both Areas)	50	235	80	3

⁽¹⁾ Condition 9A Acres = 78.04

⁽²⁾ Outside Condition 9A Acres = 132.51

⁽³⁾ Data Driven Reaction Area Acres = 30.53

⁽⁴⁾ Data for LFG vertical extraction wells in the table as of December 19, 2025.

- GENERAL DRAWING NOTES:**
- EXISTING TOPOGRAPHIC SURVEY INFORMATION SHOWN WAS PROVIDED BY PROPELLER. AERIAL PHOTOGRAPHY DATED DECEMBER 10, 2025.
 - NORTH ARROW SHOWN HERE IS REFERENCE TO THE CALIFORNIA STATE PLANE ZONE V COORDINATE SYSTEM, NAD 83.

DATE

REVISION

NO.

SHEET TITLE:
WELL/TEMPERATURE PROBE INSTALLATION MAP

PROJECT TITLE:
2025 GCCS EXPANSION WELL & TEMPERATURE PROBE
MASTER PLAN
CHIQUITA CANYON LANDFILL
CASTAIC, CALIFORNIA

CLIENT:


CHIQUITA CANYON LANDFILL
CASTAIC, CALIFORNIA

SCS ENGINEERS

ENVIRONMENTAL CONSULTANTS

15000 W. ORANGE AVE., SUITE 300
LONG BEACH, CA 90806
PH: (562) 426-9544

PROJ. NO. 01204123.41

DWN. BY: SRM

CHK. BY: WCH

APP. BY: WCH

JH/SRM

DATE: 12/19/2025

SCALE: AS SHOWN

SHEET: 1

Z:\Files\Engineers\Waste Connections\Chiquita Canyon LF\2025 Chiquita LF GCCS Design Svcs\05-COA\01-Boring Logs\2025 CCLF GCCS Expan Master Plan_Proposed LFG Extraction Well and Temp Probe Map_2025-12-19.dwg Dec 19, 2025 - 8:11am By: smedina