

From: Medina, Steven <SMedina@scsengineers.com>
Sent: Friday, January 16, 2026 2:38 PM
To: bchen@aqmd.gov; ndickel@aqmd.gov; Christina Ojeda
Cc: Haley, William (Bill); Amanda Froman; Viswanathan, Srividhya; Jones, Art; Kate Logan; Mark.Adams; Han, Jessie
Subject: Re: Case No. 6177-4 Stipulated Order for Abatement – Well Drilling Update
Attachments: 2025 CCLF GCCS Expan Master Plan_Proposed LFG Extraction Well and Temp Probe Map_2026-01-16.pdf

[EXTERNAL SENDER: Use caution with links/attachments]

Apologies All, resubmitting as my previous email did not include the attached PDF.

In accordance with Condition 15(c) of the Stipulated Order, below is the up-to-date construction summary for the Chiquita Canyon Landfill 2025 GCCS Expansion Master Plan Project.

During 01/12/2026 to 01/16/2026, Chiquita completed the installation of zero (0) vertical LFG extraction wells due to ongoing drilling rig repairs. The total count of vertical LFG extraction wells installed from December 6, 2023 (the start date of the GCCS Master Expansion) through today is three hundred fifteen (315).

During 01/12/2026 to 01/16/2026, Chiquita completed the installation of zero (0) temperature probes. The total count of temperature probes installed from February 26th, 2024 (the start date of the temperature probe installations) through today is forty (40).

The wells and temperature probes scheduled for drilling during the week of 01/19/2026 to 01/23/2026 are as follows (subject to change):

Rig (Continuum): CV-2573, CV-2574, CV-2575; Drilling of these wells was not completed last week due to drilling rig repairs. Installation is planned for next week, subject to the completion of those repairs.

Temperature Probe Rig (Boart Longyear): Drilling of the temperature probes and Soil Vapor Extraction (SVE) wells has been completed.

STEVEN Ruben Medina, **E.I.T.**
Staff Professional
SCS Engineers
3900 Kilroy Airport Way, Suite 300
Long Beach, CA 90806
858-204-4342 (c)
SMedina@scsengineers.com

Driven by Client Success
www.scsengineers.com

2024 Conrad Quality Focus Award Recipient



From: Medina, Steven <SMedina@scsengineers.com>

Sent: Friday, January 16, 2026 2:14 PM

To: bchen@aqmd.gov <bchen@aqmd.gov>; ndickel@aqmd.gov <NDickel@aqmd.gov>; Christina Ojeda <cojeda@aqmd.gov>

Cc: Haley, William (Bill) <WCHaley@scsengineers.com>; Amanda Froman <amanda.froman@wasteconnections.com>; Viswanathan, Srividhya <SViswanathan@scsengineers.com>; Jones, Art <AJones@scsengineers.com>; Kate Logan <Kate.Logan@WasteConnections.com>; Mark.Adams <Mark.Adams@WasteConnections.com>; Han, Jessie <JHan@scsengineers.com>

Subject: Re: Case No. 6177-4 Stipulated Order for Abatement – Well Drilling Update

All,

In accordance with Condition 15(c) of the Stipulated Order, below is the up-to-date construction summary for the Chiquita Canyon Landfill 2025 GCCS Expansion Master Plan Project.

During 01/12/2026 to 01/16/2026, Chiquita completed the installation of zero (0) vertical LFG extraction wells due to ongoing drilling rig repairs. The total count of vertical LFG extraction wells installed from December 6, 2023 (the start date of the GCCS Master Expansion) through today is three hundred fifteen (315).

During 01/12/2026 to 01/16/2026, Chiquita completed the installation of zero (0) temperature probes. The total count of temperature probes installed from February 26th, 2024 (the start date of the temperature probe installations) through today is forty (40).

The wells and temperature probes scheduled for drilling during the week of 01/19/2026 to 01/23/2026 are as follows (subject to change):

Rig (Continuum): CV-2573, CV-2574, CV-2575; Drilling of these wells was not completed last week due to drilling rig repairs. Installation is planned for next week, subject to the completion of those repairs.

Temperature Probe Rig (Boart Longyear): Drilling of the temperature probes and Soil Vapor Extraction (SVE) wells has been completed.

Regards,

STEVEN Ruben Medina, **E.I.T.**

Staff Professional

SCS Engineers

3900 Kilroy Airport Way, Suite 300

Long Beach, CA 90806

858-204-4342 (c)


SMedina@scsengineers.com

Driven by Client Success

www.scsengineers.com

*2024 Conrad Quality Focus
Award Recipient*



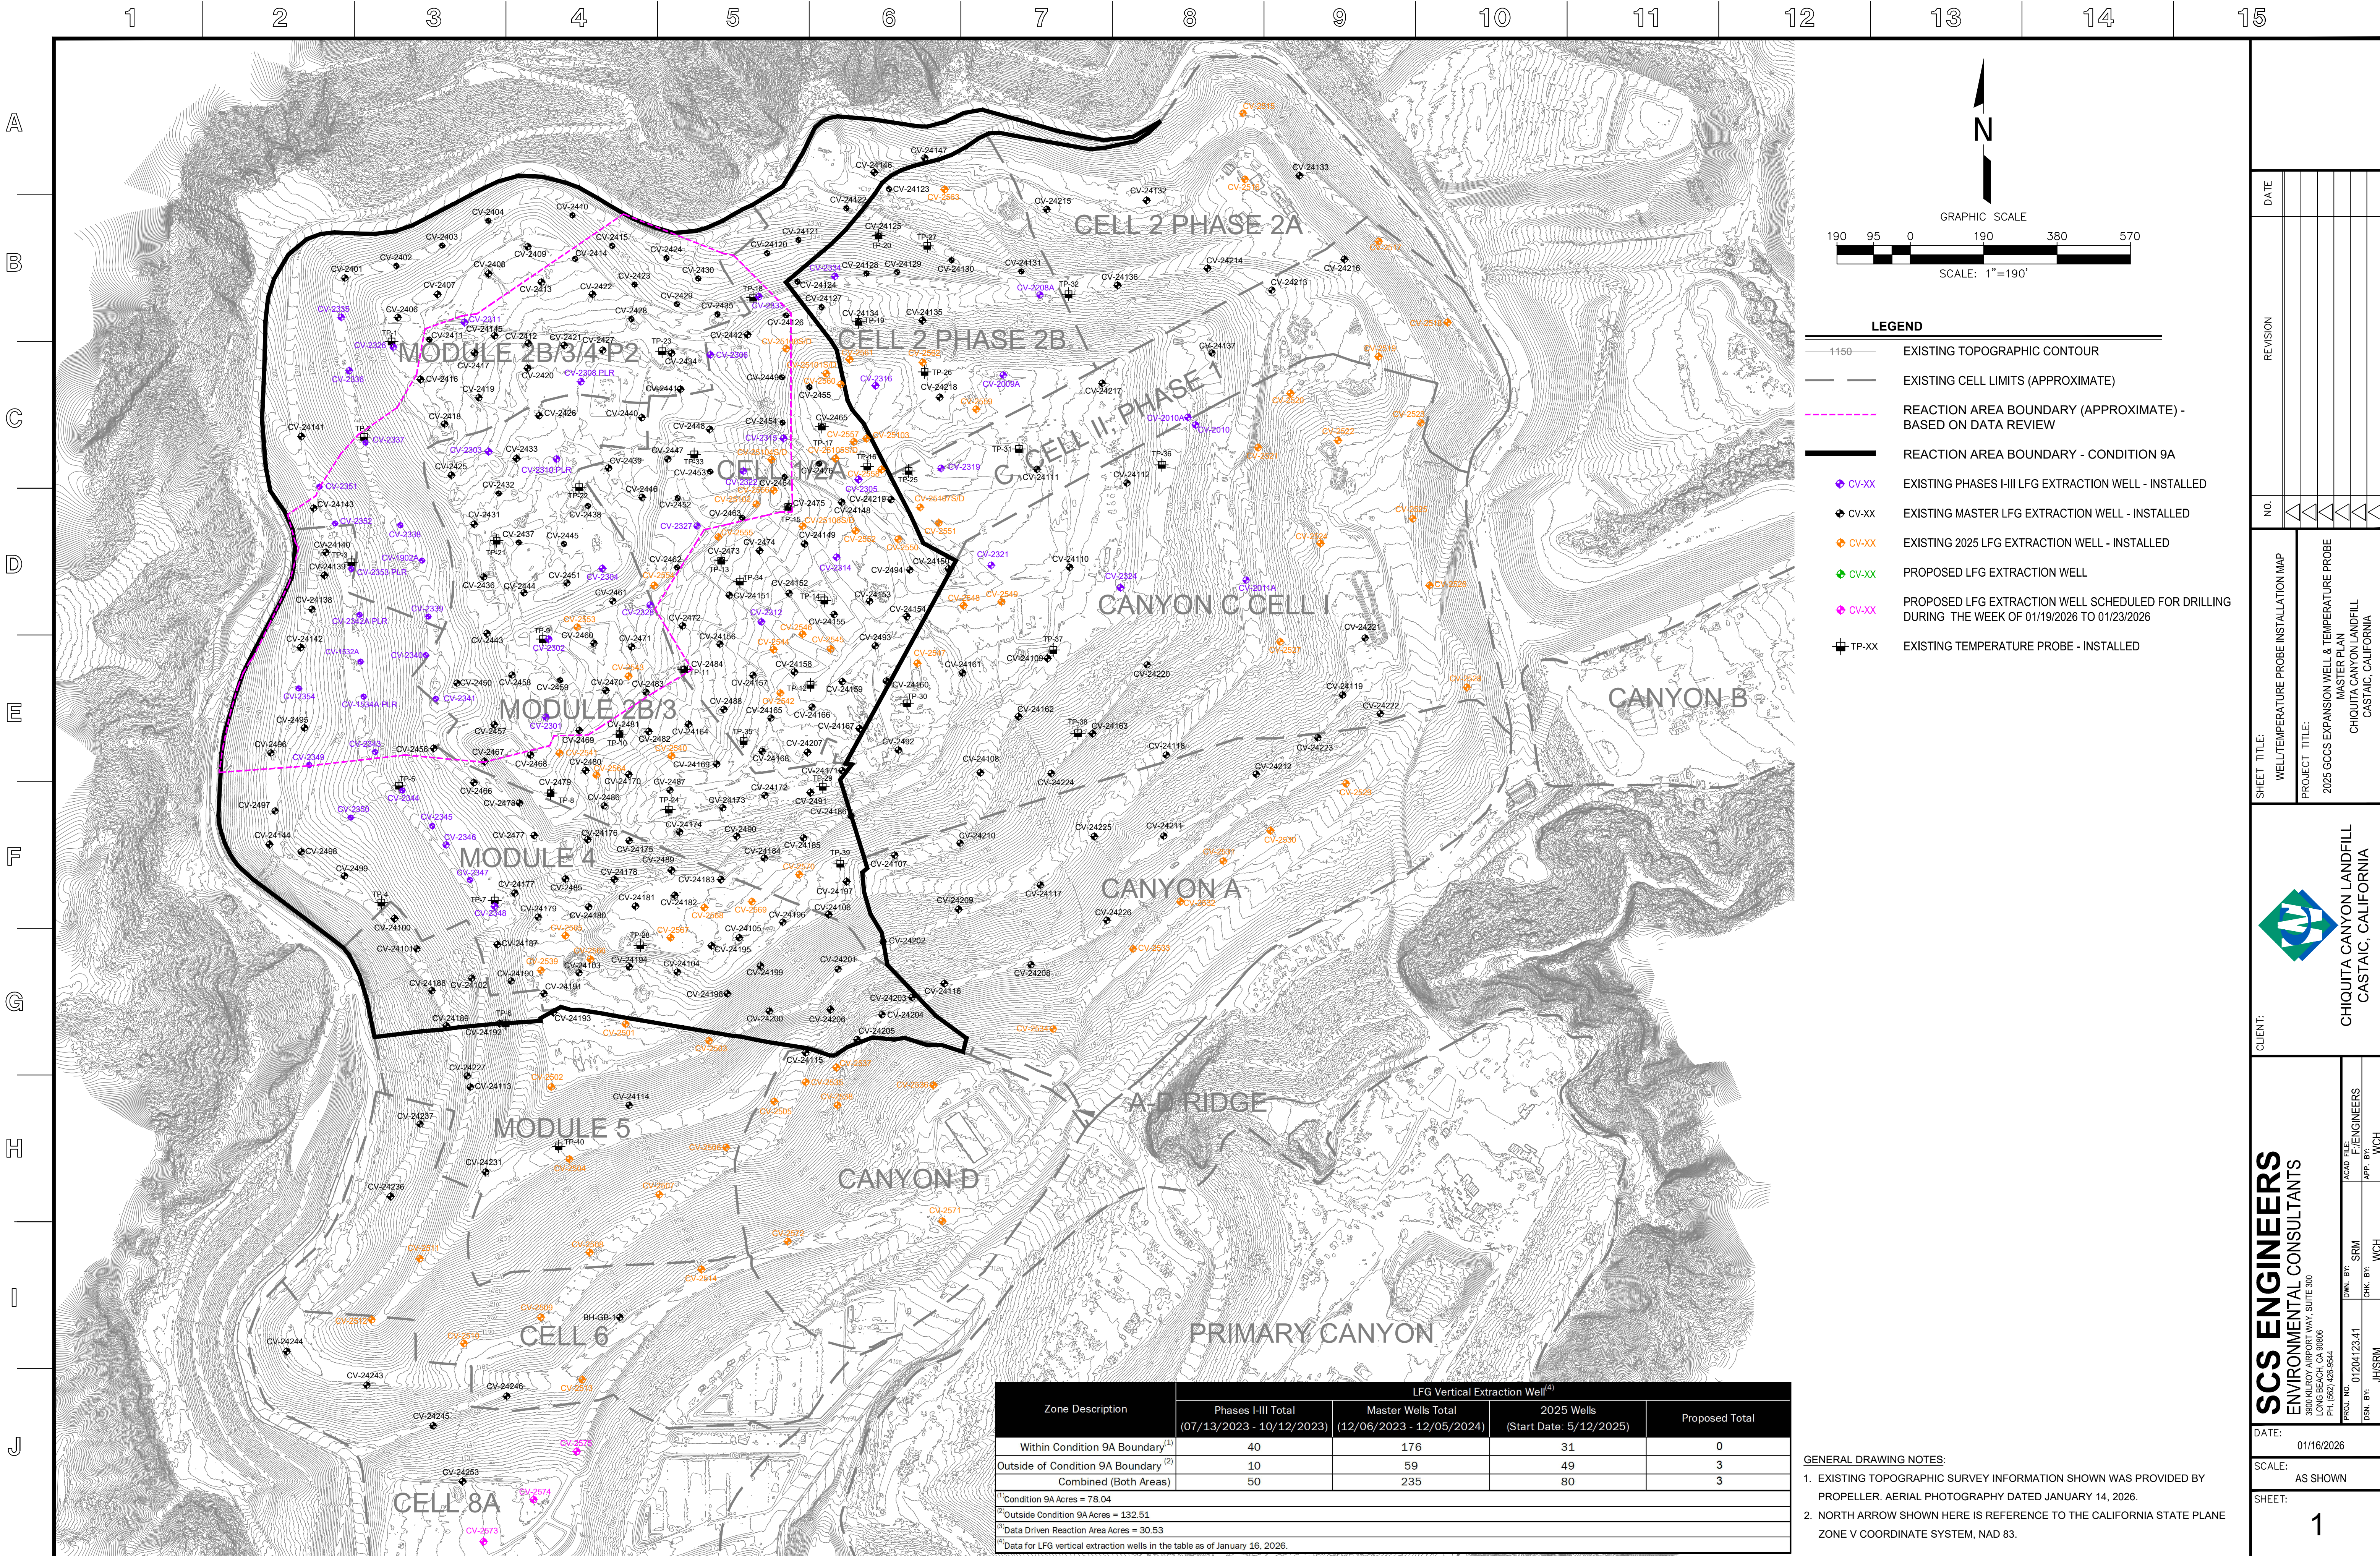

190950190380570

SCALE: 1"=190'

N

LEGEND

1150

EXISTING TOPOGRAPHIC CONTOUR

EXISTING CELL LIMITS (APPROXIMATE)

REACTION AREA BOUNDARY (APPROXIMATE) - BASED ON DATA REVIEW

REACTION AREA BOUNDARY - CONDITION 9A

CV-XX

EXISTING PHASES I-III LFG EXTRACTION WELL - INSTALLED

CV-XX

EXISTING MASTER LFG EXTRACTION WELL - INSTALLED

CV-XX

EXISTING 2025 LFG EXTRACTION WELL - INSTALLED

CV-XX

PROPOSED LFG EXTRACTION WELL

CV-XX

PROPOSED LFG EXTRACTION WELL SCHEDULED FOR DRILLING DURING THE WEEK OF 01/19/2026 TO 01/23/2026

TP-XX

EXISTING TEMPERATURE PROBE - INSTALLED

SHEET TITLE:
WELL/TEMPERATURE PROBE INSTALLATION MAP

PROJECT TITLE:
2025 GCCS EXPANSION WELL & TEMPERATURE PROBE MASTER PLAN
CHIQUITA CANYON LANDFILL
CASTAIC, CALIFORNIA

CLIENT:

SCS ENGINEERS

ENVIRONMENTAL CONSULTANTS

15000 W. ORANGE AVE., SUITE 300
LONG BEACH, CA 90806
PH: (562) 426-9544

DATE:

01/16/2026

SCALE:

AS SHOWN

SHEET:

1

Z:\Files\Engineers\Waste Connections\Chiquita Canyon LF\2025 Chiquita LF GCCS Design Svcs\05-COA\01-Boring Logs\2025 CCLF GCCS Expan Master Plan_Proposed LFG Extraction Well and Temp Probe Map_2026-01-16.dwg Jan 16, 2026 -- 7:43am By: smedina