


**Archived:** Thursday, February 5, 2026 2:56:37 PM  
**From:** [Dylan Smith](#)  
**Mail received time:** Sat, 31 Jan 2026 02:25:39  
**Sent:** Sat, 31 Jan 2026 02:25:07  
**To:** [Zmily, Zanalee@DTSC](mailto:Zmily, Zanalee@DTSC)  
**Cc:** [RRagland@ph.lacounty.gov](mailto:RRagland@ph.lacounty.gov)  
**Subject:** RE: CCL: Response to Allegation #1 of DTSC's November 18, 2025 Summary of Violations  
**Importance:** Normal  
**Sensitivity:** None  
**Attachments:** [2026 CCLF Condensate Tanks T1 and T2 As-Built\\_2026-01-30.pdf](#) 

---

[EXTERNAL SENDER: Use caution with links/attachments]

Zana and Erin,

Please see attached for the requested T1/T2 map and associated piping.

Thank you,

Dylan Smith

---

**From:** Dylan Smith <dylan.smith@wasteconnections.com>  
**Sent:** Friday, January 23, 2026 7:59 PM  
**To:** Zmily, Zanalee@DTSC <Zanalee.Zmily@dtsc.ca.gov>; Neal, Erin@DTSC <Erin.Neal@dtsc.ca.gov>  
**Cc:** RRagland@ph.lacounty.gov; LFrias@ph.lacounty.gov; NQuick@ph.lacounty.gov; sota@ph.lacounty.gov; KGork@ph.lacounty.gov; rjensen@fwhb.com; BMcphillips@counsel.lacounty.gov; ETHOMP@dpw.lacounty.gov; agarcia@planning.lacounty.gov; AHuynh@planning.lacounty.gov; Mindermann, Wes@CalRecycle <Wes.Mindermann@CalRecycle.ca.gov>; Thalhamer, Todd@CalRecycle <Todd.Thalhamer@CalRecycle.ca.gov>; Lindberg, Jeff@ARB <Jeff.Lindberg@arb.ca.gov>; Jcheng@aqmd.gov; lisrael@aqmd.gov; Casas, Enrique@Waterboards <Enrique.Casas@waterboards.ca.gov>; Berg, Thanne@DTSC <Thanne.Berg@dtsc.ca.gov>; Clark, Dylan@DTSC <Dylan.Clark@dtsc.ca.gov>; Ruttan, Peter@DTSC <Peter.Ruttan@dtsc.ca.gov>; Crick, Tim@DTSC <Tim.Crick@dtsc.ca.gov>; Barclay, Diane@DTSC <Diane.Barclay@dtsc.ca.gov>; Kane, Christopher@DTSC <Christopher.Kane@dtsc.ca.gov>; Crook, Johnathon@DTSC <Johnathon.Crook@dtsc.ca.gov>; Winebarger, Lisa@DTSC <Lisa.Winebarger@dtsc.ca.gov>; Floyd, Bridget@DTSC <Bridget.Floyd@dtsc.ca.gov>; Sarah Phillips <Sarah.Phillips@WasteConnections.com>; John Perkey <John.Perkey@WasteConnections.com>; Megan L. Morgan <MMorgan@bdlaw.com>; Nicole B. Weinstein <nweinstein@bdlaw.com>  
**Subject:** RE: CCL: Response to Allegation #1 of DTSC's November 18, 2025 Summary of Violations

[EXTERNAL SENDER: Use caution with links/attachments]

Zana and Erin,

As an update regarding the requested T1/T2 map and associated piping in the November 18, 2025 SOV, Chiquita's third-party consultant has completed the necessary site visit required to update the map. Because of the need to coordinate that site visit and the level of detail required to track the tanks' associated piping, preparation of the map has taken more time than originally anticipated. Chiquita's third-party consultant has, however, confirmed it is working expeditiously to update the map, and Chiquita expects to be able to provide the updated map to DTSC by January 30, 2026.

Please let us know if you have questions.

Thank you,

Dylan Smith

---

**From:** Kate Logan <[Kate.Logan@WasteConnections.com](mailto:Kate.Logan@WasteConnections.com)>

**Sent:** Thursday, January 15, 2026 7:01 PM

**To:** Zmily, Zanalee@DTSC <[Zanalee.Zmily@dtsc.ca.gov](mailto:Zanalee.Zmily@dtsc.ca.gov)>; Neal, Erin@DTSC <[Erin.Neal@dtsc.ca.gov](mailto:Erin.Neal@dtsc.ca.gov)>

**Cc:** [RRagland@ph.lacounty.gov](mailto:RRagland@ph.lacounty.gov); [LFrias@ph.lacounty.gov](mailto:LFrias@ph.lacounty.gov); [NQuick@ph.lacounty.gov](mailto:NQuick@ph.lacounty.gov); [sota@ph.lacounty.gov](mailto:sota@ph.lacounty.gov); [KGork@ph.lacounty.gov](mailto:KGork@ph.lacounty.gov); [rjensen@fwhb.com](mailto:rjensen@fwhb.com); [BMcphillips@counsel.lacounty.gov](mailto:BMcphillips@counsel.lacounty.gov); [ETHOMP@dpw.lacounty.gov](mailto:ETHOMP@dpw.lacounty.gov); [agarcia@planning.lacounty.gov](mailto:agarcia@planning.lacounty.gov); [AHuynh@planning.lacounty.gov](mailto:AHuynh@planning.lacounty.gov); Mindermann, Wes@CalRecycle <[Wes.Mindermann@CalRecycle.ca.gov](mailto:Wes.Mindermann@CalRecycle.ca.gov)>; Thalhamer, Todd@CalRecycle <[Todd.Thalhamer@CalRecycle.ca.gov](mailto:Todd.Thalhamer@CalRecycle.ca.gov)>; Lindberg, Jeff@ARB <[Jeff.Lindberg@arb.ca.gov](mailto:Jeff.Lindberg@arb.ca.gov)>; [Jcheng@aqmd.gov](mailto:Jcheng@aqmd.gov); [lisrael@aqmd.gov](mailto:lisrael@aqmd.gov); Casas, Enrique@Waterboards <[Enrique.Casas@waterboards.ca.gov](mailto:Enrique.Casas@waterboards.ca.gov)>; Berg, Thanne@DTSC <[Thanne.Berg@dtsc.ca.gov](mailto:Thanne.Berg@dtsc.ca.gov)>; Clark, Dylan@DTSC <[Dylan.Clark@dtsc.ca.gov](mailto:Dylan.Clark@dtsc.ca.gov)>; Ruttan, Peter@DTSC <[Peter.Ruttan@dtsc.ca.gov](mailto:Peter.Ruttan@dtsc.ca.gov)>; Crick, Tim@DTSC <[Tim.Crick@dtsc.ca.gov](mailto:Tim.Crick@dtsc.ca.gov)>; Barclay, Diane@DTSC <[Diane.Barclay@dtsc.ca.gov](mailto:Diane.Barclay@dtsc.ca.gov)>; Kane, Christopher@DTSC <[Christopher.Kane@dtsc.ca.gov](mailto:Christopher.Kane@dtsc.ca.gov)>; Crook, Johnathon@DTSC <[Johnathon.Crook@dtsc.ca.gov](mailto:Johnathon.Crook@dtsc.ca.gov)>; Winebarger, Lisa@DTSC <[Lisa.Winebarger@dtsc.ca.gov](mailto:Lisa.Winebarger@dtsc.ca.gov)>; Floyd, Bridget@DTSC <[Bridget.Floyd@dtsc.ca.gov](mailto:Bridget.Floyd@dtsc.ca.gov)>; Dylan Smith <[Dylan.Smith@WasteConnections.com](mailto:Dylan.Smith@WasteConnections.com)>; Sarah Phillips <[Sarah.Phillips@WasteConnections.com](mailto:Sarah.Phillips@WasteConnections.com)>; Amanda Froman <[Amanda.Froman@WasteConnections.com](mailto:Amanda.Froman@WasteConnections.com)>; John Perkey <[John.Perkey@WasteConnections.com](mailto:John.Perkey@WasteConnections.com)>; Megan L. Morgan <[MMorgan@bdlaw.com](mailto:MMorgan@bdlaw.com)>; Nicole B. Weinstein <[nweinstein@bdlaw.com](mailto:nweinstein@bdlaw.com)>

**Subject:** RE: CCL: Response to Allegation #1 of DTSC's November 18, 2025 Summary of Violations

[EXTERNAL SENDER: Use caution with links/attachments]

---

Good Afternoon Zana, please see attached – both the #2 and #3 were addressed in the previous submittal.

If you have any questions please let me know.

Thanks,

Kate Logan

**Senior Remediation Project Manager**

**Chiquita Canyon Landfill**

29201 Henry Mayo Dr.

Castaic, CA 91384

(m) (346) 807-5547

[Kate.Logan@WasteConnections.com](mailto:Kate.Logan@WasteConnections.com)



---

**From:** Zmily, Zanalee@DTSC <[Zanalee.Zmily@dtsc.ca.gov](mailto:Zanalee.Zmily@dtsc.ca.gov)>

**Sent:** Thursday, January 15, 2026 4:54 PM

**To:** Kate Logan <[Kate.Logan@WasteConnections.com](mailto:Kate.Logan@WasteConnections.com)>; Neal, Erin@DTSC <[Erin.Neal@dtsc.ca.gov](mailto:Erin.Neal@dtsc.ca.gov)>

**Cc:** [RRagland@ph.lacounty.gov](mailto:RRagland@ph.lacounty.gov); [LFrias@ph.lacounty.gov](mailto:LFrias@ph.lacounty.gov); [NQuick@ph.lacounty.gov](mailto:NQuick@ph.lacounty.gov); [sota@ph.lacounty.gov](mailto:sota@ph.lacounty.gov); [KGork@ph.lacounty.gov](mailto:KGork@ph.lacounty.gov); [rjensen@fwhb.com](mailto:rjensen@fwhb.com); [BMcphillips@counsel.lacounty.gov](mailto:BMcphillips@counsel.lacounty.gov); [ETHOMP@dpw.lacounty.gov](mailto:ETHOMP@dpw.lacounty.gov); [agarcia@planning.lacounty.gov](mailto:agarcia@planning.lacounty.gov); [AHuynh@planning.lacounty.gov](mailto:AHuynh@planning.lacounty.gov); Mindermann, Wes@CalRecycle

<[Wes.Mindermann@CalRecycle.ca.gov](mailto:Wes.Mindermann@CalRecycle.ca.gov)>; Thalhamer, Todd@CalRecycle <[Todd.Thalhamer@CalRecycle.ca.gov](mailto:Todd.Thalhamer@CalRecycle.ca.gov)>; Lindberg, Jeff@ARB <[Jeff.Lindberg@arb.ca.gov](mailto:Jeff.Lindberg@arb.ca.gov)>; [Jcheng@aqmd.gov](mailto:Jcheng@aqmd.gov); [lisrael@aqmd.gov](mailto:lisrael@aqmd.gov); Casas, Enrique@Waterboards <[Enrique.Casas@waterboards.ca.gov](mailto:Enrique.Casas@waterboards.ca.gov)>; Berg, Thanne@DTSC <[Thanne.Berg@dtsc.ca.gov](mailto:Thanne.Berg@dtsc.ca.gov)>; Clark, Dylan@DTSC <[Dylan.Clark@dtsc.ca.gov](mailto:Dylan.Clark@dtsc.ca.gov)>; Ruttan, Peter@DTSC <[Peter.Ruttan@dtsc.ca.gov](mailto:Peter.Ruttan@dtsc.ca.gov)>; Crick, Tim@DTSC <[Tim.Crick@dtsc.ca.gov](mailto:Tim.Crick@dtsc.ca.gov)>; Barclay, Diane@DTSC <[Diane.Barclay@dtsc.ca.gov](mailto:Diane.Barclay@dtsc.ca.gov)>; Kane, Christopher@DTSC <[Christopher.Kane@dtsc.ca.gov](mailto:Christopher.Kane@dtsc.ca.gov)>; Crook, Johnathon@DTSC <[Johnathon.Crook@dtsc.ca.gov](mailto:Johnathon.Crook@dtsc.ca.gov)>; Winebarger, Lisa@DTSC <[Lisa.Winebarger@dtsc.ca.gov](mailto:Lisa.Winebarger@dtsc.ca.gov)>; Floyd, Bridget@DTSC <[Bridget.Floyd@dtsc.ca.gov](mailto:Bridget.Floyd@dtsc.ca.gov)>; Dylan Smith <[Dylan.Smith@WasteConnections.com](mailto:Dylan.Smith@WasteConnections.com)>; Sarah Phillips <[Sarah.Phillips@WasteConnections.com](mailto:Sarah.Phillips@WasteConnections.com)>; Amanda Froman <[Amanda.Froman@WasteConnections.com](mailto:Amanda.Froman@WasteConnections.com)>; John Perkey <[John.Perkey@WasteConnections.com](mailto:John.Perkey@WasteConnections.com)>; [MMorgan@bdlaw.com](mailto:MMorgan@bdlaw.com); Nicole B. Weinstein <[nweinstein@bdlaw.com](mailto:nweinstein@bdlaw.com)>

**Subject:** RE: CCL: Response to Allegation #1 of DTSC's November 18, 2025 Summary of Violations

Thank you, Kate. We will review the response. At a glance, I do not see an updated response to Violation #3 (labeling). Does CCL intend to provide additional documentation?



**Zana Zmilv** (*she/her/hers*)  
Senior Environmental Scientist. Supervisory  
Office of Criminal Investigations  
916-926-9065  
[Zanalee.Zmily@dtsc.ca.gov](mailto:Zanalee.Zmily@dtsc.ca.gov)  
Department of Toxic Substances Control  
California Environmental Protection Agency

---

**From:** Kate Logan <[Kate.Logan@WasteConnections.com](mailto:Kate.Logan@WasteConnections.com)>

**Sent:** Thursday, January 15, 2026 4:28 PM

**To:** Neal, Erin@DTSC <[Erin.Neal@dtsc.ca.gov](mailto:Erin.Neal@dtsc.ca.gov)>; Zmily, Zanalee@DTSC <[Zanalee.Zmily@dtsc.ca.gov](mailto:Zanalee.Zmily@dtsc.ca.gov)>

**Cc:** [RRagland@ph.lacounty.gov](mailto:RRagland@ph.lacounty.gov); [LFrias@ph.lacounty.gov](mailto:LFrias@ph.lacounty.gov); [NQuick@ph.lacounty.gov](mailto:NQuick@ph.lacounty.gov); [sota@ph.lacounty.gov](mailto:sota@ph.lacounty.gov); [KGork@ph.lacounty.gov](mailto:KGork@ph.lacounty.gov); [rjensen@fwhb.com](mailto:rjensen@fwhb.com); [BMcphillips@counsel.lacounty.gov](mailto:BMcphillips@counsel.lacounty.gov); [ETHOMP@dpw.lacounty.gov](mailto:ETHOMP@dpw.lacounty.gov); [agarcia@planning.lacounty.gov](mailto:agarcia@planning.lacounty.gov); [AHuynh@planning.lacounty.gov](mailto:AHuynh@planning.lacounty.gov); Mindermann, Wes@CalRecycle

<[Wes.Mindermann@CalRecycle.ca.gov](mailto:Wes.Mindermann@CalRecycle.ca.gov)>; Thalhamer, Todd@CalRecycle <[Todd.Thalhamer@CalRecycle.ca.gov](mailto:Todd.Thalhamer@CalRecycle.ca.gov)>; Lindberg, Jeff@ARB <[Jeff.Lindberg@arb.ca.gov](mailto:Jeff.Lindberg@arb.ca.gov)>; [Jcheng@aqmd.gov](mailto:Jcheng@aqmd.gov); [lisrael@aqmd.gov](mailto:lisrael@aqmd.gov); Casas, Enrique@Waterboards <[Enrique.Casas@waterboards.ca.gov](mailto:Enrique.Casas@waterboards.ca.gov)>; Berg, Thanne@DTSC <[Thanne.Berg@dtsc.ca.gov](mailto:Thanne.Berg@dtsc.ca.gov)>; Clark, Dylan@DTSC <[Dylan.Clark@dtsc.ca.gov](mailto:Dylan.Clark@dtsc.ca.gov)>; Ruttan, Peter@DTSC <[Peter.Ruttan@dtsc.ca.gov](mailto:Peter.Ruttan@dtsc.ca.gov)>; Crick, Tim@DTSC <[Tim.Crick@dtsc.ca.gov](mailto:Tim.Crick@dtsc.ca.gov)>; Barclay, Diane@DTSC <[Diane.Barclay@dtsc.ca.gov](mailto:Diane.Barclay@dtsc.ca.gov)>; Kane, Christopher@DTSC <[Christopher.Kane@dtsc.ca.gov](mailto:Christopher.Kane@dtsc.ca.gov)>; Crook, Johnathon@DTSC <[Johnathon.Crook@dtsc.ca.gov](mailto:Johnathon.Crook@dtsc.ca.gov)>; Winebarger, Lisa@DTSC <[Lisa.Winebarger@dtsc.ca.gov](mailto:Lisa.Winebarger@dtsc.ca.gov)>; Floyd, Bridget@DTSC <[Bridget.Floyd@dtsc.ca.gov](mailto:Bridget.Floyd@dtsc.ca.gov)>; Dylan Smith <[Dylan.Smith@WasteConnections.com](mailto:Dylan.Smith@WasteConnections.com)>; Sarah Phillips <[Sarah.Phillips@WasteConnections.com](mailto:Sarah.Phillips@WasteConnections.com)>; Amanda Froman <[Amanda.Froman@WasteConnections.com](mailto:Amanda.Froman@WasteConnections.com)>; John Perkey <[John.Perkey@WasteConnections.com](mailto:John.Perkey@WasteConnections.com)>; [MMorgan@bdlaw.com](mailto:MMorgan@bdlaw.com); [nweinstein@bdlaw.com](mailto:nweinstein@bdlaw.com)

**Subject:** CCL: Response to Allegation #1 of DTSC's November 18, 2025 Summary of Violations

All—

On behalf of Chiquita Canyon, LLC, attached please find a supplemental response to DTSC's November 18, 2025 Summary of Violations regarding the Chiquita Canyon Landfill. Attachments include:

1. Chiquita's letter response to Allegation #1 of DTSC's November 18, 2025 Summary of Violations
2. Attachment 1 – Chiquita's December 18, 2025 Response to DTSC's SOV
3. Attachment 2 – Updated Manifests
4. Attachment 3 – Chiquita Tank Farm 13 and related SOPs

Please let us know if you have questions or would like to have a call to discuss.

Kate

Kate Logan

**Senior Remediation Project Manager**

**Chiquita Canyon Landfill**

29201 Henry Mayo Dr.

Castaic, CA 91384

(m) (346) 807-5547


[Kate.Logan@WasteConnections.com](mailto:Kate.Logan@WasteConnections.com)



WASTE CONNECTIONS  
*Connect with the Future*


1 2 3 4 5 6 7 8 9 10 11 12 13 14 15

A  
B  
C  
D  
E  
F  
G  
H  
I  
J

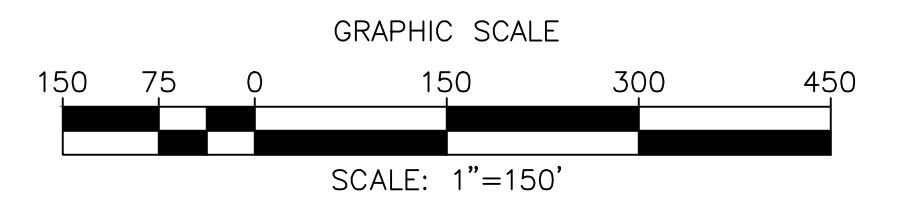


**LEGEND**

	EXISTING CONDENSATE LINE
	EXISTING VACUUM LINE
	EXISTING AIRLINE

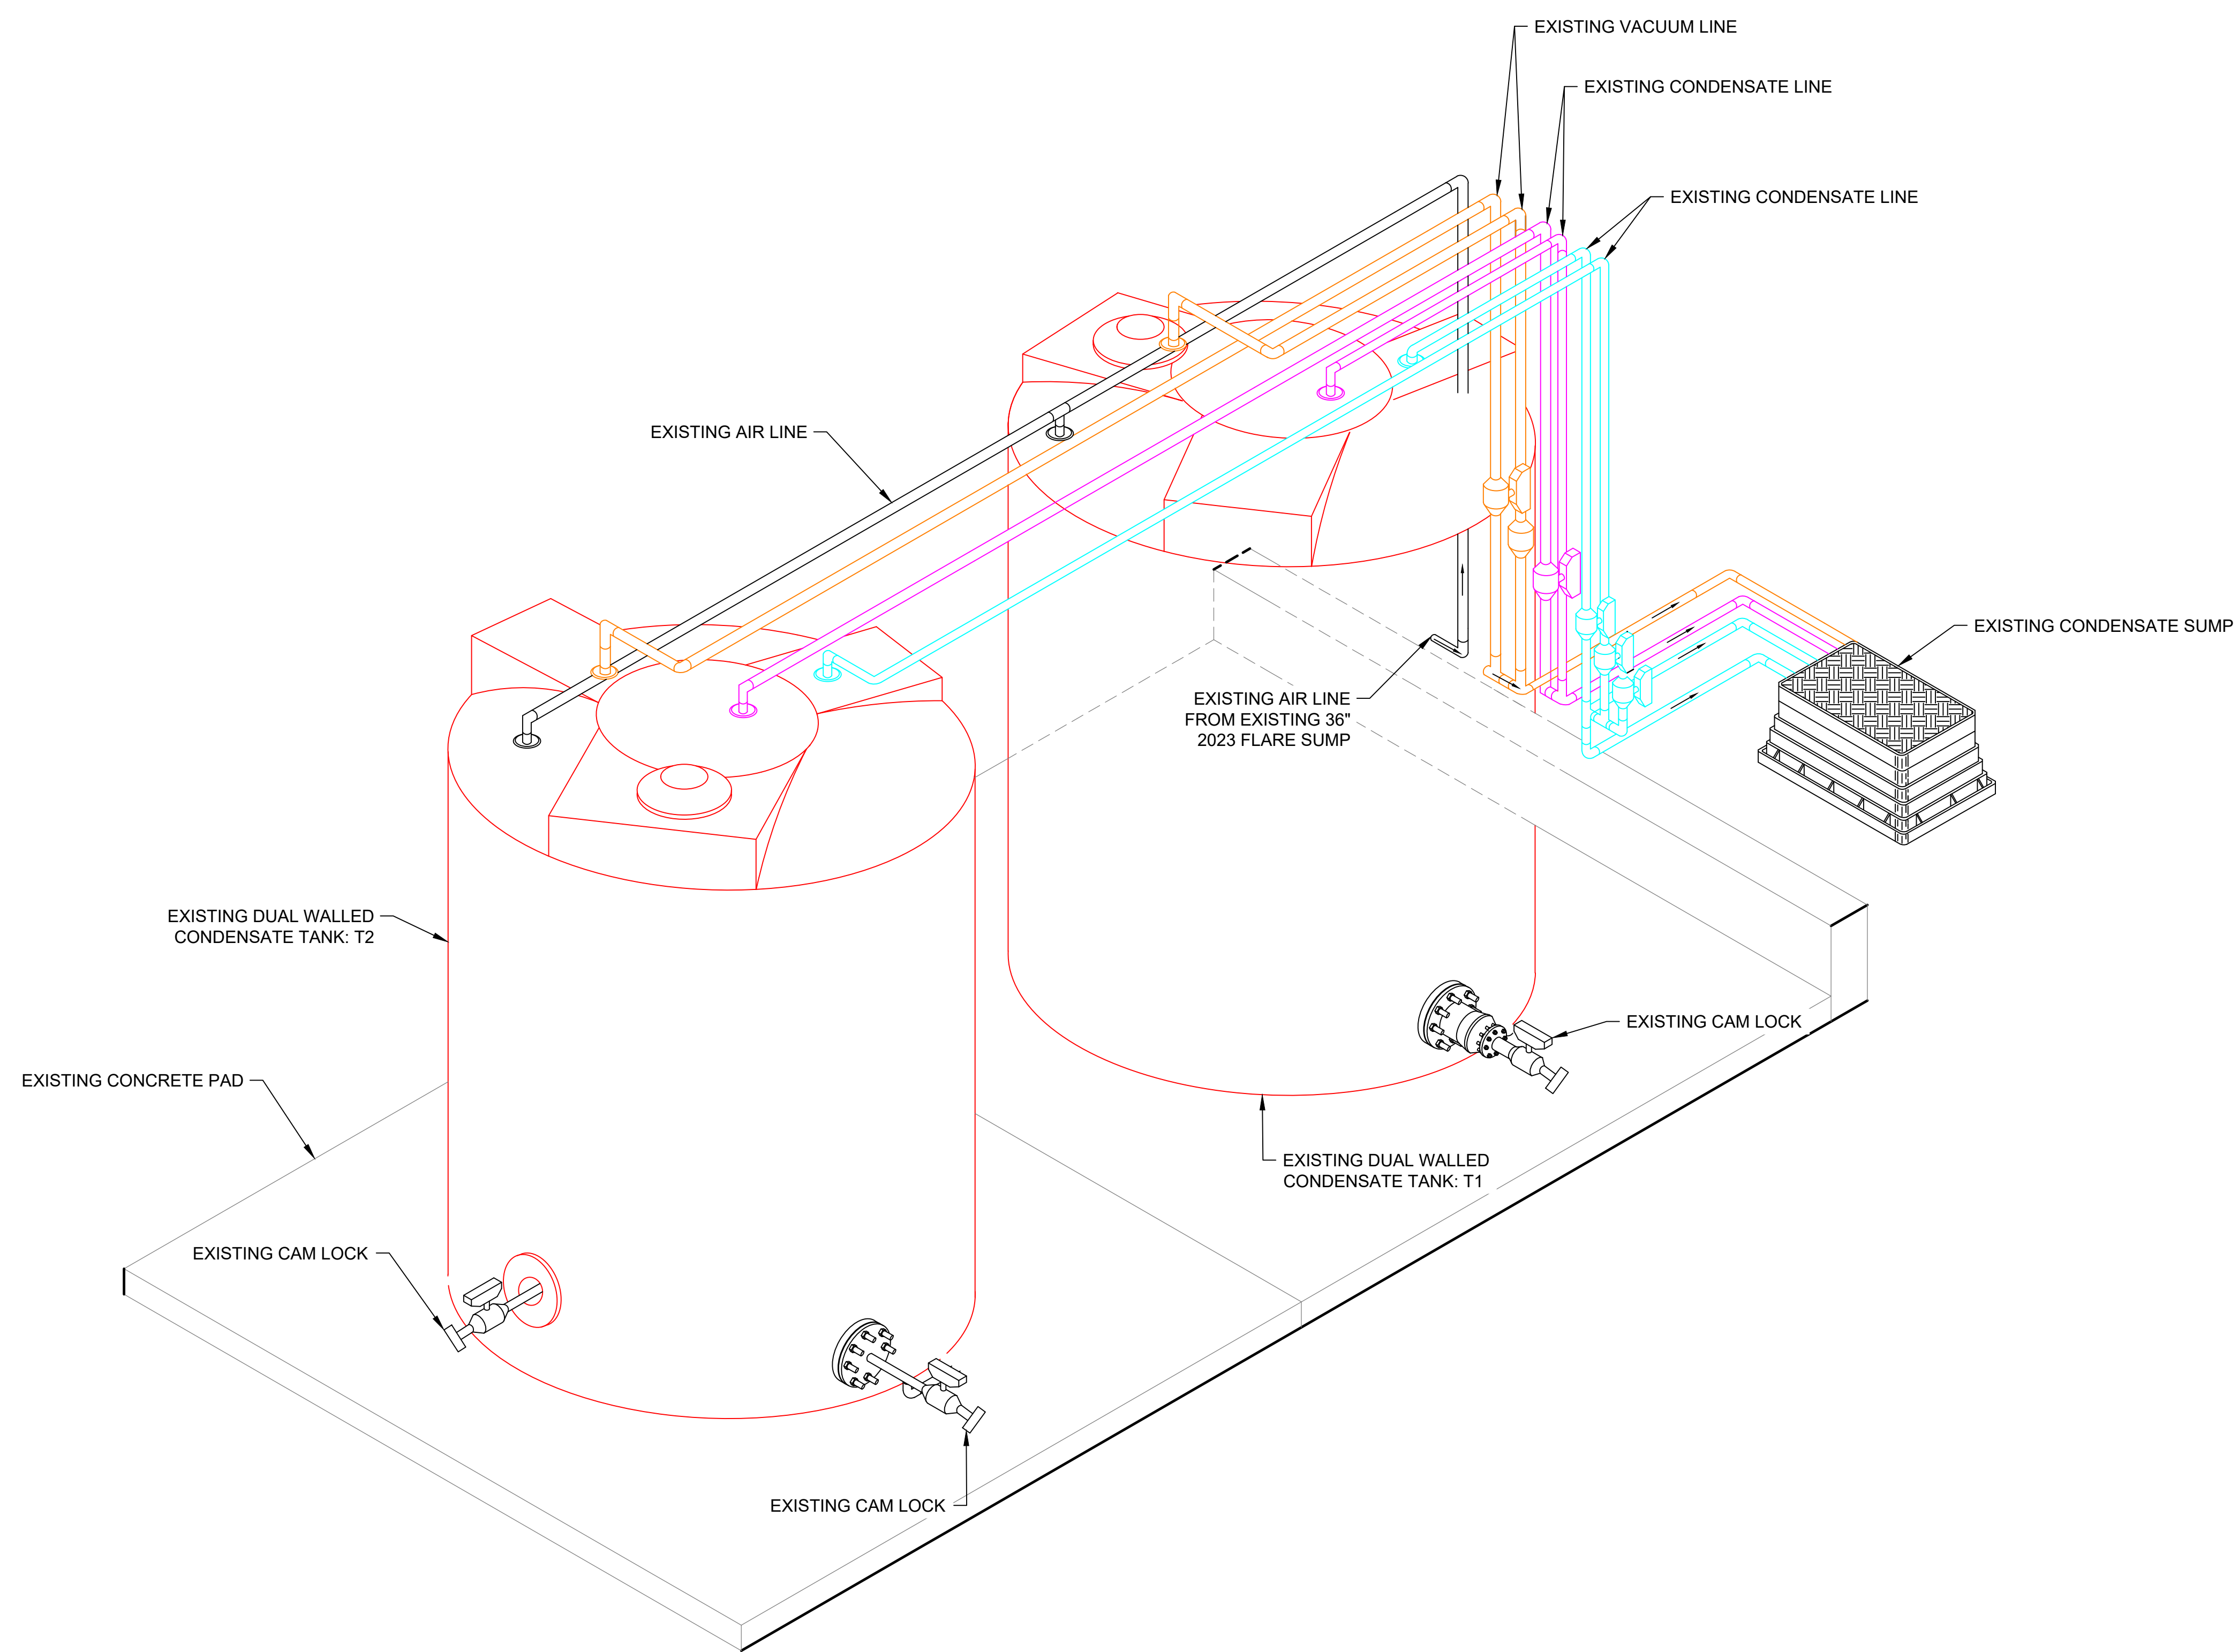

NO.	REVISION	DATE

SHEET TITLE: EXISTING CONDENSATE TANKS T1 & T2 AS-BUILT  
 PROJECT TITLE: CHIQUITA CANYON LANDFILL CASTAIC, CALIFORNIA

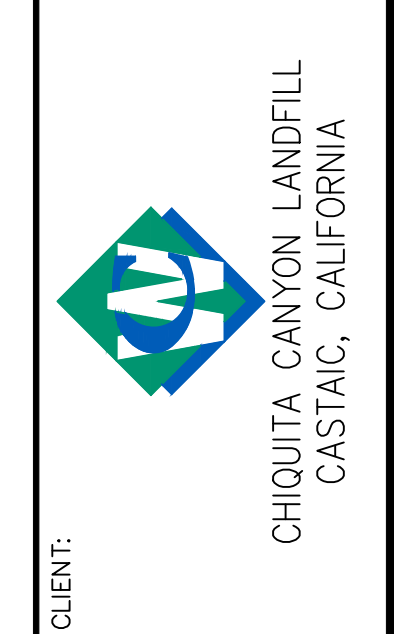

**SCS ENGINEERS**  
 ENVIRONMENTAL CONSULTANTS  
 3800 N. GARDEN, SUITE 300  
 LONG BEACH, CA 90808  
 PH: (562) 428-9544

DATE: 01/30/2026

SCALE: AS SHOWN

SHEET: 1

**GENERAL DRAWING NOTES:**

1. NORTH ARROW SHOWN HERE IS REFERENCE TO THE CALIFORNIA STATE PLANE ZONE V COORDINATE SYSTEM, NAD 83.
2. THE LOCATION OF ANY EXISTING GCCS COMPONENTS AND OTHER FEATURES ARE APPROXIMATE AND SHOULD BE USED FOR INFORMATION PURPOSES ONLY.

N:\CAD\ASBUILT - MASTERS\CHIQUITA\GCCS\2026 ACAD\2026 CCLF Condensate Tanks T1 and T2 As-Built\_2026-01-30.dwg Jan 30, 2026 By: smedina