



CHIQUITA CANYON
A Waste Connections Company

February 12, 2026

California Regional Water Quality Control Board
Los Angeles Region
320 W. 4th Street, Suite 200
Los Angeles, California 90013
ATTN: Information Technology Unit

**Subject: Leachate Spill Report
Chiquita Canyon Landfill
File No. 67-020**

Out of an abundance of caution and in an effort to be transparent, Chiquita Canyon, LLC (“Chiquita”) voluntarily provides the following information regarding a spill that occurred on February 5, 2026 at the Chiquita Canyon Landfill, during which approximately one to two (1-2) gallons of presumed characteristically hazardous liquid spilled on the road north of grid 21. Liquid spilled outside of the landfill’s footprint but did not reach the stormwater channel or either stormwater basin. The volume of the spill is a conservative estimate based on visual observation by Chiquita staff. Chiquita maintains appropriate response materials, including fully stocked spill kits, and has trained staff on site to respond to spills and leaks to prevent liquids from entering the stormwater system.

i. Map - A map showing the location(s) of leakage.

The spill occurred north of grid 21 – as depicted in **Attachment A**.

ii. Flow rate - An estimate of the flow rate.

The spill had a very low flow rate.

iii. Description - A description of the nature of the discharge (e.g., all pertinent observations and analyses).

At approximately 1:50 p.m. on February 5, 2026, liquid spilled while a contractor was transporting 2-inch HDPE pipes to the laydown yard for storage. Residual liquid in the pipes appears to have spilled while the pipes were being transported. Chiquita attributes this spill to third-party contractor error. Because of the nature of this spill, Chiquita is unable to determine the exact group association of the liquid. The liquid was dark brown in color, with a low viscosity, and had a very low flow rate.

February 12, 2026

Page 2 of 2

iv. Location – Location of sample(s) collected for laboratory analysis, as appropriate.

No sampling of this spill was conducted.

v. Corrective measures – approved (or proposed for consideration) by the Regional Board Executive Officer.

Upon discovering the spill, Chiquita promptly removed the impacted soil. The soil was then placed into a container for proper disposal. Cleanup commenced immediately and was completed in less than 30 minutes.


Additionally, Chiquita is taking steps to prevent a similar spill from occurring in the future. Chiquita discussed with the relevant third-party contractor situational awareness and proper handling and transport procedures for pipes with the potential to contain residual liquids.

If you should have any questions regarding this report, please do not hesitate to contact me at (661) 257-3655.

Sincerely,
Chiquita Canyon, LLC

Sarah Phillips
Corporate Compliance Manager
Chiquita Canyon Landfill

Attachments:
Attachment A – Map depicting the location of the spill

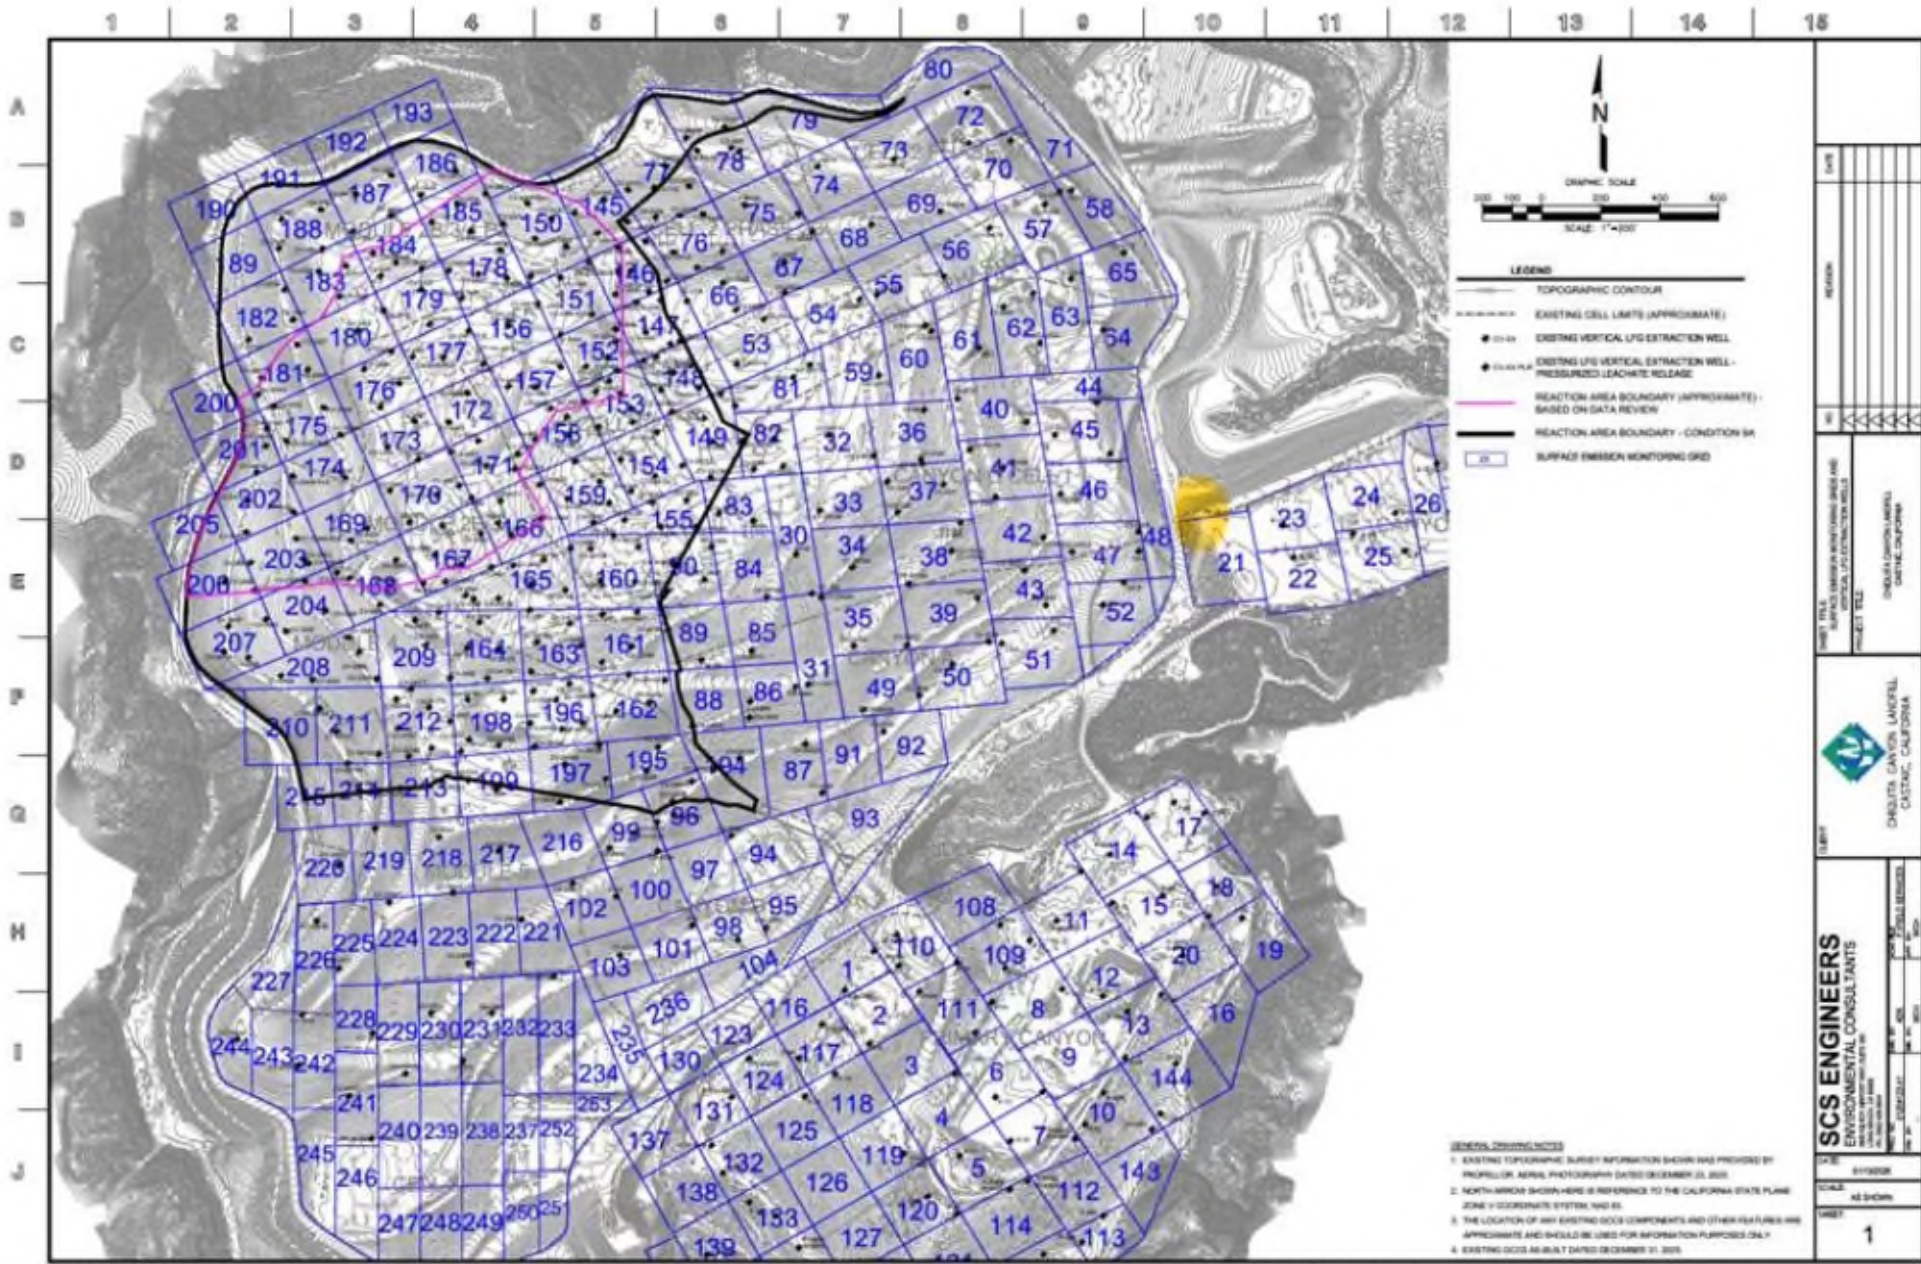

DATE	
REVISION	

WEST TITLE SURFACE EMISSION MONITORING AREA AND VERTICAL LPG EXTRACTION WELLS
PROJECT FILE




SCS ENGINEERS
ENVIRONMENTAL CONSULTANTS


SCALE: AS SHOWN
SHEET: 1