
From: Medina, Steven <SMedina@scsengineers.com>
Sent: Friday, March 27, 2026 5:06 PM
To: Baitong Chen; Christina Ojeda; Nathaniel Dickel
Cc: Haley, William (Bill); Chris Fear; Han, Jessie; Viswanathan, Srividhya; Mark.Adams; Dylan Smith; Sarah Phillips
Subject: UPDATED: Case No. 6177-4 Stipulated Order for Abatement - Weekly Pump Installation and Operation Update
Attachments: 2026 CCLF Existing De-Watering Well with Pump Map_2026-03-20.pdf

[EXTERNAL SENDER: Use caution with links/attachments]

Hello All,

We are resubmitting this update to include a map of the LFG wells with operating pumps as of the date of the original submittal, March 20, 2026.

In accordance with Condition 65 of the Modified Stipulated Order, below is the summary of the installation and operation of dewatering pumps for the Chiquita Canyon Landfill. This information is subject to change based on further review and verification.

During 03/13/2026 to 03/19/2026, Chiquita completed the installation of, and began operating during the day, nine (9) pumps in a vertical LFG extraction well for a total of fifty-four (54) pumps operating in vertical LFG extraction wells. No pumps were taken offline last week. The number of pumps offline is higher than usual due in large part to reduced off-site leachate disposal capacity and the ongoing EVOH/HDPE geomembrane cover deployment. Please note that Chiquita has additional pumps in operation in perimeter sumps that are not included in this count.

During 03/20/2026 to 03/26/2026, given the number of dewatering pumps installed to date, and the maintenance associated with those pumps, Chiquita plans to install and begin operating zero (0) additional pumps in vertical LFG extraction wells in locations along the north and south slope of the reaction area. Pump installation will resume once the existing pumps are turned back on, subject to disposal outlet capacity.

Regards,

STEVEN Ruben Medina, **E.I.T.**
Staff Professional
SCS Engineers
3900 Kilroy Airport Way, Suite 300
Long Beach, CA 90806
858-204-4342 (c)
SMedina@scsengineers.com

Driven by Client Success
www.scsengineers.com

2024 Conrad Quality Focus Award Recipient



From: Medina, Steven <SMedina@scsengineers.com>

Sent: Friday, March 20, 2026 11:38 AM

To: Baitong Chen <bchen@aqmd.gov>; Nathaniel Dickel <ndickel@aqmd.gov>; Christina Ojeda <cojeda@aqmd.gov>

Cc: Haley, William (Bill) <WCHaley@scsengineers.com>; Chris Fear <christopher.fear@wasteconnections.com>; Han, Jessie <JHan@scsengineers.com>; Viswanathan, Srividhya <SViswanathan@scsengineers.com>; Mark.Adams <Mark.Adams@WasteConnections.com>; Dylan Smith <Dylan.Smith@WasteConnections.com>; Sarah Phillips <Sarah.Phillips@WasteConnections.com>

Subject: Case No. 6177-4 Stipulated Order for Abatement - Weekly Pump Installation and Operation Update

Hello All,

During 03/13/2026 to 03/19/2026, Chiquita completed the installation of, and began operating during the day, nine (9) pumps in a vertical LFG extraction well for a total of fifty-four (54) pumps operating in vertical LFG extraction wells. No pumps were taken offline last week. Due to a system-wide shutdown, SCS is currently unable to access the up-to-date map of LFG wells with operating pumps. SCS will provide the map in a revised report once the system returns to normal operation. The number of pumps offline is higher than usual due in large part to reduced off-site leachate disposal capacity and the ongoing EVOH/HDPE geomembrane cover deployment. Please note that Chiquita has additional pumps in operation in perimeter sumps that are not included in this count.

During 03/20/2026 to 03/26/2026, given the number of dewatering pumps installed to date, and the maintenance associated with those pumps, Chiquita plans to install and begin operating zero (0) additional pumps in vertical LFG extraction wells in locations along the north and south slope of the reaction area. Pump installation will resume once the existing pumps are turned back on, subject to disposal outlet capacity.

Regards,

STEVEN Ruben Medina, **E.I.T.**

Staff Professional

SCS Engineers

3900 Kilroy Airport Way, Suite 300

Long Beach, CA 90806


858-204-4342 (c)

SMedina@scsengineers.com

Driven by Client Success

www.scsengineers.com


*2024 Conrad Quality Focus
Award Recipient*

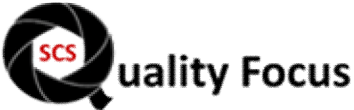

GENERAL DRAWING NOTES:

- EXISTING TOPOGRAPHIC SURVEY INFORMATION SHOWN WAS PROVIDED BY PROPELLOR. AERIAL PHOTOGRAPHY DATED MARCH 18, 2026.
- NORTH ARROW SHOWN HERE IS REFERENCE TO THE CALIFORNIA STATE PLANE ZONE V COORDINATE SYSTEM, NAD 83.
- THE LOCATION OF ANY EXISTING GCCS COMPONENTS AND OTHER FEATURES ARE APPROXIMATE AND SHOULD BE USED FOR INFORMATION PURPOSES ONLY.

A
B
C
D
E
F
G
H
I
J

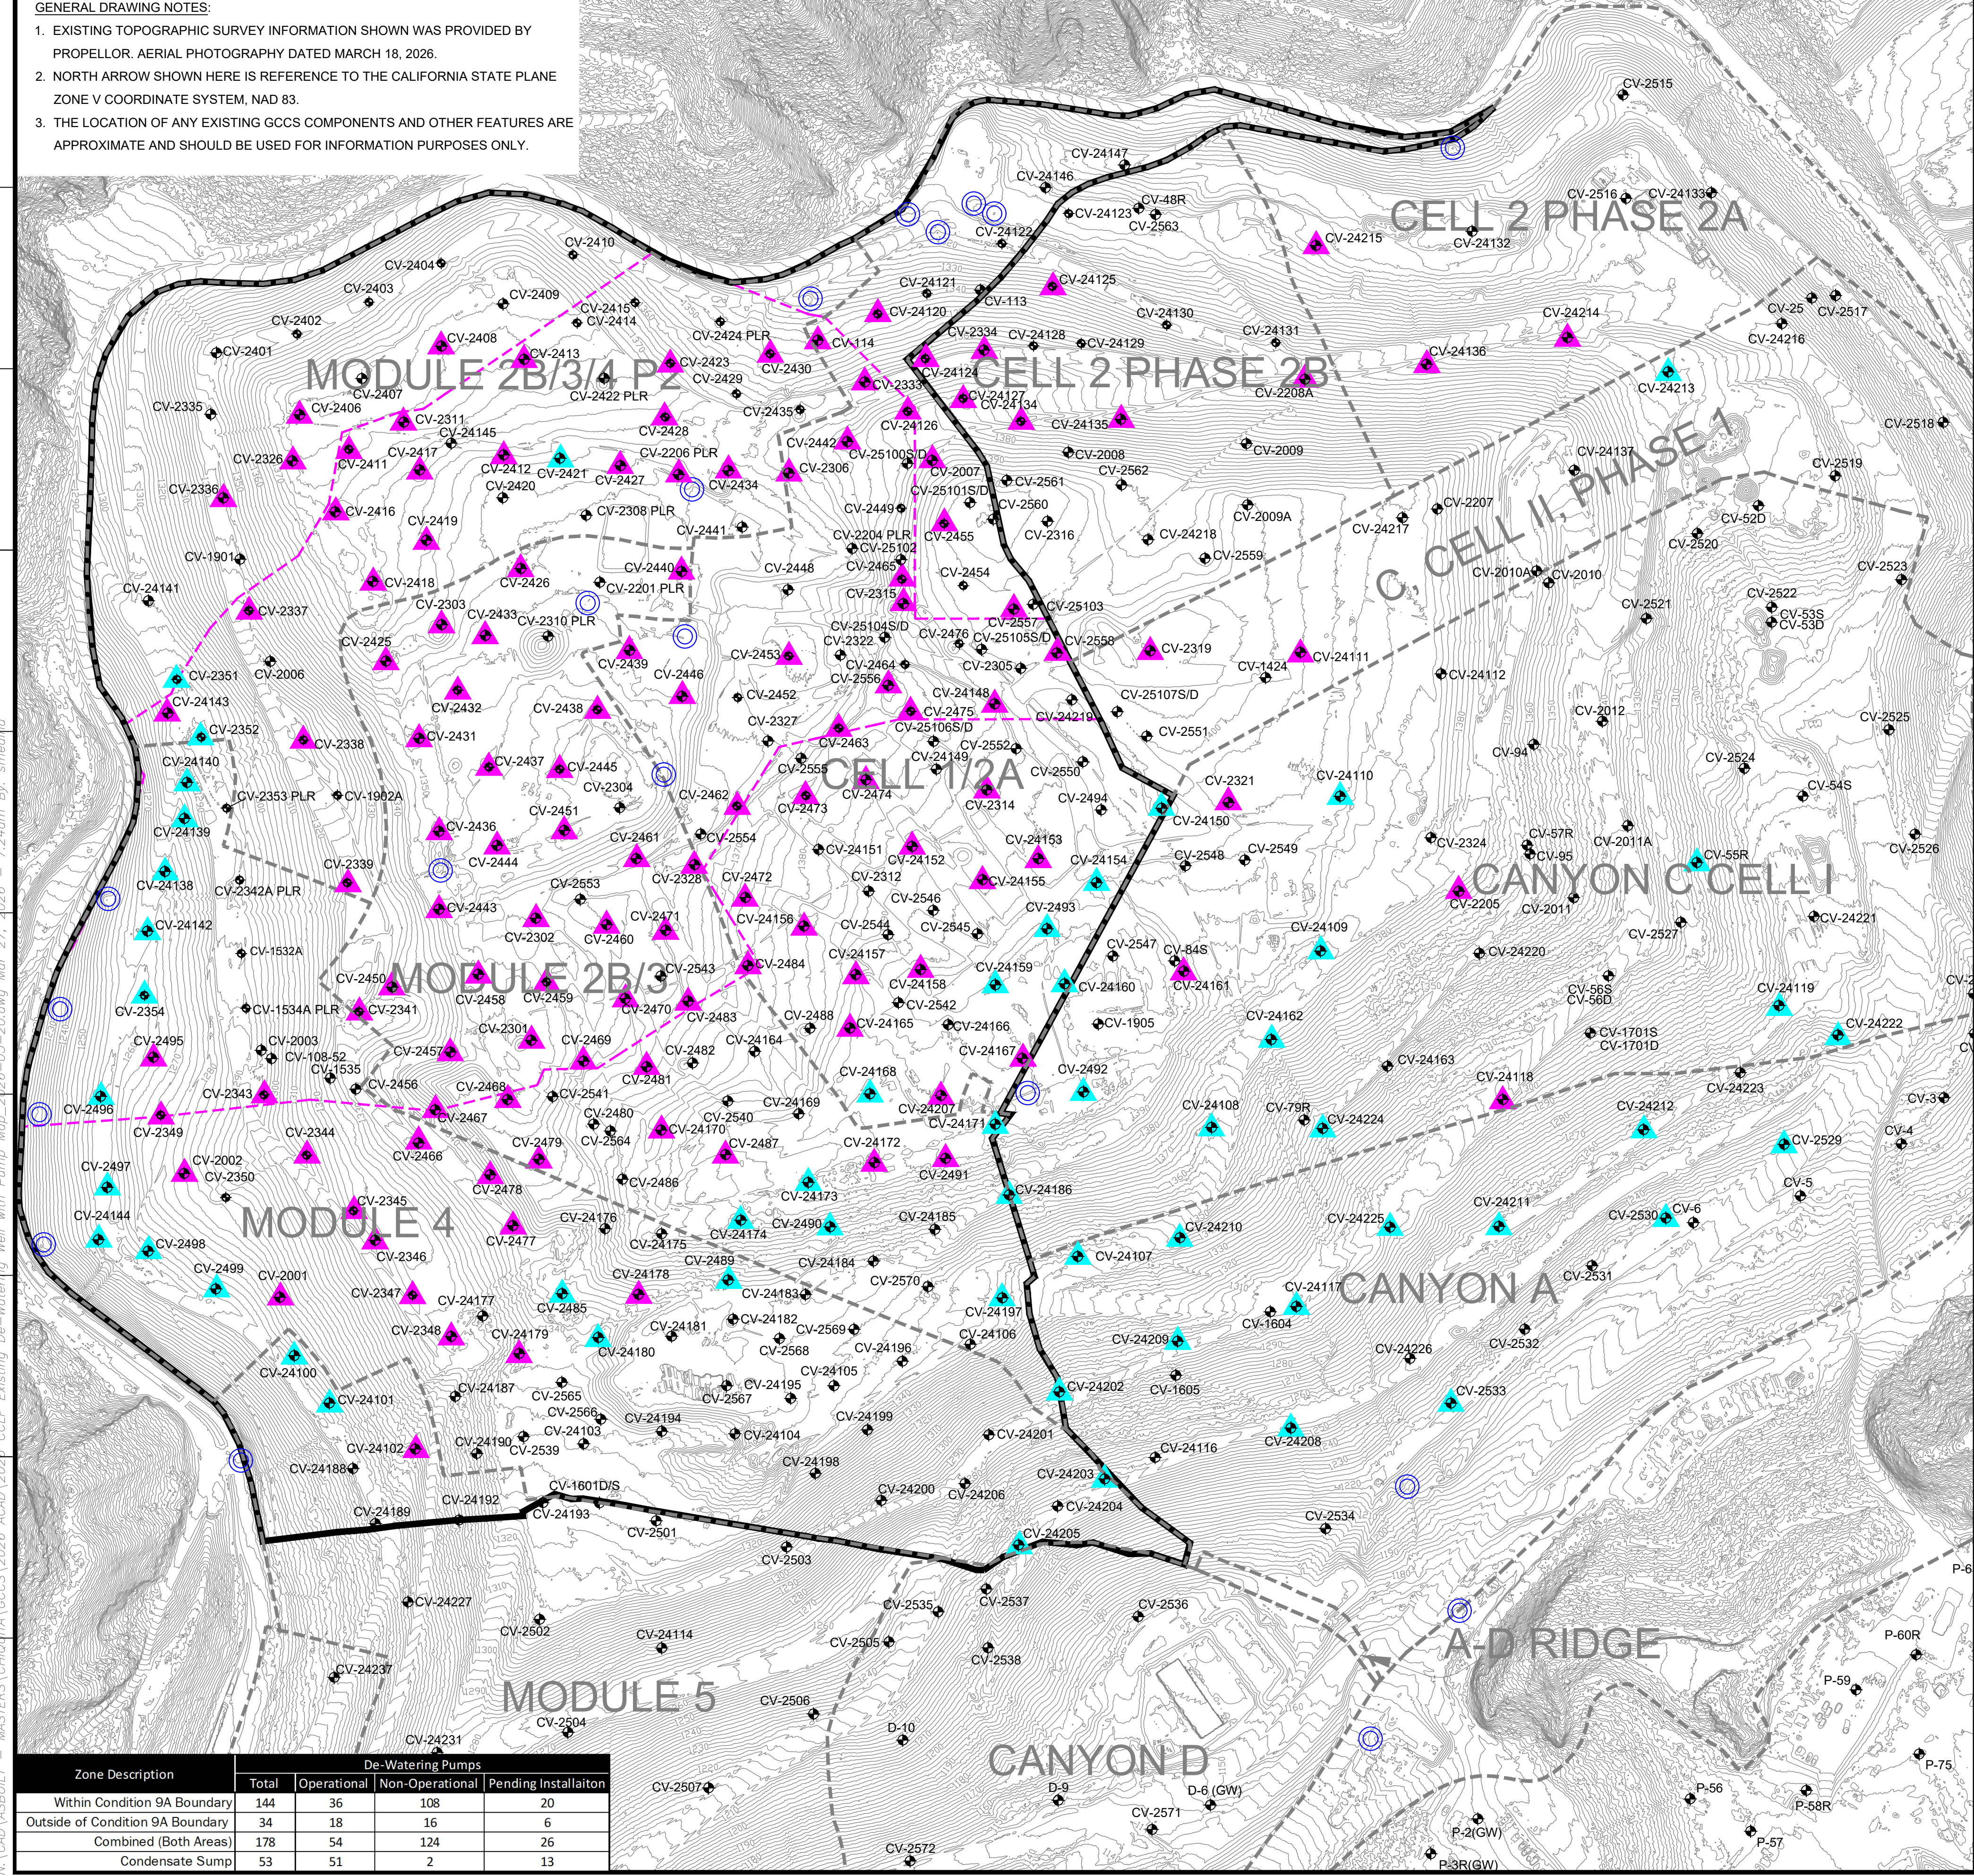

#	Well I.D.	Operational Startup Date
1	CV-114	
2	CV-2001	
3	CV-2002	
4	CV-2007	
5	CV-2205	
6	CV-2206-PLR	
7	CV-2208A	
8	CV-2301	
9	CV-2302	
10	CV-2303	
11	CV-2306	
12	CV-2311	
13	CV-2314	
14	CV-2315	
15	CV-2319	
16	CV-2321	
17	CV-2326	
18	CV-2328	
19	CV-2333	
20	CV-2334	
21	CV-2336	
22	CV-2337	
23	CV-2338	
24	CV-2339	
25	CV-2341	
26	CV-2343-PLR	
27	CV-2344	
28	CV-2345	
29	CV-2346	
30	CV-2347	
31	CV-2348	
32	CV-2349	
33	CV-2406	
34	CV-2408	
35	CV-2411	
36	CV-2412	
37	CV-2413	
38	CV-2416	
39	CV-2417	
40	CV-2419	
41	CV-2418	
42	CV-2423	
43	CV-2425	
44	CV-2426	
45	CV-2427	
46	CV-2428	
47	CV-2430	
48	CV-2431	
49	CV-2432	
50	CV-2433	
51	CV-2434	
52	CV-2436	
53	CV-2437	
54	CV-2438	
55	CV-2439	
56	CV-2440	
57	CV-2442	
58	CV-2443	
59	CV-2444	
60	CV-2445	
61	CV-2446	
62	CV-2450	
63	CV-2451	
64	CV-2453	
65	CV-2455	
66	CV-2457	
67	CV-2458	
68	CV-2459	
69	CV-2460	
70	CV-2461	
71	CV-2462	
72	CV-2463	
73	CV-2465	
74	CV-2466	
75	CV-2467	
76	CV-2468	
77	CV-2469	
78	CV-2470	
79	CV-2471	
80	CV-2472	
81	CV-2473	
82	CV-2474	
83	CV-2475	
84	CV-2477	
85	CV-2478	
86	CV-2479	
87	CV-2481	
88	CV-2483	
89	CV-2484	
90	CV-2487	
91	CV-2491	
92	CV-2495	
93	CV-24102	
94	CV-24111	
95	CV-24118	
96	CV-24120	
97	CV-24124	
98	CV-24125	
99	CV-24126	
100	CV-24127	
101	CV-24134	
102	CV-24135	
103	CV-24136	
104	CV-24143	
105	CV-24148	
106	CV-24152	
107	CV-24153	
108	CV-24155	
109	CV-24156	
110	CV-24157	
111	CV-24158	
112	CV-24161	
113	CV-24165	
114	CV-24167	
115	CV-24170	
116	CV-24172	
117	CV-24178	
118	CV-24179	
119	CV-24207	
120	CV-24214	
121	CV-24215	
122	CV-24216	
123	CV-24217	
124	CV-24218	

De-Watering Well Pumps That Are Currently Installed and Not In Operation

150 75 0 150 300 450
GRAPHIC SCALE
SCALE: 1"=150'

LEGEND

- 1150 TOPOGRAPHIC CONTOUR
- EXISTING CELL LIMITS (APPROXIMATE)
- REACTION AREA BOUNDARY - CONDITION 9A
- REACTION AREA BOUNDARY - DATA ANALYSIS
- CV-XX EXISTING VERTICAL LFG EXTRACTION WELL
- CV-XX PLR EXISTING LFG VERTICAL EXTRACTION WELL - PRESSURIZED LEACHATE RELEASE
- EXISTING CONDENSATE SUMP WITH PUMP
- ▲ EXISTING DE-WATERING WELL WITH PUMP - CURRENTLY RUNNING
- ▲ EXISTING DE-WATERING WELL WITH PUMP - INSTALLED

De-Watering Well Pumps that are Currently Running

#	Well I.D.	Operational Startup Date
1	CV-24142	5/3/2024
2	CV-24144	5/13/2024
3	CV-2496	5/30/2024
4	CV-2497	5/30/2024
5	CV-24109	7/3/2024
6	CV-24162	7/7/2024
7	CV-24101	7/8/2024
8	CV-24100	7/17/2024
9	CV-2498	7/18/2024
10	CV-24108	9/4/2024
11	CV-24210	9/10/2024
12	CV-24212	1/10/2025
13	CV-24202	2/20/2025
14	CV-24209	2/28/2025
15	CV-24197	3/11/2025
16	CV-24168	4/7/2025
17	CV-24171	4/7/2025
18	CV-24173	4/15/2025
19	CV-24174	4/15/2025
20	CV-24159	4/16/2025
21	CV-24154	4/17/2025
22	CV-2354	5/6/2025
23	CV-2493	5/6/2025
24	CV-24160	5/6/2025
25	CV-2492	5/7/2025
26	CV-24224	5/12/2025
27	CV-24117	5/13/2025
28	CV-24119	5/14/2025
29	CV-24107	5/15/2025
30	CV-24211	5/15/2025
31	CV-24208	5/16/2025
32	CV-24205	5/20/2025
33	CV-2490	6/5/2025
34	CV-24203	6/5/2025
35	CV-24225	6/9/2025
36	CV-24186	6/10/2025
37	CV-24222	6/10/2025
38	CV-24139	6/12/2025
39	CV-24140	6/14/2025
40	CV-55R	6/23/2025
41	CV-24213	7/9/2025
42	CV-24150	7/9/2025
43	CV-24110	7/17/2025
44	CV-2485	8/7/2025
45	CV-24180	8/15/2025
46	CV-2489	9/4/2025
47	CV-2530	10/3/2025
48	CV-2533	10/3/2025
49	CV-2529	10/18/2025
50	CV-2351	1/23/2026
51	CV-24138	1/23/2026
52	CV-2352	1/26/2026
53	CV-2499	1/27/2026
54	CV-2421	3/16/2026

Zone Description	De-Watering Pumps			
	Total	Operational	Non-Operational	Pending Installation
Within Condition 9A Boundary	144	36	108	20
Outside of Condition 9A Boundary	34	18	16	6
Combined (Both Areas)	178	54	124	26
Condensate Sump	53	51	2	13

DATE: 03/20/2026

SCALE: AS SHOWN

SHEET: 1

CLIENT: CHIQUITA CANYON LANDFILL CASTAIC, CALIFORNIA

PROJECT TITLE: CHIQUITA CANYON LANDFILL CASTAIC, CALIFORNIA

AGENCY FILE: NUCAD/ASR/IL-MASTERS

DATE: 01/20/24 12:41

APP. BY: SRM

CHK. BY: SRM

DATE: 03/20/2026

SCALE: AS SHOWN

SHEET: 1