

---

**De:** Medina, Steven <SMedina@scsengineers.com>  
**Enviado:** Viernes 22 de mayo de 2026 12:38 PM  
**Para:** Nathaniel Dickel; Christina Ojeda; Baitong Chen  
**Cc:** Viswanathan, Srividhya; Jones, Art; Mark.Adams; Dylan Smith; Matt Breuer; Sarah Phillips; Han, Jessie; Huber, Rachelle; Bill Haley  
**Asunto:** Orden de Depuración Estipulada del Caso No. 6177-4 - Actualización sobre la Perforación del Pozo  
**Adjuntos:** 2025 CCLF GCCS Expan Master Plan\_Proposed LFG Extraction Well and Temp Probe Map\_2026-05-22.pdf

[REMITENTE EXTERNO: Tenga precaución con los enlaces/adjuntos]

---

Todos,

Chiquita presenta esta actualización en cumplimiento con la Condición 15(c) de la Orden Estipulada. Desde el 6 de diciembre de 2023 (la fecha de inicio de la Expansión Maestra de GCCS) hasta hoy, Chiquita ha instalado un total de trescientos quince (315) pozos de extracción vertical de LFG.

No se instaló ningún pozo de extracción vertical la semana pasada y ninguno tiene programado actualmente perforar la próxima semana. Chiquita continúa evaluando las necesidades del sitio y programará otra perforación como corresponda.

Como referencia, la figura adjunta exhibe los pozos instalados hasta la fecha.

Atentamente,

**STEVEN** Rubén Medina, **E.I.T.**

Profesional del Proyecto

**SCS Engineers**

3900 Kilroy Airport Way, Suite 300

Long Beach, CA 90806



858-204-4342 (c)

[SMedina@scsengineers.com](mailto:SMedina@scsengineers.com)

**Dirigidos por el Éxito de los Clientes**

[www.scsengineers.com](http://www.scsengineers.com)



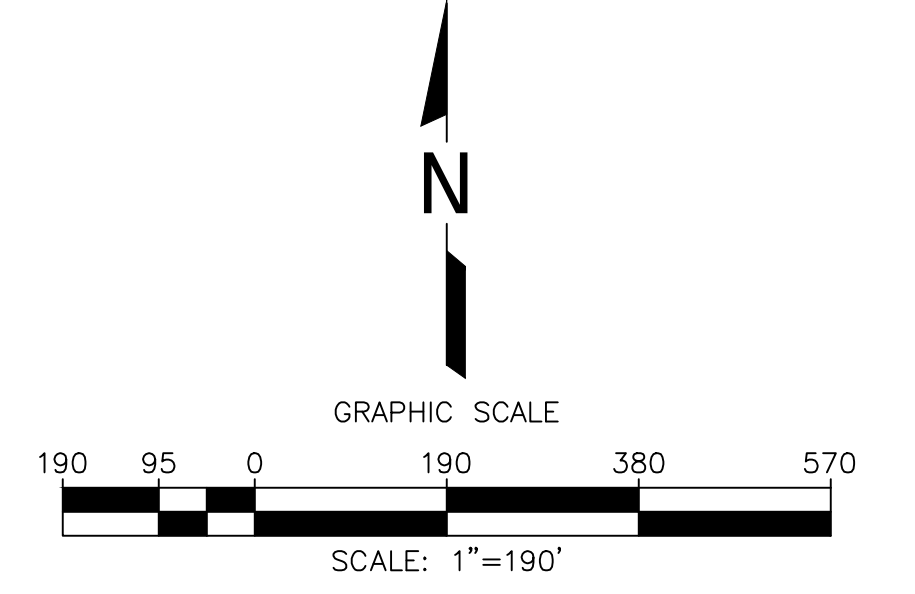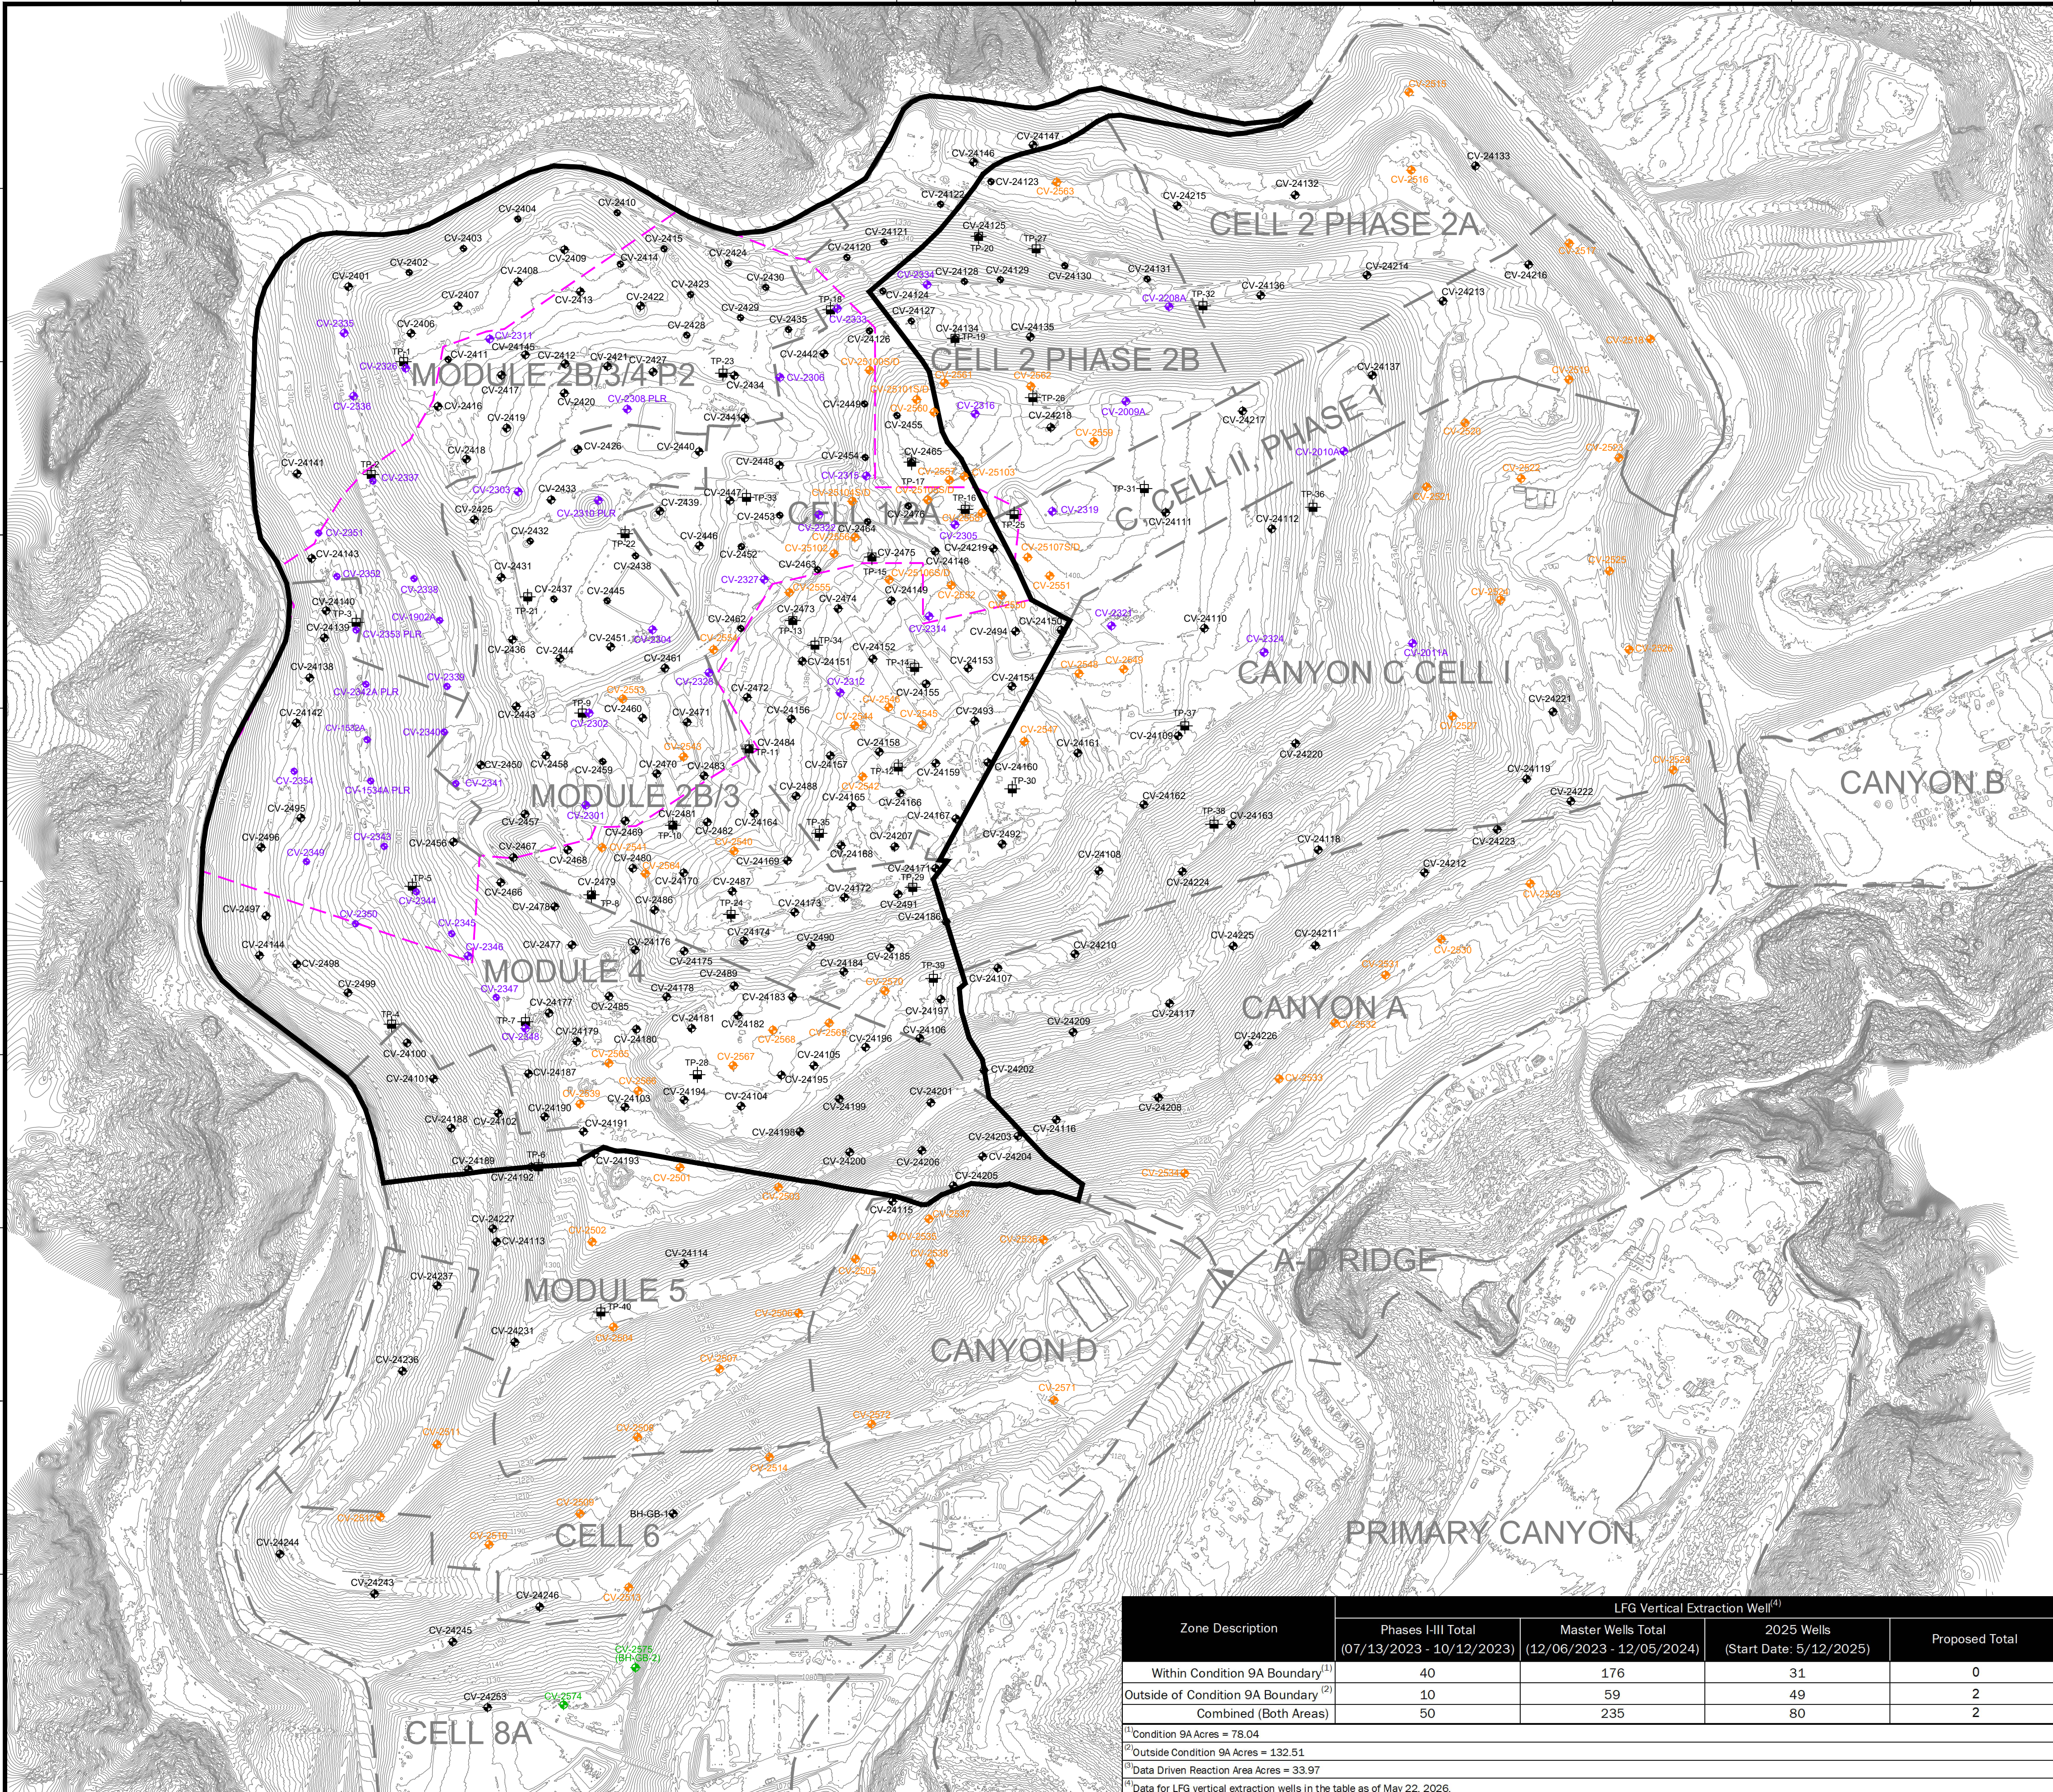

**LEGEND**

- EXISTING TOPOGRAPHIC CONTOUR
- EXISTING CELL LIMITS (APPROXIMATE)
- REACTION AREA BOUNDARY (APPROXIMATE) - BASED ON DATA REVIEW
- REACTION AREA BOUNDARY - CONDITION 9A
- EXISTING PHASES I-III LFG EXTRACTION WELL - INSTALLED
- EXISTING MASTER LFG EXTRACTION WELL - INSTALLED
- EXISTING 2025 LFG EXTRACTION WELL - INSTALLED
- PROPOSED LFG EXTRACTION WELL
- EXISTING TEMPERATURE PROBE - INSTALLED

DATE	
REVISION	
NO.	
SHEET TITLE:	WELL/TEMPERATURE PROBE INSTALLATION MAP
PROJECT TITLE:	2025 GCCS EXPANSION WELL & TEMPERATURE PROBE MASTER PLAN CHIQUITA CANYON LANDFILL CASTAIC, CALIFORNIA
CLIENT:	 CHIQUITA CANYON LANDFILL CASTAIC, CALIFORNIA
DATE:	05/22/2026
SCALE:	AS SHOWN
SHEET:	1

Zone Description	LFG Vertical Extraction Well <sup>(4)</sup>			
	Phases I-III Total (07/13/2023 - 10/12/2023)	Master Wells Total (12/06/2023 - 12/05/2024)	2025 Wells (Start Date: 5/12/2025)	Proposed Total
Within Condition 9A Boundary <sup>(1)</sup>	40	176	31	0
Outside of Condition 9A Boundary <sup>(2)</sup>	10	59	49	2
Combined (Both Areas)	50	235	80	2

<sup>(1)</sup> Condition 9A Acres = 78.04  
<sup>(2)</sup> Outside Condition 9A Acres = 132.51  
<sup>(3)</sup> Data Driven Reaction Area Acres = 33.97  
<sup>(4)</sup> Data for LFG vertical extraction wells in the table as of May 22, 2026.

**GENERAL DRAWING NOTES:**

- EXISTING TOPOGRAPHIC SURVEY INFORMATION SHOWN WAS PROVIDED BY PROPELLER. AERIAL PHOTOGRAPHY DATED MAY 06, 2026.
- NORTH ARROW SHOWN HERE IS REFERENCE TO THE CALIFORNIA STATE PLANE ZONE V COORDINATE SYSTEM, NAD 83.