

---

**From:** Medina, Steven <SMedina@scsengineers.com>  
**Sent:** Friday, May 29, 2026 5:47 PM  
**To:** Baitong Chen; Christina Ojeda; Nathaniel Dickel  
**Cc:** Han, Jessie; Chris Fear; Viswanathan, Srividhya; Mark.Adams; Dylan Smith; Sarah Phillips; Huber, Rachelle; Bill Haley  
**Subject:** Case No. 6177-4 Stipulated Order for Abatement - Weekly Pump Installation and Operation Update  
**Attachments:** 2026 CCLF Existing De-Watering Well with Pump Map\_2026-05-29.pdf

[EXTERNAL SENDER: Use caution with links/attachments]

---

Hello All,

In accordance with Condition 65 of the Modified Stipulated Order, below is the summary of the installation and operation of dewatering pumps for the Chiquita Canyon Landfill. This information is subject to change based on further review and verification.

During 05/22/2026 to 05/28/2026, Chiquita completed the installation of, and began operating during the day, four (4) new pumps in a vertical LFG extraction well for a total of one hundred eleven (111) pumps operating in vertical LFG extraction wells. Additionally, three (3) pumps were taken offline last week, and four (4) new pumps became operational, leading to a net increase of one (1) pump. The number of pumps offline is higher than usual due in large part to reduced off-site leachate disposal capacity and the ongoing EVOH/HDPE geomembrane cover deployment. Please note that Chiquita has additional pumps in operation in perimeter sumps that are not included in this count.

During 05/29/2026 to 06/04/2026, given the number of dewatering pumps installed to date, and the maintenance associated with those pumps, Chiquita plans to install and begin operating zero (0) additional pumps in vertical LFG extraction wells in locations along the north and south slope of the reaction area. Pump installation will resume once the existing pumps are turned back on, subject to disposal outlet capacity.

**STEVEN** Ruben Medina, **E.I.T.**  
Project Professional  
**SCS Engineers**  
3900 Kilroy Airport Way, Suite 300  
Long Beach, CA 90806  
858-204-4342 (c)  
[SMedina@scsengineers.com](mailto:SMedina@scsengineers.com)


**Driven by Client Success**  
[www.scsengineers.com](http://www.scsengineers.com)




**GENERAL DRAWING NOTES:**

- EXISTING TOPOGRAPHIC SURVEY INFORMATION SHOWN WAS PROVIDED BY PROPELLOR. AERIAL PHOTOGRAPHY DATED MAY 06, 2026.
- NORTH ARROW SHOWN HERE IS REFERENCE TO THE CALIFORNIA STATE PLANE ZONE V COORDINATE SYSTEM, NAD 83.
- THE LOCATION OF ANY EXISTING GCCS COMPONENTS AND OTHER FEATURES ARE APPROXIMATE AND SHOULD BE USED FOR INFORMATION PURPOSES ONLY.

A  
B  
C  
D  
E  
F  
G  
H  
I  
J

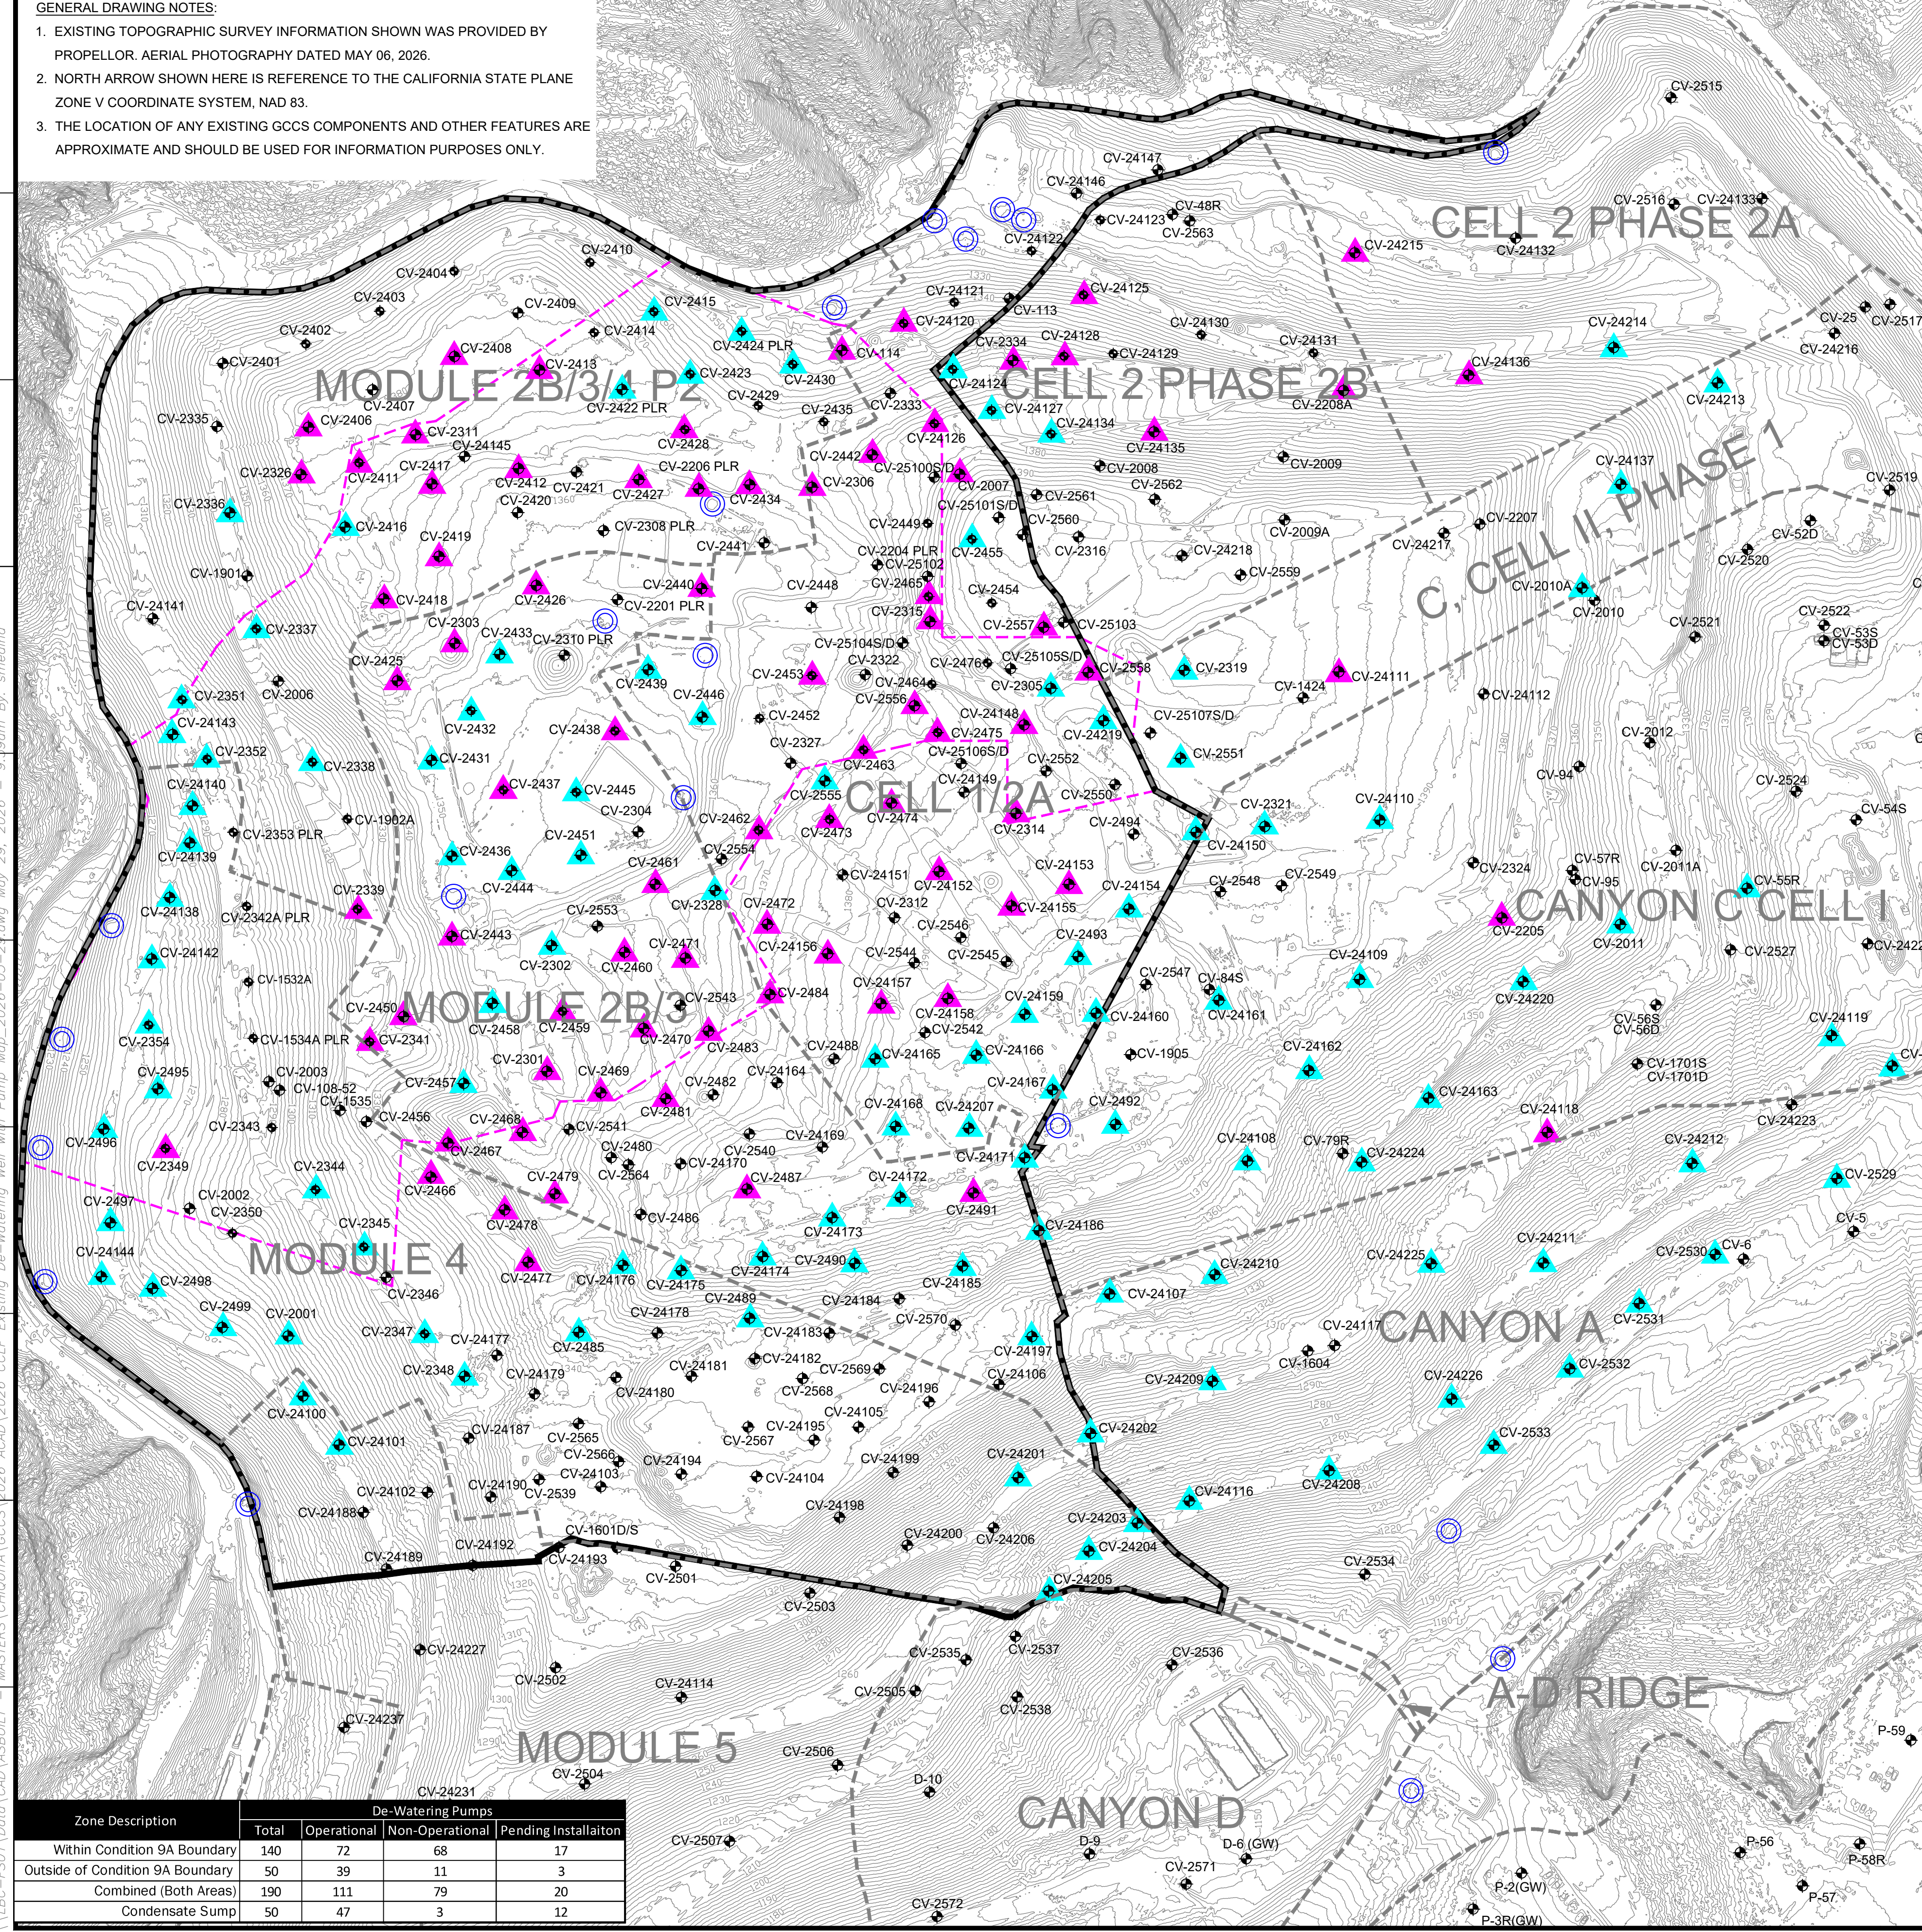

De-Watering Well Pumps that are Currently Running		
#	Well ID	Operational Startup Date
1	CV-2337	4/22/2024
2	CV-2302	4/26/2024
3	CV-2328	4/26/2024
4	CV-2336	4/30/2024
5	CV-24142	5/3/2024
6	CV-24144	5/13/2024
7	CV-2496	5/30/2024
8	CV-2497	5/30/2024
9	CV-2416	6/24/2024
10	CV-24109	7/3/2024
11	CV-24162	7/7/2024
12	CV-24101	7/8/2024
13	CV-24100	7/17/2024
14	CV-2498	7/18/2024
15	CV-2348	7/22/2024
16	CV-2347	7/24/2024
17	CV-2345	7/27/2024
18	CV-2344	7/30/2024
19	CV-24124	8/24/2024
20	CV-2423	8/26/2024
21	CV-24108	9/4/2024
22	CV-24210	9/10/2024
23	CV-2451	12/23/2024
24	CV-2445	1/6/2025
25	CV-2432	1/7/2025
26	CV-24212	1/10/2025
27	CV-2001	1/23/2025
28	CV-2338	2/8/2025
29	CV-24202	2/20/2025
30	CV-24209	2/28/2025
31	CV-24197	3/11/2025
32	CV-24166	4/7/2025
33	CV-24168	4/7/2025
34	CV-24171	4/7/2025
35	CV-24165	4/7/2025
36	CV-24134	4/9/2025
37	CV-24173	4/15/2025
38	CV-24174	4/15/2025
39	CV-24175	4/15/2025
40	CV-24159	4/16/2025
41	CV-24154	4/17/2025
42	CV-24214	5/2/2025
43	CV-2354	5/6/2025
44	CV-2493	5/6/2025
45	CV-24160	5/6/2025
46	CV-2492	5/7/2025
47	CV-24161	5/8/2025
48	CV-24224	5/12/2025
49	CV-24119	5/14/2025
50	CV-24107	5/15/2025
51	CV-24211	5/15/2025
52	CV-24137	5/15/2025
53	CV-24208	5/16/2025
54	CV-24116	5/20/2025
55	CV-24204	5/20/2025
56	CV-24205	5/20/2025
57	CV-2490	6/5/2025
58	CV-24203	6/5/2025
59	CV-24225	6/9/2025
60	CV-24207	6/9/2025
61	CV-24186	6/10/2025
62	CV-24222	6/10/2025
63	CV-24163	6/11/2025
64	CV-2439	6/12/2025
65	CV-24143	6/12/2025
66	CV-24139	6/12/2025
67	CV-24140	6/14/2025
68	CV-24220	6/16/2025
69	CV-2436	6/23/2025
70	CV-2444	6/23/2025
71	CV-55R	6/23/2025
72	CV-24213	7/9/2025
73	CV-24150	7/9/2025
74	CV-2319	7/9/2025
75	CV-24219	7/9/2025
76	CV-24110	7/17/2025
77	CV-2485	8/7/2025
78	CV-2489	9/4/2025
79	CV-2431	9/18/2025
80	CV-2530	10/3/2025
81	CV-2533	10/3/2025
82	CV-2532	10/17/2025
83	CV-2529	10/18/2025
84	CV-2010A	11/24/2025
85	CV-2011A	11/24/2025
86	CV-2551	12/30/2025
87	CV-2351	1/23/2026
88	CV-24138	1/23/2026
89	CV-2352	1/26/2026
90	CV-2499	1/27/2026
91	CV-2455	2/28/2026
92	CV-2495	2/28/2026
93	CV-24167	3/4/2026
94	CV-24185	3/19/2026
95	CV-24201	3/26/2026
96	CV-2430	3/31/2026
97	CV-2555	4/1/2026
98	CV-24226	4/2/2026
99	CV-24176	4/3/2026
100	CV-2422	4/6/2026
101	CV-2321	4/10/2026
102	CV-2433	4/11/2026
103	CV-2446	4/11/2026
104	CV-2457	4/11/2026
105	CV-2458	4/11/2026
106	CV-2424	4/13/2026
107	CV-2305	4/15/2026
108	CV-24172	4/16/2026
109	CV-2415	4/22/2026
110	CV-2531	4/29/2026
111	CV-24127	5/21/2026

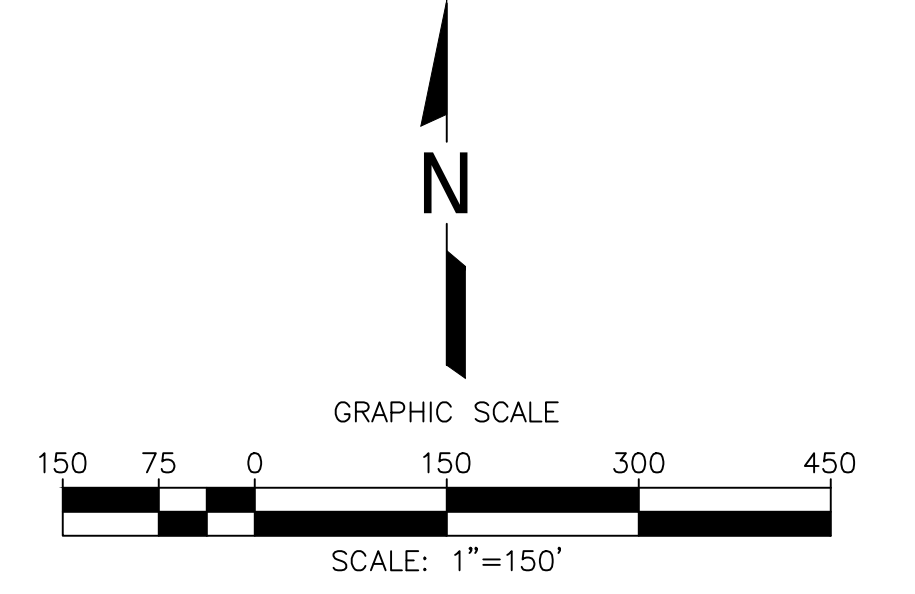

- LEGEND**
- 1150 TOPOGRAPHIC CONTOUR
  - EXISTING CELL LIMITS (APPROXIMATE)
  - REACTION AREA BOUNDARY - CONDITION 9A
  - REACTION AREA BOUNDARY - DATA ANALYSIS
  - ⊕ CV-XX EXISTING VERTICAL LFG EXTRACTION WELL
  - ⊕ CV-XX PLR EXISTING LFG VERTICAL EXTRACTION WELL - PRESSURIZED LEACHATE RELEASE
  - ⊙ EXISTING CONDENSATE SUMP WITH PUMP
  - ▲ EXISTING DE-WATERING WELL WITH PUMP - CURRENTLY RUNNING
  - ▲ EXISTING DE-WATERING WELL WITH PUMP - INSTALLED

De-Watering Well Pumps That Are Currently Installed and Not in Operation	
#	Well ID
1	CV-114
2	CV-2007
3	CV-2205 PLR
4	CV-2208A
5	CV-2301
6	CV-2303
7	CV-2306
8	CV-2311
9	CV-2314
10	CV-2315
11	CV-2326
12	CV-2334
13	CV-2339
14	CV-2341
15	CV-2349
16	CV-2406
17	CV-2408
18	CV-2411
19	CV-2412
20	CV-2415
21	CV-2417
22	CV-2419
23	CV-2418
24	CV-2425
25	CV-2426
26	CV-2427
27	CV-2428
28	CV-2434
29	CV-2437
30	CV-2438
31	CV-2440
32	CV-2442
33	CV-2443
34	CV-2450
35	CV-2453
36	CV-2459
37	CV-2460
38	CV-2461

Zone Description	De-Watering Pumps			
	Total	Operational	Non-Operational	Pending Installation
Within Condition 9A Boundary	140	72	68	17
Outside of Condition 9A Boundary	50	39	11	3
Combined (Both Areas)	190	111	79	20
Condensate Sump	50	47	3	12

CLIENT: CHIQUITA CANYON LANDFILL CASTAIC, CALIFORNIA

PROJECT TITLE: CHIQUITA CANYON LANDFILL CASTAIC, CALIFORNIA

DATE: 05/29/2026

SCALE: AS SHOWN

SHEET: 1