
De: Dylan Smith <Dylan.Smith@WasteConnections.com>
Enviado: Viernes 12 de junio de 2026 5:47 PM
Para: Karen Gork
Cc: Todd.Thalhamer@Calrecycle.ca.gov; LFrias@ph.lacounty.gov; NQuick@ph.lacounty.gov; RRagland@ph.lacounty.gov; BMcphillips@counsel.lacounty.gov; Wes.Mindermann@CalRecycle.ca.gov; mark.debie@calrecycle.ca.gov; mark.debie@calrecycle.ca.gov; emorofuji@ph.lacounty.gov; btway@ph.lacounty.gov; Relon.MarkAnthony@epa.gov; Holybee.Tyler@epa.gov; Friedli.Laura@epa.gov; John Perkey; Sarah Phillips; Gregory.Shaffer@dtsc.ca.gov; Natasha.DiPietro@dtsc.ca.gov; Gregory.Gentile@dtsc.ca.gov; WILLIAM.HALEY@WasteConnections.com
Asunto: Vertedero de Chiquita Canyon - Cubierta Geosintética - Medida de Mitigación 4.1
Adjuntos: RM22.1077-CCL-EVOH-FIG 1-(2026-06-12)-UPDATE 2.pdf; 2026 CCLF Reaction Area_Reactive Wells_2026-06-12.pdf; Milestone 2B Chiquita Canyon LF Isopach_May.2026.pdf


A continuación se encuentra la actualización de Chiquita de la semana sobre el estado de la instalación de la cubierta de EVOH/HDPE geomembrana de 60-mil en el Vertedero de Chiquita Canyon, conforme a la Medida de Mitigación 4.1 de la Orden de Cumplimiento de la LEA emitida el 1 de mayo de 2025.

Al 5 de junio de 2026, D&E, en nombre de Chiquita, ha instalado aproximadamente 2.196.637 pies cuadrados de cubierta de geomembrana de EVOH/HDPE de 60 milésimas de pulgada. De este total, se desplegaron aproximadamente 622.707 pies cuadrados sobre la geomembrana existente de 30 milésimas de pulgadas para aumentar su efectividad. La obra realizada la semana del 5 de junio también incluyó reparaciones y detalles en los paneles existentes, que incluyen la fabricación de bases, emparchado, soldadura por extrusión y volver a coser, según la necesidad. El trabajo continuó durante la semana del 8 de junio de 2026.

El mapa del sitio adjunto muestra la extensión aproximada de la cubierta de geomembrana instalada al miércoles 10 de junio de 2026, como también la cubierta de geomembrana descrita en el anteproyecto del plan de trabajo revisado para la extensión del área de la cubierta de geomembrana presentado a la LEA, a la US EPA y al DTSC el 13 de marzo de 2026. También se adjuntan a esta entrega el mapa isopáquico mensual de mayo de 2026 y una figura que identifica los pozos que muestran indicios de reacción al 1 de junio de 2026. Debido a limitaciones técnicas, actualmente no podemos crear una figura que incluya todos estos datos.

Gracias,

Dylan Smith

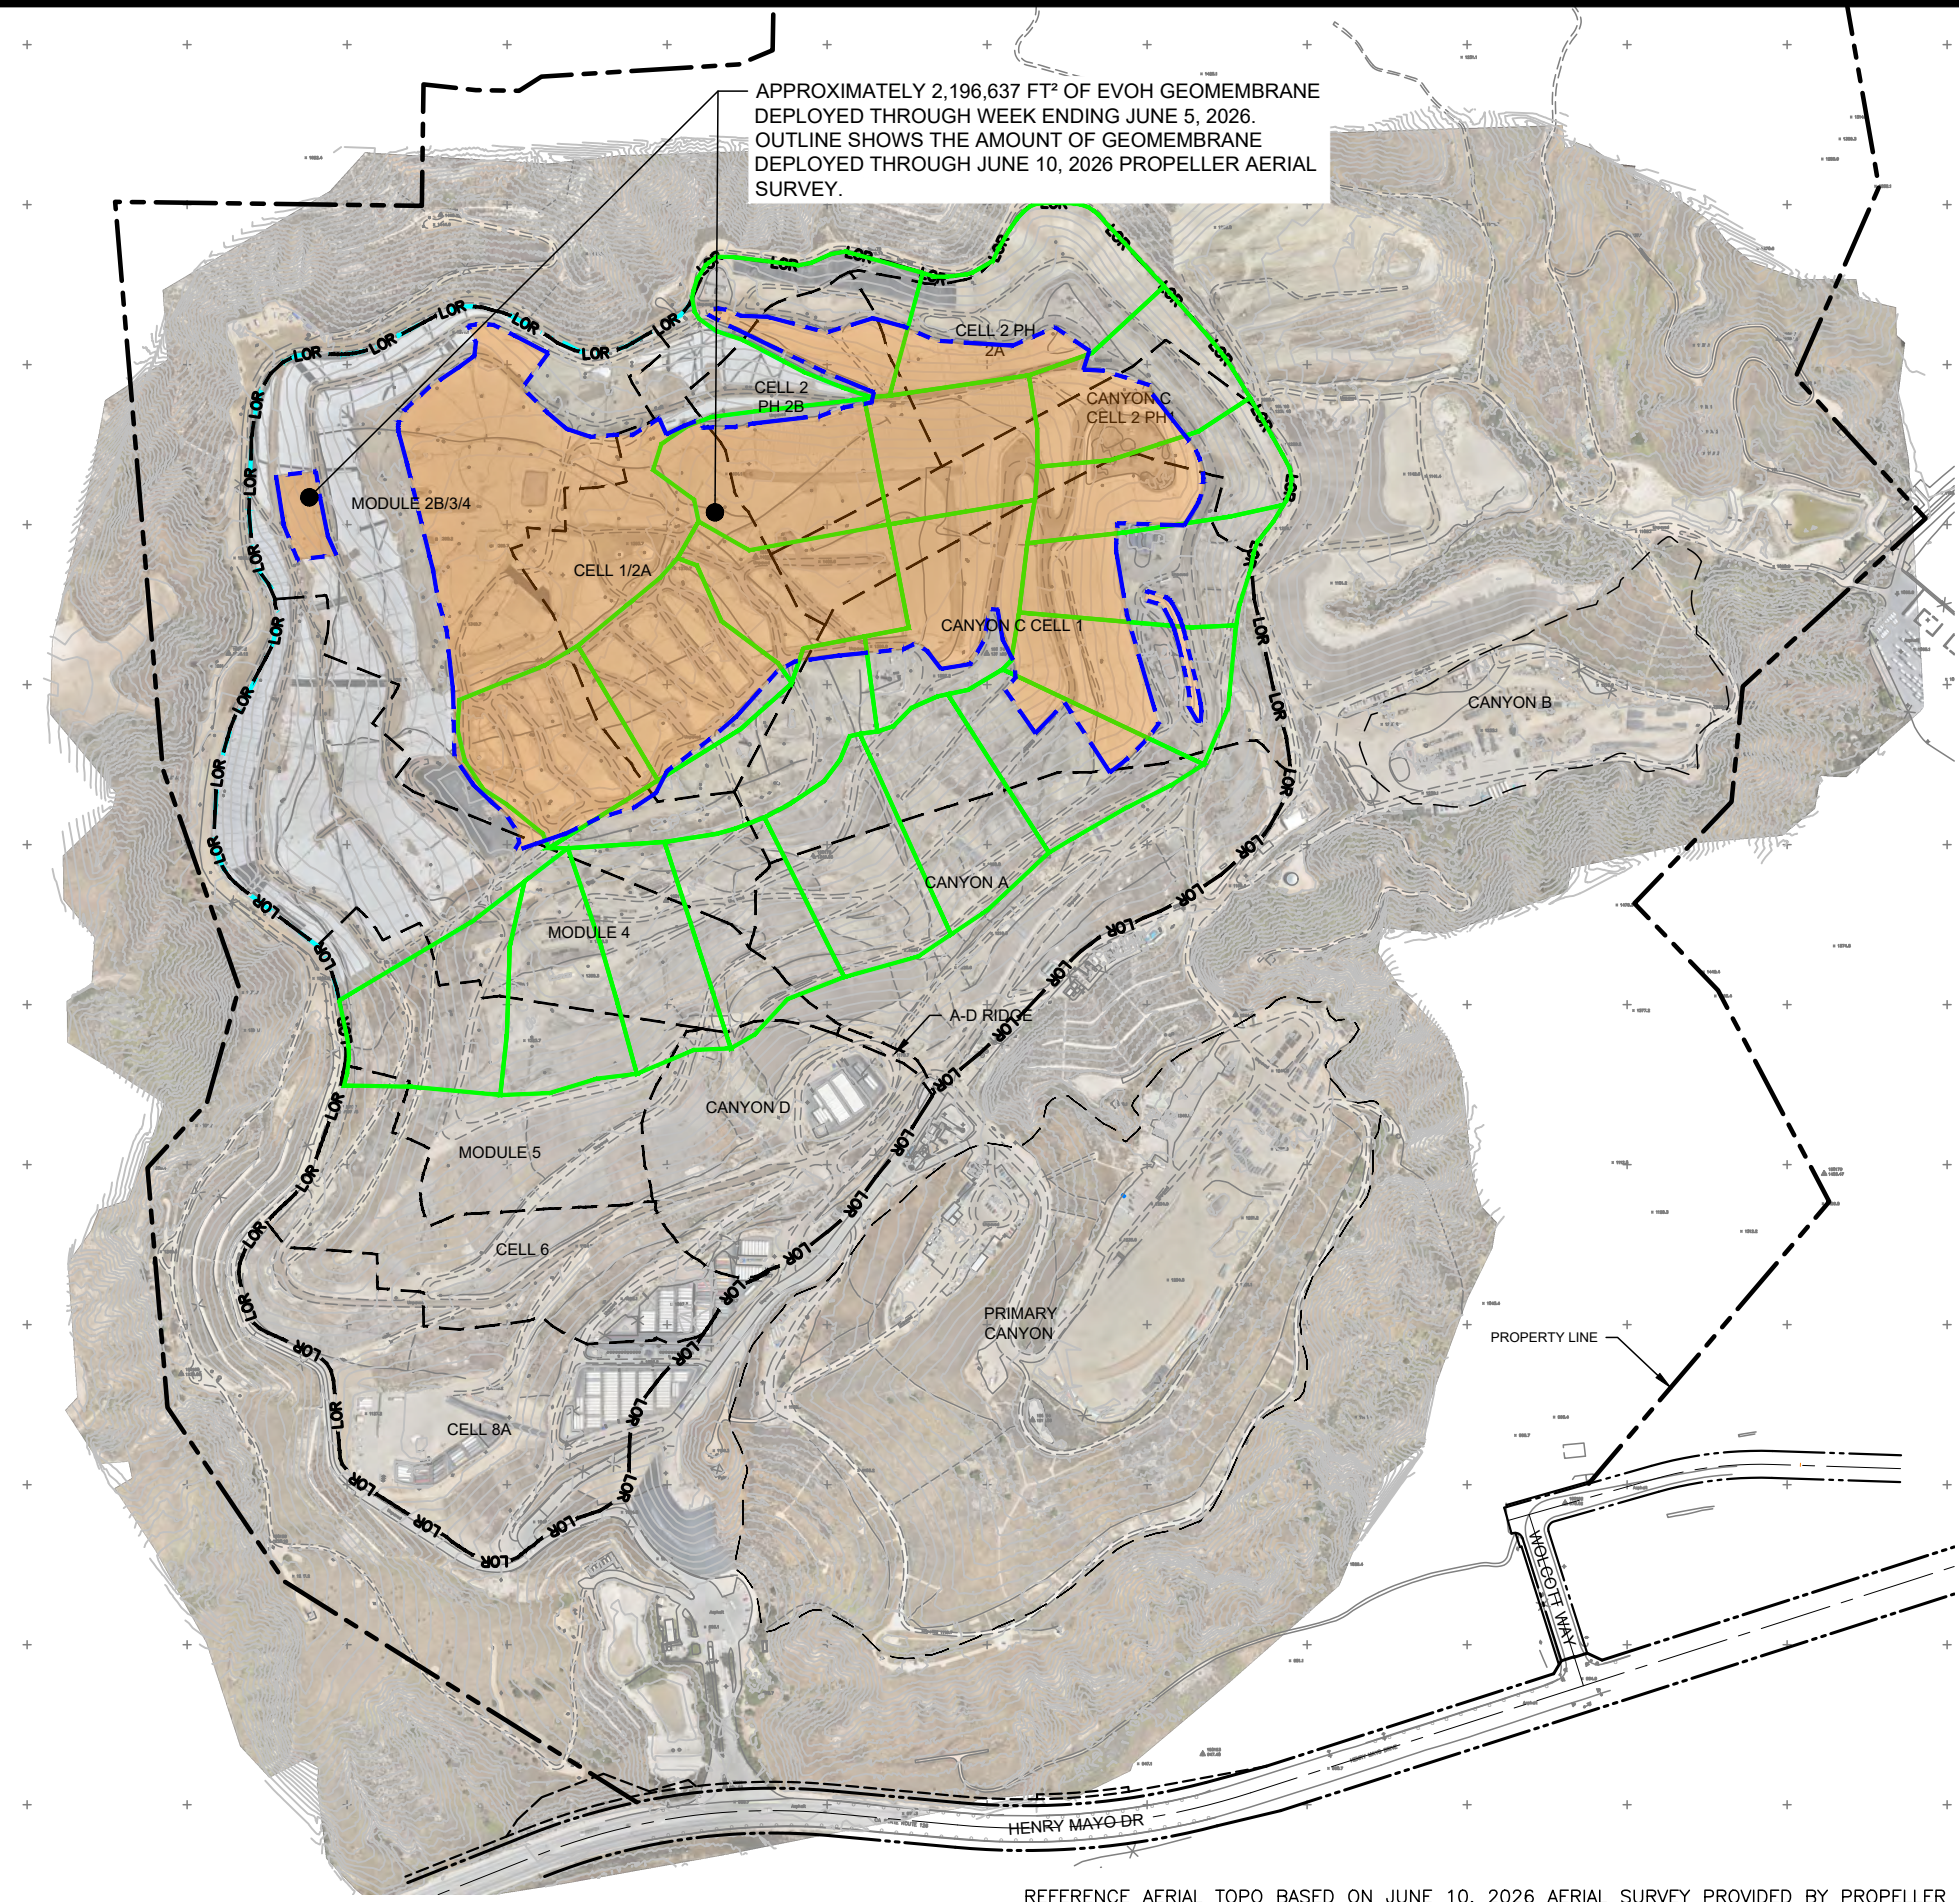

APPROXIMATELY 2,196,637 FT² OF EVOH GEOMEMBRANE DEPLOYED THROUGH WEEK ENDING JUNE 5, 2026. OUTLINE SHOWS THE AMOUNT OF GEOMEMBRANE DEPLOYED THROUGH JUNE 10, 2026 PROPELLER AERIAL SURVEY.

LEGEND:

- PROPERTY LINE
- APPROXIMATE LIMIT OF REFUSE
- CELL LIMIT
- EXISTING GEOMEMBRANE DEPLOYMENT AREA
- INITIAL SUPPLEMENTAL GEOMEMBRANE DEPLOYMENT AREA
- SUBSEQUENT SUPPLEMENTAL GEOMEMBRANE AREA

NOTE:

1. EXISTING GEOMEMBRANE DEPLOYMENT AREA IS APPROXIMATELY 48.3 ACRES.
2. EXISTING GEOMEMBRANE IS 30-MIL HDPE, EXCEPT FOR 1.3 ACRES OF 40-MIL HDPE.
3. EACH PROPOSED DEPLOYMENT AREA IS APPROXIMATELY 5 ACRES.
4. NEW GEOMEMBRANE WILL BE 60-MIL HDPE WITH AN INTERNAL CORE EVOH RESIN BARRIER.



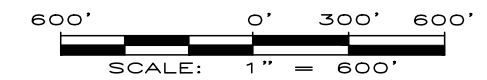


FIGURE 1
APPROXIMATE LIMITS OF DEPLOYED EVOH GEOMEMBRANE
CHIQUITA CANYON LANDFILL
CASTAIC, CA

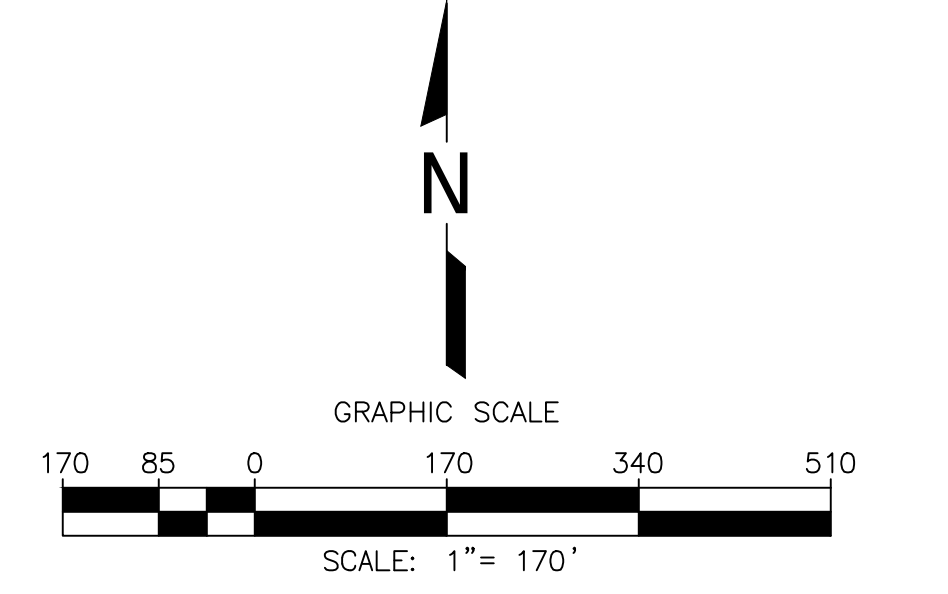

REFERENCE AERIAL TOPO BASED ON JUNE 10, 2026 AERIAL SURVEY PROVIDED BY PROPELLER

DRAWN BY: LP/RM | DATE: JUNE 2026 | JOB NO.: RM22.1077

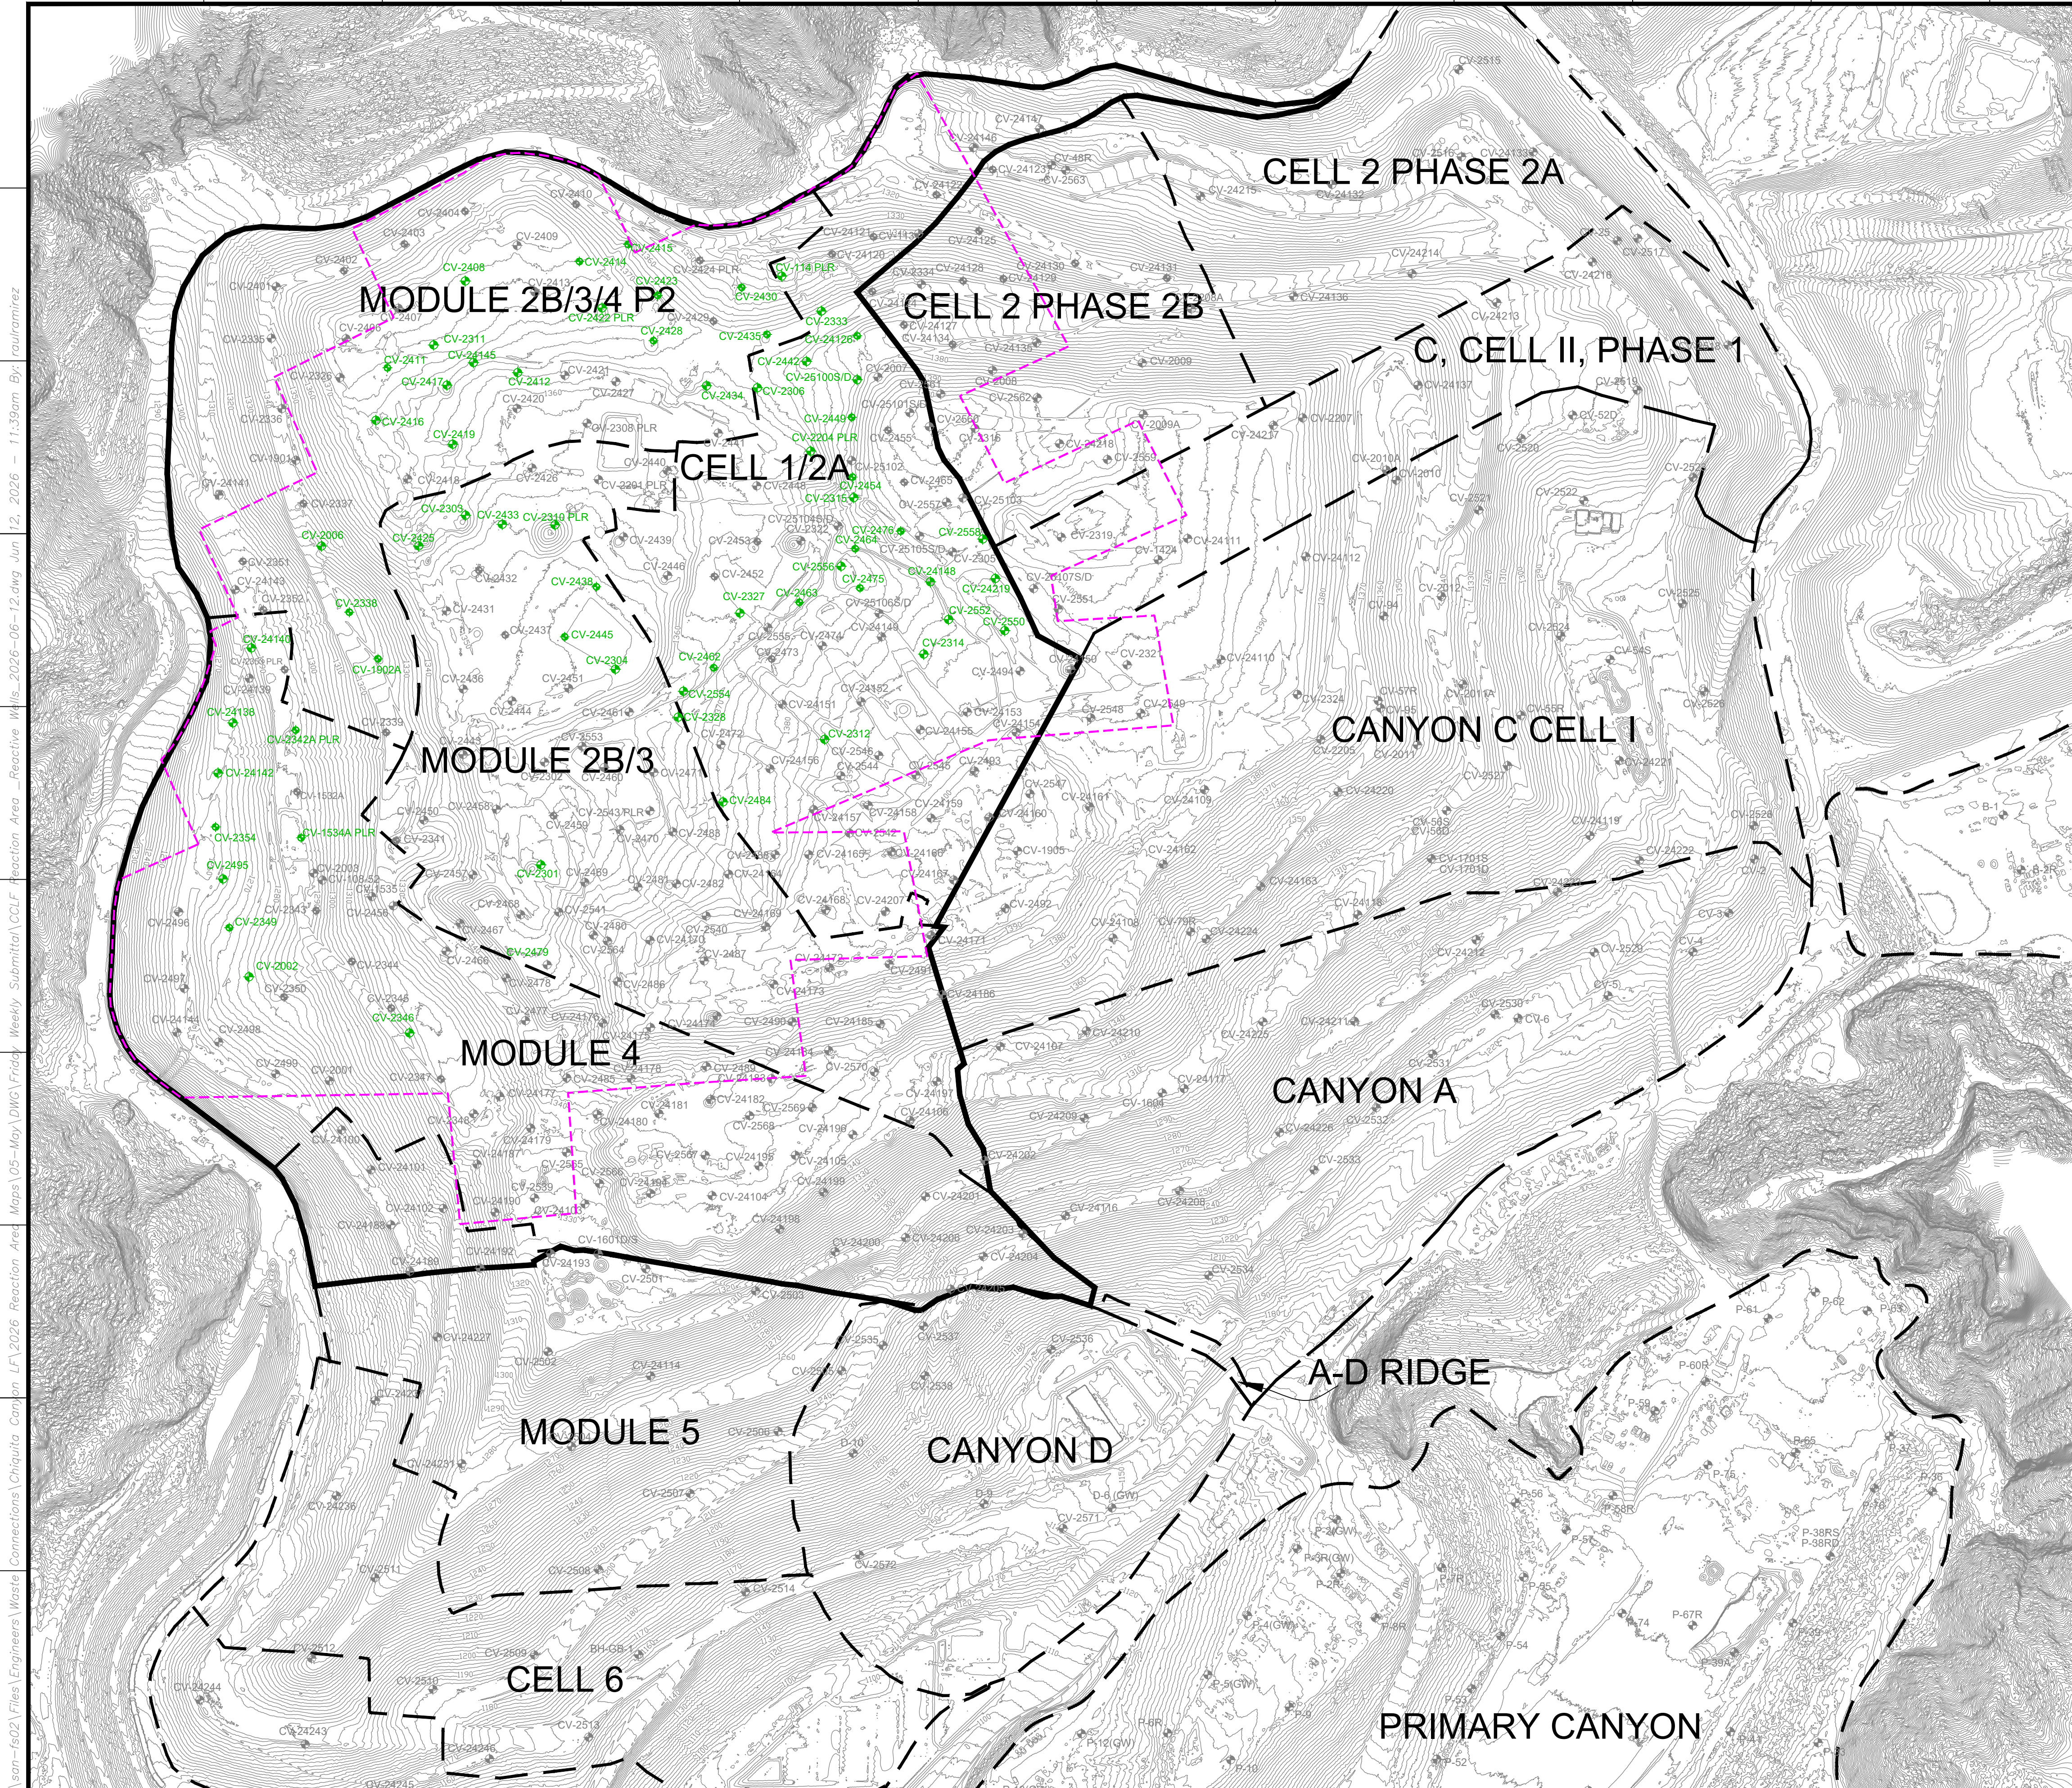

LEGEND

1150	EXISTING TOPOGRAPHIC CONTOUR
- - - -	EXISTING CELL LIMITS (APPROXIMATE)
⊕ CV-XX	EXISTING VERTICAL WELLS
⊕ CV-XX PLR	EXISTING VERTICAL WELL - PRESSURIZED LEACHATE RELEASE
⊕ CV-XX	EXISTING VERTICAL WELLS - REACTIVE
- - - -	REACTION AREA BOUNDARY (APPROXIMATE)
- - - -	REACTION AREA BOUNDARY - CONDITION 9A

NO.	REVISION	DATE

SHEET TITLE: REACTIVE VERTICAL EXTRACTION WELLS
 PROJECT TITLE: CHIQUITA CANYON LANDFILL
 CASTAIC, CALIFORNIA



SCS ENGINEERS
 ENVIRONMENTAL CONSULTANTS
 3840 ALBOY AVE. SUITE 300
 LONG BEACH, CA 90808
 PH: (562) 428-9544


PROJ. NO: 01204123-45
 DSN. BY: RR
 APP. BY: F/ENGINEERS
 CHK. BY: RR

DATE: 06/12/2026
 SCALE: AS SHOWN
 SHEET: 1

GENERAL DRAWING NOTES:
 1. EXISTING TOPOGRAPHIC SURVEY INFORMATION SHOWN WAS PROVIDED BY PROPELLER. AERIAL PHOTOGRAPHY DATED JUNE 02, 2026.
 2. NORTH ARROW SHOWN HERE IS REFERENCE TO THE CALIFORNIA STATE PLANE ZONE V COORDINATE SYSTEM, NAD 83.

\\san-t021\files\Engineers\Waste Connections\Chiquita Canyon LF\2026 Reaction Area Maps\05-May-DWG\Friday Weekly Submittal\CCF Reaction Area - Reactive WELLS 2026-06-12.dwg Jun 12, 2026 - 11:39am By:raulramirez

Chiquita Canyon Landfill -Isopach

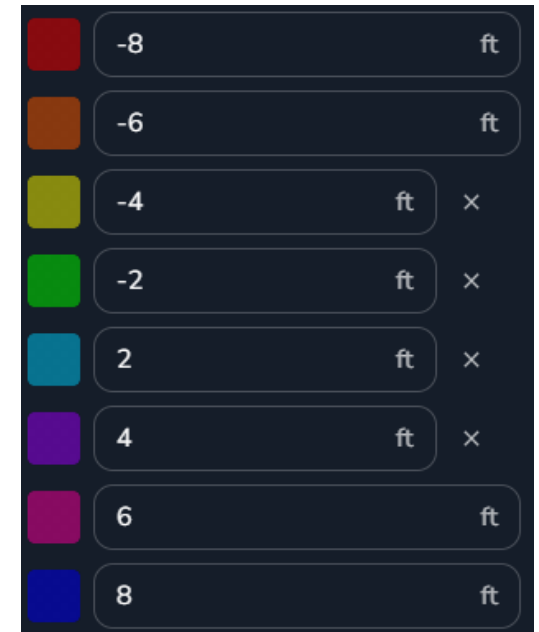

May 27, 2026 Survey Image. May 6, 2026 vs May 27, 2026