

From: Medina, Steven <SMedina@scsengineers.com>
Sent: Thursday, July 2, 2026 3:59 PM
To: Baitong Chen; Christina Ojeda; Nathaniel Dickel
Cc: Chris Fear; Viswanathan, Srividhya; Mark.Adams; Dylan Smith; Sarah Phillips; Huber, Rachelle; Bill Haley
Subject: Case No. 6177-4 Stipulated Order for Abatement - Weekly Pump Installation and Operation Update
Attachments: 2026-07-02_CCLF_Existing De-Watering Well with Pump Map_V1.0.pdf

[EXTERNAL SENDER: Use caution with links/attachments]

All,

In accordance with Condition 65 of the Modified Stipulated Order, below is the summary of the installation and operation of dewatering pumps for the Chiquita Canyon Landfill. This information is subject to change based on further review and verification. This notification has been provided one day in advance in observance of the upcoming holiday.

During 06/26/2026 to 07/01/2026, Chiquita completed the installation of, and began operating during the day, nine (9) new pumps in a vertical LFG extraction well for a total of one hundred sixty-three (163) pumps operating in vertical LFG extraction wells. No pumps were taken offline last week. Please note that Chiquita has additional pumps in operation in perimeter sumps that are not included in this count.

During 07/02/2026 to 07/09/2026, given the number of dewatering pumps installed to date, and the maintenance associated with those pumps, Chiquita plans to install and begin operating zero (0) additional pumps in vertical LFG extraction wells in locations along the north and south slope of the reaction area. Pump installation will resume once the existing pumps are turned back on, subject to disposal outlet capacity.

Regards,

STEVEN Ruben Medina, **E.I.T.**
Project Professional
SCS Engineers
3900 Kilroy Airport Way, Suite 300
Long Beach, CA 90806
858-204-4342 (c)
SMedina@scsengineers.com

Driven by Client Success
www.scsengineers.com




GENERAL DRAWING NOTES:

1. EXISTING TOPOGRAPHIC SURVEY INFORMATION SHOWN WAS PROVIDED BY PROPELLOR. AERIAL PHOTOGRAPHY DATED JUNE 02, 2026.

2. NORTH ARROW SHOWN HERE IS REFERENCE TO THE CALIFORNIA STATE PLANE ZONE V COORDINATE SYSTEM, NAD 83.

3. THE LOCATION OF ANY EXISTING GCCS COMPONENTS AND OTHER FEATURES ARE APPROXIMATE AND SHOULD BE USED FOR INFORMATION PURPOSES ONLY.

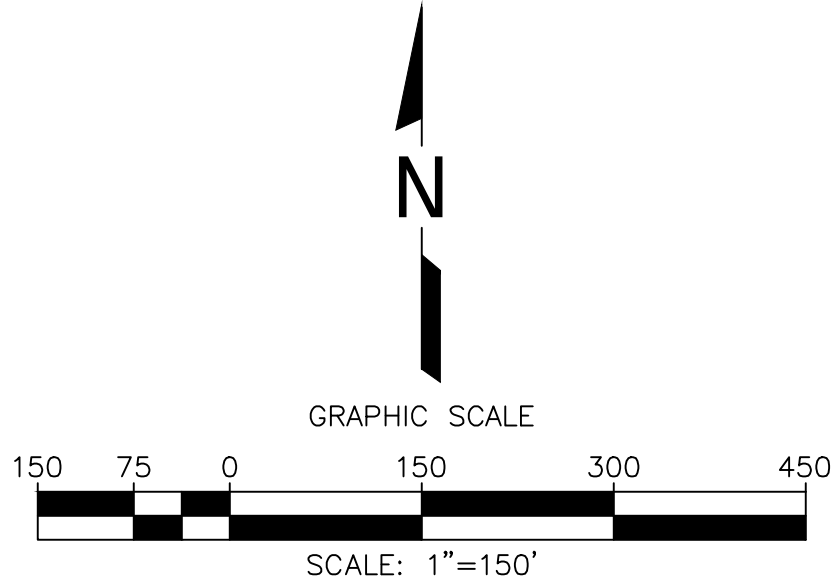

- LEGEND
- 1150 TOPOGRAPHIC CONTOUR
 - EXISTING CELL LIMITS (APPROXIMATE)
 - REACTION AREA BOUNDARY - CONDITION 9A
 - REACTION AREA BOUNDARY - DATA ANALYSIS
 - CV-XX EXISTING VERTICAL LFG EXTRACTION WELL
 - CV-XX PLR EXISTING LFG VERTICAL EXTRACTION WELL - PRESSURIZED LEACHATE RELEASE
 - EXISTING CONDENSATE SUMP WITH PUMP
 - EXISTING DE-WATERING WELL WITH PUMP - CURRENTLY RUNNING
 - EXISTING DE-WATERING WELL WITH PUMP - INSTALLED

De-Watering Well Pumps Currently Running		
#	Well I.D.	Operational/Install Date
1	CV-2314	4/22/2024
2	CV-2337	4/22/2024
3	CV-2302	4/26/2024
4	CV-2328	4/28/2024
5	CV-2336	4/30/2024
6	CV-24142	5/3/2024
7	CV-24144	5/13/2024
8	CV-2405	5/30/2024
9	CV-2497	5/30/2024
10	CV-2416	6/24/2024
11	CV-24162	7/7/2024
12	CV-24101	7/8/2024
13	CV-24100	7/17/2024
14	CV-2348	7/22/2024
15	CV-2347	7/24/2024
16	CV-2345	7/27/2024
17	CV-2344	7/30/2024
18	CV-2417	8/13/2024
19	CV-2418	8/14/2024
20	CV-2341	8/15/2024
21	CV-24124	8/24/2024
22	CV-2493	8/26/2024
23	CV-2409	8/30/2024
24	CV-2437	11/26/2024
25	CV-2451	12/23/2024
26	CV-2470	12/24/2024
27	CV-2432	1/7/2025
28	CV-24212	1/10/2025
29	CV-2462	1/14/2025
30	CV-2463	1/15/2025
31	CV-2001	1/23/2025
32	CV-2483	1/26/2025
33	CV-2338	2/8/2025
34	CV-24202	2/20/2025
35	CV-24161	3/11/2025
36	CV-24165	4/7/2025
37	CV-24166	4/7/2025
38	CV-24168	4/7/2025
39	CV-24171	4/7/2025
40	CV-24134	4/9/2025
41	CV-24173	4/15/2025
42	CV-24174	4/15/2025
43	CV-24175	4/15/2025
44	CV-24159	4/16/2025
45	CV-24154	4/17/2025
46	CV-24158	5/2/2025
47	CV-24124	5/2/2025
48	CV-2354	5/6/2025
49	CV-2463	5/6/2025
50	CV-24160	5/6/2025
51	CV-2492	5/7/2025
52	CV-24161	5/8/2025
53	CV-24124	5/12/2025
54	CV-24119	5/14/2025
55	CV-24107	5/15/2025
56	CV-24121	5/15/2025
57	CV-24137	5/15/2025
58	CV-24208	5/16/2025
59	CV-24116	5/20/2025
60	CV-24204	5/20/2025
61	CV-24205	5/20/2025
62	CV-2460	6/5/2025
63	CV-24203	6/5/2025
64	CV-24207	6/9/2025
65	CV-24225	6/9/2025
66	CV-24186	6/10/2025
67	CV-24222	6/10/2025
68	CV-24163	6/11/2025
69	CV-2439	6/12/2025
70	CV-24175	6/12/2025
71	CV-24139	6/12/2025
72	CV-24143	6/12/2025
73	CV-24140	6/14/2025
74	CV-24220	6/15/2025
75	CV-2436	6/23/2025
76	CV-2444	6/23/2025
77	CV-24203	6/23/2025
78	CV-24213	7/9/2025
79	CV-24150	7/9/2025
80	CV-2318	7/9/2025
81	CV-24219	7/9/2025
82	CV-24110	7/17/2025
83	CV-2485	8/7/2025
84	CV-2489	9/4/2025
85	CV-2431	9/18/2025
86	CV-2425	9/22/2025
87	CV-2530	10/3/2025
88	CV-2533	10/11/2025
89	CV-2529	10/18/2025
90	CV-2010A	11/24/2025
91	CV-2011A	11/24/2025
92	CV-24156	12/17/2025
93	CV-2551	12/30/2025
94	CV-2561	1/23/2026
95	CV-24158	1/23/2026
96	CV-2352	1/26/2026
97	CV-2455	2/28/2026
98	CV-2465	3/26/2026
99	CV-24167	3/4/2026
100	CV-24185	3/19/2026
101	CV-2430	3/31/2026
102	CV-2555	4/1/2026
103	CV-24226	4/2/2026
104	CV-24176	4/3/2026
105	CV-24223	4/8/2026
106	CV-2321	4/10/2026
107	CV-2433	4/11/2026
108	CV-2445	4/11/2026
109	CV-2457	4/11/2026
110	CV-2458	4/11/2026
111	CV-2424	4/13/2026
112	CV-2426	4/15/2026
113	CV-24172	4/16/2026
114	CV-2415	4/22/2026
115	CV-2531	4/28/2026
116	CV-24127	5/21/2026
117	CV-24180	5/28/2026
118	CV-2443	6/1/2026
119	CV-2473	6/1/2026
120	CV-24157	6/1/2026
121	CV-24170	6/2/2026
122	CV-2459	6/2/2026
123	CV-2460	6/2/2026
124	CV-2461	6/2/2026
125	CV-2469	6/2/2026
126	CV-2471	6/3/2026
127	CV-2326	6/3/2026
128	CV-2473	6/3/2026
129	CV-2464	6/3/2026
130	CV-2491	6/3/2026
131	CV-24136	6/3/2026
132	CV-24159	6/3/2026
133	CV-24164	6/3/2026
134	CV-2303	6/5/2026
135	CV-24148	6/5/2026
136	CV-24152	6/5/2026
137	CV-24153	6/5/2026
138	CV-24155	6/5/2026
139	CV-24215	6/5/2026
140	CV-2467	6/5/2026
141	CV-2426	6/9/2026
142	CV-2434	6/9/2026
143	CV-2469	6/9/2026
144	CV-24120	6/9/2026
145	CV-24128	6/9/2026
146	CV-2333	6/10/2026
147	CV-2408	6/10/2026
148	CV-2477	6/10/2026
149	CV-24125	6/10/2026
150	CV-2334	6/11/2026
151	CV-2456	6/11/2026
152	CV-2343-PLR	6/15/2026
153	CV-2474	6/15/2026
154	CV-2316	6/17/2026
155	CV-2339	6/18/2026
156	CV-2482	6/18/2026
157	CV-2444	6/18/2026
158	CV-2546	6/18/2026
159	CV-2545	6/18/2026
160	CV-24177	6/22/2026
161	CV-2340	6/23/2026
162	CV-2548	6/25/2026
163	CV-24129	7/1/2026

Zone Description	De-Watering Pumps			
	Total	Operational	Not Running	Pending Installation
Within Condition 9A Boundary	155	122	33	17
Outside of Condition 9A Boundary	47	41	6	3
Combined (Both Areas)	202	163	39	20
Condensate Sump	52	50	2	12

De-Watering Well Pumps Currently Installed, but NOT in Operation	
#	Well I.D.
1	CV-114
2	CV-2007
3	CV-2206-PLR
4	CV-2301
5	CV-2306-PLR
6	CV-2311
7	CV-2315
8	CV-2349
9	CV-2408
10	CV-2411
11	CV-2412
12	CV-2413
13	CV-2427
14	CV-2428
15	CV-2438
16	CV-2440
17	CV-2442
18	CV-2445
19	CV-2450
20	CV-2453
21	CV-2465
22	CV-2466
23	CV-2478
24	CV-2479
25	CV-2481
26	CV-2487
27	CV-2553
28	CV-2556
29	CV-2557
30	CV-2558
31	CV-24108
32	CV-24109
33	CV-24111
34	CV-24118
35	CV-24135
36	CV-24178
37	CV-24201
38	CV-24209
39	CV-24210

DATE: 07/02/2026

SCALE: AS SHOWN

SHEET: 1

REVISION

NO.

SHEET TITLE: EXISTING DE-WATERING WELL WITH PUMP MAP

PROJECT TITLE: CHICUITA CANYON LANDFILL CASTAIC, CALIFORNIA

CLIENT:

SCS ENGINEERS ENVIRONMENTAL CONSULTANTS

LONG BEACH, CA 90806
PH: (562) 426-9544

ACAD FILE: N:\CADD\BUILT-MASTERS

DWN. BY: SRM / CW

APP. BY:

DSN. NO: 01204123.45

CHK. BY:

CHICUITA CANYON LANDFILL CASTAIC, CALIFORNIA

CHICUITA CANYON LANDFILL CASTAIC, CALIFORNIA