

**From:** Huber, Rachelle <RHuber@scsengineers.com>  
**Sent:** Friday, July 10, 2026 8:33 PM  
**To:** Medina, Steven; Baitong Chen; Christina Ojeda; Nathaniel Dickel  
**Cc:** Chris Fear; Viswanathan, Srividhya; Mark.Adams; Dylan Smith; Sarah Phillips; Bill Haley  
**Subject:** Case No. 6177-4 Stipulated Order for Abatement - Weekly Pump Installation and Operation Update  
**Attachments:** 2026-07-10\_CCLF\_Existing De-Watering Well with Pump Map\_v0.0 1.pdf

[EXTERNAL SENDER: Use caution with links/attachments]

---

All,

In accordance with Condition 65 of the Modified Stipulated Order, below is the summary of the installation and operation of dewatering pumps for the Chiquita Canyon Landfill. This information is subject to change based on further review and verification.

During 07/02/2026 to 07/09/2026, Chiquita completed the installation of, and began operating during the day, fourteen (14) new pumps in a vertical LFG extraction well for a total of one hundred seventy-seven (177) pumps operating in vertical LFG extraction wells. No pumps were taken offline last week. Please note that Chiquita has additional pumps in operation in perimeter sumps that are not included in this count.

During 07/10/2026 to 07/16/2026, given the number of dewatering pumps installed to date, and the maintenance associated with those pumps, Chiquita plans to install and begin operating zero (0) additional pumps in vertical LFG extraction wells in locations along the north and south slope of the reaction area. Pump installation will resume once the existing pumps are turned back on, subject to disposal outlet capacity.

Best,

**Rachelle Huber**  
Project Manager

SCS Engineers  
4683 Chabot Drive, Suite 200  
Pleasanton, CA 94588  
(925) 789-5710 (work cell)  
[rhuber@scsengineers.com](mailto:rhuber@scsengineers.com)

**Driven by Client Success**  
[www.scsengineers.com](http://www.scsengineers.com)



GENERAL DRAWING NOTES:

1. EXISTING TOPOGRAPHIC SURVEY INFORMATION SHOWN WAS PROVIDED BY PROPELLOR. AERIAL PHOTOGRAPHY DATED JULY 01, 2026.

2. NORTH ARROW SHOWN HERE IS REFERENCE TO THE CALIFORNIA STATE PLANE ZONE V COORDINATE SYSTEM, NAD 83.

3. THE LOCATION OF ANY EXISTING GGCS COMPONENTS AND OTHER FEATURES ARE APPROXIMATE AND SHOULD BE USED FOR INFORMATION PURPOSES ONLY.

A

B

C

D

E


F

G

H

I

J

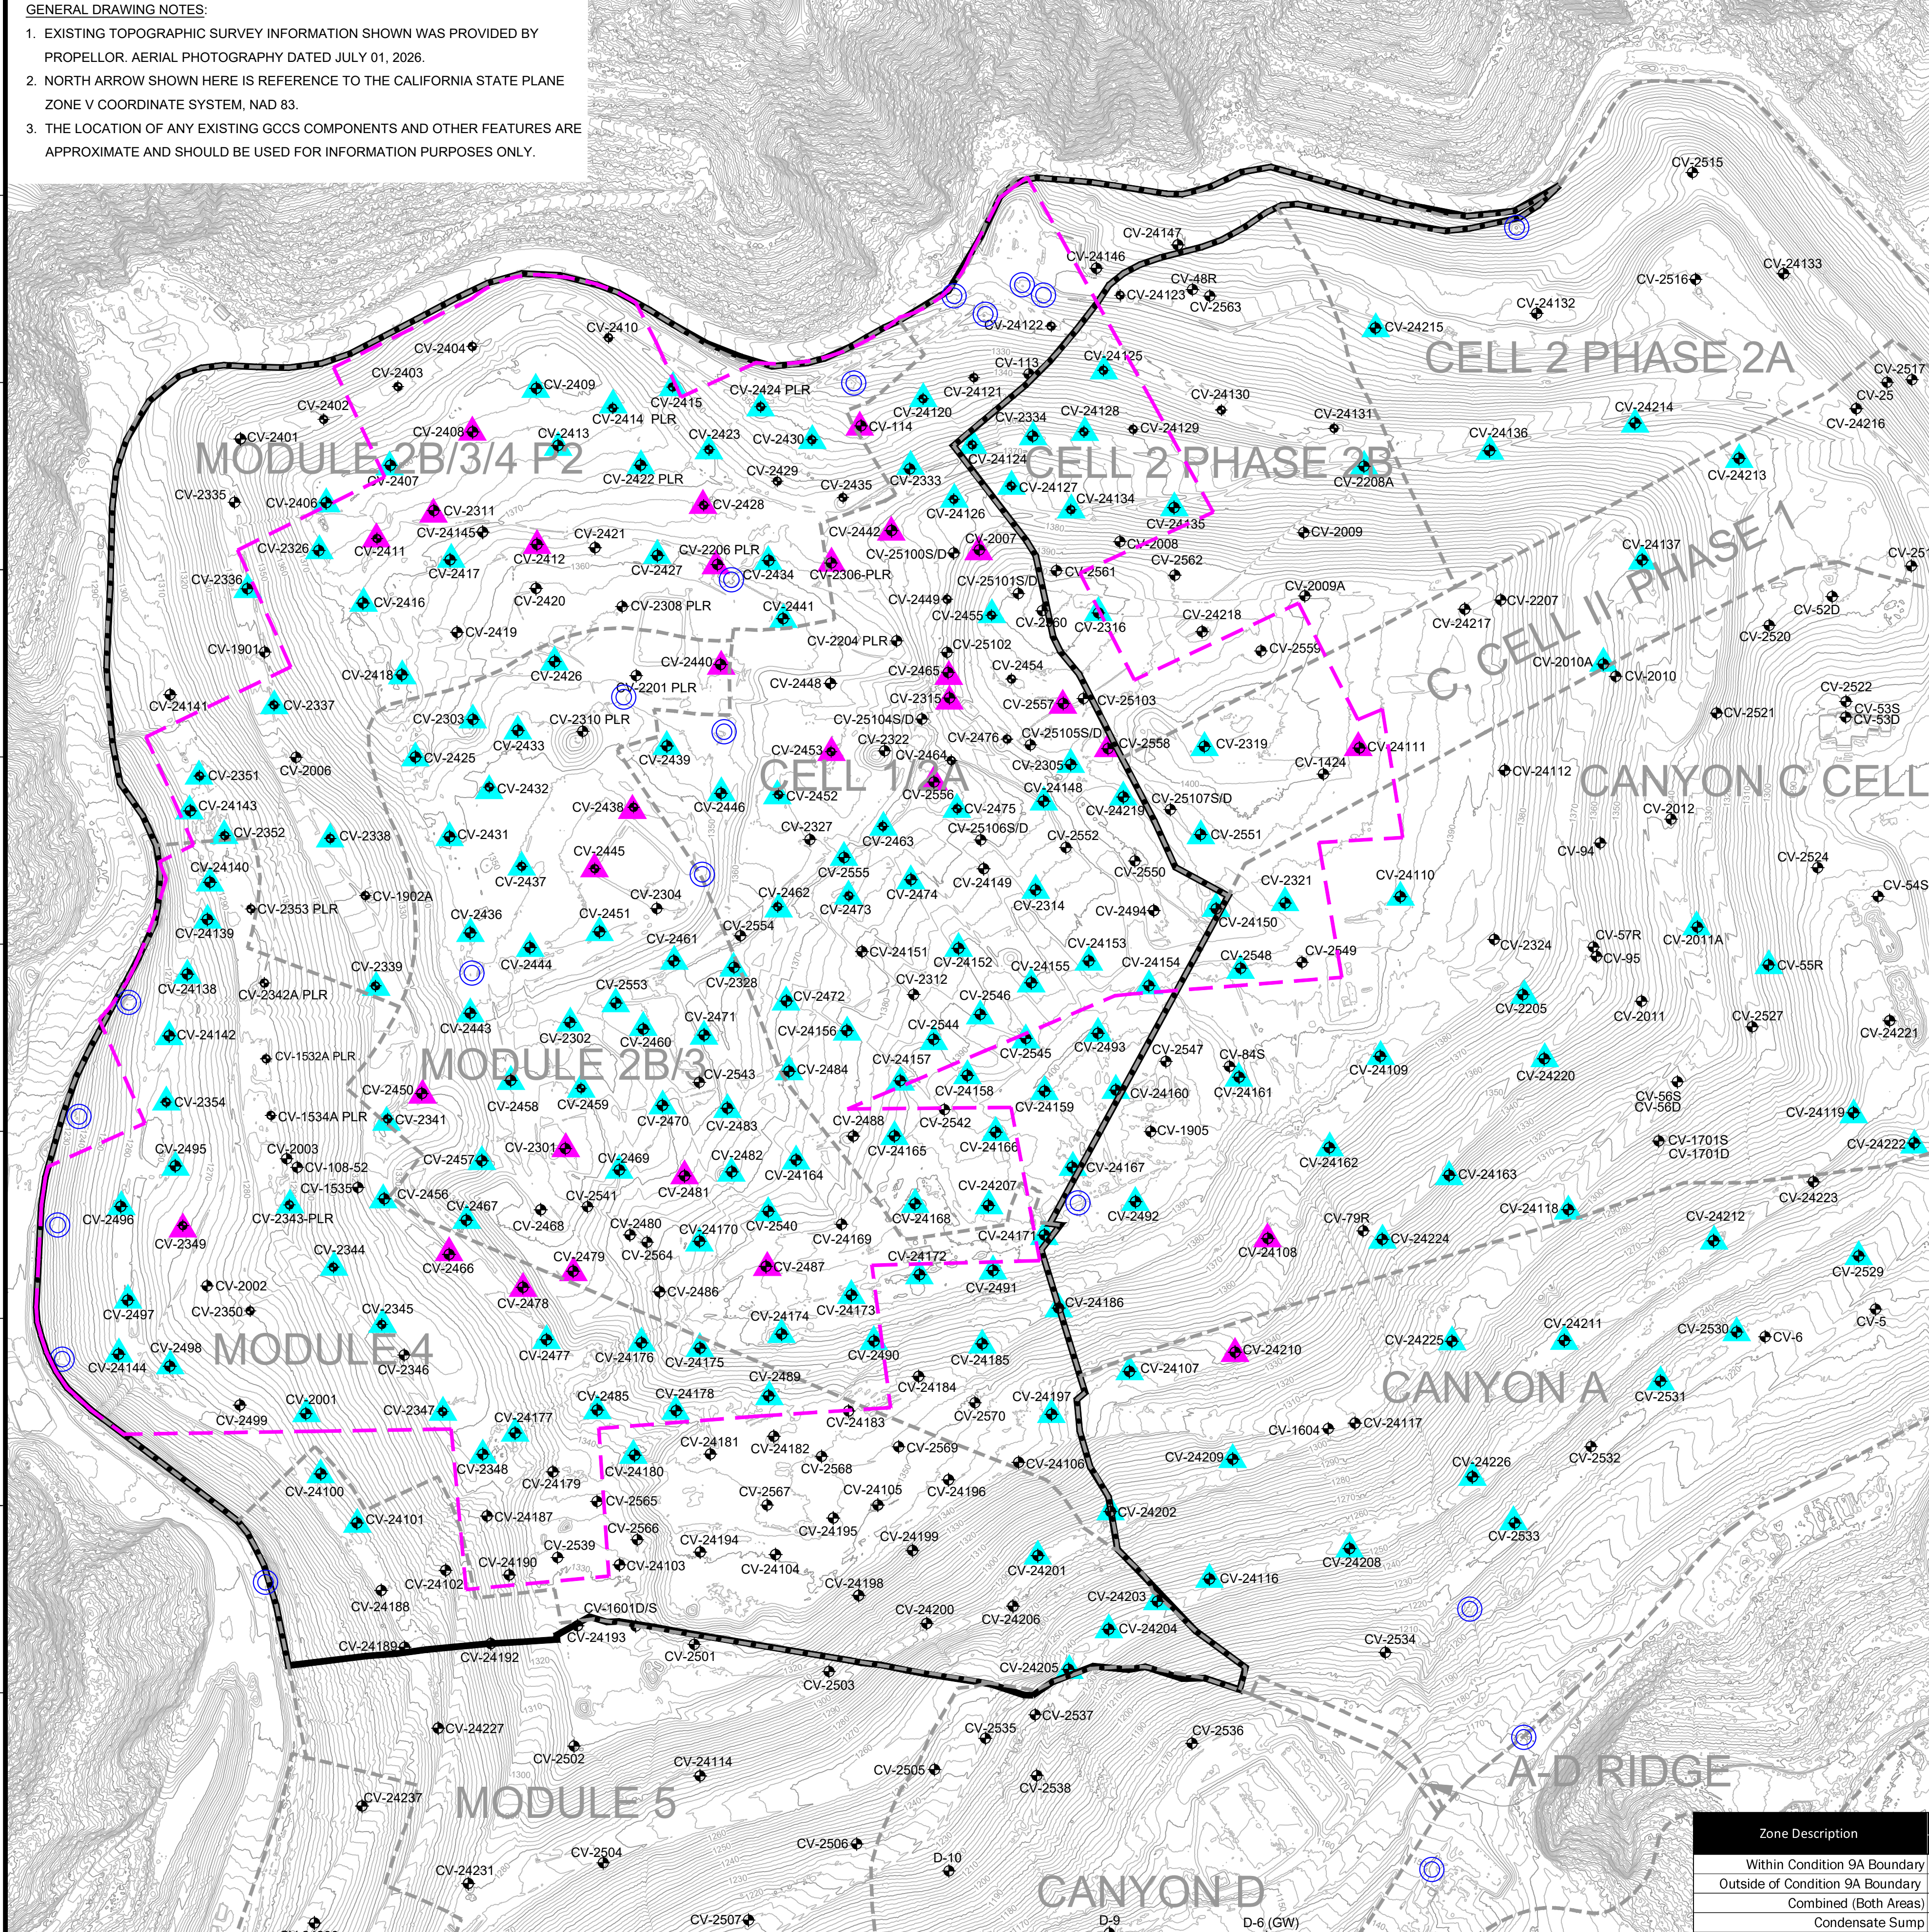

| De-Watering Well Pumps Currently Running |           |              |     |              |              |
|------------------------------------------|-----------|--------------|-----|--------------|--------------|
| #                                        | Well I.D. | Install Date | #   | Well I.D.    | Install Date |
| 1                                        | CV-2314   | 3/27/2024    | 90  | CV-2485      | 8/7/2025     |
| 2                                        | CV-2337   | 4/22/2024    | 91  | CV-2489      | 9/4/2025     |
| 3                                        | CV-2302   | 4/26/2024    | 92  | CV-2431      | 9/18/2025    |
| 4                                        | CV-2328   | 4/26/2024    | 93  | CV-2425      | 9/22/2025    |
| 5                                        | CV-2335   | 4/30/2024    | 94  | CV-2530      | 10/3/2025    |
| 6                                        | CV-24142  | 5/3/2024     | 95  | CV-2533      | 10/17/2025   |
| 7                                        | CV-24144  | 5/13/2024    | 96  | CV-2529      | 10/18/2025   |
| 8                                        | CV-2496   | 5/30/2024    | 97  | CV-2010A     | 11/24/2025   |
| 9                                        | CV-2497   | 5/30/2024    | 98  | CV-2011A     | 11/24/2025   |
| 10                                       | CV-2416   | 6/24/2024    | 99  | CV-24156     | 12/17/2025   |
| 11                                       | CV-24109  | 7/3/2024     | 100 | CV-2551      | 12/30/2025   |
| 12                                       | CV-24162  | 7/7/2024     | 101 | CV-2351      | 1/23/2026    |
| 13                                       | CV-24101  | 7/8/2024     | 102 | CV-24138     | 1/23/2026    |
| 14                                       | CV-24100  | 7/17/2024    | 103 | CV-2352      | 1/26/2026    |
| 15                                       | CV-2349   | 7/22/2024    | 104 | CV-2455      | 2/28/2026    |
| 16                                       | CV-2347   | 7/24/2024    | 105 | CV-2495      | 2/28/2026    |
| 17                                       | CV-2345   | 7/27/2024    | 106 | CV-24167     | 3/4/2026     |
| 18                                       | CV-2344   | 7/30/2024    | 107 | CV-24185     | 3/19/2026    |
| 19                                       | CV-2417   | 8/13/2024    | 108 | CV-24201     | 3/26/2026    |
| 20                                       | CV-2418   | 8/14/2024    | 109 | CV-24178     | 3/30/2026    |
| 21                                       | CV-2341   | 8/15/2024    | 110 | CV-2430      | 3/31/2026    |
| 22                                       | CV-2427   | 8/15/2024    | 111 | CV-2555      | 4/1/2026     |
| 23                                       | CV-24124  | 8/24/2024    | 112 | CV-24226     | 4/2/2026     |
| 24                                       | CV-2423   | 9/28/2024    | 113 | CV-24176     | 4/3/2026     |
| 25                                       | CV-2409   | 9/30/2024    | 114 | CV-2422      | 4/6/2026     |
| 26                                       | CV-2437   | 11/26/2024   | 115 | CV-2321      | 4/10/2026    |
| 27                                       | CV-2413   | 12/16/2024   | 116 | CV-2433      | 4/11/2026    |
| 28                                       | CV-2451   | 12/23/2024   | 117 | CV-2446      | 4/11/2026    |
| 29                                       | CV-2470   | 12/24/2024   | 118 | CV-2457      | 4/11/2026    |
| 30                                       | CV-2432   | 1/7/2025     | 119 | CV-2458      | 4/11/2026    |
| 31                                       | CV-2412   | 1/10/2025    | 120 | CV-2424      | 4/13/2026    |
| 32                                       | CV-2462   | 1/14/2025    | 121 | CV-2305      | 4/15/2026    |
| 33                                       | CV-2463   | 1/15/2025    | 122 | CV-24172     | 4/16/2026    |
| 34                                       | CV-2001   | 1/23/2025    | 123 | CV-2415      | 4/22/2026    |
| 35                                       | CV-2483   | 1/29/2025    | 124 | CV-2531      | 4/29/2026    |
| 36                                       | CV-2338   | 2/8/2025     | 125 | CV-24127     | 5/21/2026    |
| 37                                       | CV-24202  | 2/20/2025    | 126 | CV-24180     | 5/29/2026    |
| 38                                       | CV-24209  | 2/28/2025    | 127 | CV-2443      | 6/1/2026     |
| 39                                       | CV-24197  | 3/11/2025    | 128 | CV-2472      | 6/1/2026     |
| 40                                       | CV-24165  | 4/7/2025     | 129 | CV-24157     | 6/1/2026     |
| 41                                       | CV-24166  | 4/7/2025     | 130 | CV-24170     | 6/2/2026     |
| 42                                       | CV-24168  | 4/7/2025     | 131 | CV-2459      | 6/2/2026     |
| 43                                       | CV-24171  | 4/7/2025     | 132 | CV-2460      | 6/2/2026     |
| 44                                       | CV-24134  | 4/9/2025     | 133 | CV-2461      | 6/2/2026     |
| 45                                       | CV-24135  | 4/11/2025    | 134 | CV-2469      | 6/2/2026     |
| 46                                       | CV-24173  | 4/15/2025    | 135 | CV-2471      | 6/3/2026     |
| 47                                       | CV-24174  | 4/15/2025    | 136 | CV-2326      | 6/3/2026     |
| 48                                       | CV-24175  | 4/15/2025    | 137 | CV-2473      | 6/3/2026     |
| 49                                       | CV-24159  | 4/16/2025    | 138 | CV-2484      | 6/3/2026     |
| 50                                       | CV-24154  | 4/17/2025    | 139 | CV-2491      | 6/3/2026     |
| 51                                       | CV-2208A  | 5/2/2025     | 140 | CV-24136     | 6/3/2026     |
| 52                                       | CV-24214  | 5/2/2025     | 141 | CV-24158     | 6/3/2026     |
| 53                                       | CV-2354   | 5/6/2025     | 142 | CV-24164     | 6/3/2026     |
| 54                                       | CV-2493   | 5/6/2025     | 143 | CV-2303      | 6/5/2026     |
| 55                                       | CV-24160  | 5/8/2025     | 144 | CV-24148     | 6/5/2026     |
| 56                                       | CV-2492   | 5/7/2025     | 145 | CV-24152     | 6/5/2026     |
| 57                                       | CV-2205   | 5/8/2025     | 146 | CV-24153     | 6/5/2026     |
| 58                                       | CV-24161  | 5/8/2025     | 147 | CV-24155     | 6/5/2026     |
| 59                                       | CV-24224  | 5/12/2025    | 148 | CV-24215     | 6/5/2026     |
| 60                                       | CV-24118  | 5/14/2025    | 149 | CV-2467      | 6/5/2026     |
| 61                                       | CV-24119  | 5/14/2025    | 150 | CV-2553      | 6/7/2026     |
| 62                                       | CV-24107  | 5/15/2025    | 151 | CV-2426      | 6/9/2026     |
| 63                                       | CV-24211  | 5/15/2025    | 152 | CV-2434      | 6/9/2026     |
| 64                                       | CV-24137  | 5/15/2025    | 153 | CV-2498      | 6/9/2026     |
| 65                                       | CV-24208  | 5/18/2025    | 154 | CV-24120     | 6/9/2026     |
| 66                                       | CV-24116  | 5/20/2025    | 155 | CV-24128     | 6/9/2026     |
| 67                                       | CV-24204  | 5/20/2025    | 156 | CV-2333      | 6/10/2026    |
| 68                                       | CV-24205  | 5/20/2025    | 157 | CV-2406      | 6/10/2026    |
| 69                                       | CV-2490   | 6/5/2025     | 158 | CV-2477      | 6/10/2026    |
| 70                                       | CV-24203  | 6/5/2025     | 159 | CV-24125     | 6/10/2025    |
| 71                                       | CV-24207  | 6/9/2025     | 160 | CV-2334      | 6/11/2026    |
| 72                                       | CV-24225  | 6/9/2025     | 161 | CV-2456      | 6/11/2026    |
| 73                                       | CV-24186  | 6/10/2025    | 162 | CV-2343-PLR  | 6/19/2026    |
| 74                                       | CV-24222  | 6/10/2025    | 163 | CV-2474      | 6/16/2026    |
| 75                                       | CV-24163  | 6/11/2025    | 164 | CV-2316      | 6/17/2026    |
| 76                                       | CV-2439   | 6/12/2025    | 165 | CV-2339      | 6/18/2026    |
| 77                                       | CV-2475   | 6/12/2025    | 166 | CV-2482      | 6/18/2026    |
| 78                                       | CV-24139  | 6/12/2025    | 167 | CV-2544      | 6/18/2026    |
| 79                                       | CV-24143  | 6/12/2025    | 168 | CV-2546      | 6/18/2026    |
| 80                                       | CV-24140  | 6/14/2025    | 169 | CV-2545      | 6/19/2026    |
| 81                                       | CV-24220  | 6/16/2025    | 170 | CV-24177     | 6/22/2026    |
| 82                                       | CV-2436   | 6/23/2025    | 171 | CV-2540      | 6/23/2026    |
| 83                                       | CV-2444   | 6/23/2025    | 172 | CV-2548      | 6/25/2026    |
| 84                                       | CV-255R   | 6/23/2025    | 173 | CV-24126     | 7/1/2026     |
| 85                                       | CV-24213  | 7/9/2025     | 174 | CV-24014-PLR | 7/8/2026     |
| 86                                       | CV-24150  | 7/9/2025     | 175 | CV-2407      | 7/7/2026     |
| 87                                       | CV-2319   | 7/9/2025     | 176 | CV-2441      | 7/7/2026     |
| 88                                       | CV-24219  | 7/9/2025     | 177 | CV-2452      | 7/7/2026     |
| 89                                       | CV-24110  | 7/17/2025    |     |              |              |

150

75

0

150

300

450

GRAPHIC SCALE

SCALE: 1"=150'

N

GRAPHIC SCALE

SCALE: 1"=150'

LEGEND

1150

TOPOGRAPHIC CONTOUR

---

EXISTING CELL LIMITS (APPROXIMATE)

---

REACTION AREA BOUNDARY - CONDITION 9A

---

REACTION MITIGATION AREA BOUNDARY

CV-XX

EXISTING VERTICAL EXTRACTION WELL

CV-XX PLR

EXISTING VERTICAL EXTRACTION WELL - PRESSURIZED LEACHATE RELEASE

CV-XX

EXISTING CONDENSATE SUMP WITH PUMP

CV-XX

EXISTING DE-WATERING WELL - PUMP INSTALLED AND RUNNING

CV-XX

EXISTING DE-WATERING WELL - PUMP INSTALLED, NOT RUNNING

DATE

REVISION

NO

SHEET TITLE: EXISTING DE-WATERING WELLS

PROJECT TITLE: CHIHUITA CANYON LANDFILL CASTAIC, CALIFORNIA

CLIENT:

SCS ENGINEERS ENVIRONMENTAL CONSULTANTS  
15000 WILSON AVENUE, SUITE 300  
LONG BEACH, CA 90806  
PH: (562) 426-9544

DATE: 07/10/2026

SCALE: AS SHOWN

SHEET: 1

| Zone Description                 | De-Watering Pumps |             |             |                      |
|----------------------------------|-------------------|-------------|-------------|----------------------|
|                                  | Total             | Operational | Not Running | Pending Installation |
| Within Condition 9A Boundary     | 159               | 132         | 27          | 14                   |
| Outside of Condition 9A Boundary | 48                | 45          | 3           | 7                    |
| Combined (Both Areas)            | 207               | 177         | 30          | 21                   |
| Condensate Sump                  | 52                | 50          | 2           | 12                   |

| De-Watering Well Pumps Currently Installed, but NOT in Operation |             |
|------------------------------------------------------------------|-------------|
| #                                                                | Well I.D.   |
| 1                                                                | CV-114      |
| 2                                                                | CV-2007     |
| 3                                                                | CV-2206-PLR |
| 4                                                                | CV-2301     |
| 5                                                                | CV-2306-PLR |
| 6                                                                | CV-2311     |
| 7                                                                | CV-2315     |
| 8                                                                | CV-2349     |
| 9                                                                | CV-2408     |
| 10                                                               | CV-2411     |
| 11                                                               | CV-2412     |
| 12                                                               | CV-2428     |
| 13                                                               | CV-2438     |
| 14                                                               | CV-2440     |
| 15                                                               | CV-2442     |
| 16                                                               | CV-2445     |
| 17                                                               | CV-2450     |
| 18                                                               | CV-2453     |
| 19                                                               | CV-2465     |
| 20                                                               | CV-2466     |
| 21                                                               | CV-2478     |
| 22                                                               | CV-2479     |
| 23                                                               | CV-2481     |
| 24                                                               | CV-2487     |
| 25                                                               | CV-2556     |
| 26                                                               | CV-2557     |
| 27                                                               | CV-2558     |
| 28                                                               | CV-24108    |
| 29                                                               | CV-24111    |
| 30                                                               | CV-24210    |