

From: Dylan Smith
Sent: Friday, July 10, 2026 7:12 PM
To: Karen Gork
Cc: Todd.Thalhamer@Calrecycle.ca.gov; LFrias@ph.lacounty.gov; NQuick@ph.lacounty.gov; RRagland@ph.lacounty.gov; BMcphillips@counsel.lacounty.gov; Wes.Mindermann@CalRecycle.ca.gov; mark.debie@calrecycle.ca.gov; mark.debie@calrecycle.ca.gov; emorofuji@ph.lacounty.gov; btway@ph.lacounty.gov; Relon.MarkAnthony@epa.gov; Holybee.Tyler@epa.gov; Friedli.Laura@epa.gov; John Perkey; Sarah Phillips; Gregory.Shaffer@dtsc.ca.gov; Natasha.DiPietro@dtsc.ca.gov; Gregory.Gentile@dtsc.ca.gov; WILLIAM.HALEY@WasteConnections.com
Subject: Chiquita Canyon Landfill – Geosynthetic Cover – Mitigation Measure 4.1
Attachments: RM22.1077-CCL-EVOH-FIG 1-(2026-07-09)-FIG 1.pdf; Milestone 2B Chiquita Canyon LF Isopach_June.2026.pdf; 2026 CCLF Reaction Area_Reactive Wells_2026-06-19.pdf

Below is Chiquita's weekly update on the status of the installation of the 60-mil EVOH/HDPE geomembrane cover at the Chiquita Canyon Landfill, in accordance with Mitigation Measure 4.1 of the LEA's Compliance Order issued May 1, 2025.


As of July 3, 2026, D&E, on behalf of Chiquita, has installed approximately 2,828,807 square feet of tan 60-mil EVOH/HDPE geomembrane cover. Of this total, approximately 678,279 square feet has been deployed on top of the existing 30mil geomembrane to augment its effectiveness. Work conducted the week of June 29 also included repairs and detailing of existing panels, including boot fabrication, patching, extrusion welding, and re-seaming, as needed. Work continued during the week of July 6, 2026.

The attached site map shows the approximate extent of geomembrane cover installed as of Wednesday, July 8, 2026, as well as the geomembrane coverage described in the revised draft workplan for extension of the geomembrane cover area submitted to the LEA, the US EPA, and DTSC on March 13, 2026. Also attached to this submission are the June 2026 monthly isopach map and a figure identifying wells showing signs of reaction as of June 19, 2026. A new figure identifying wells showing signs of reaction based on the 7/10/26 Reaction Mitigation Area will be available next week. Due to technical limitations, we are currently unable to create one figure including all of this data.


Thank you,

Dylan Smith

P:\SITES\CHIQUITA CYN LF\MONITORING SUMMARY\FIGURES-WEEKLY\RM22.1077-CCL-EVOH-FIG 1-(2026-07-09).DWG July 9, 2026 -- 4:47 PM BY: GLA-USER

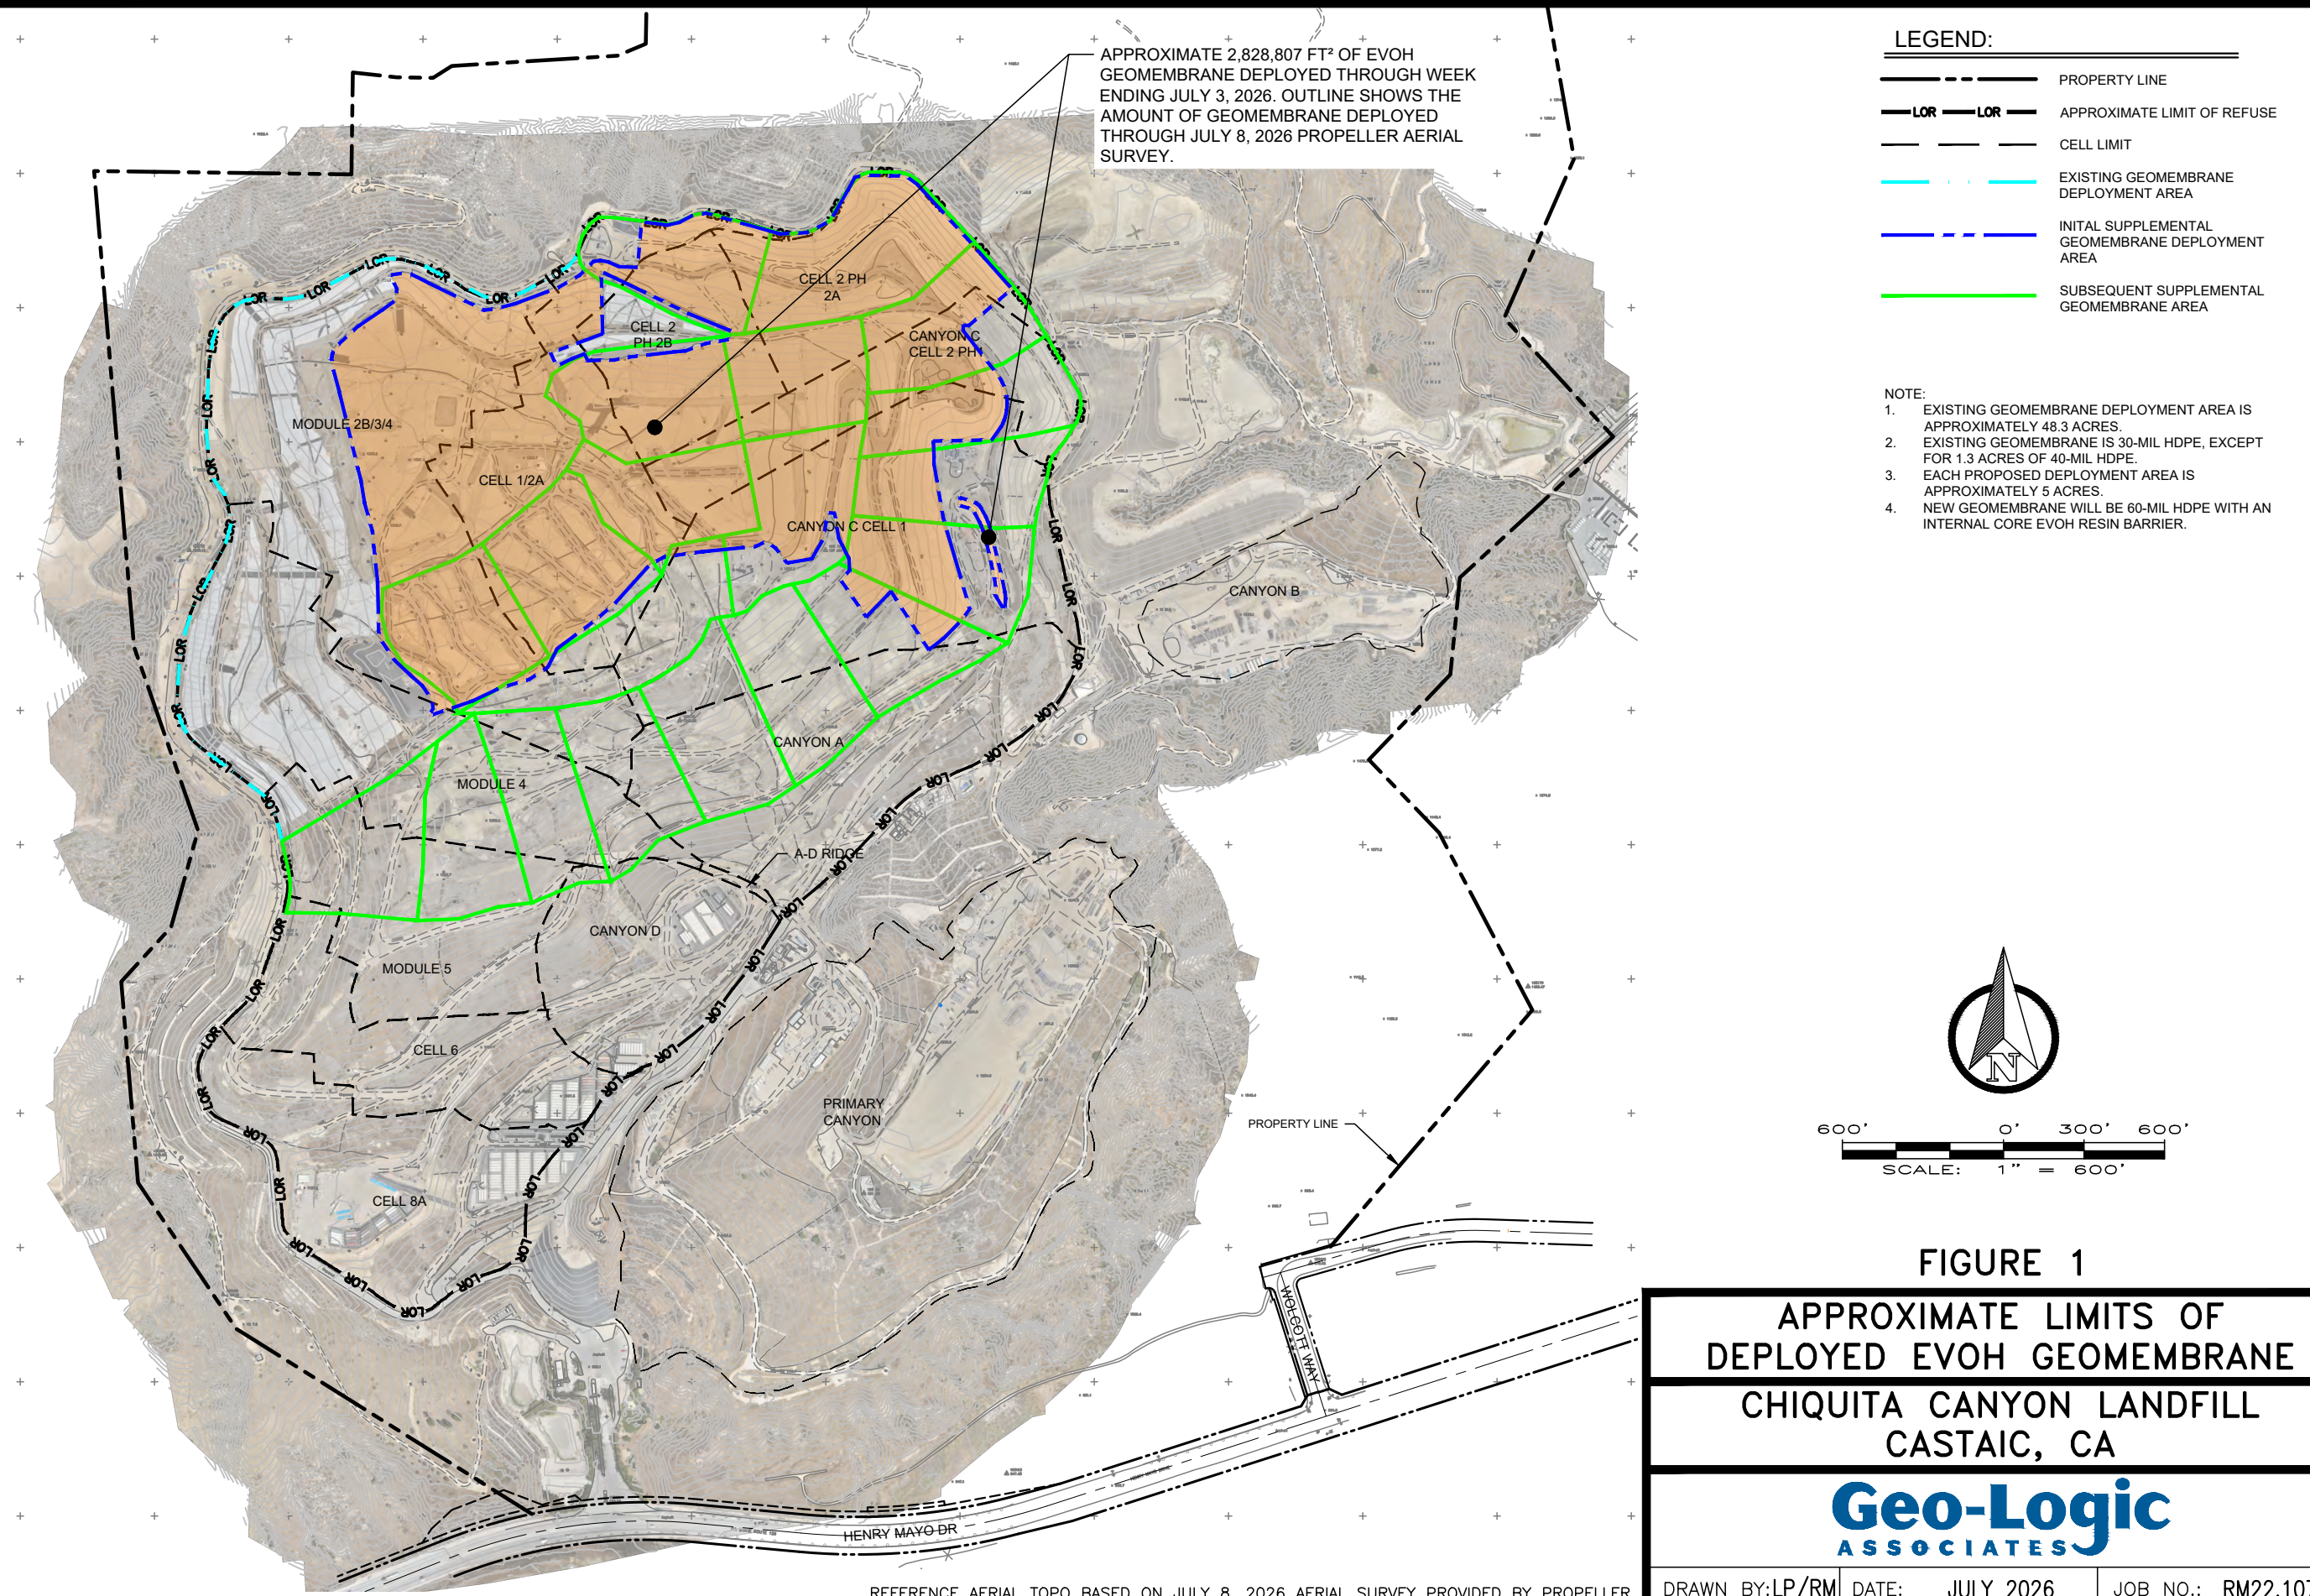

Chiquita Canyon Landfill -Isopach

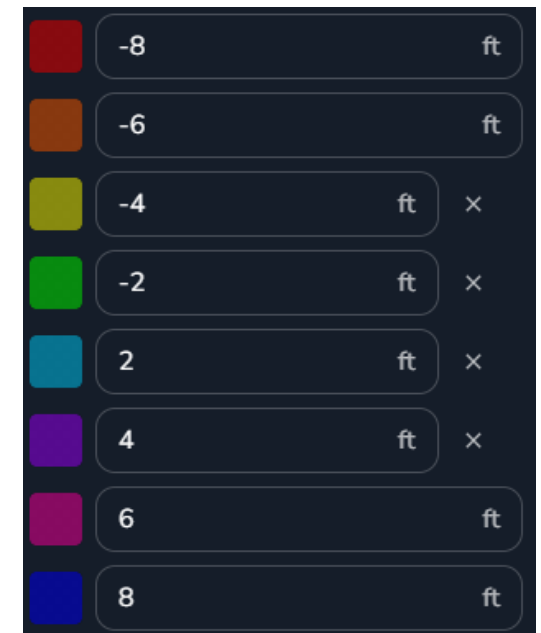

June 24, 2026 Survey Image. June 2, 2026 vs June 24, 2026

